



FED. ROAD DIST. NO.	STATE	FED. AID PROJ. NO.	FISCAL YEAR	SHEET NO.	TOTAL SHEETS
HAWAII	HAW.	F-083-1(10) F-083-1(20)	1984	4	57

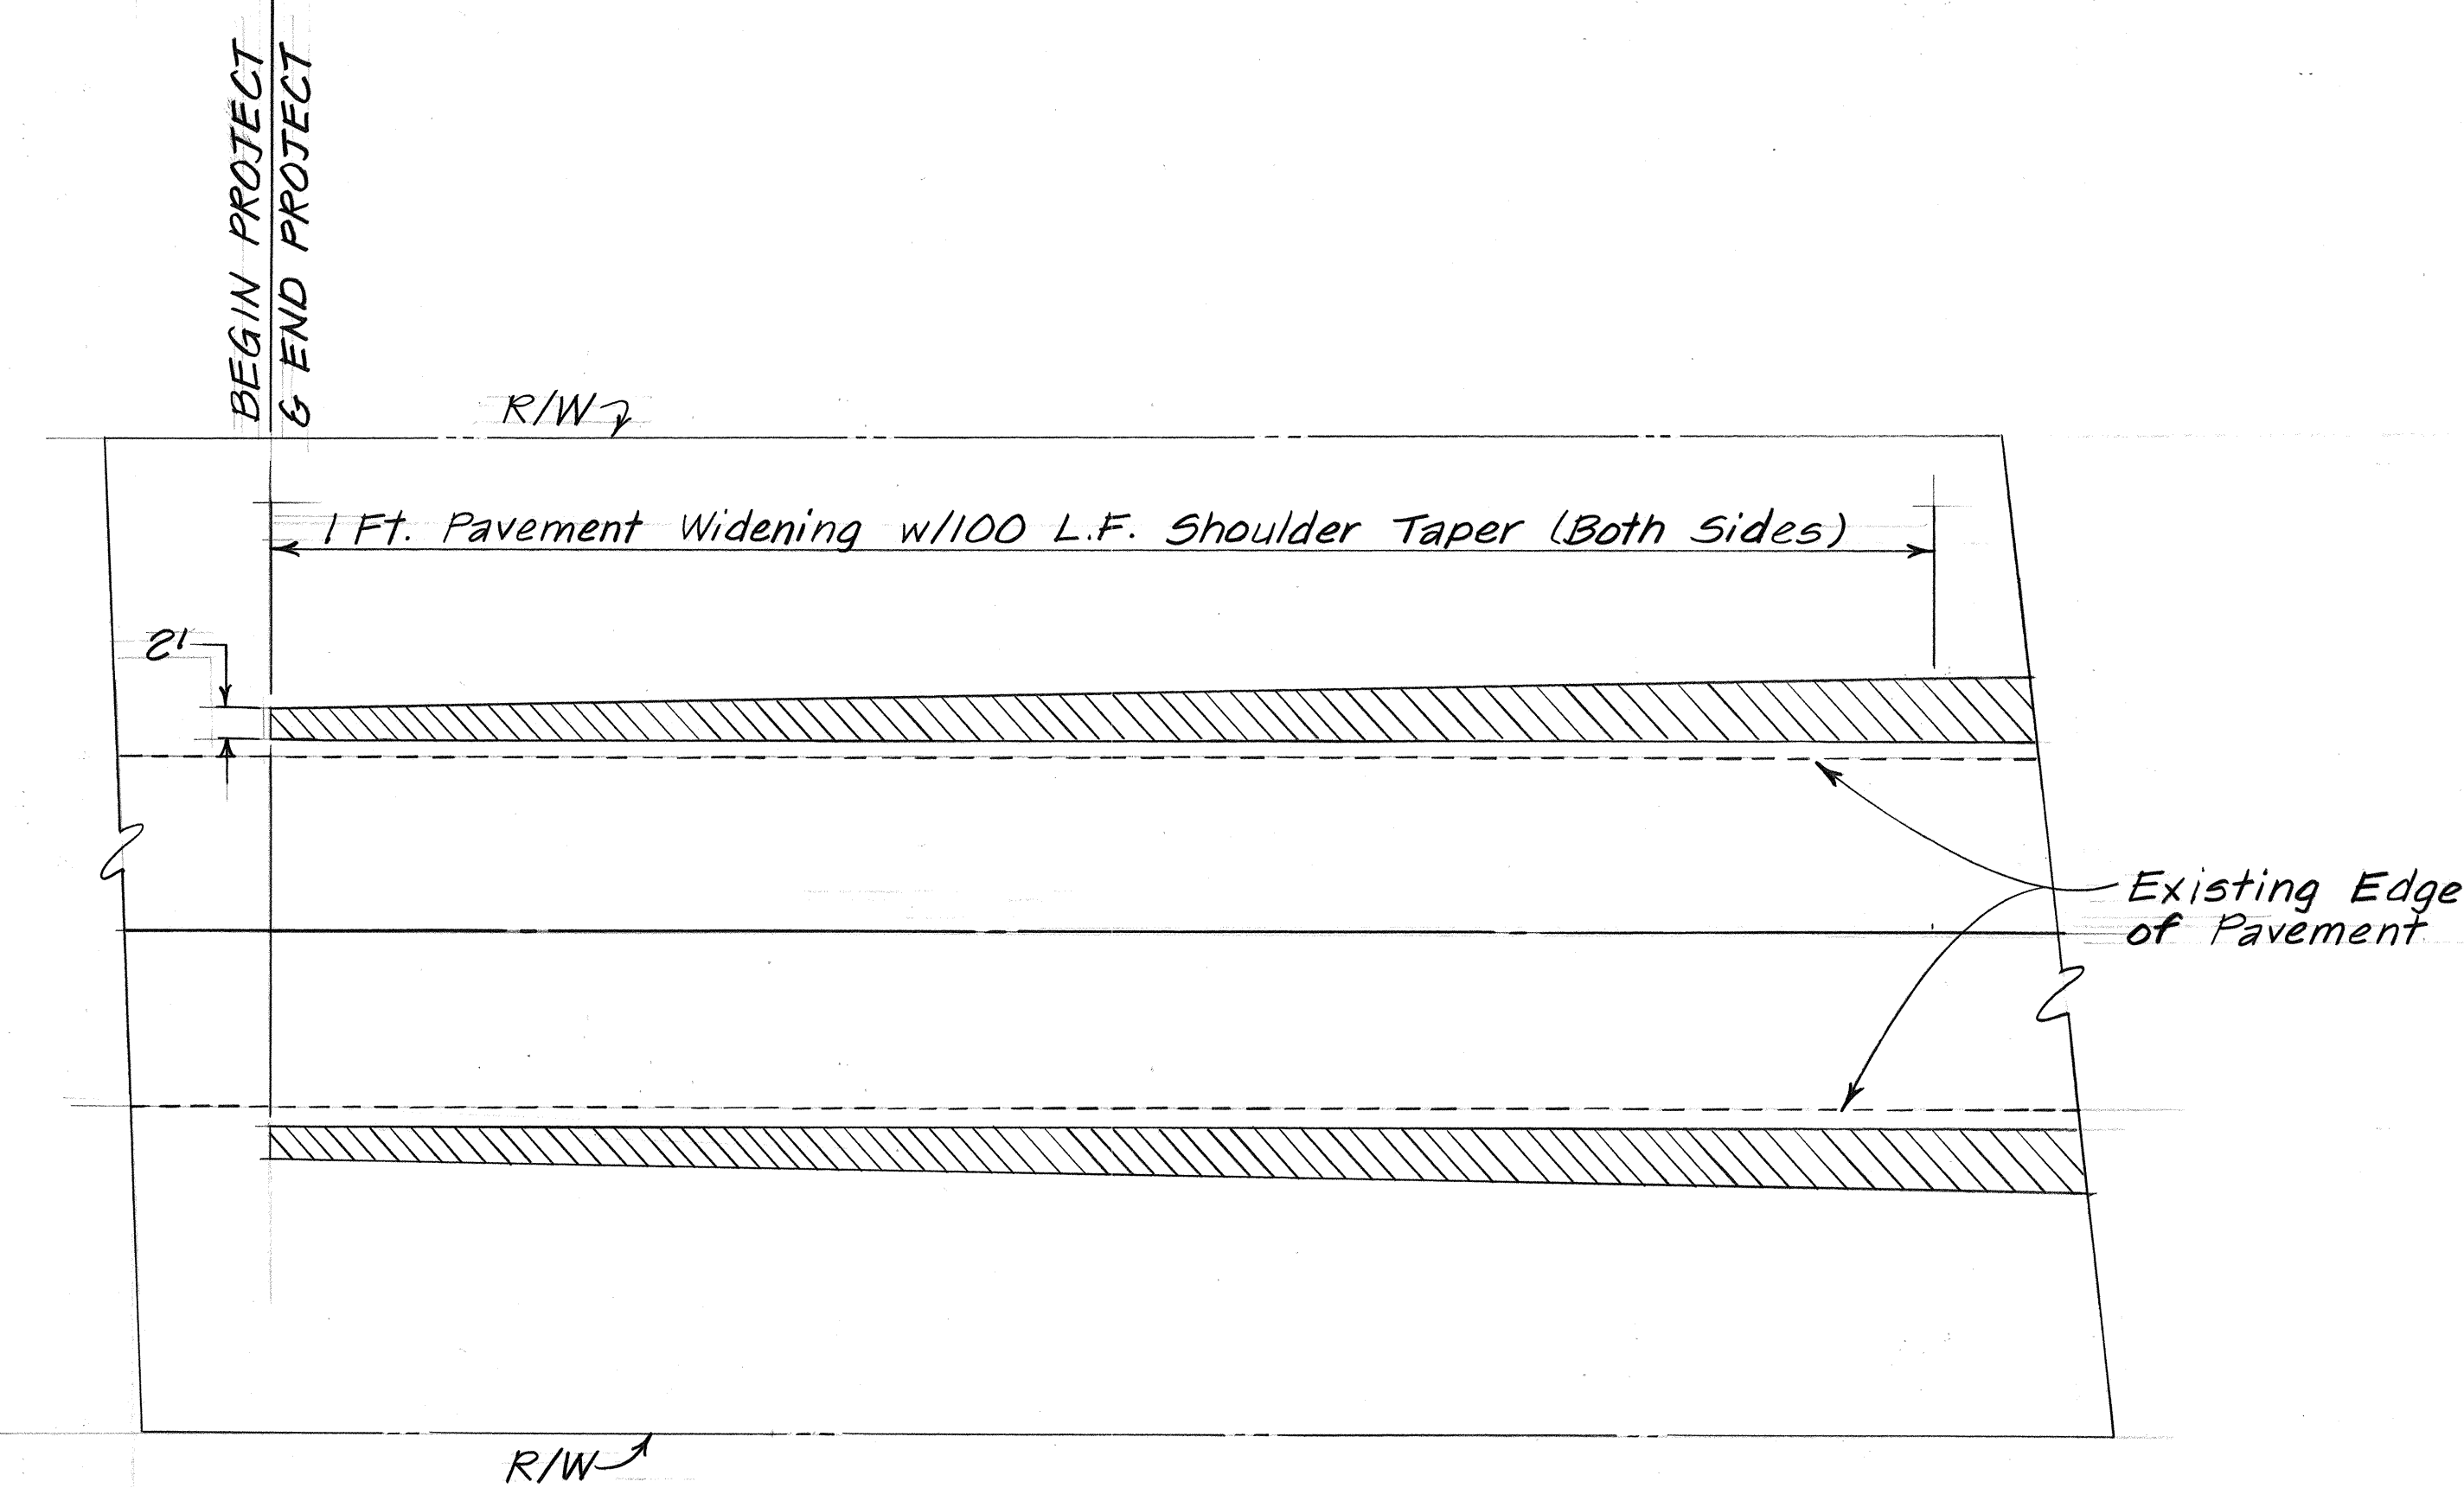

DETAIL - BEGINNING AND END TRANSITION
Scale: 1" = 10'

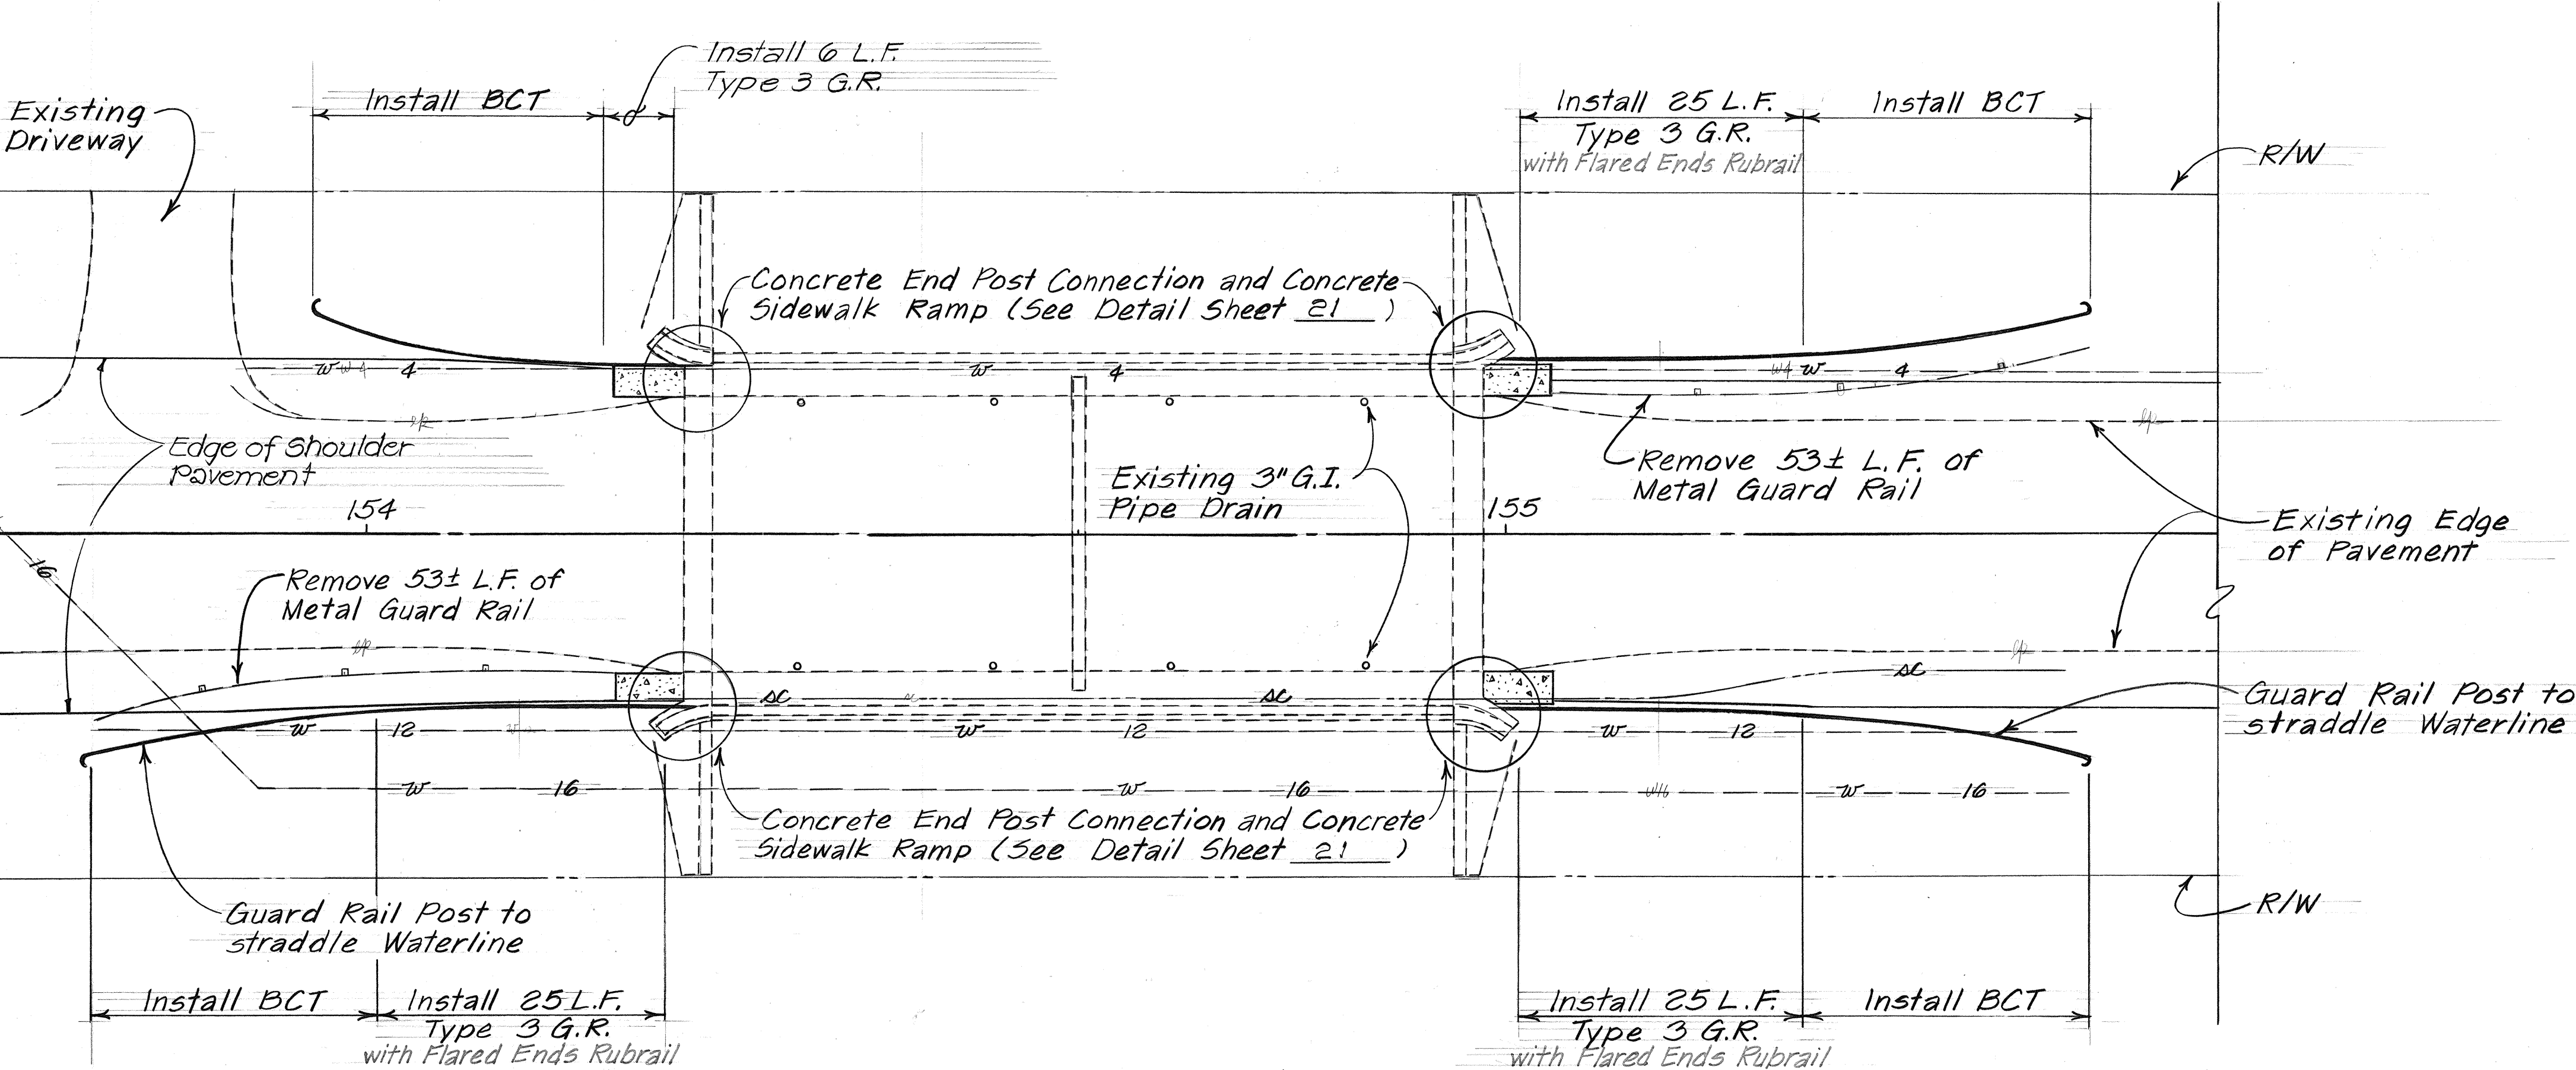

END TREATMENT - LAUHULU BRIDGE
Scale: 1" = 10'


STATE OF HAWAII
DEPARTMENT OF TRANSPORTATION
HIGHWAYS DIVISION

ROADWAY TRANSITION AND
LAUHULU END TREATMENT
KAMEHAMEHA HIGHWAY RESURFACING
UNITS 1 & 2
F. A. PROJ. NOS. F-083-1(10) &
F-083-1(20)
Scale: 1" = 10' Date: Feb., 1984

SHEET NO. OF SHEETS


SURVEY PLOTTED BY	DATE
DRAWN BY	
TRACED BY	
NOTED BY	
CHECKED BY	
ORIGINAL PLAN	
NOTE BOOK	
NO.	

FED. ROAD DIST. NO.	STATE	FED. AID PROJ. NO.	FISCAL YEAR	SHEET NO.	TOTAL SHEETS
HAWAII	HAW.	F-083-1(19) F-083-1(20)	1984	5	57

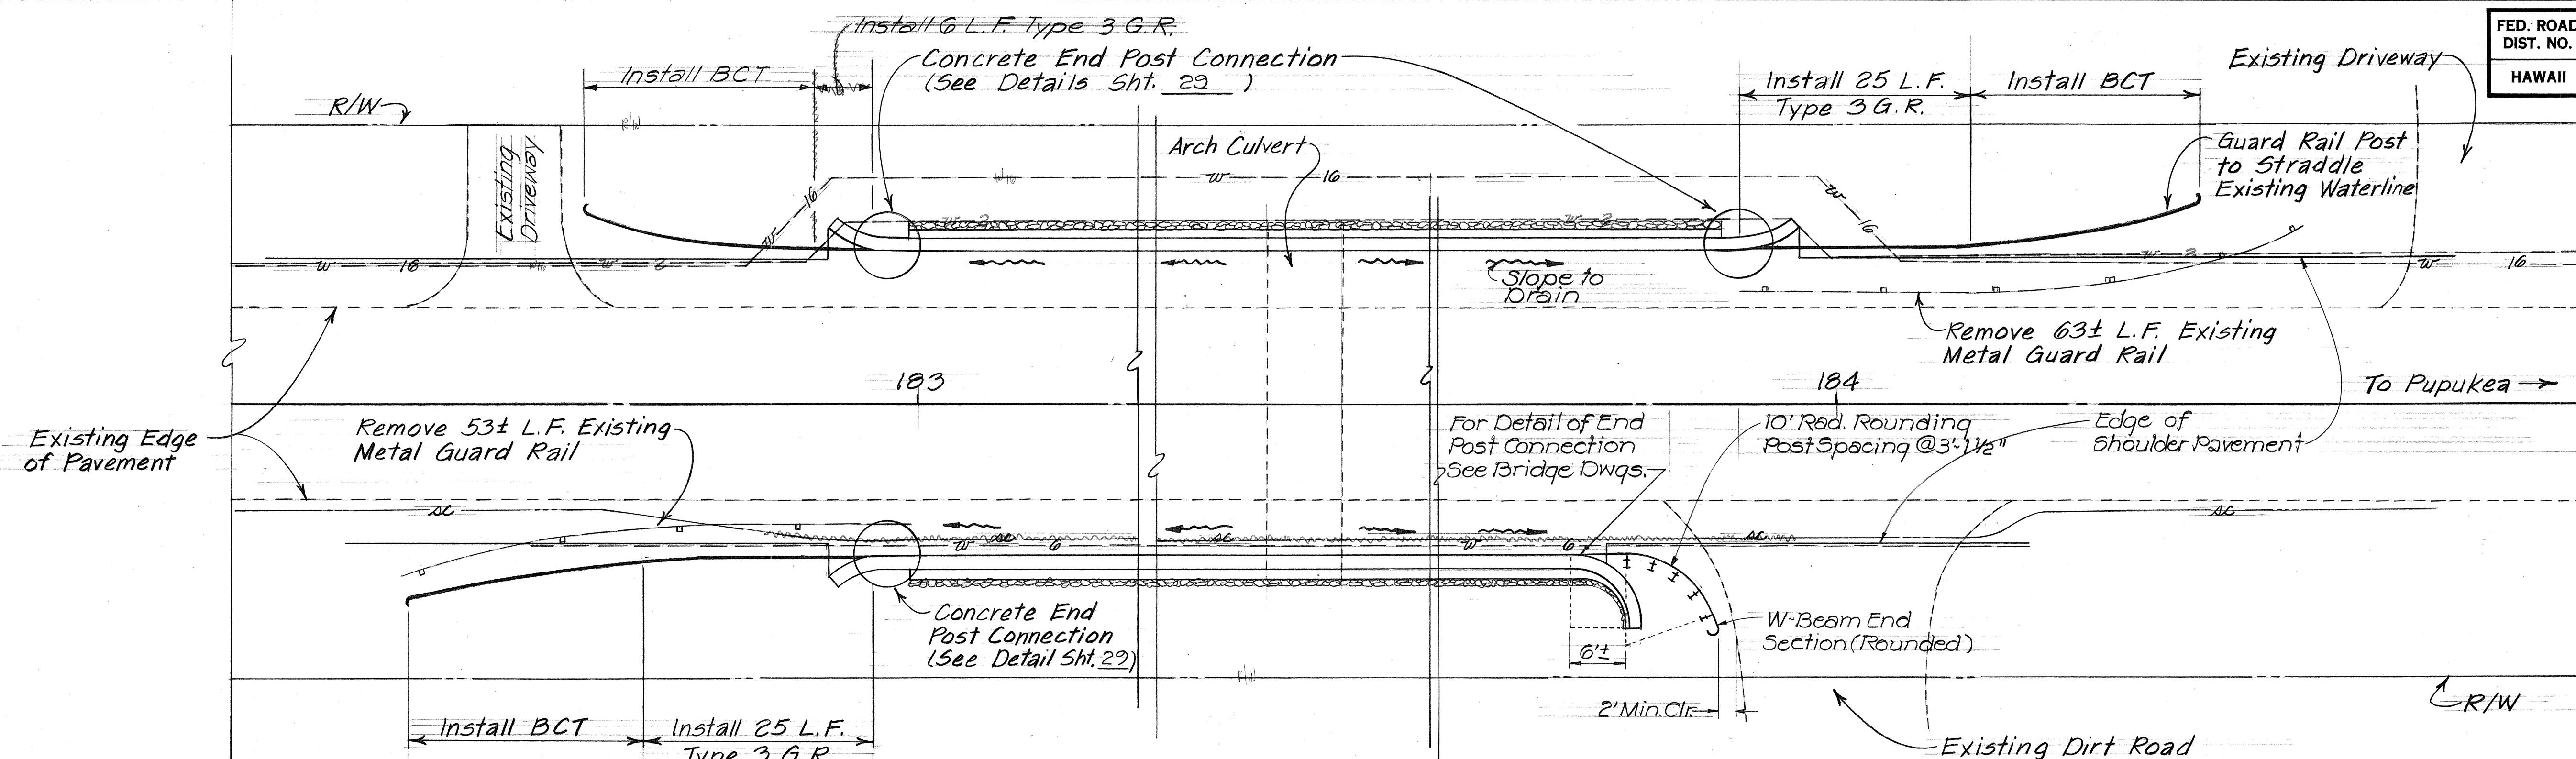

END TREATMENT AT ARCH CULVERT

Scale: 1" = 10'

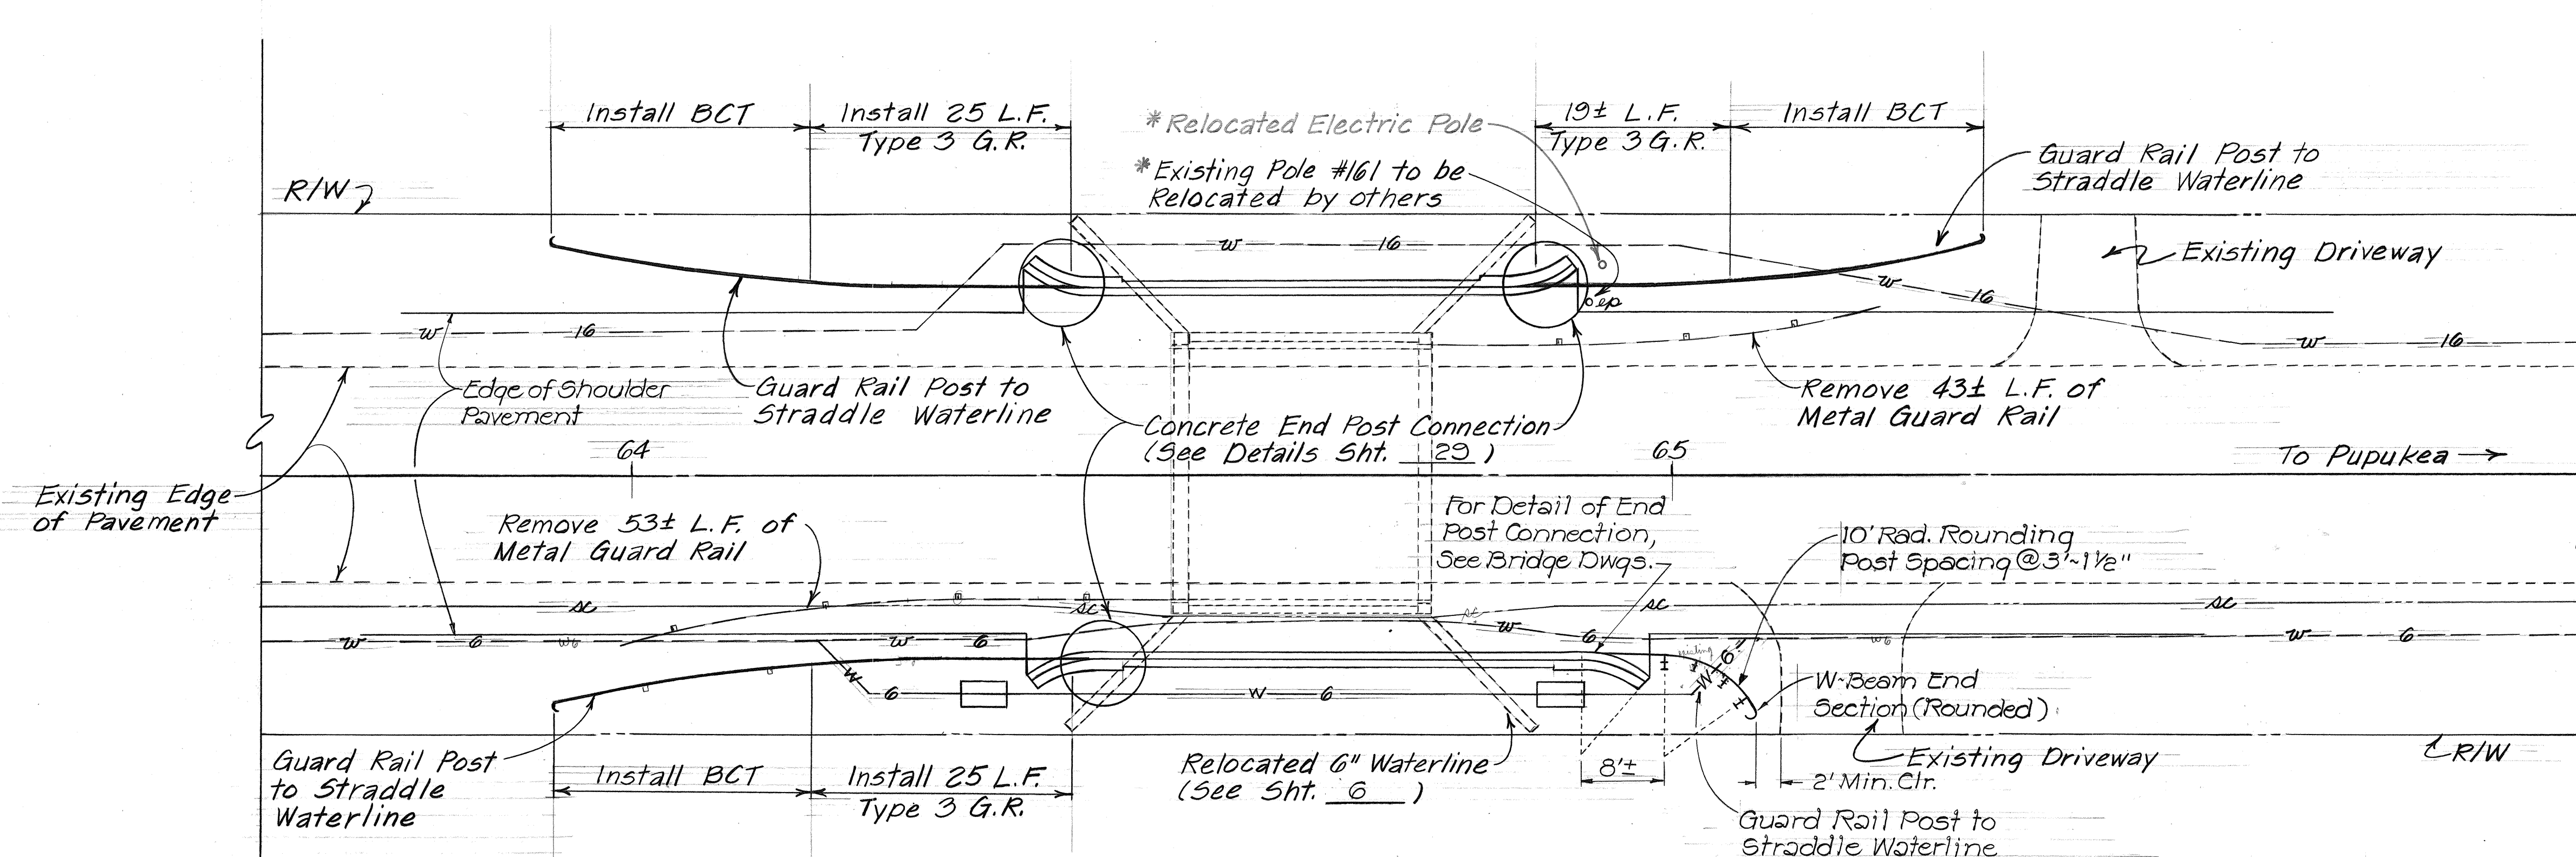

END TREATMENT AT KAWAIOHA BRIDGE

Scale: 1" = 10'

SURVEY PLOTTED BY	DATE
DRAWN BY	
CHECKED BY	
NOTED BY	
NO.	

STATE OF HAWAII
DEPARTMENT OF TRANSPORTATION
HIGHWAYS DIVISION

**ARCH CULVERT AND
KAWAIOHA END TREATMENT**
KAMEHAMEHA HIGHWAY RESURFACING
UNITS 1 & 2

F.A. PROJ. NOS. F-083-1(19) &
F-083-1(20)

Scale: 1" = 10' Date: Feb., 1984

SHEET NO. OF SHEETS