


B-7-4

INDEX TO DRAWINGS	
SHEET NO.	DESCRIPTION
1	TITLE SHEET
2	LAYOUT PLAN AND GENERAL NOTES
3 - 11	PLAN AND TYPICAL SECTIONS
12 - 17	SPECIAL DETAILS OF GUARD RAIL CONNECTIONS AND CONC. RAMPS
18 - 23	TYPICAL & STANDARD DETAILS OF GUARD RAILS
24 - 26	SPECIAL AND STANDARD DRAINAGE DETAILS
27 - 43	HIGHWAY LIGHTING & SIGNING PLAN AND DETAILS




DESIGNED BY
Allan T. Nishimura
P. S. & E. BY
A. Nishimura
548-7490
Feb. 1985
DATE

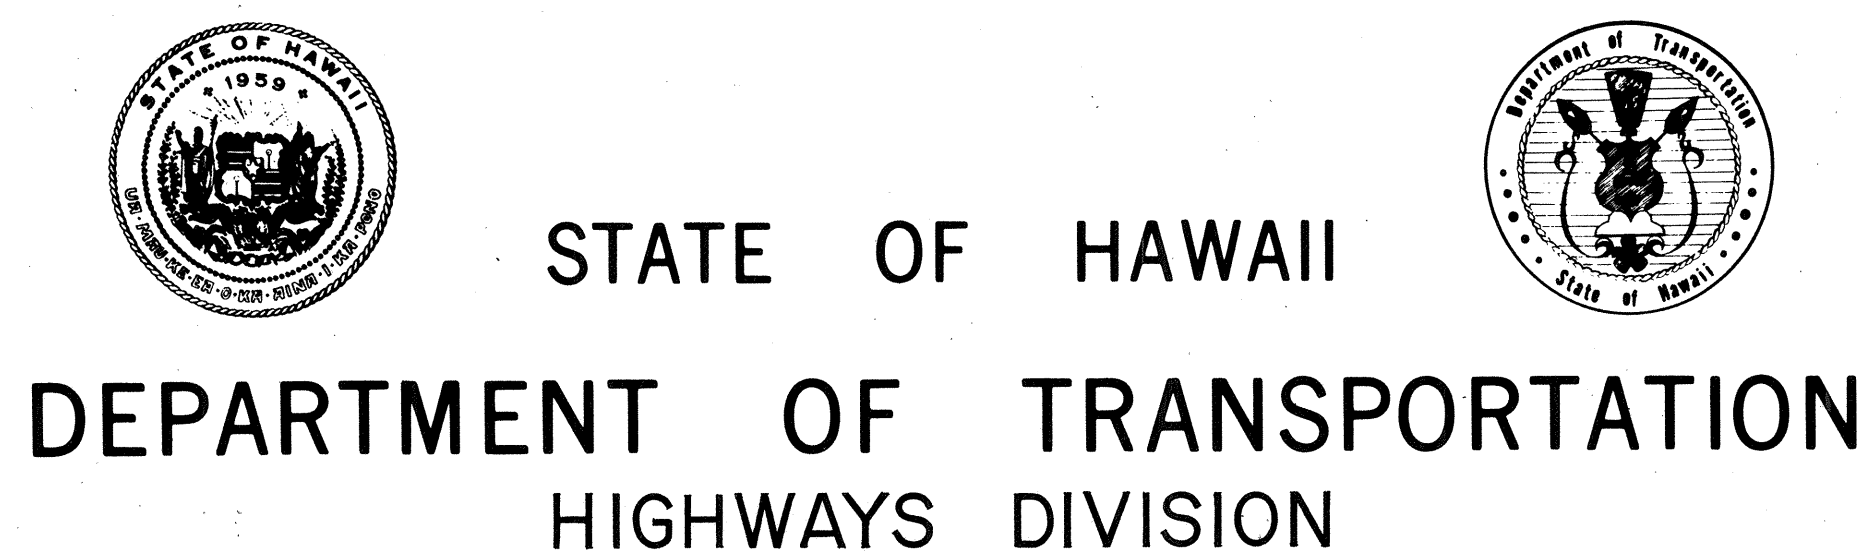

STATE OF HAWAII
DEPARTMENT OF TRANSPORTATION
HIGHWAYS DIVISION
"AS-BUILT"
PLANS FOR
GUARD RAIL AND SHOULDER IMPROVEMENTS
ON ROUTE 99
MILILANI TO WEED JUNCTION
FED. AID PROJECT NO. HES-099-1(8)

DISTRICTS OF EWA, WAHIAWA AND WAIALUA
ISLAND OF OAHU

FED. ROAD DIST. NO.	STATE	FED. AID PROJ. NO.	FISCAL YEAR	SHEET NO.	TOTAL SHEETS
HAWAII	HAW.	HES-099-1(8)	1985	1	43

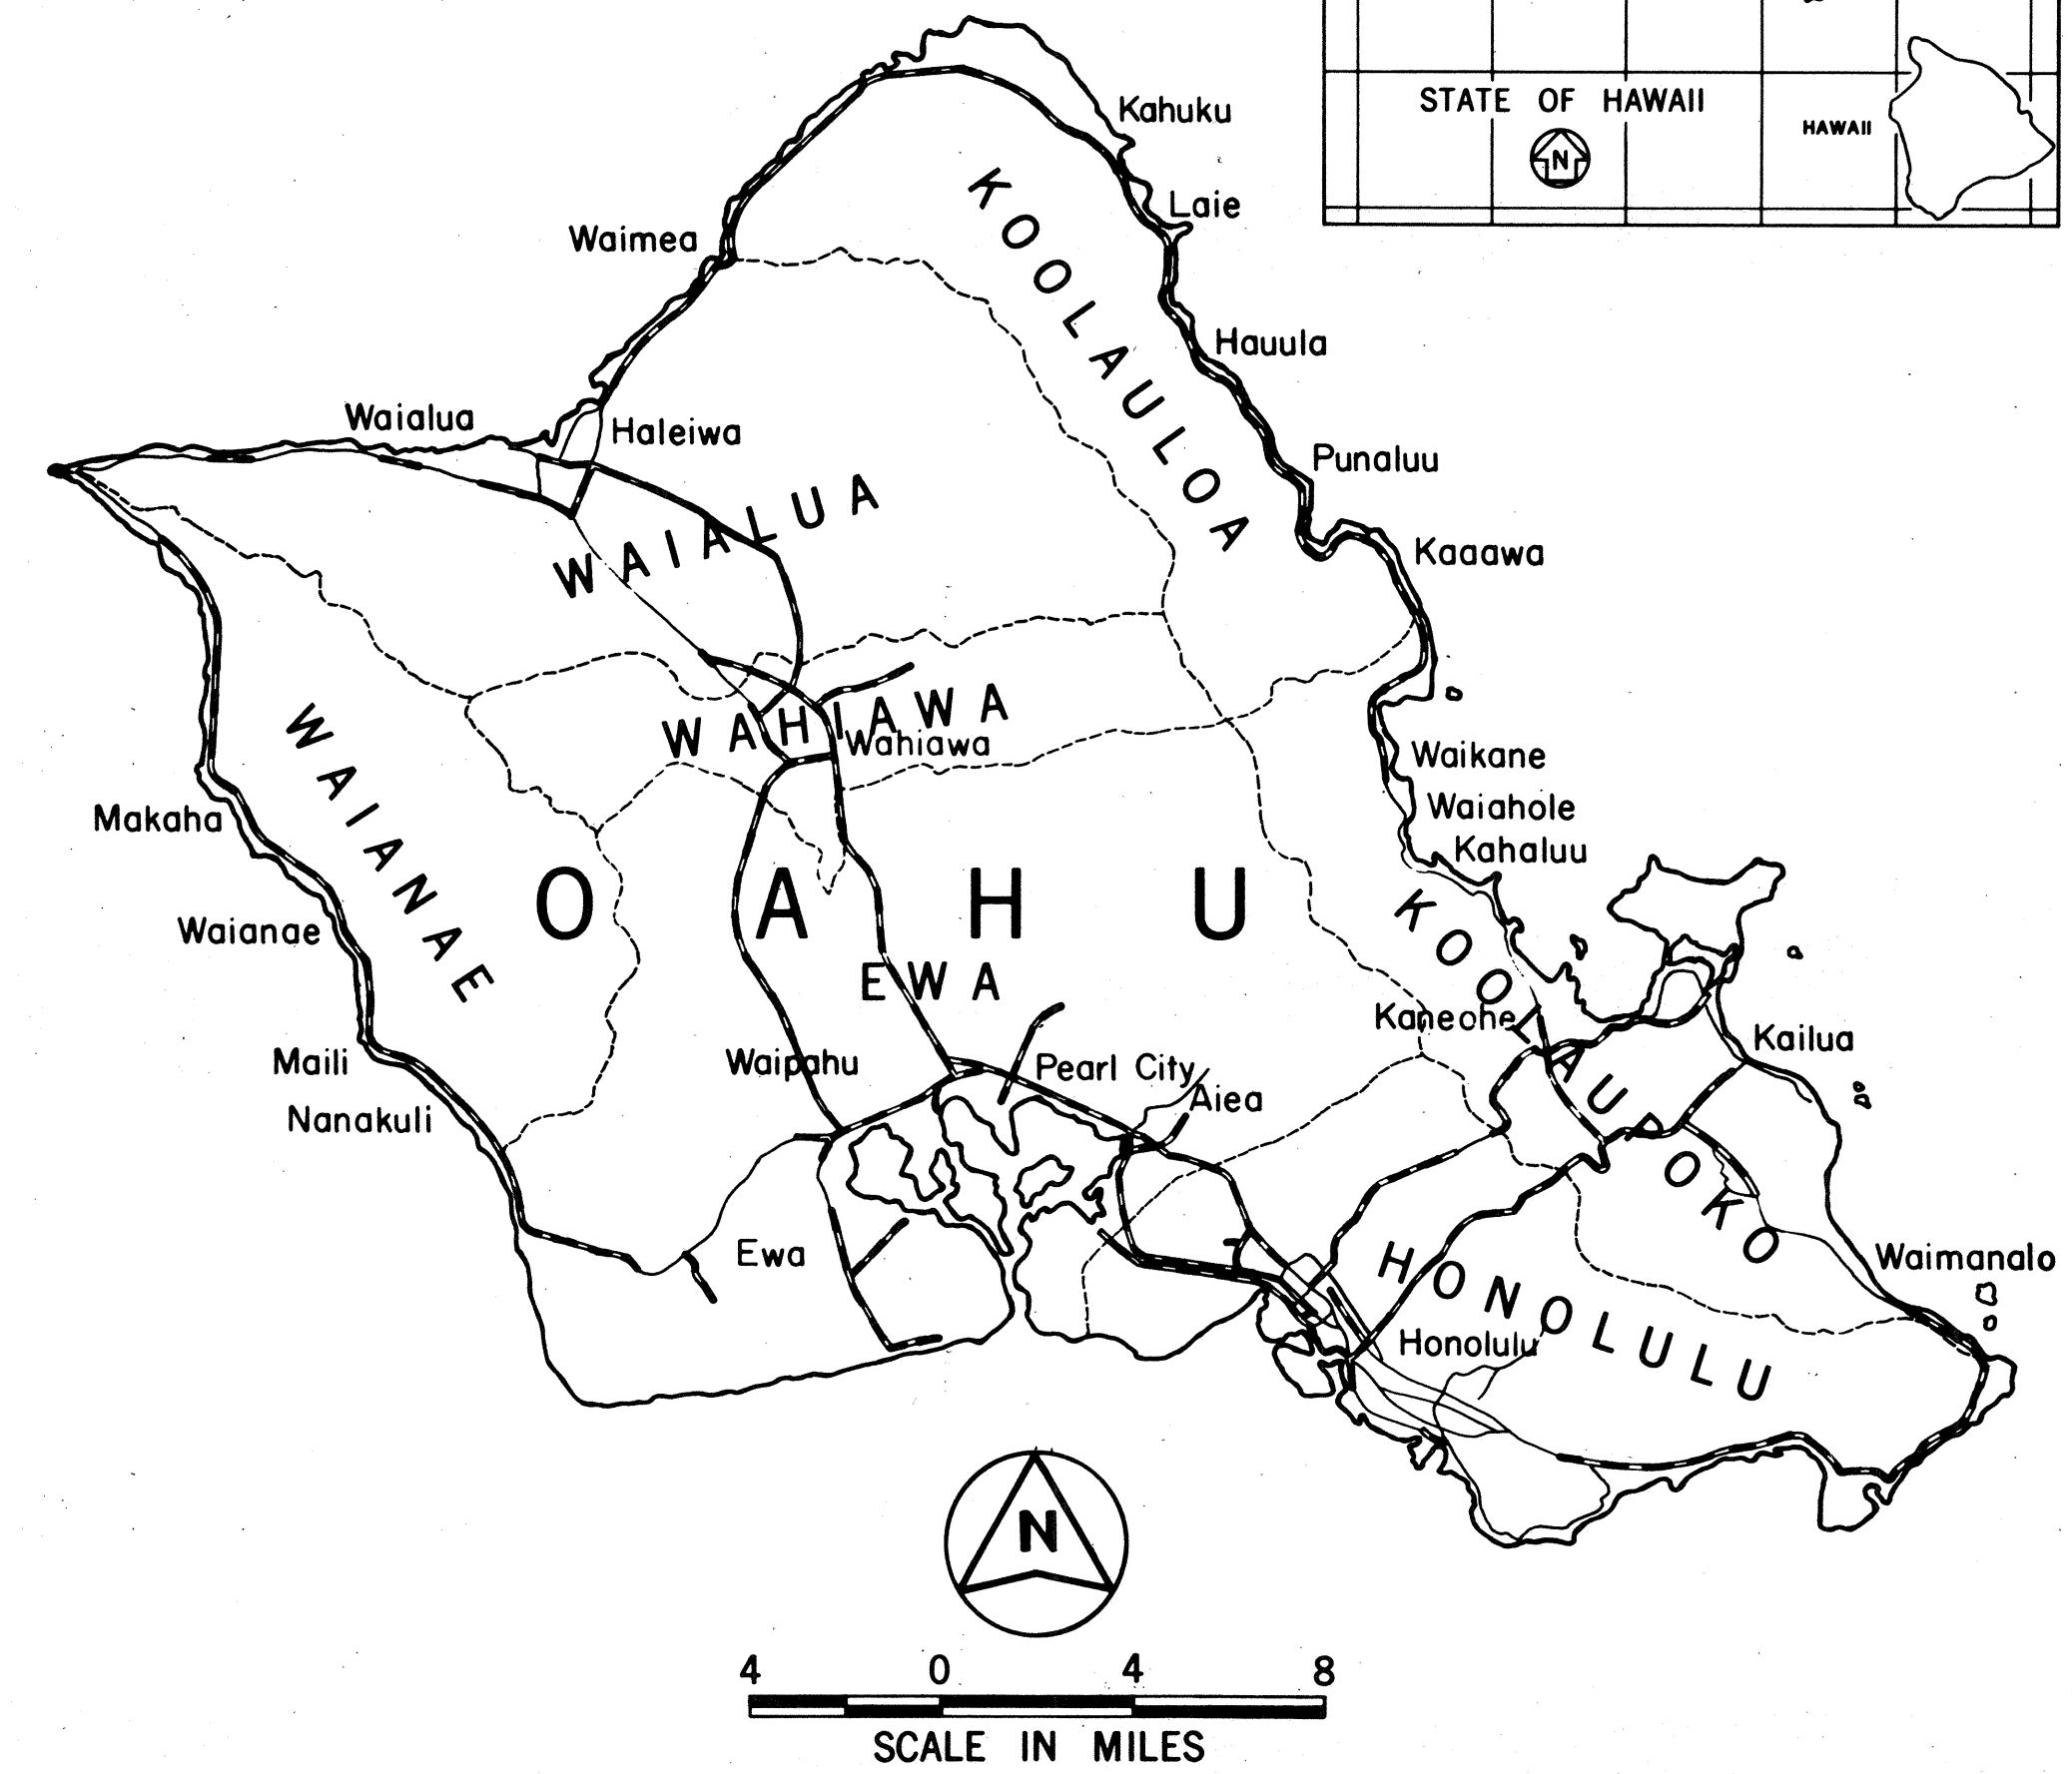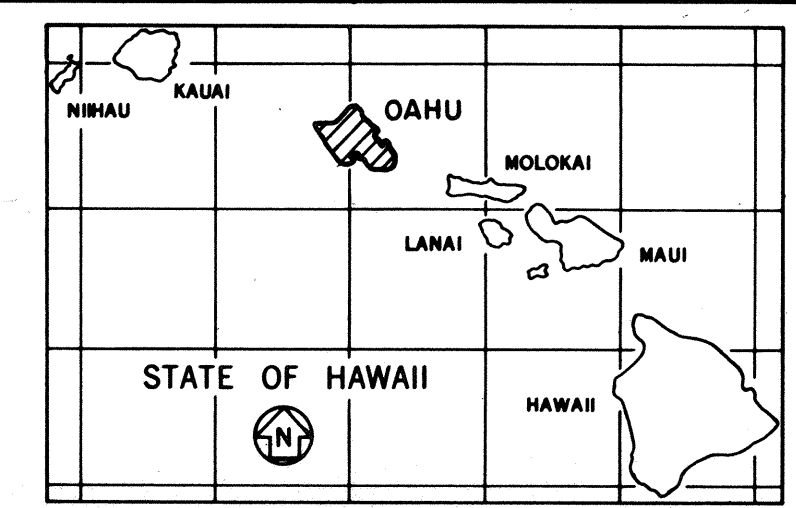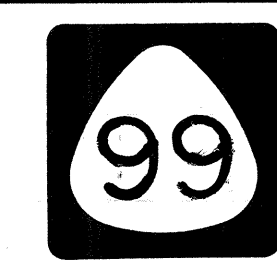

— — — — — FEDERAL AID PROJECTS PREVIOUSLY CONSTRUCTED OR UNDER CONSTRUCTION

CHANGES MADE DURING CONSTRUCTION HAVE BEEN INCORPORATED ON THESE PLANS EXCEPT CHANGES IN THE ORIGINAL THEORETICAL QUANTITIES. FOR ACTUAL QUANTITIES, REFER TO PROJECT LEDGER AND/OR COMPUTATION BOOK.

Ronald N. Kan 7/14/88
RESIDENT ENGINEER DATE

DEPARTMENT OF TRANSPORTATION
FEDERAL HIGHWAY ADMINISTRATION
APPROVED: [Signature] 4/8/85
DIVISION ADMINISTRATOR DATE

DEPARTMENT OF TRANSPORTATION
STATE OF HAWAII
APPROVED: [Signature] 7/24/85
DIR. OF TRANSPORTATION DATE