	INDEX TO DRAWINGS
SHEET NO.	DESCRIPTION
	TITLE SHEET
2-4	PLANS & GENERAL NOTES
5-6	TYPICAL DETAILS OF WHEEL CHAIR RAMPS
7-12	STANDARD DETAILS
<i>y</i>	
,	
1	
To see	
PATE AND AND ADDRESS OF THE PATE AND ADDRESS OF THE PA	
· ·	

**548-7490** PHONE

A. Nishimura P. S. & E. BY

STATE OF HAWAII

TRANSPORTATION DEPARTMENT OF HIGHWAYS DIVISION HONOLULU, HAWAII


"AS-BUILT"

PLANS FOR


KAHEKILI HIGHWAY TRAFFIC SIGNAL IMPROVEMENTS KEAAHALA ROAD TO HAIKU ROAD


PROJECT NO. 83G-01-85

DISTRICT OF KOOLAUPOKO ISLAND OF OAHU

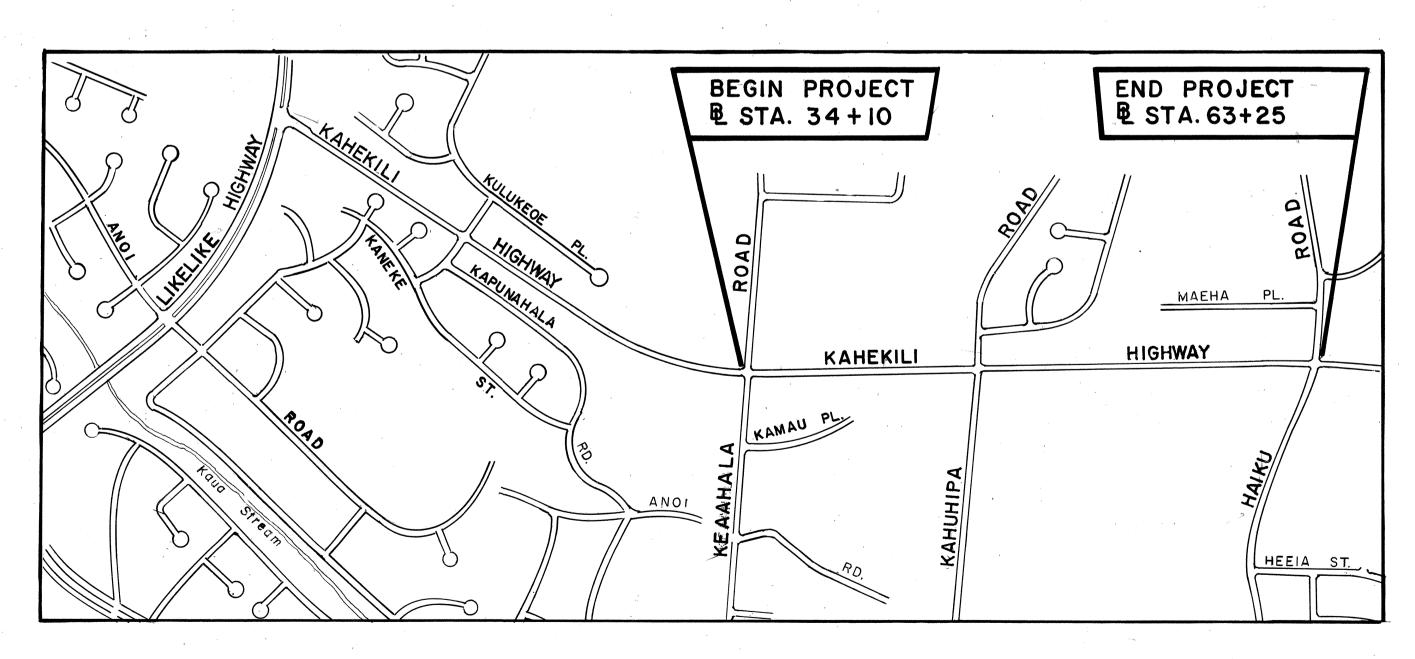

LAYOUT PLAN

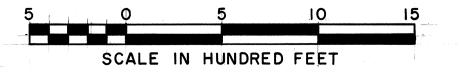

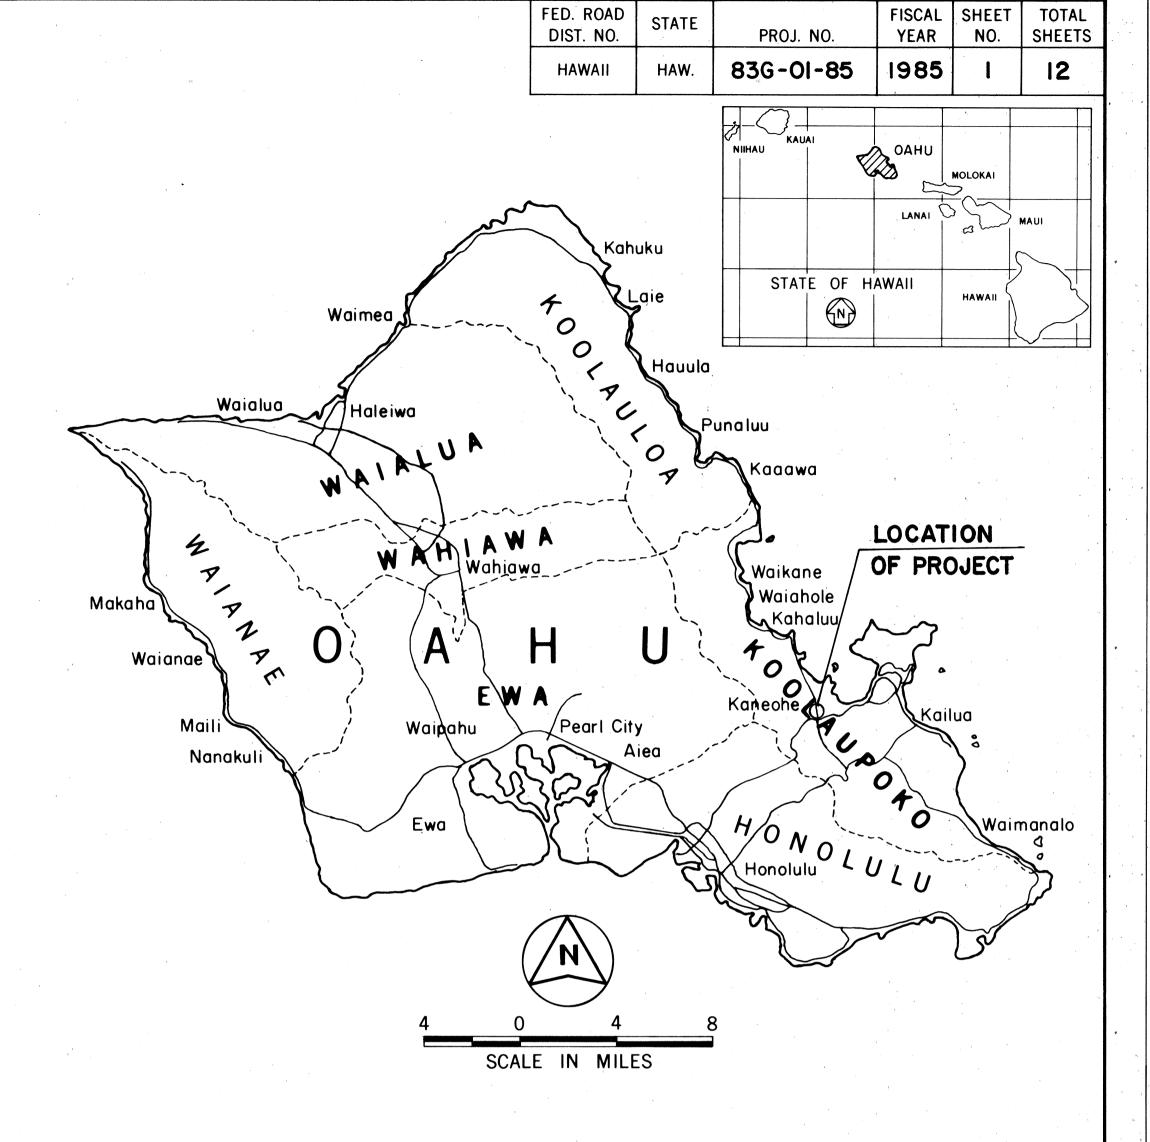

CHANGES MADE DURING CONSTRUCTION HAVE BEEN INCORPORATED ON THESE PLANS EXCEPT CHANGES IN THE ORIGINAL THEORETICAL QUANTITIES. FOR ACTUAL QUANTITIES, REFER TO PROJECT LEDGER AND/OR COMPUTATION BOOK.

RESIDENT ENGINEER

DEPARTMENT OF TRANSPORTATION STATE OF HAWAII APPROVED:



DIR. OF TRANSPORTATION