

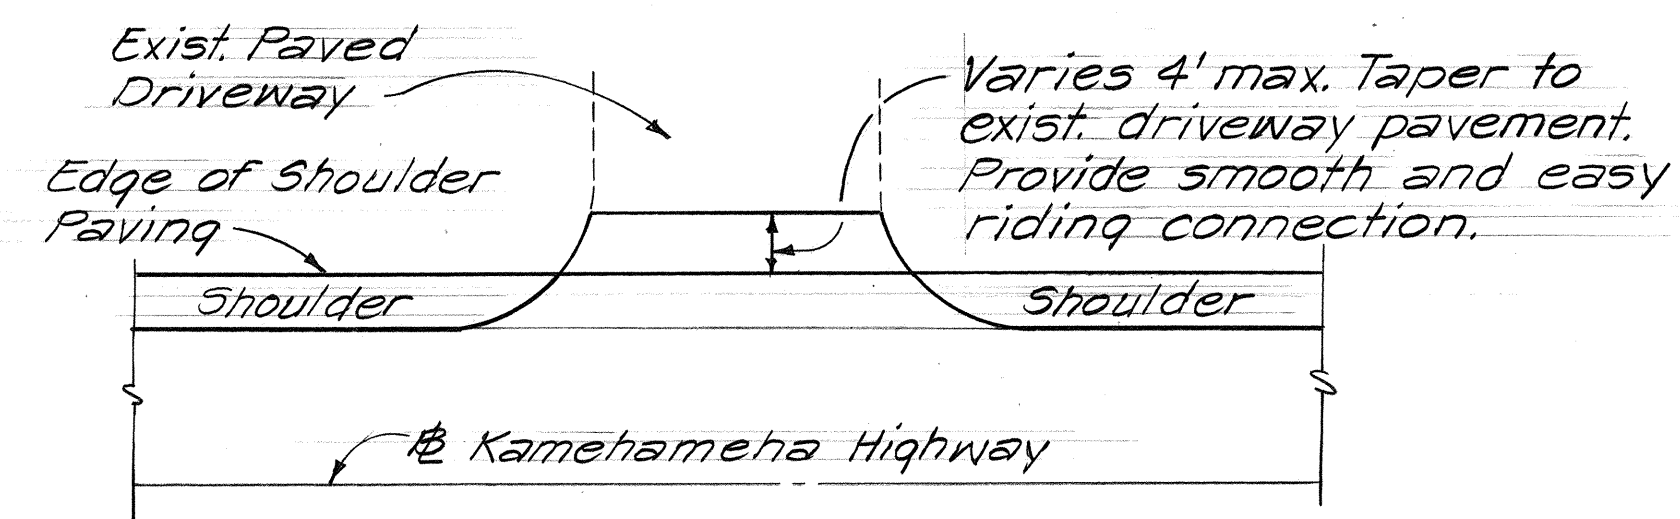


FED. ROAD DIST. NO.	STATE	PROJ. NO.	FISCAL YEAR	SHEET NO.	TOTAL SHEETS
HAWAII	HAW.	83C-01-86M	1986	5	40

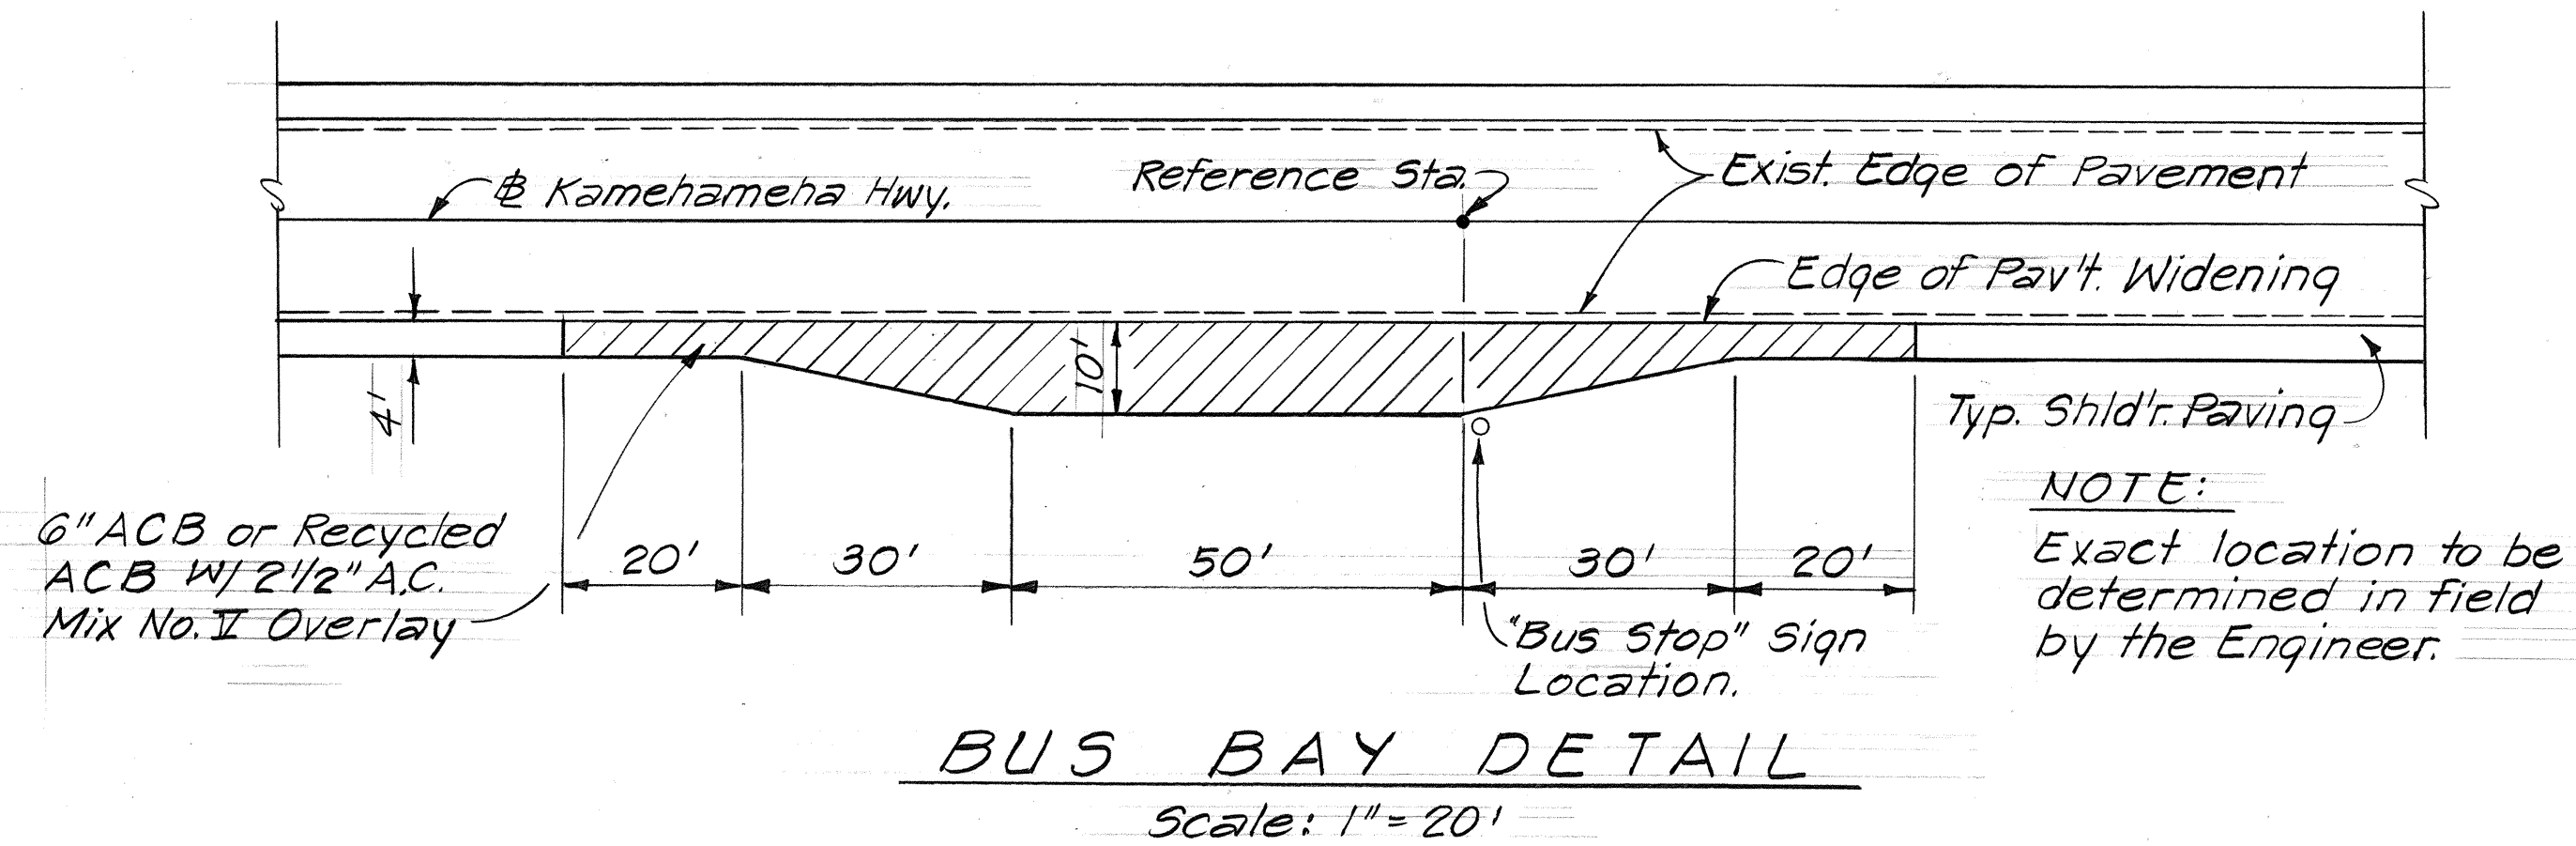


PLAN

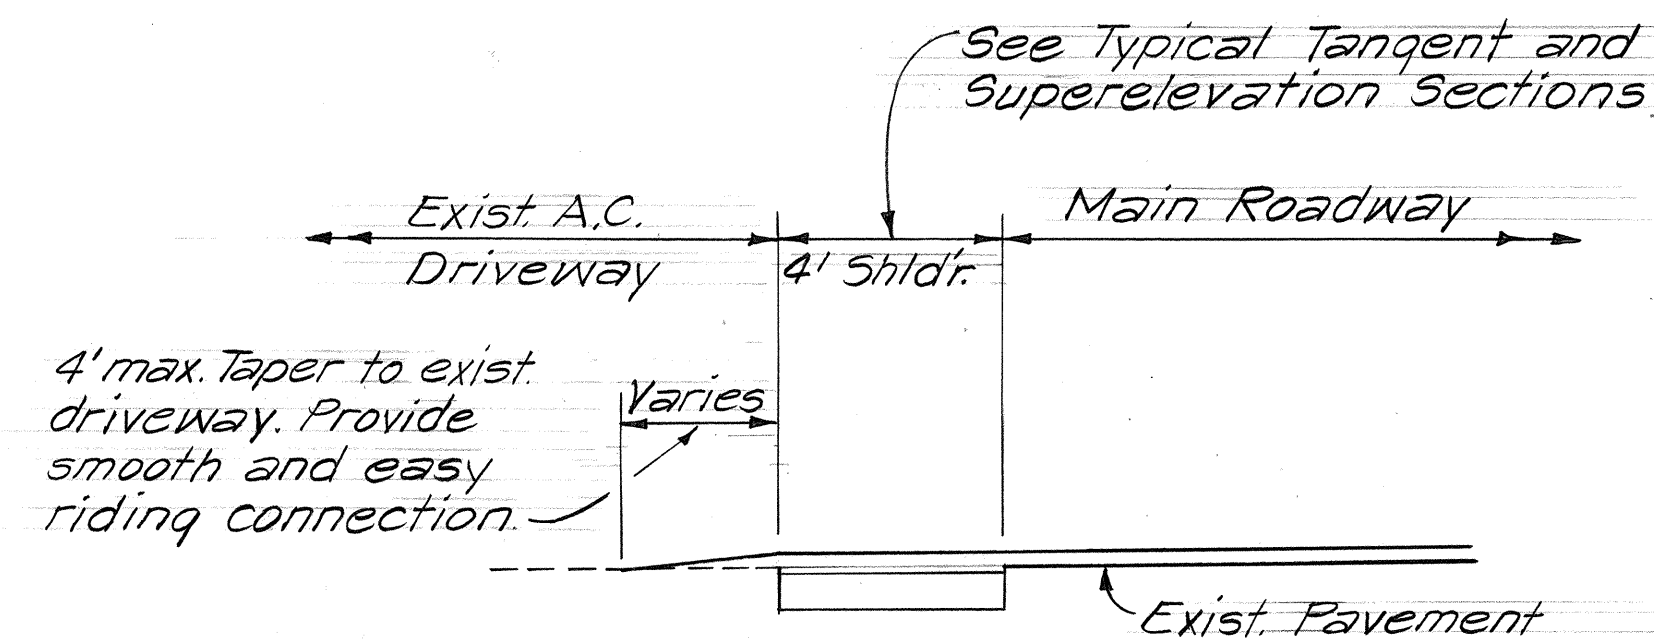

SECTION

DRIVEWAY CONNECTION DETAIL
Not to Scale

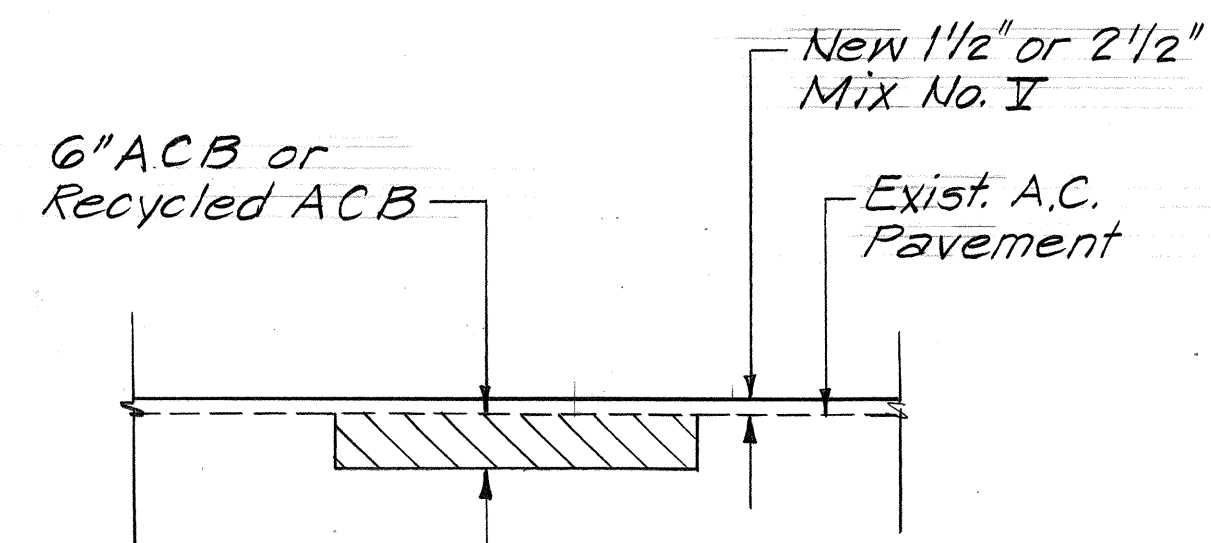

RECONSTRUCTION AREA SECTION
Not to Scale

STATE OF HAWAII	
DEPARTMENT OF TRANSPORTATION	
HIGHWAYS DIVISION	
MISCELLANEOUS DETAILS	
KAMEHAMEHA HIGHWAY RESURFACING	
Laiemaloo Bridge to Puuluana Street	
PROJECT No. 83C-01-86M	
Scale: As noted	Date: Oct, 1985
SHEET No. OF SHEETS	