

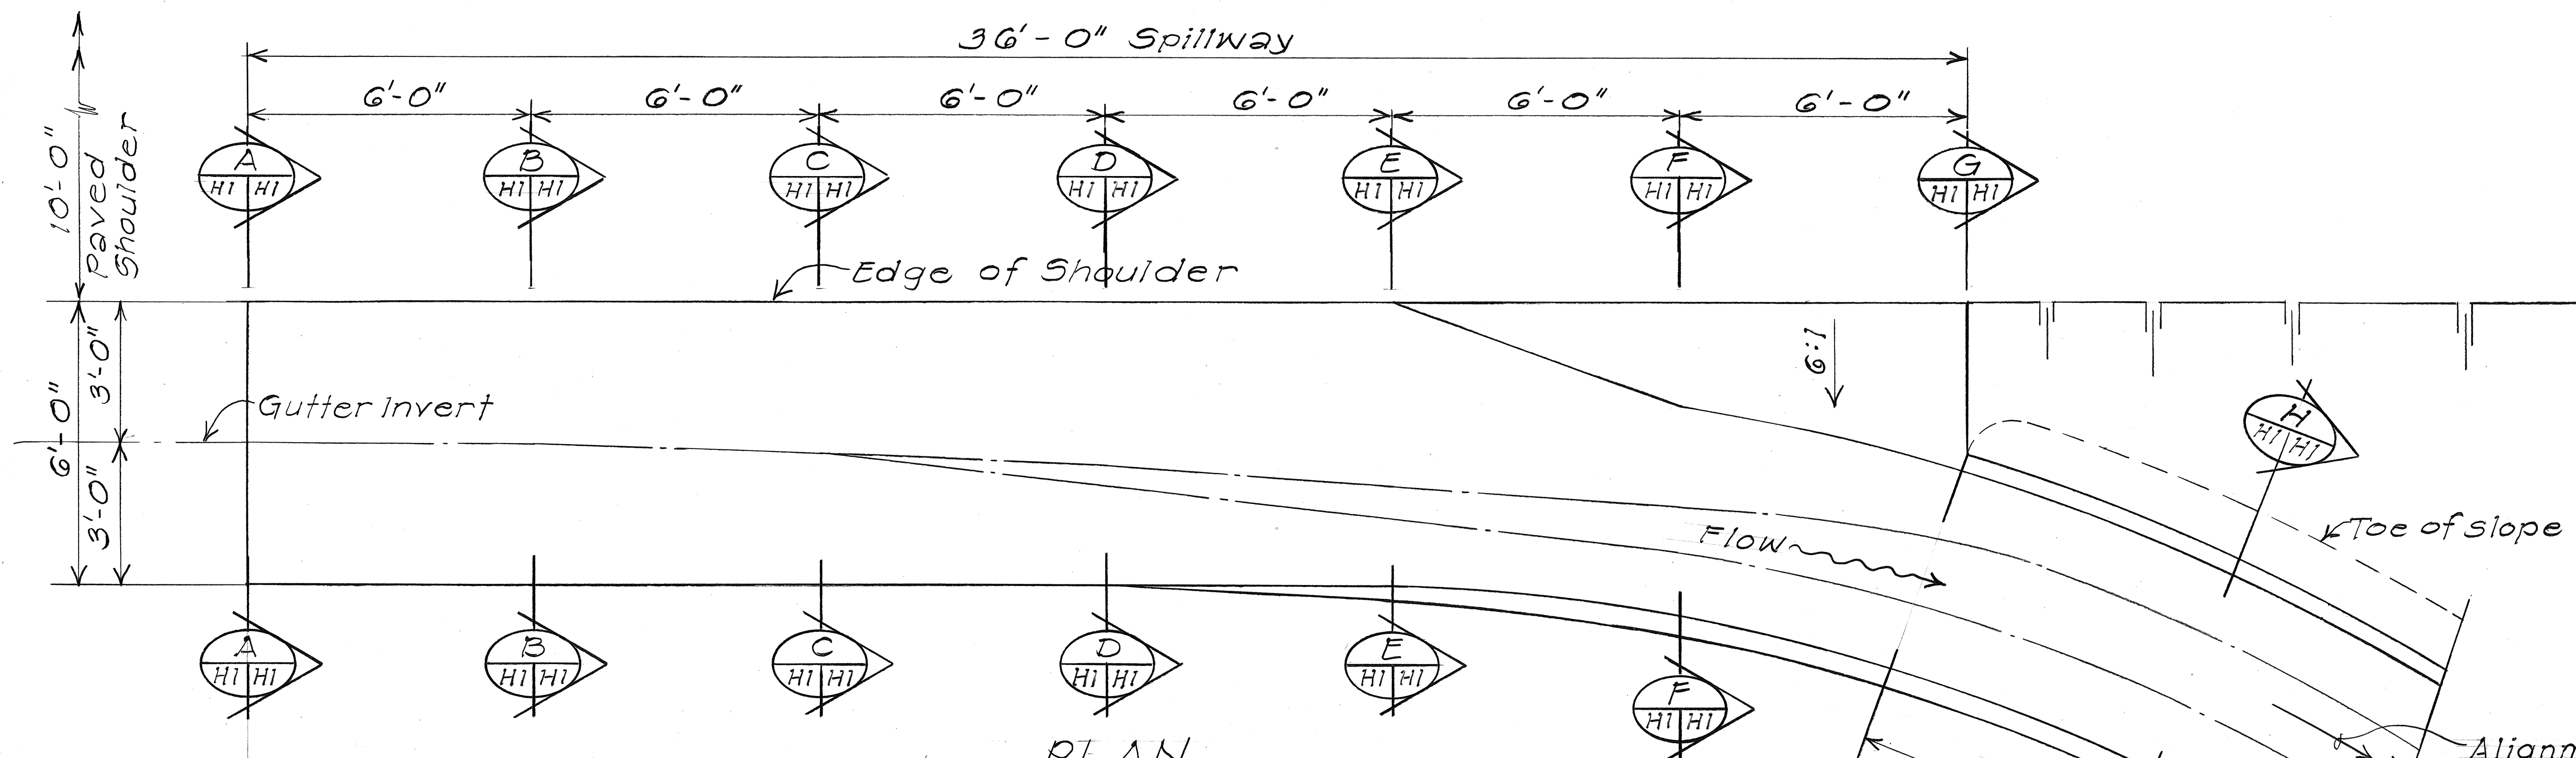
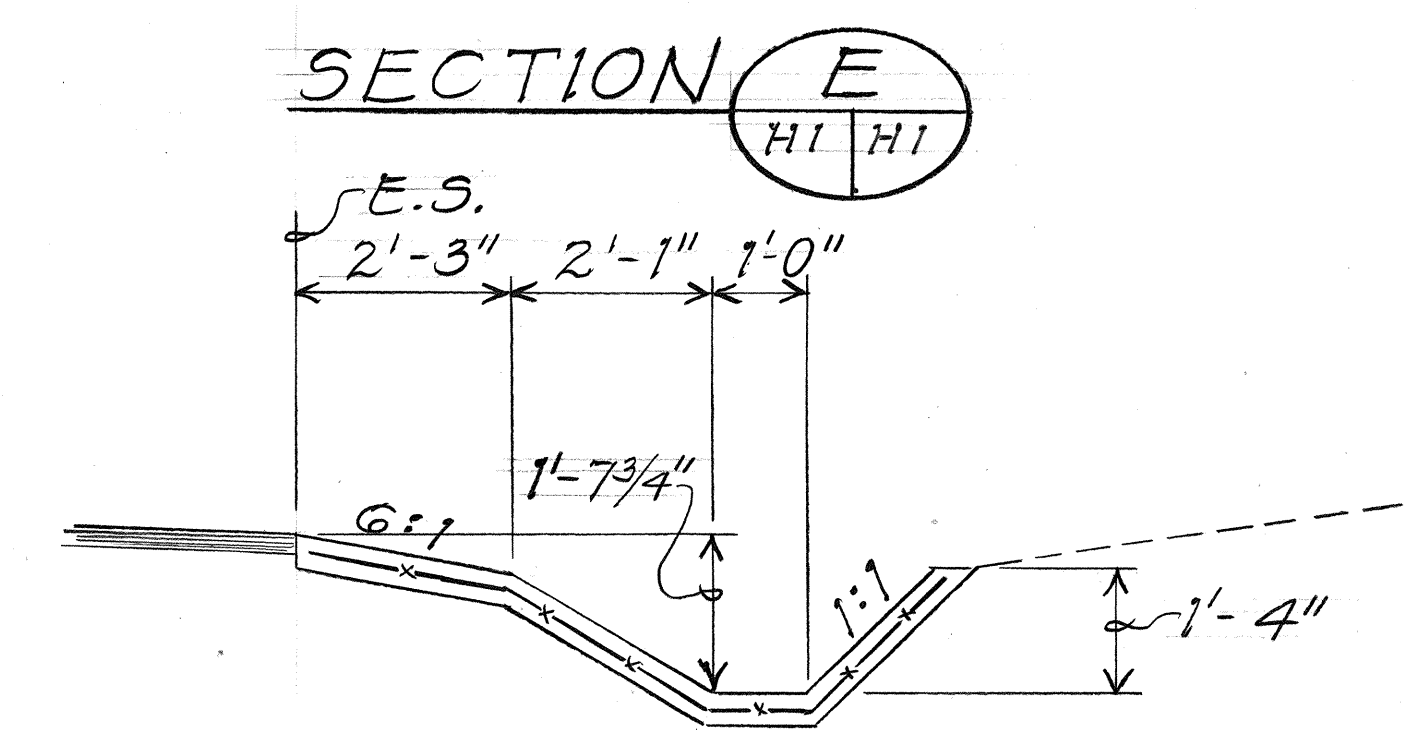
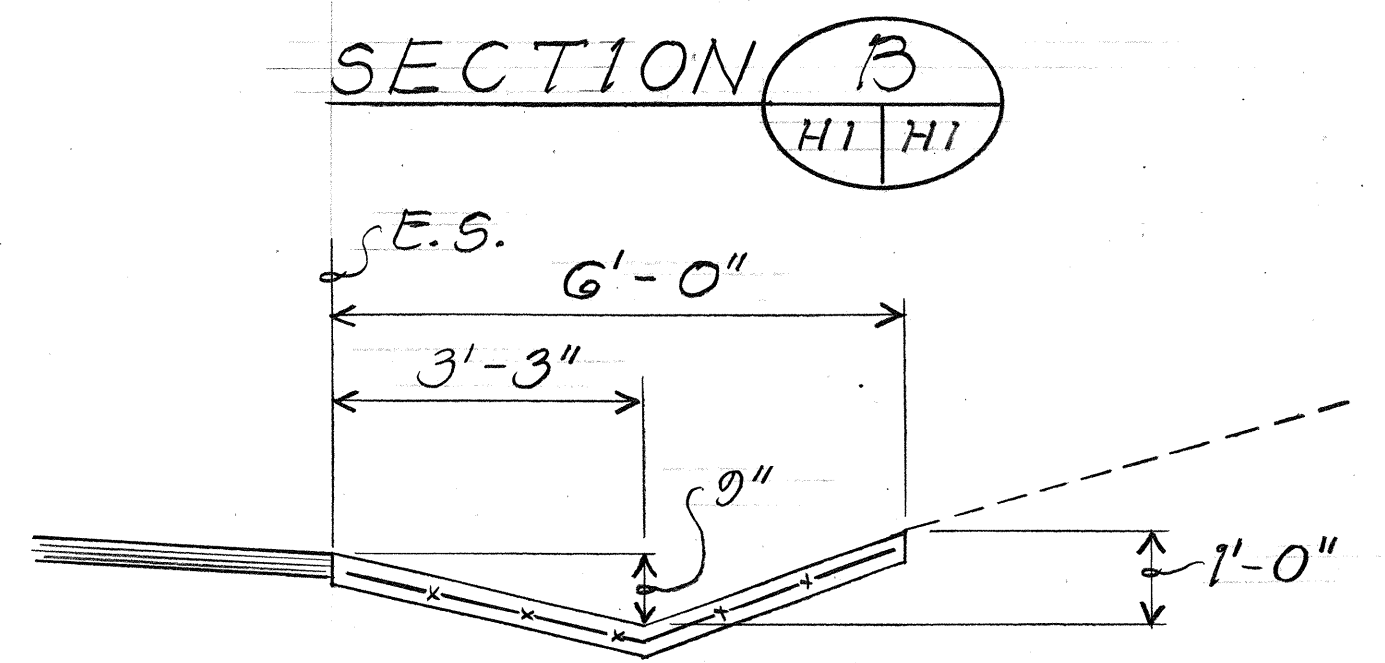
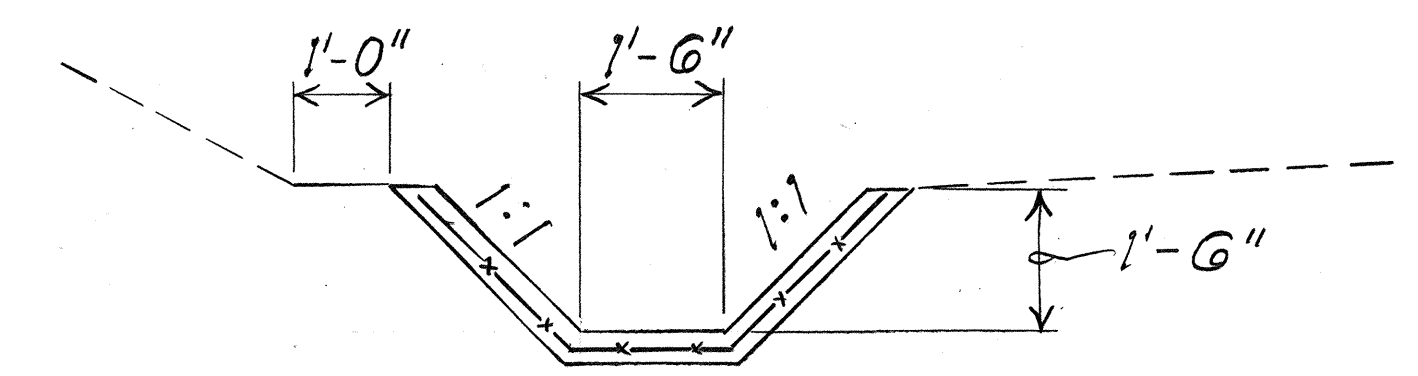
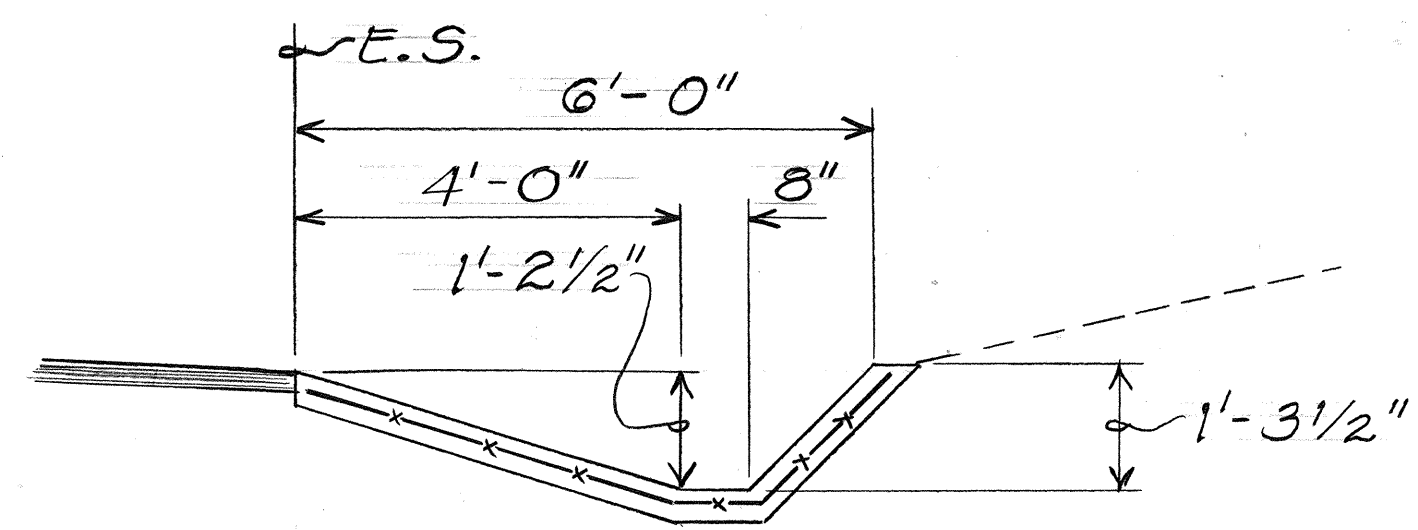
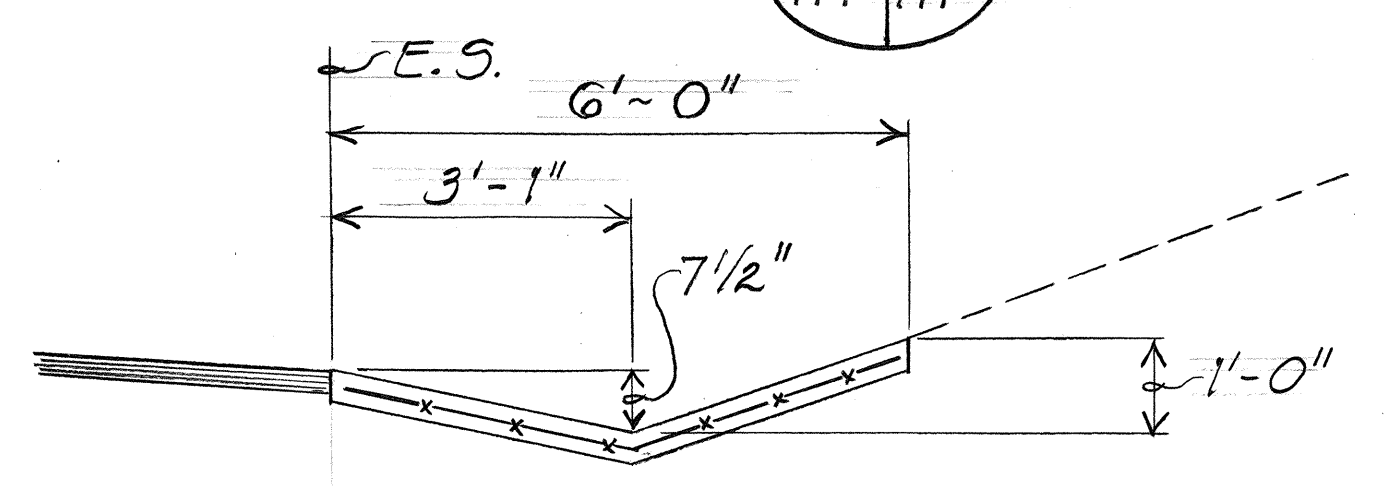
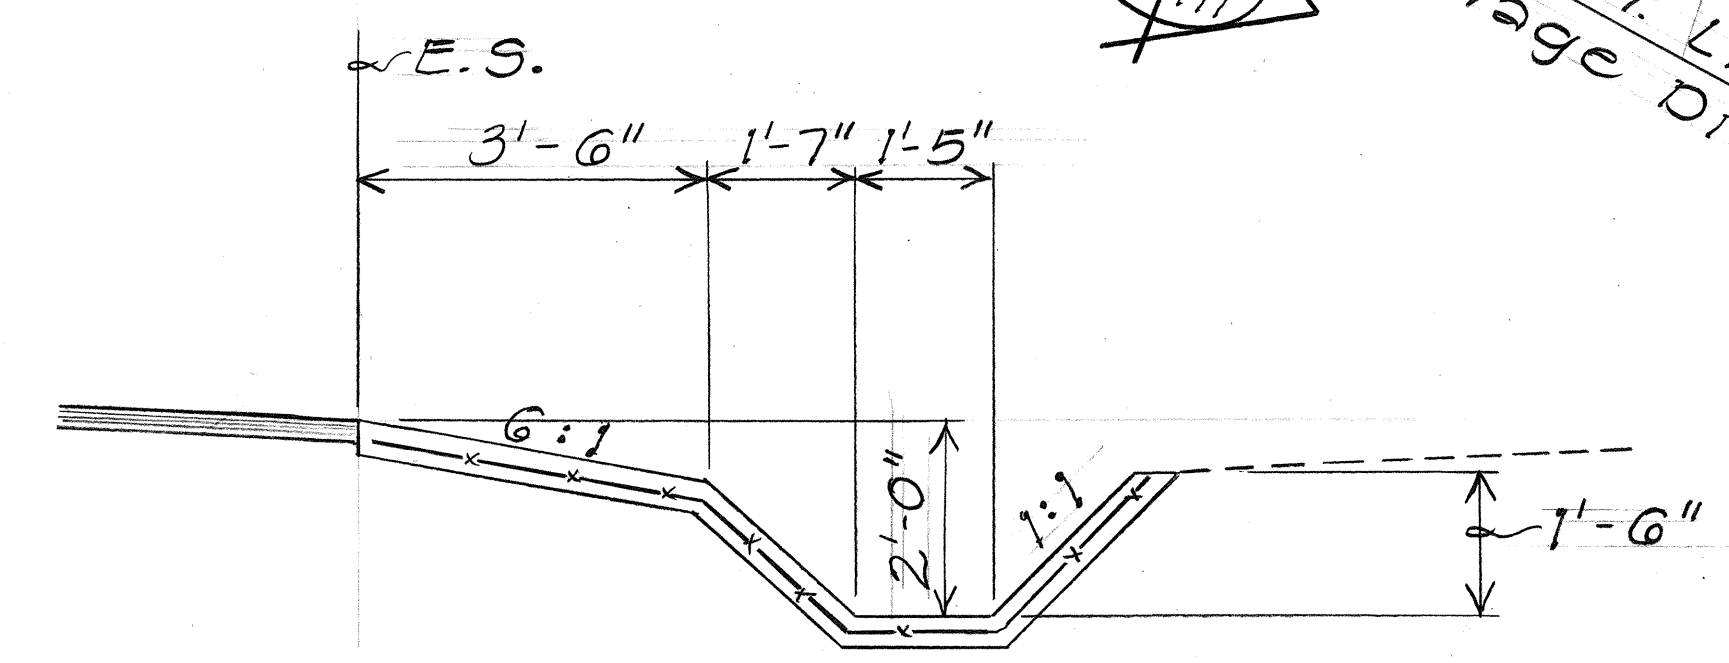


FED. ROAD DIST. NO.	STATE	PROJ. NO.	FISCAL YEAR	SHEET NO.	TOTAL SHEETS
HAWAII	HAW.	83EF-02-86	1986	19	52

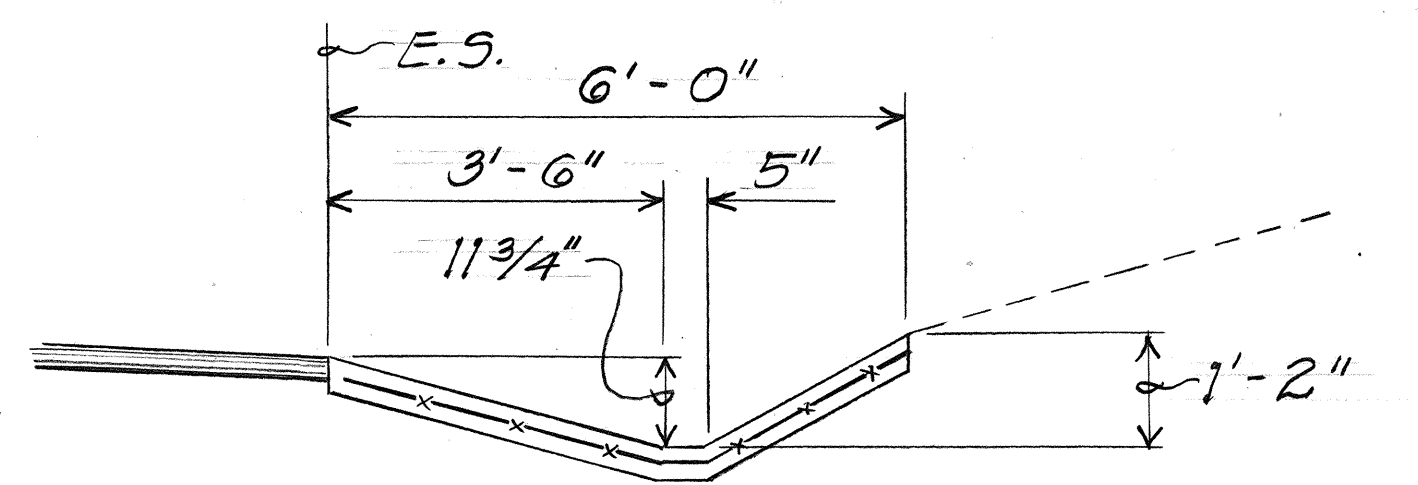

PLAN

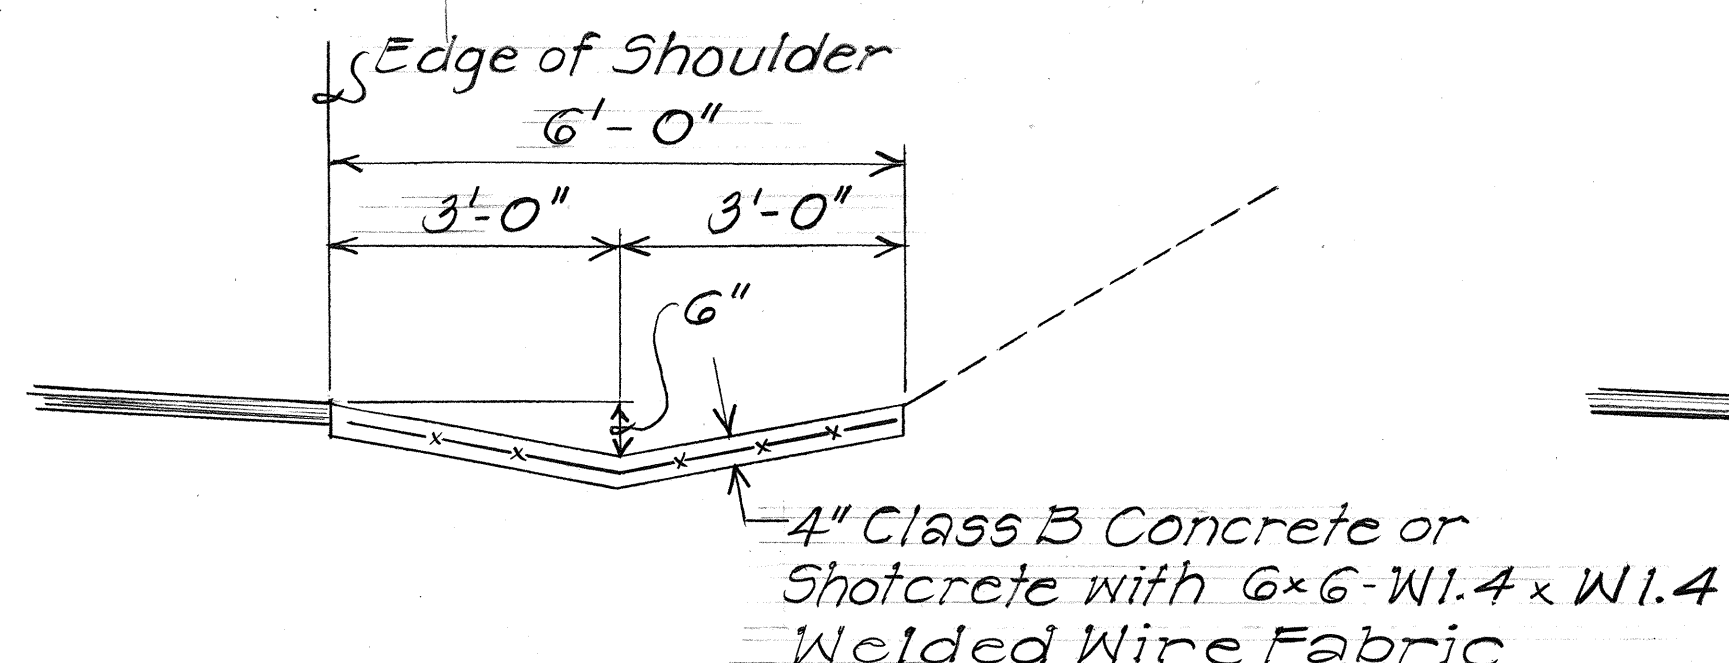

TYPICAL DETAILS OF CONCRETE SPILLWAY INLET

ORIGINAL PLAN	DATE
DRAWN BY	
DESIGNED BY	
CHECKED BY	
NO.	

STATE OF HAWAII
DEPARTMENT OF TRANSPORTATION
HIGHWAYS DIVISION

DRAINAGE DETAILS

KAHEKILIA KAMEHAMEHA HIGHWAY
RECONSTRUCTION & RESURFACING
Proj. No. 83EF-02-86
Scale: 1/2" = 1'-0" Date: Jan., 1986
SHEET NO. H1 OF 1 SHEETS