

| INDEX TO DRAWINGS |   |
|-------------------|---|
| SHEET NO.         | DESCRIPTION                                   |
| 1                 | TITLE SHEET                                   |
| 2                 | GENERAL NOTES AND UTILITY NOTES               |
| 3 - 6             | TYPICAL SECTIONS, MISC. DETAILS AND SCHEDULES |
| 7 - 18            | PLANS   |
| 19                | DRAINAGE DETAILS                              |
| 20 - 22           | CULVERT EXTENSION PLANS AND DETAILS           |
| 23 - 25           | CULVERT EXTENSION TYPICAL DETAILS             |
| 26 - 32           | ROADWAY STANDARD DETAILS                      |
| 33 - 52           | SIGNING AND STRIPING PLANS AND DETAILS        |

Plan Sheet Nos. ① C0.51S-1 & C0.51S-2 are supplementary sheets to this project. TOTAL SHEET COUNT after "AS-BUILT" postings = 54 sheets.

STATE OF HAWAII

DEPARTMENT OF TRANSPORTATION

HIGHWAYS DIVISION

HONOLULU, HAWAII

"AS - BUILT"

PLANS FOR

KAHEKILI HIGHWAY

AND

KAMEHAMEHA HIGHWAY

RECONSTRUCTION AND RESURFACING

LIKELIKE HIGHWAY TO KAALAEA ROAD

PROJECT NO. 83EF - 02 - 86

DISTRICT OF KOOLAUPOKO

ISLAND OF OAHU

CHANGES MADE DURING CONSTRUCTION HAVE BEEN INCORPORATED ON THESE PLANS EXCEPT CHANGES IN THE ORIGINAL THEORETICAL QUANTITIES. FOR ACTUAL QUANTITIES, REFER TO PROJECT LEDGER AND/OR COMPUTATION BOOK.

*Don T. Hoge*


RESIDENT ENGINEER

8/11/86

DATE

FEDERAL AID PROJECTS PREVIOUSLY CONSTRUCTED OR UNDER CONSTRUCTION

PROJECT NO. 83EF - 02 - 86

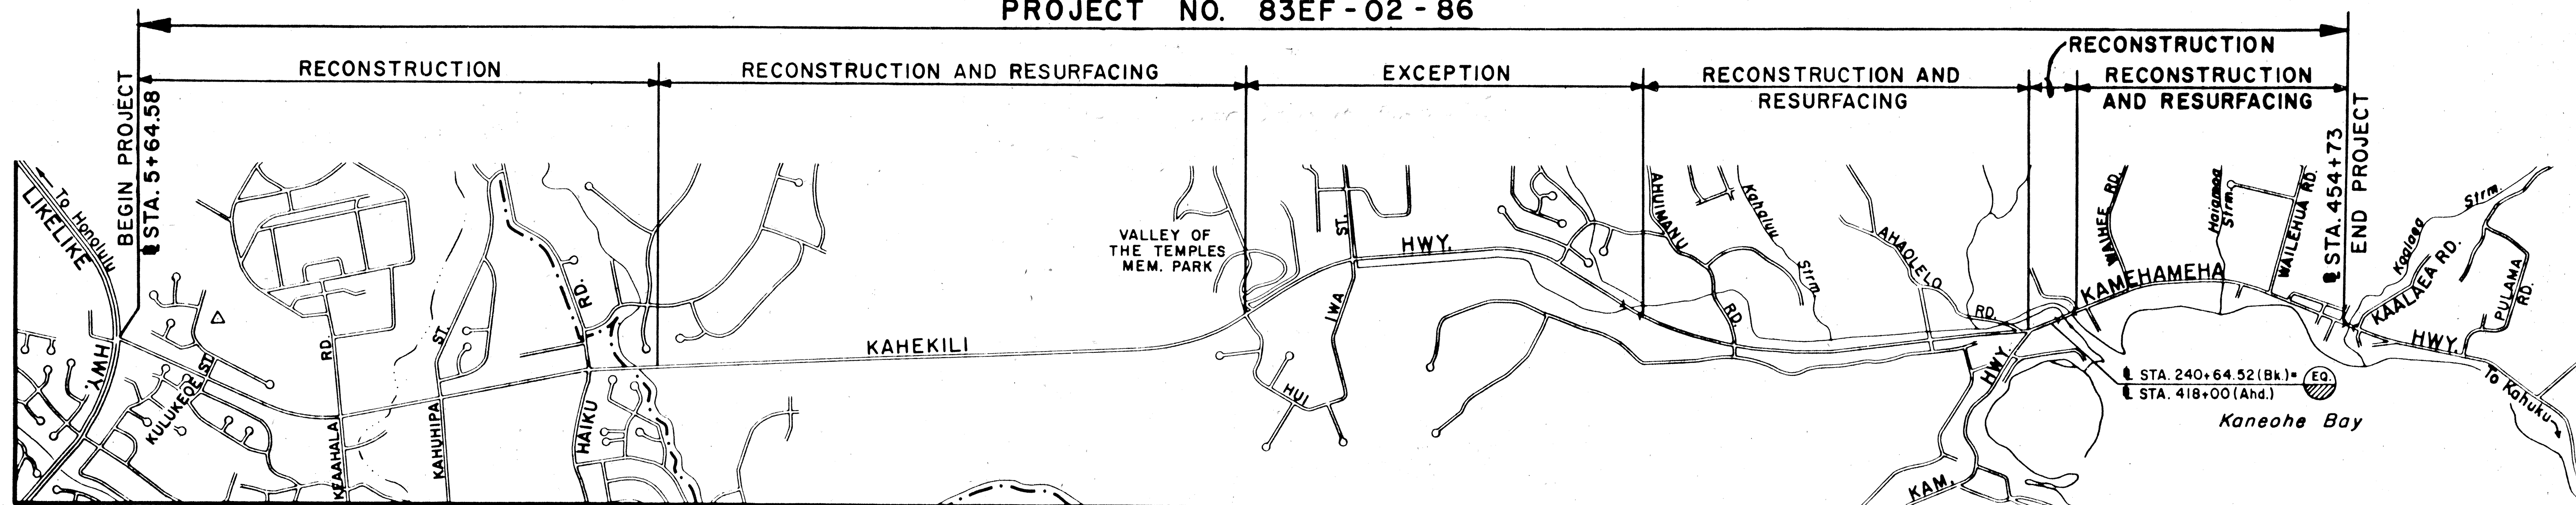

0 1 2 3

SCALE IN THOUSAND FEET

LAYOUT PLAN

|                         |      |       |
|-------------------------|------|-------|
| GROSS LENGTH OF PROJECT | 5.15 | MILES |
| LESS EXCEPTION          | 0.94 | MILES |
| NET LENGTH OF PROJECT   | 4.21 | MILES |

DEPARTMENT OF TRANSPORTATION

STATE OF HAWAII

APPROVED:




*Charles D. Poon*

7/20/86

DIR. OF TRANSPORTATION

DATE

| FED. ROAD DIST. NO. | STATE | PROJ. NO.      | FISCAL YEAR | SHEET NO. | TOTAL SHEETS |
|---------------------|-------|----------------|-------------|-----------|--------------|
| HAWAII              | HAW.  | 83EF - 02 - 86 | 1986        | 1         | 52           |

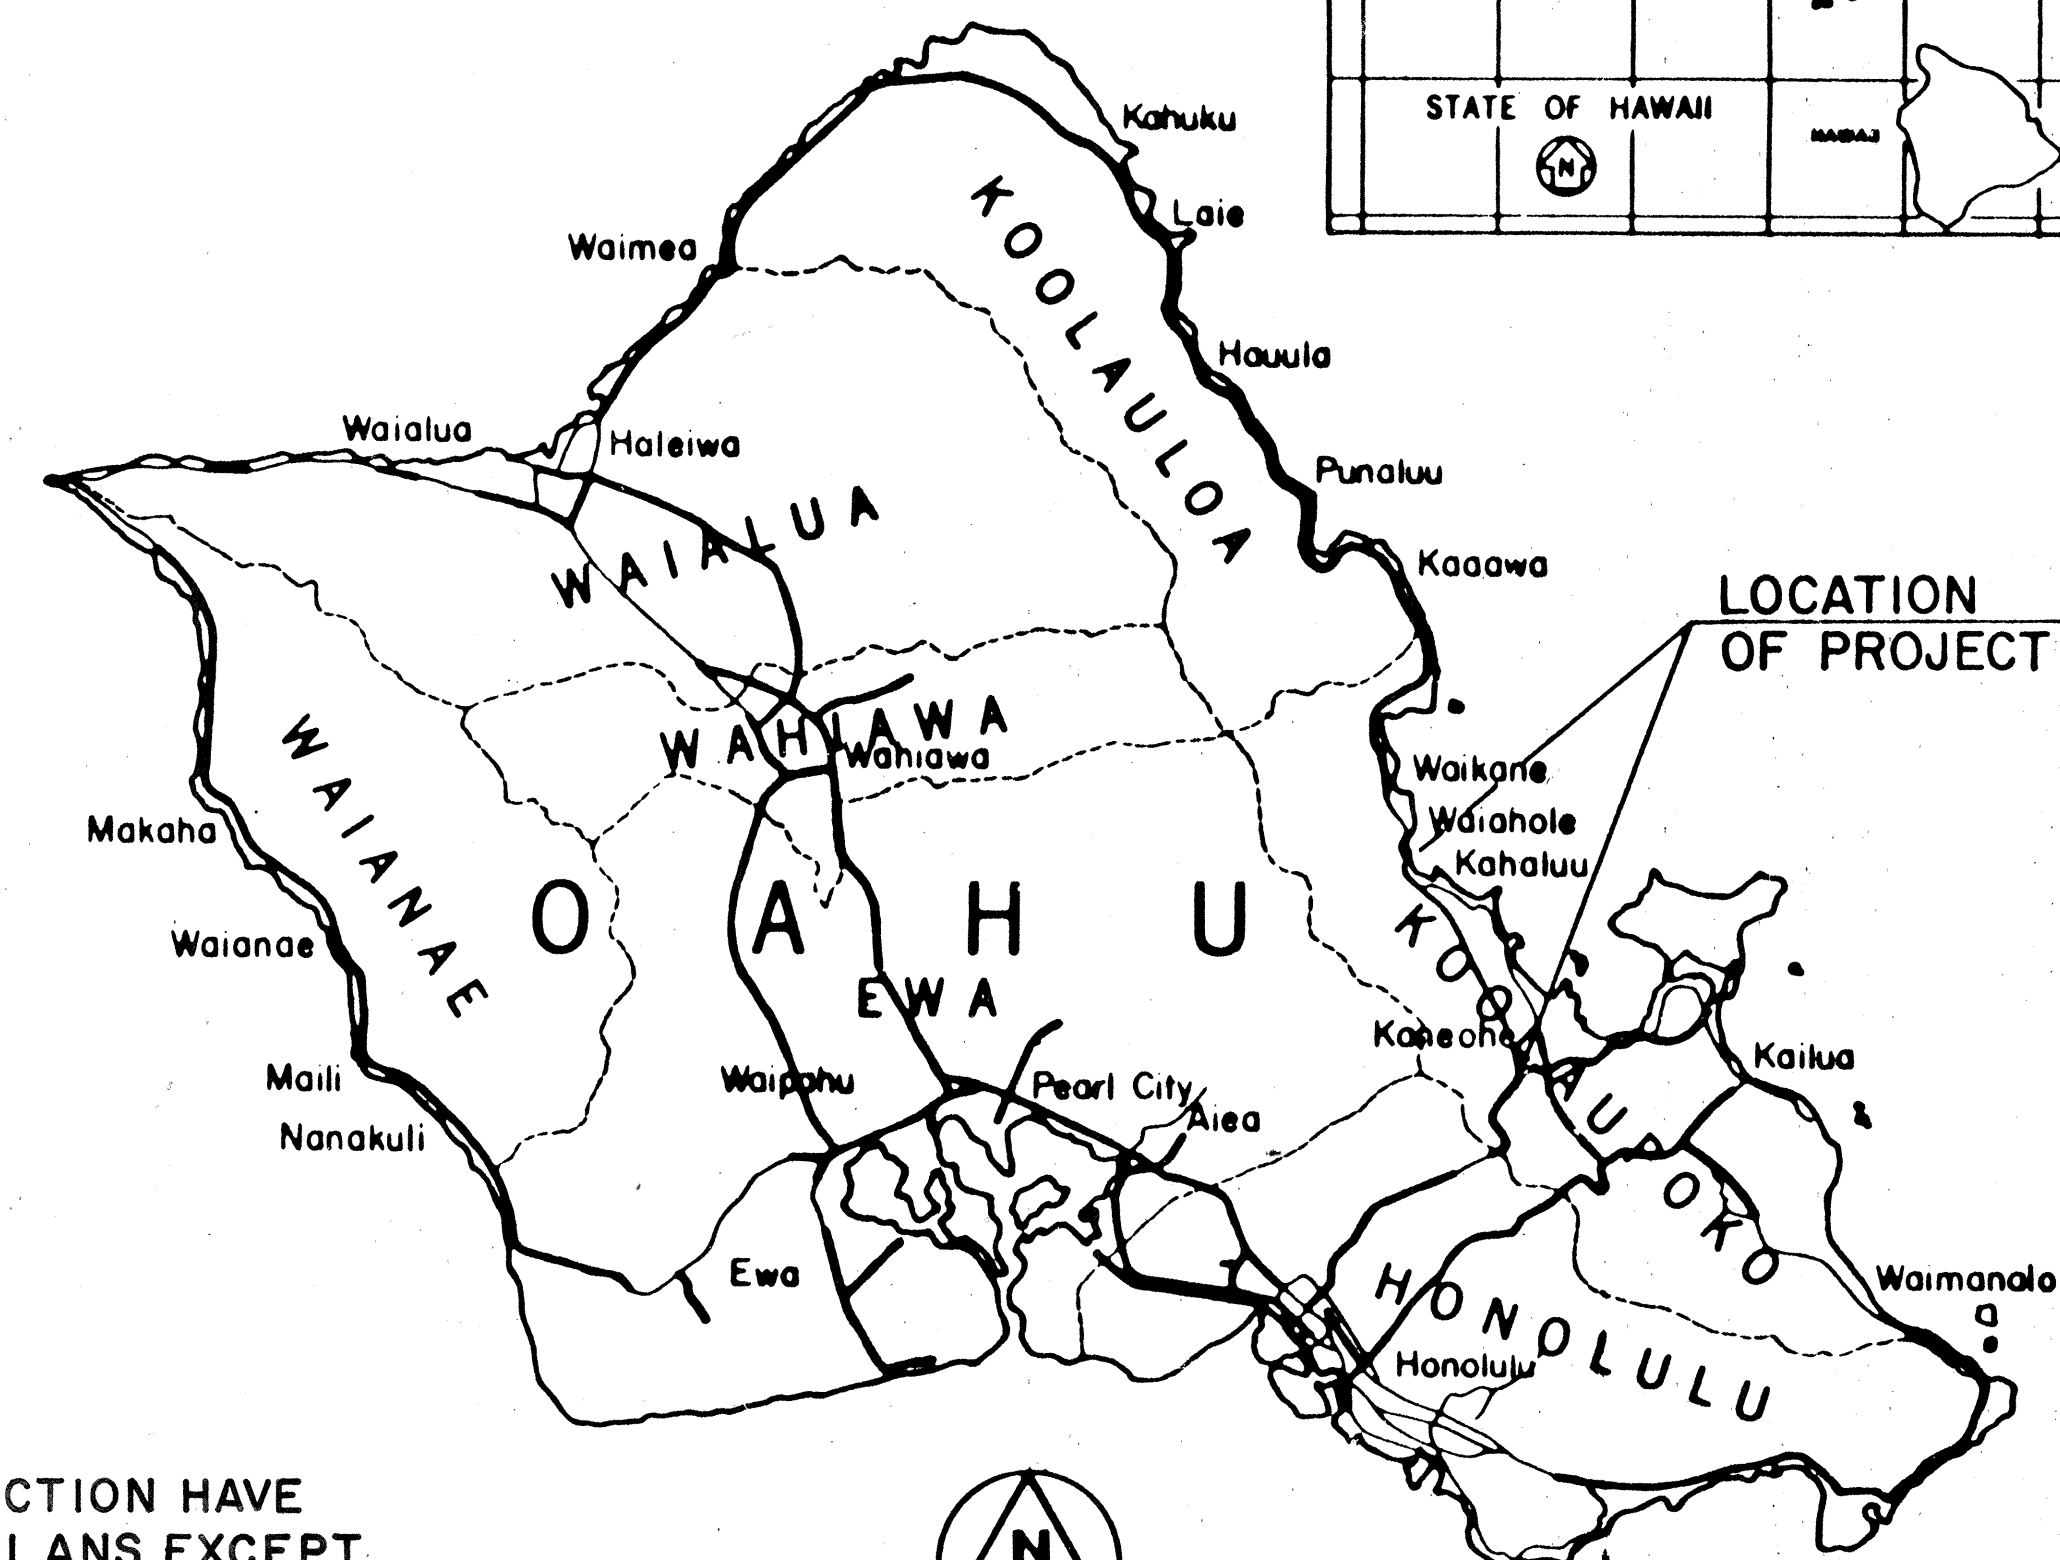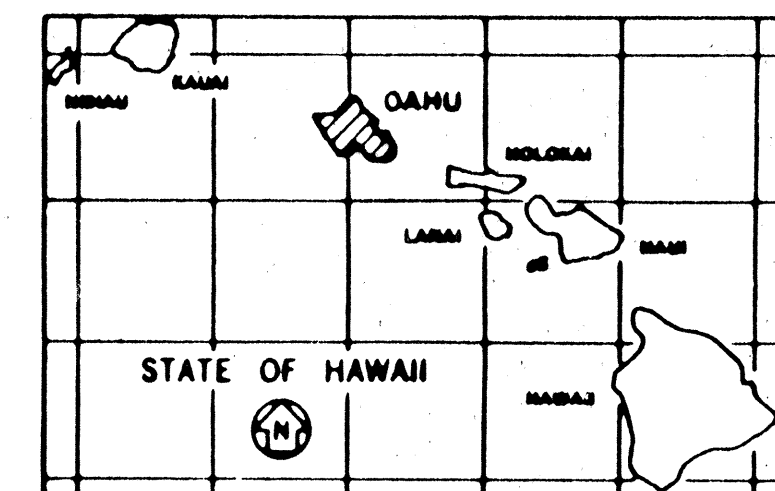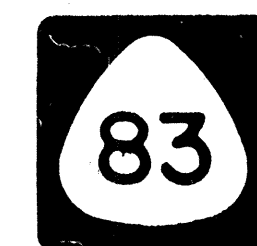

4 0 4 8

SCALE IN MILES

ALLAN T. NISHIMURA

DESIGNED BY

A. NISHIMURA

548-7490

PHONE

FEB. 1986

DATE