




FED. ROAD DIST. NO.	STATE	PROJ. NO.	FISCAL YEAR	SHEET NO.	TOTAL SHEETS
HAWAII	HAW.	83D-01-86M	1986	3	57

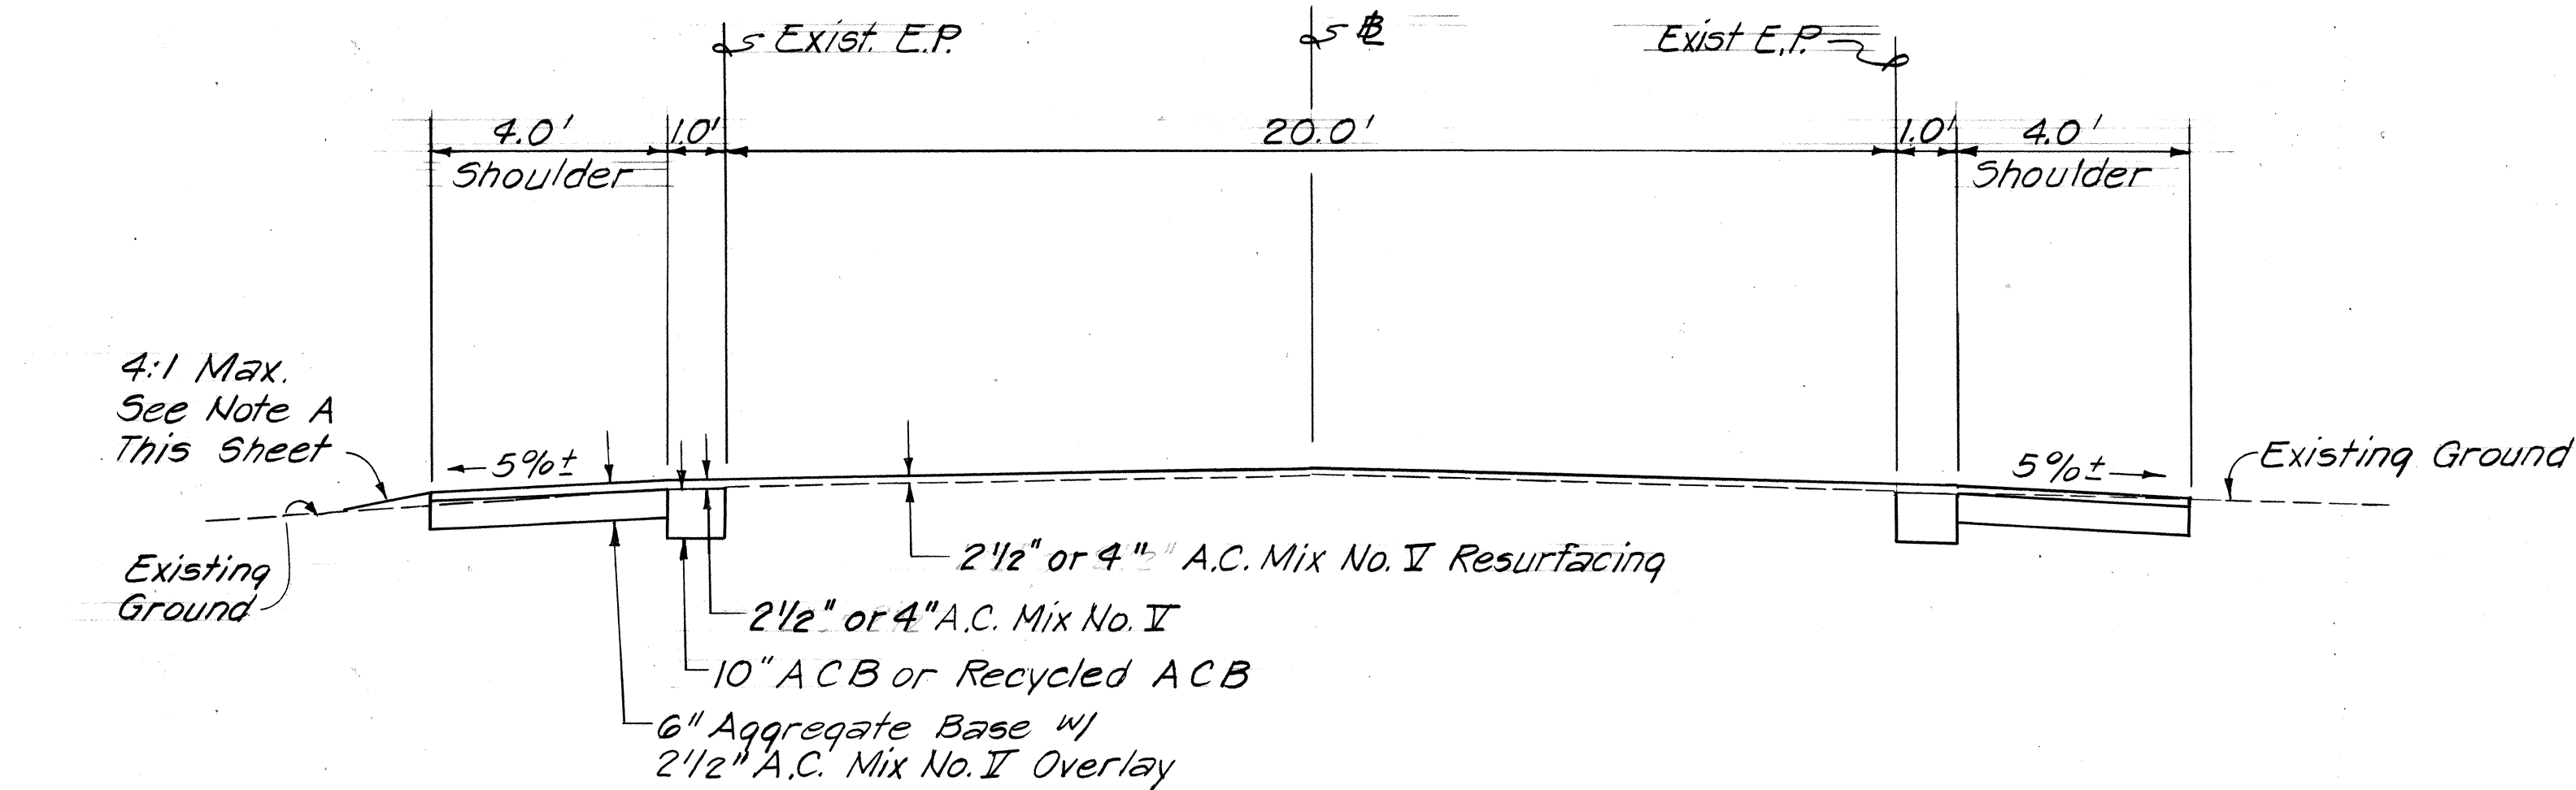


TYPICAL TANGENT SECTION
Not to Scale

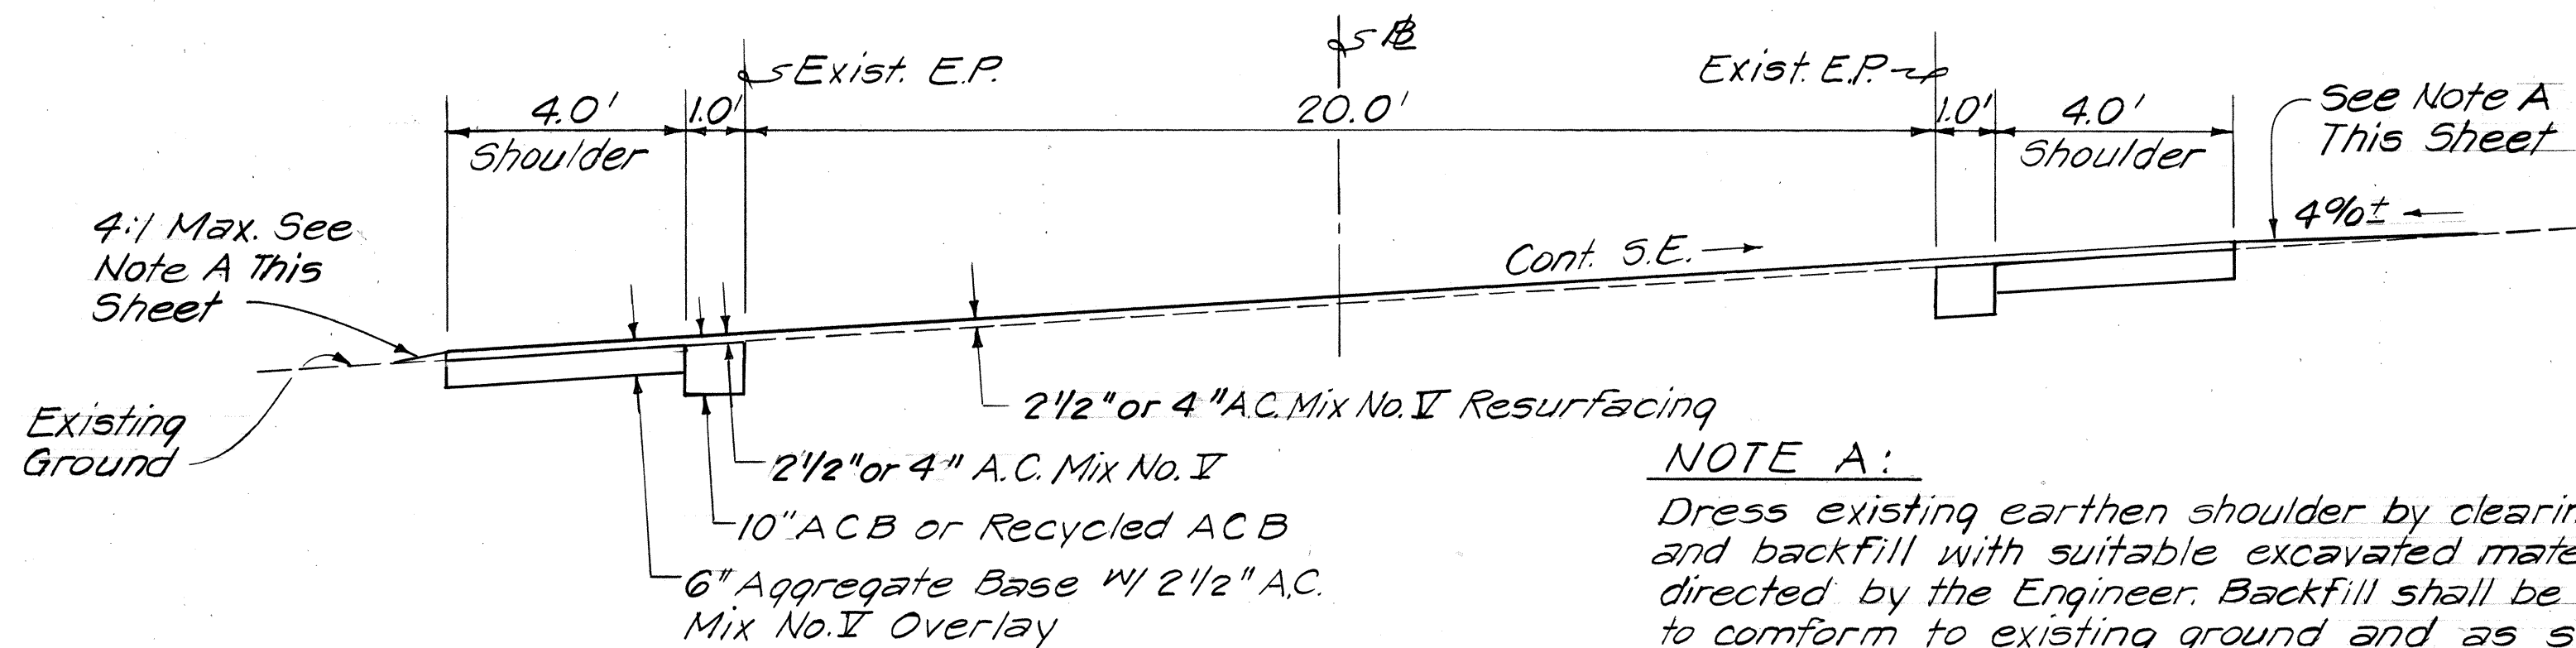


TYPICAL SUPERELEVATED SECTION
Not to Scale

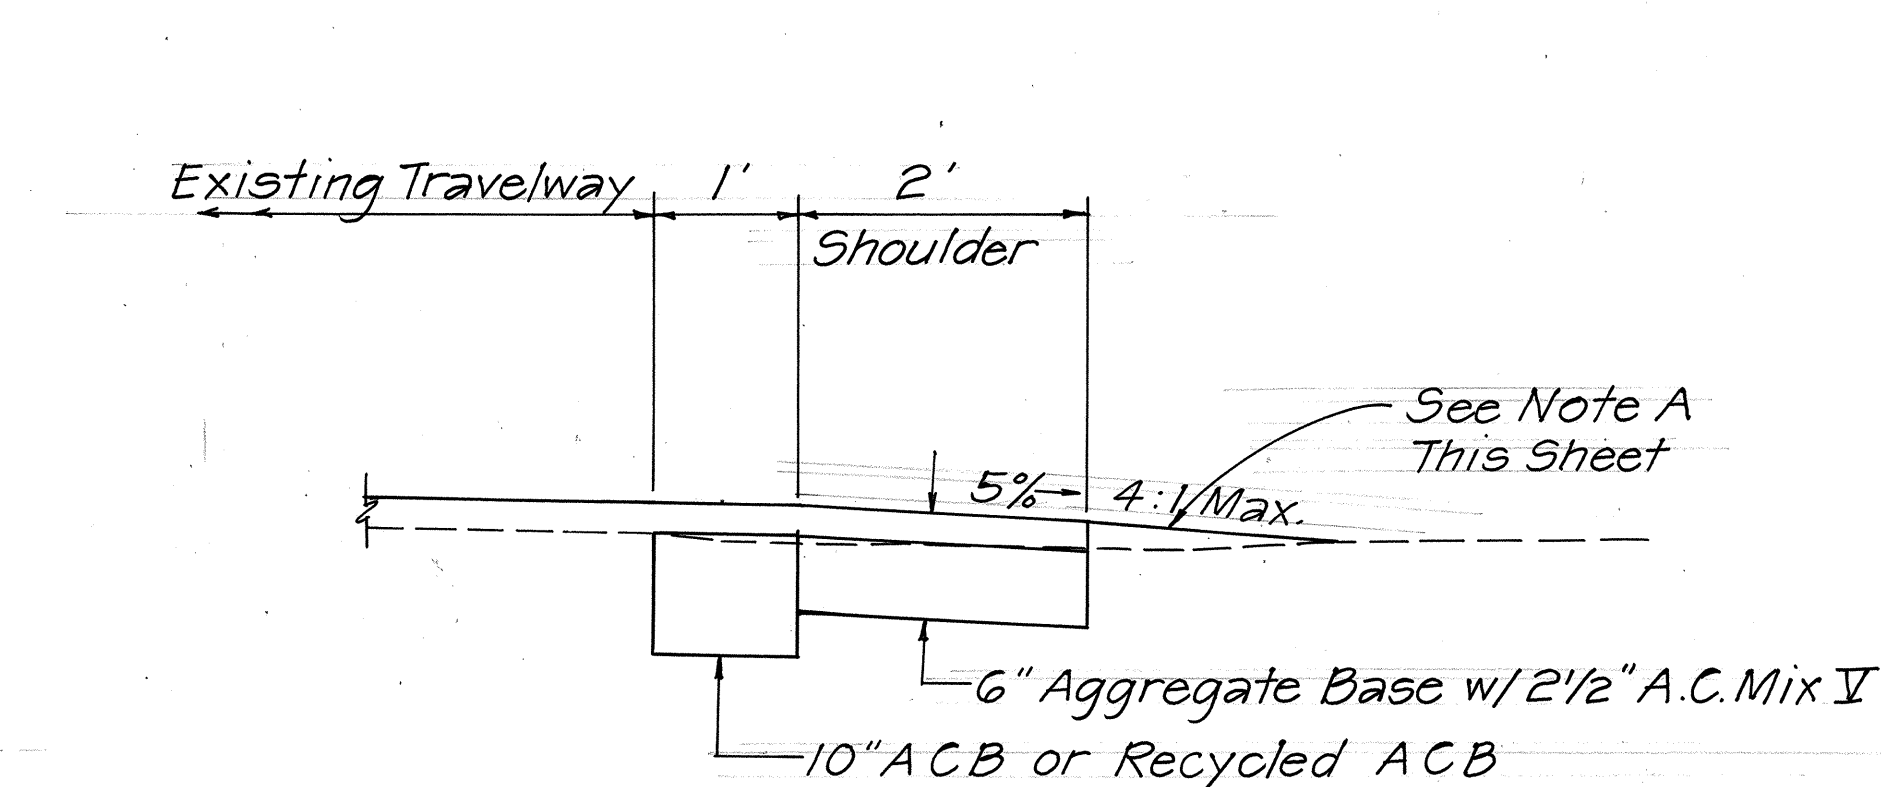


TYPICAL SHOULDER SECTION
Sta. 809+00± to Sta. 816+50±
Sta. 852+50± to Sta. 863+50±
(Right Shoulder Only)
Not To Scale

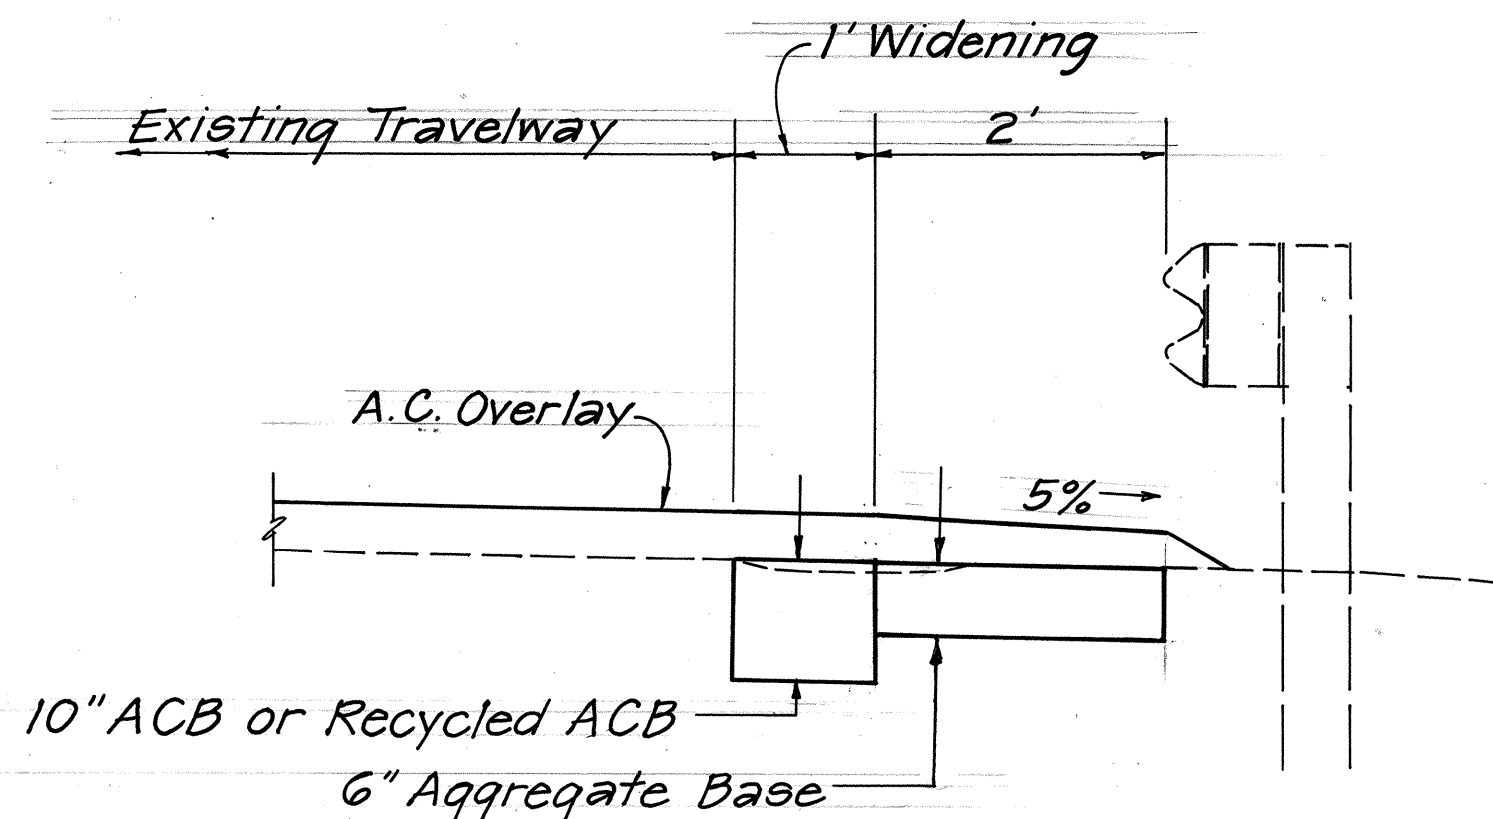


TYPICAL SHOULDER SECTION
Sta. 767+30± to Sta. 782+00±
(Right Shoulder Only)
Not To Scale

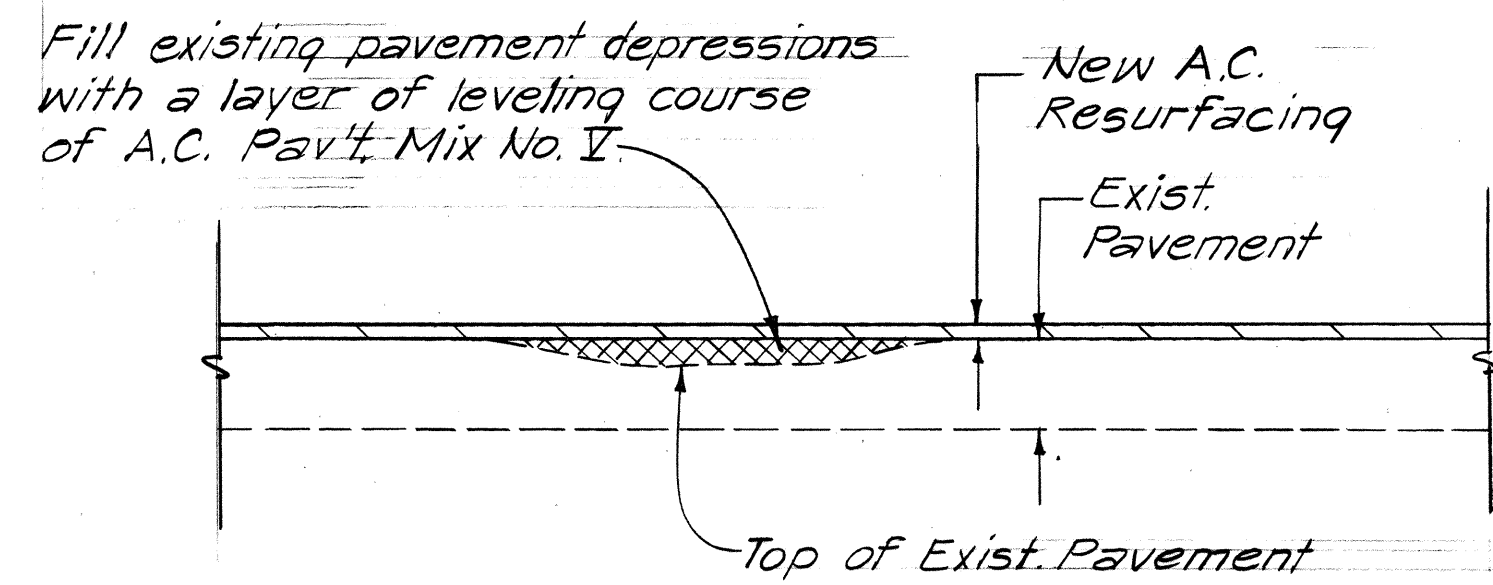


LEVELING COURSE DETAIL
Scale: 1" = 1'-0"

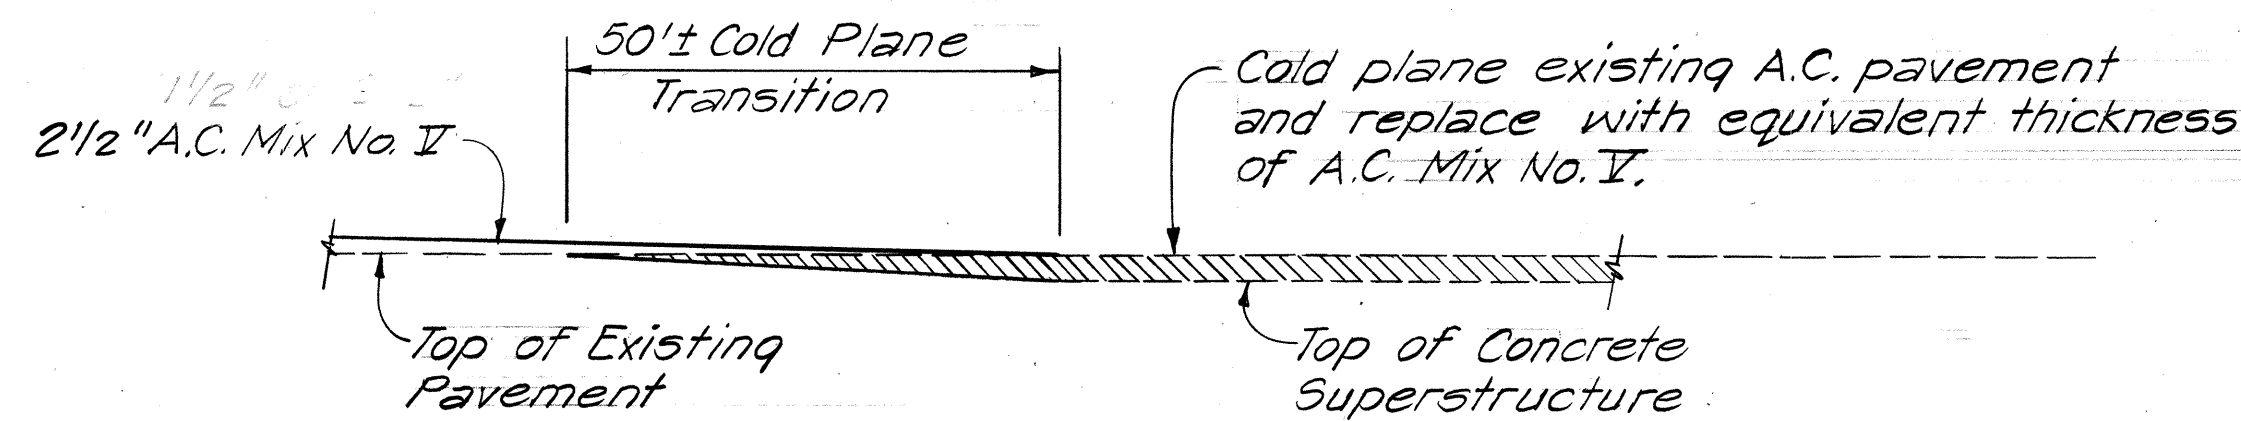

LONGITUDINAL SECTION AT BRIDGES

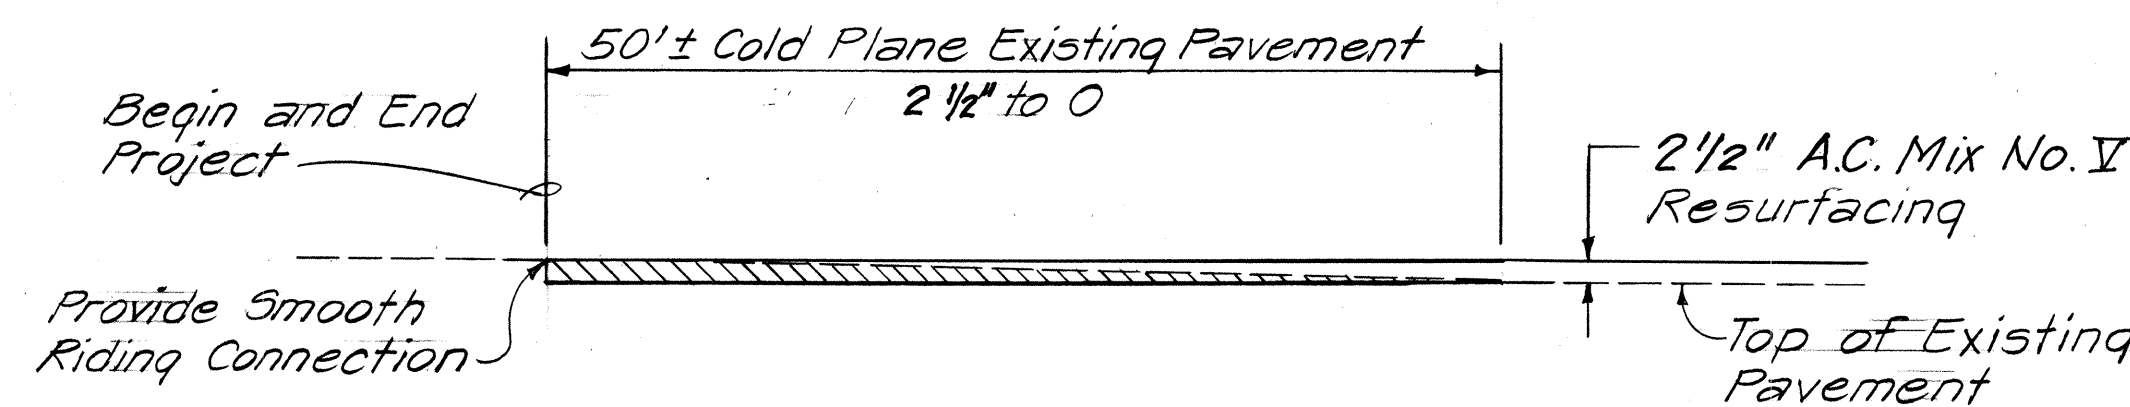

LONGITUDINAL SECTION - PROJECT BEGINNING AND END TRANSITION SECTION






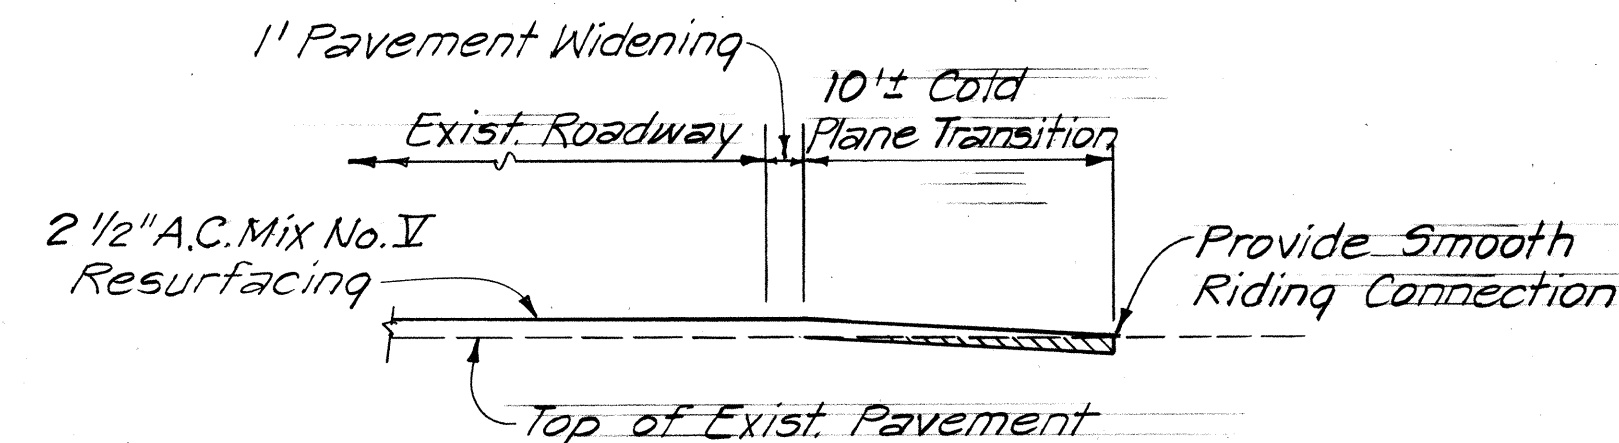


SIDE ROAD TRANSITION SECTION

COLD PLANE DETAILS
Not to Scale

STATE OF HAWAII
DEPARTMENT OF TRANSPORTATION
HIGHWAYS DIVISION
TYPICAL SECTIONS
KAMEHAMEHA HIGHWAY RESURFACING
Kualoa to Lau Place
PROJECT No. 83D-01-86M
Scale: As noted Date: April, 1986
SHEET No. 1 OF 1 SHEETS

FED. ROAD DIST. NO.	STATE	PROJ. NO.	FISCAL YEAR	SHEET NO.	TOTAL SHEETS
HAWAII	HAW.	83D-01-86M	1986	4	57

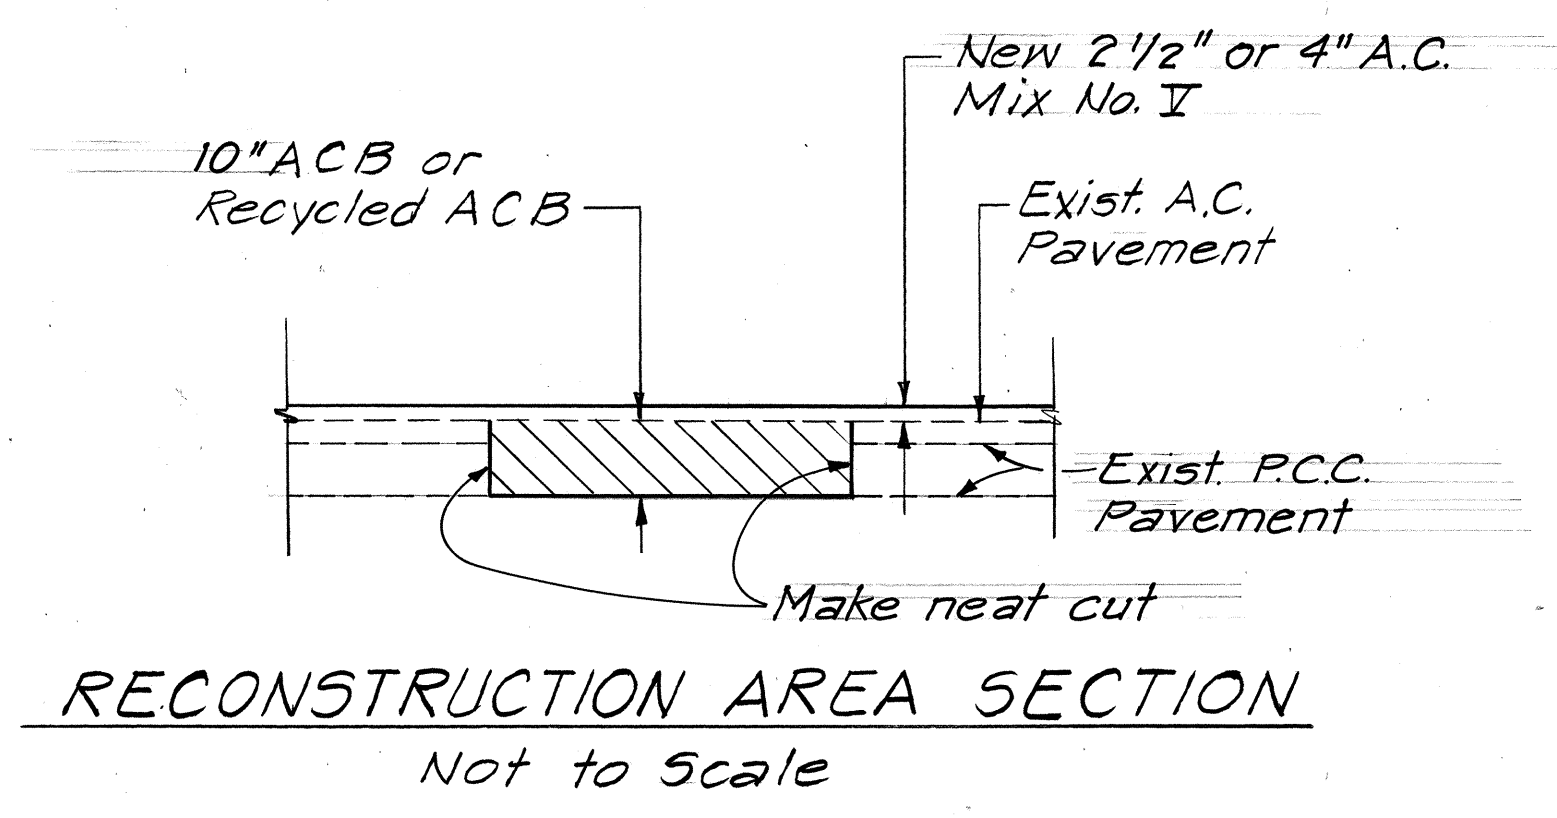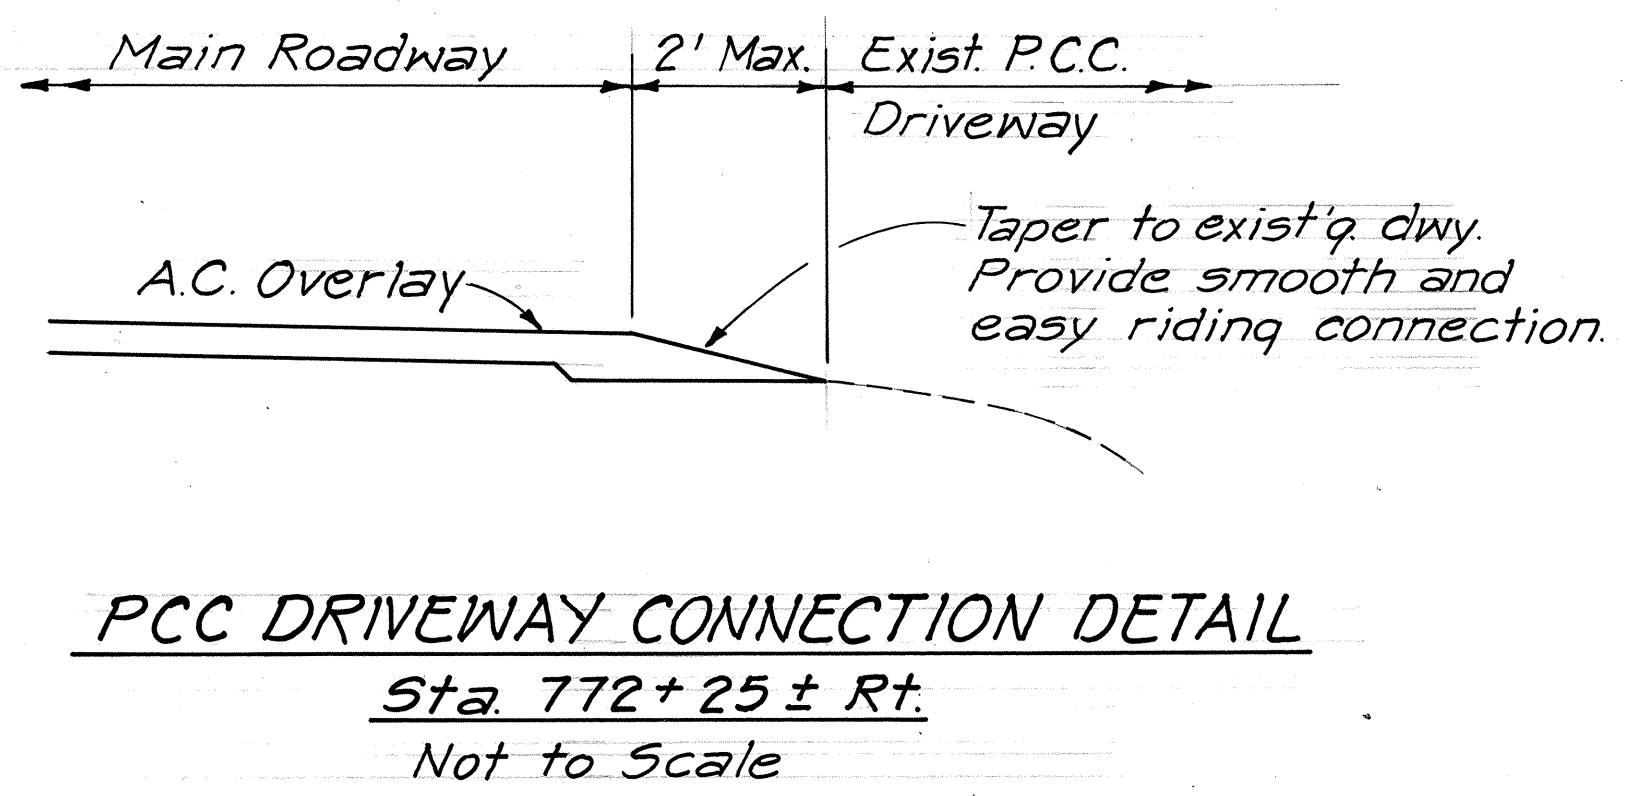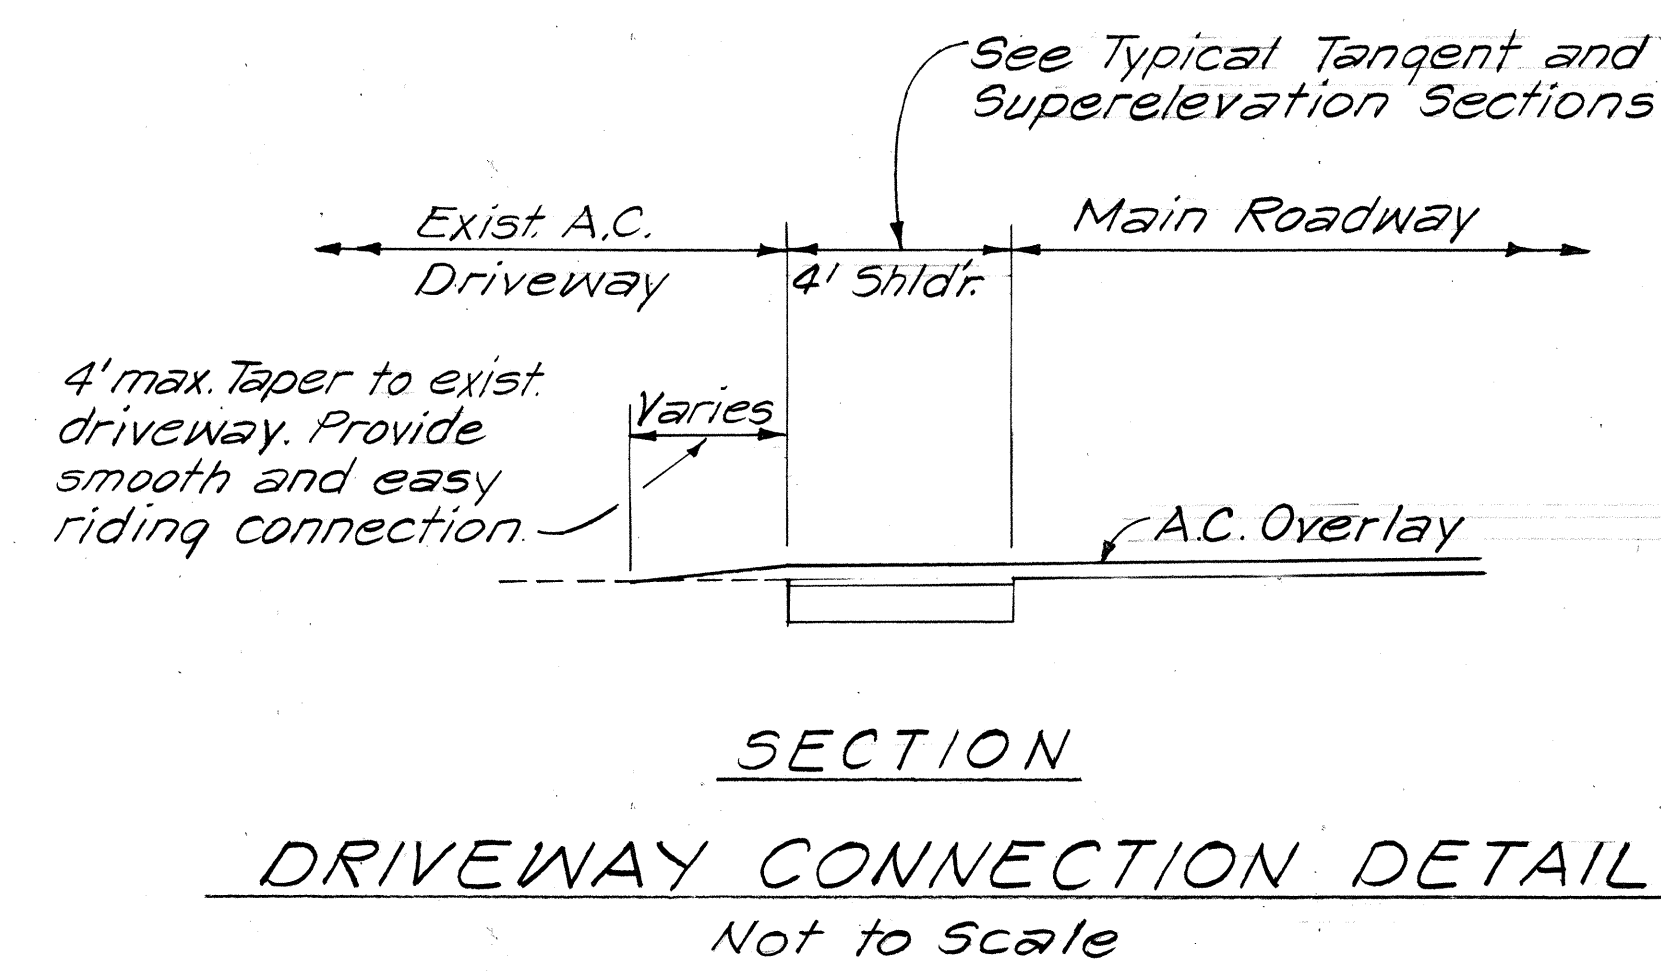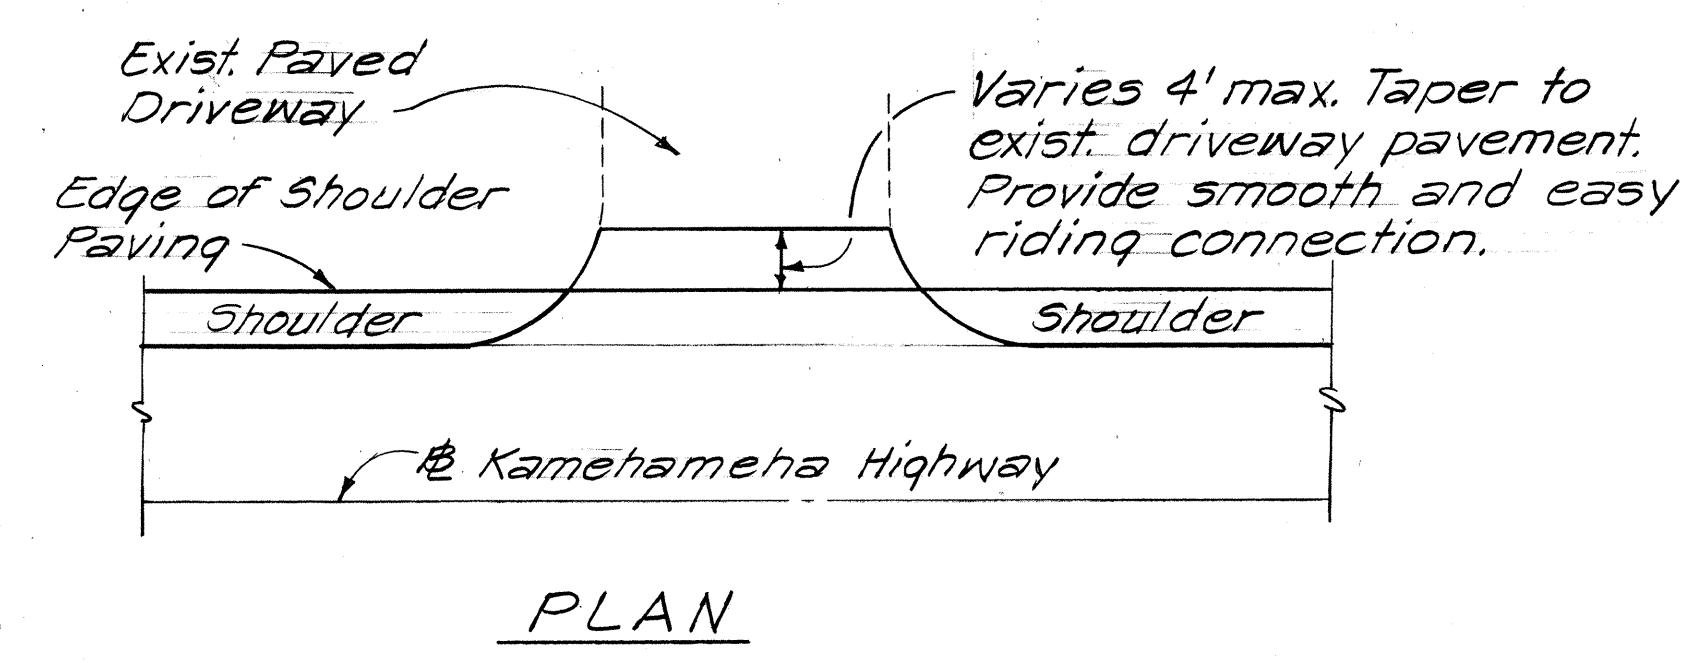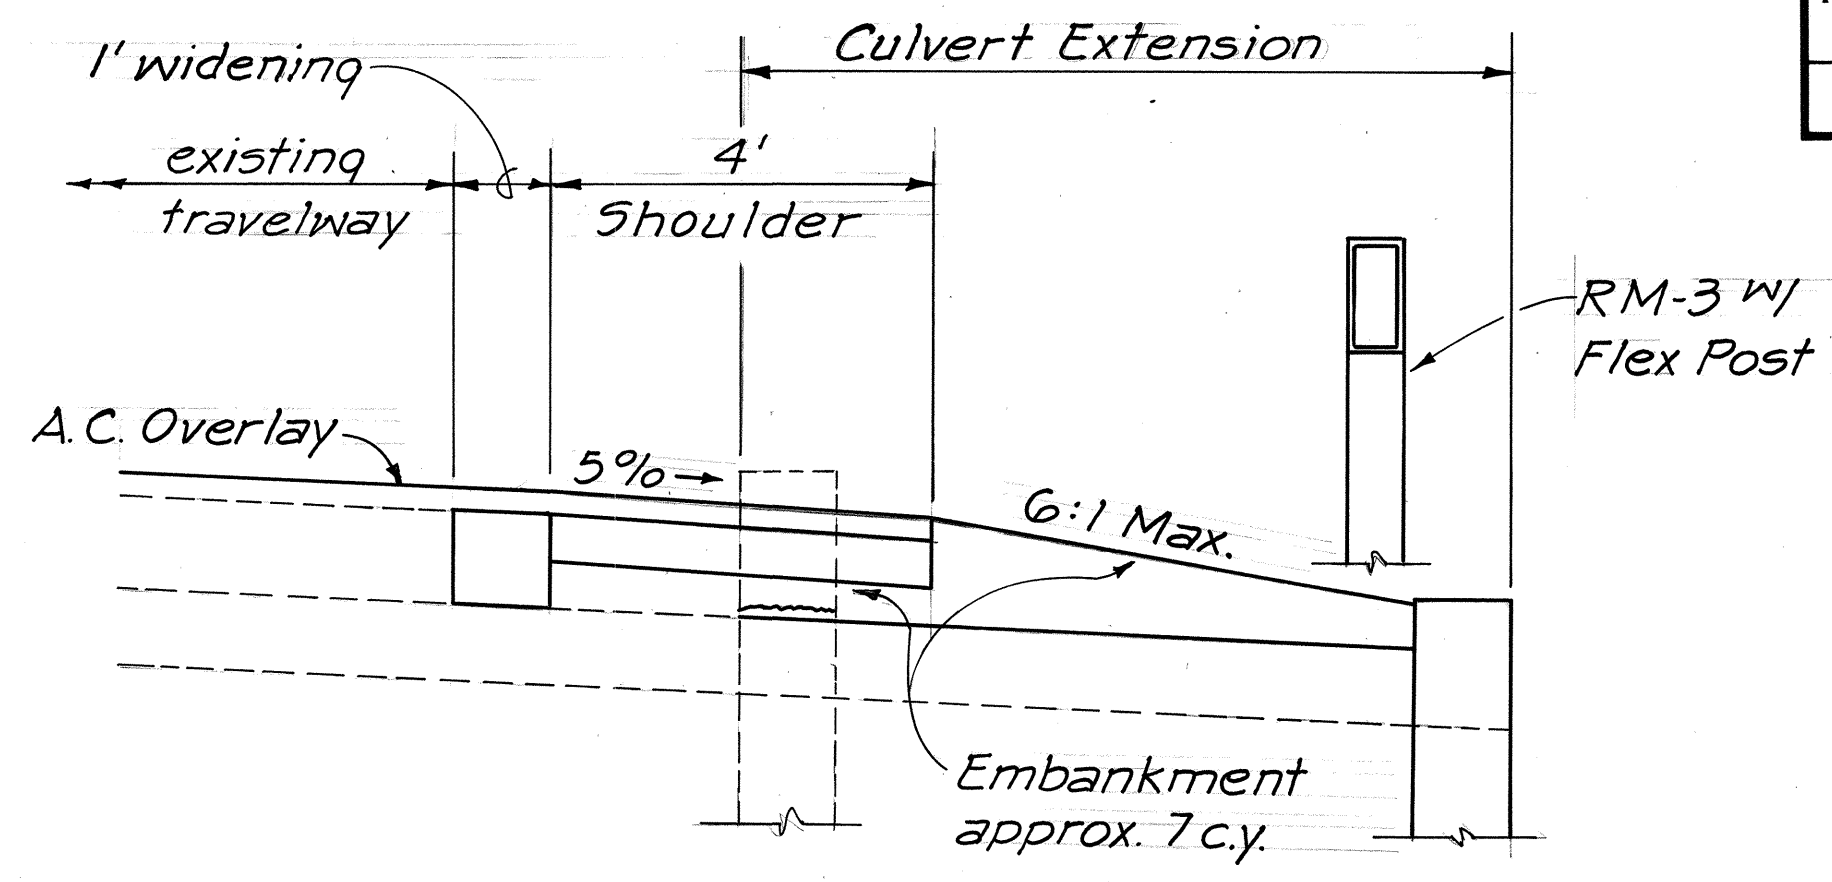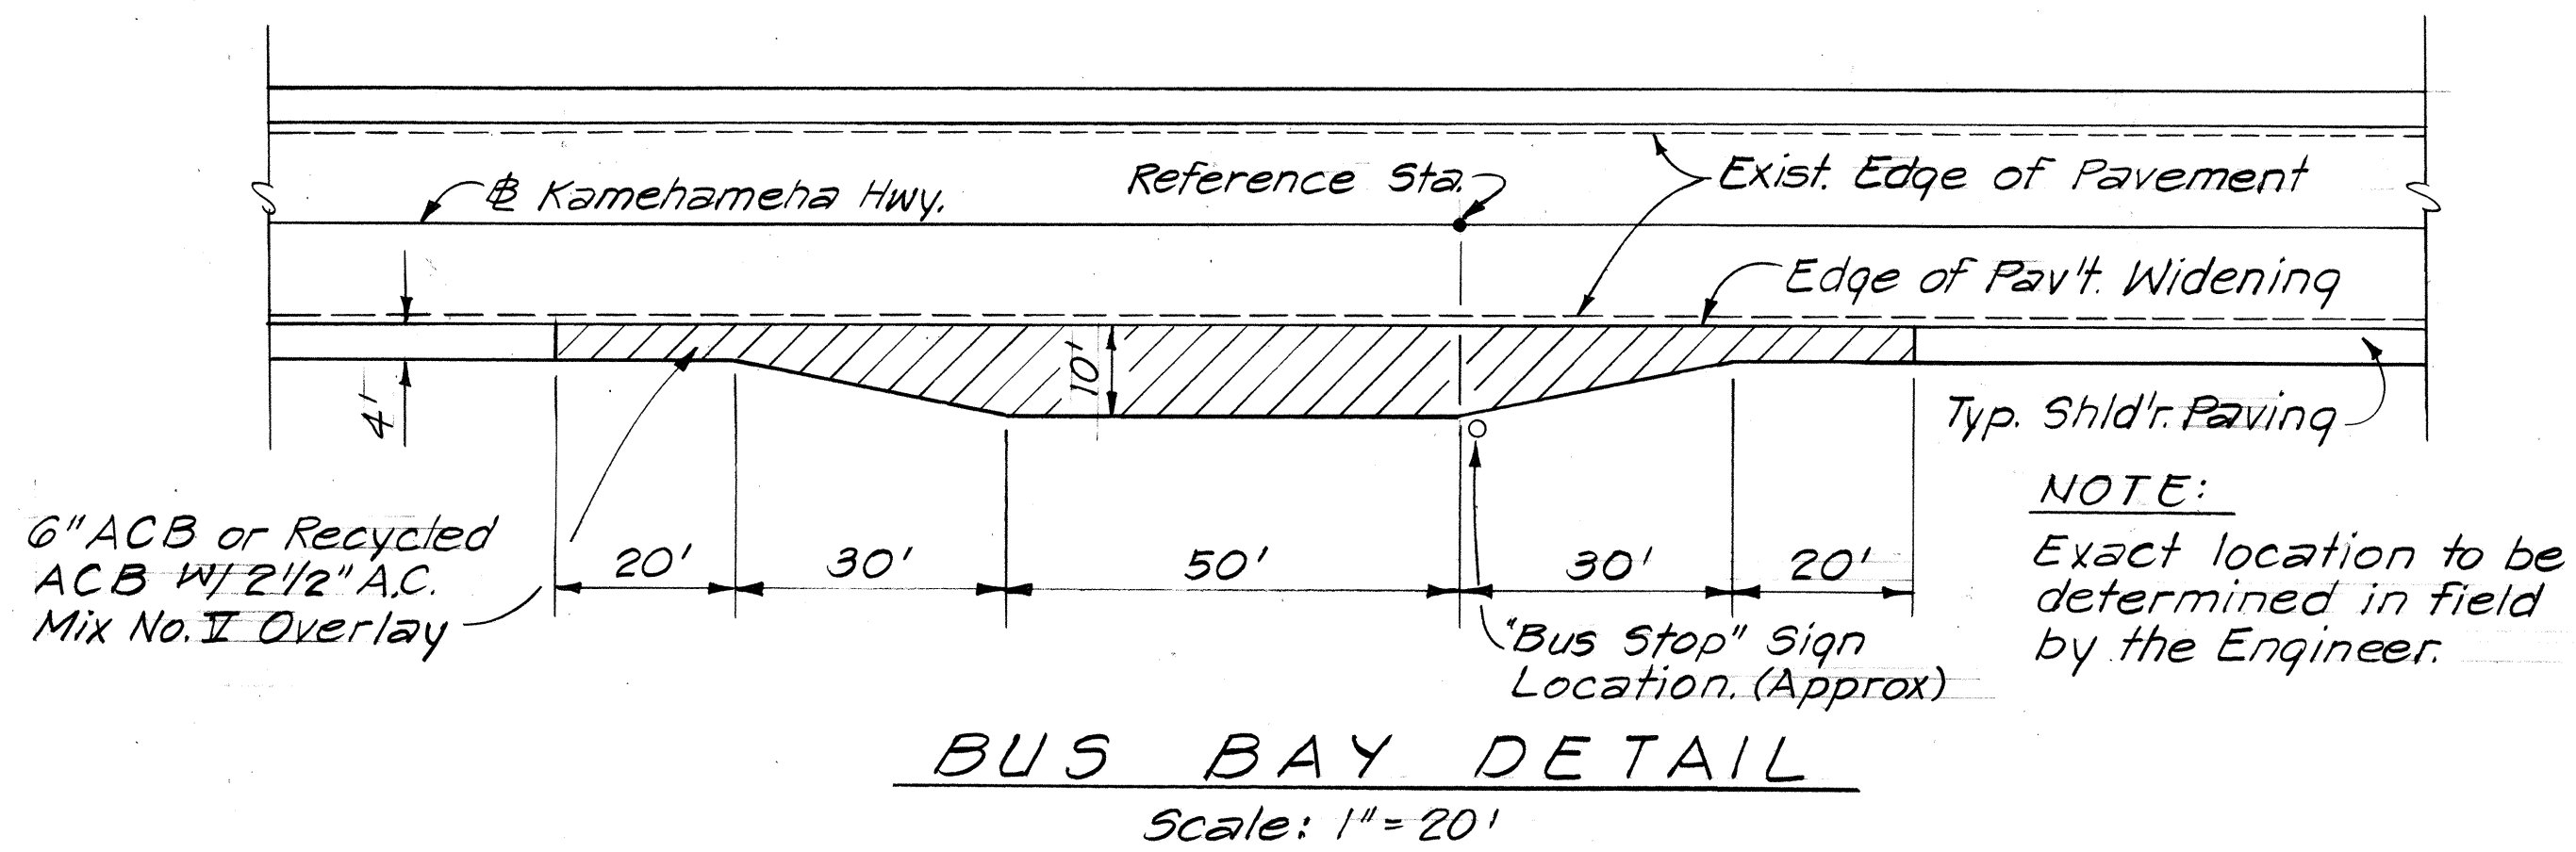

STATE OF HAWAII
DEPARTMENT OF TRANSPORTATION
HIGHWAYS DIVISION

MISCELLANEOUS DETAILS

KAMEHAMEHA HIGHWAY RESURFACING
Kualoa to Lau Place
PROJECT No. 83D-01-86M

Scale: As noted Date: April, 1986

SHEET No. OF SHEETS

DATE	
SURVEY PLOTTED BY	
DRAWN BY	
DESIGNED BY	
QUANTITIES BY	
CHECKED BY	
ORIGINAL PLAN	
NOTE BOOK	
No.	