<u> </u>	·
	INDEX TO DRAWINGS
SHEET NO.	DESCRIPTION
, 1	TITLE SHEET
2 - 4	TYPICAL SECTIONS & MISC. ROADWAY DETAILS
5 - 9	UTILITY GENERAL NOTES, CONSTRUCTION NOTES & ROADWAY PLANS
10 -19	TYPICAL & STANDARD ROADWAY DETAILS
20 - 26	DRAINAGE PLANS & DETAILS
27 -47	SIGNING & STRIPING PLANS & DETAILS
48-54	TRAFFIC SIGNAL PLANS & DETAILS

1	


STATE OF HAWAII

DEPARTMENT OF TRANSPORTATION HIGHWAYS DIVISION HONOLULU, HAWAII "AS-BUILT" PLANS FOR


KAHEKILI HIGHWAY IMPROVEMENTS

LIKELIKE HIGHWAY TO HAIKU ROAD PROJECT NO. 83F-01-86

DISTRICT OF KOOLAUPOKO ISLAND OF OAHU

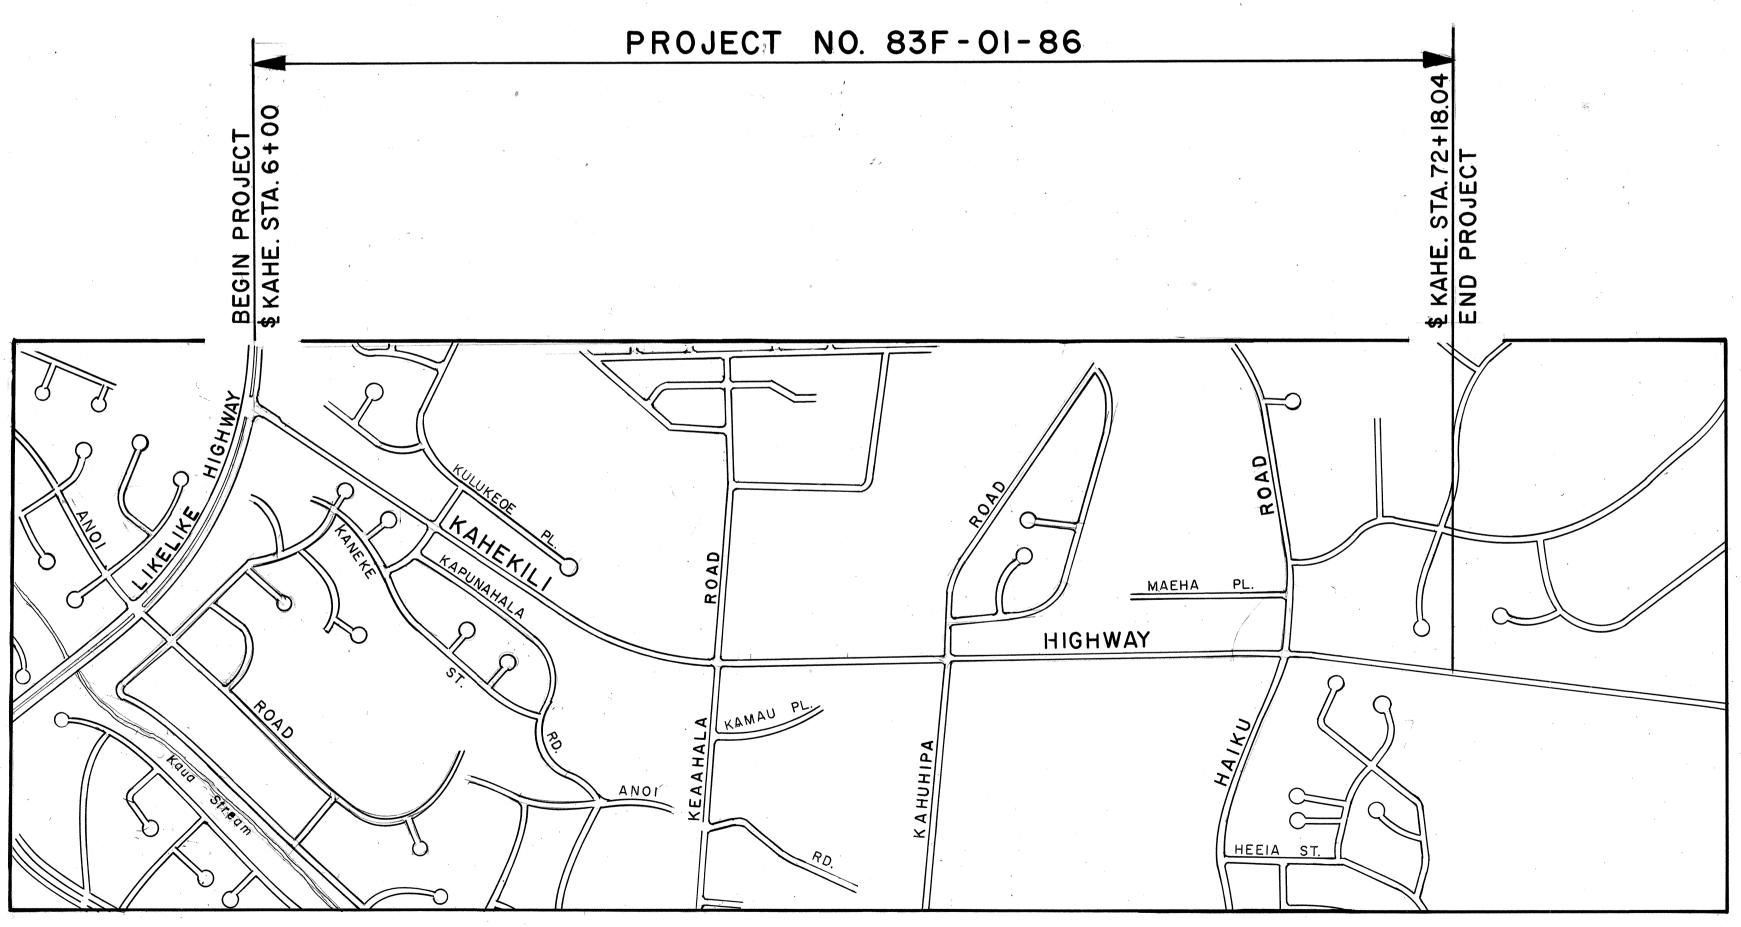

LAYOUT PLAN

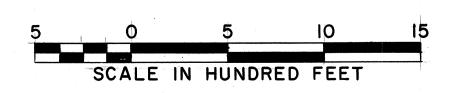

STATE OF HAWAII Waialua LOCATION OF PROJECT Waianae Nanakul

FED. ROAD DIST. NO.

HAWAII

CHANGES MADE DURING CONSTRUCTION HAVE BEEN INCORPORATED ON THESE PLANS EXCEPT CHANGES IN THE ORIGINAL THEORETICAL QUANTITIES. FOR ACTUAL QUANTITIES, REFER TO PROJECT LEDGER AND/OR COMPUTATION BOOK.

Demit Hugh RESIDENT ENGINEER

FISCAL SHEET TOTAL YEAR NO. SHEETS

1986

83F-01-86

DEPARTMENT OF TRANSPORTATION STATE OF HAWAII

APPROVED:

DIR. OF TRANSPORTATION DATE

ALLAN T. NISHIMURA DESIGNED BY