


CURVE DATA			
	9	10	11
Δ	3° 00' 14"	19° 20' 51"	2° 07' 37"
R	4800.00'	600.00'	4800.00'
T	125.86'	102.28'	89.10'
L	251.65	202.61	178.19
S.E.	0.00 ft./ft.	0.05 ft./ft.	0.00 ft./ft.


FED. ROAD DIST. NO.	STATE	PROJ. NO.	FISCAL YEAR	SHEET NO.	TOTAL SHEETS
HAWAII	HAW.	83B-01-88M	1988	6	19

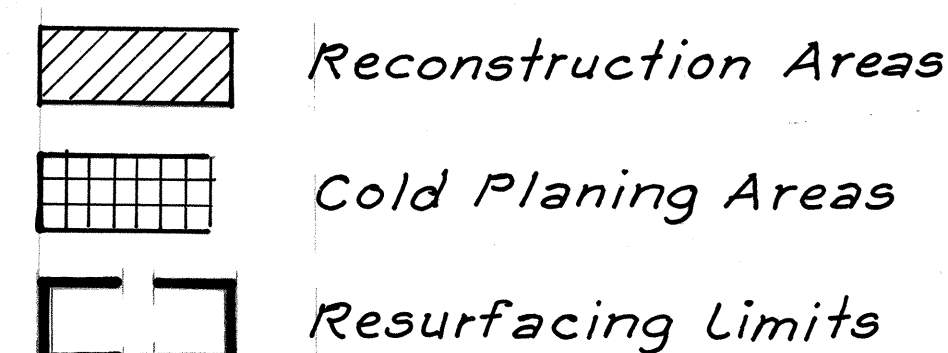

LEGEND

- Catch Basin
- Storm Drain Pipe
- Drop Inlet
- Fire Hydrant
- Water Line
- Water Manhole
- Water Valve
- Electric Ductline
- Electric Pole
- Guy Pole
- Joint Pole
- Telephone Pole
- Pull Box
- Signal Corp.

Sta. 134+95± to Sta. 136+70±, Lt.
 Sta. 143+60± to Sta. 143+90±, Lt.
 Sta. 144+00± to Sta. 145+50±, Lt.
 Removal of existing retaining wall
 will be incidental to roadway excavation.
 For Details see Plan Sht. No. 4.

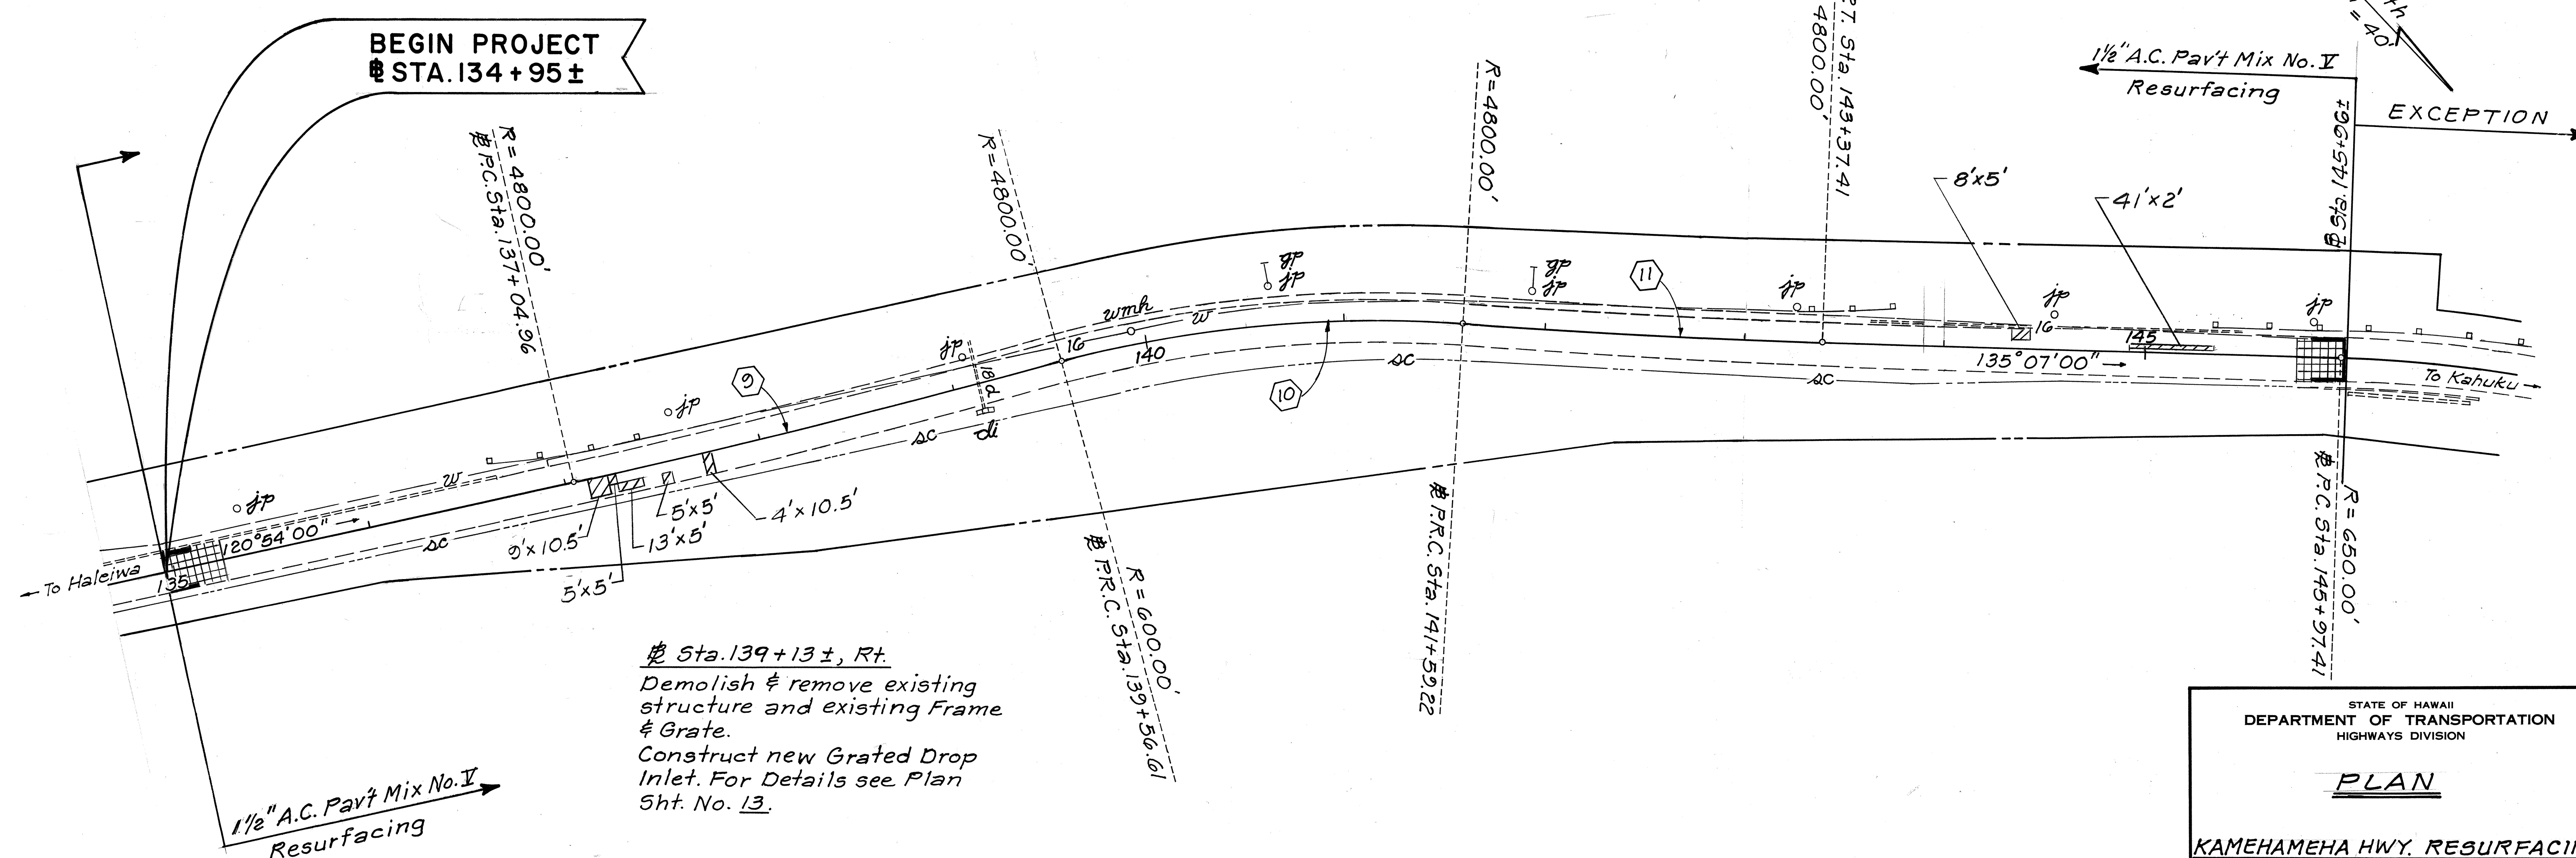

Sta. 139+13±, Rt.
 Demolish & remove existing
 structure and existing Frame
 & Grate.
 Construct new Grated Drop
 Inlet. For Details see Plan
 Sht. No. 13.

STATE OF HAWAII
 DEPARTMENT OF TRANSPORTATION
 HIGHWAYS DIVISION

PLAN

KAMEHAMEHA HWY. RESURFACING
 PROJECT NO. 83B-01-88M


Scale: 1" = 40' Date: Mar., 1988

SHEET No. 1 OF 6 SHEETS


FED. ROAD DIST. NO.	STATE	PROJ. NO.	FISCAL YEAR	SHEET NO.	TOTAL SHEETS
HAWAII	HAW.	83B-01-88M	1988	7	19

TRUE NORTH
Scale: 1" = 40'

EXCEPTION 2 1/2" A.C. Pav't Mix No. II
Resurfacing

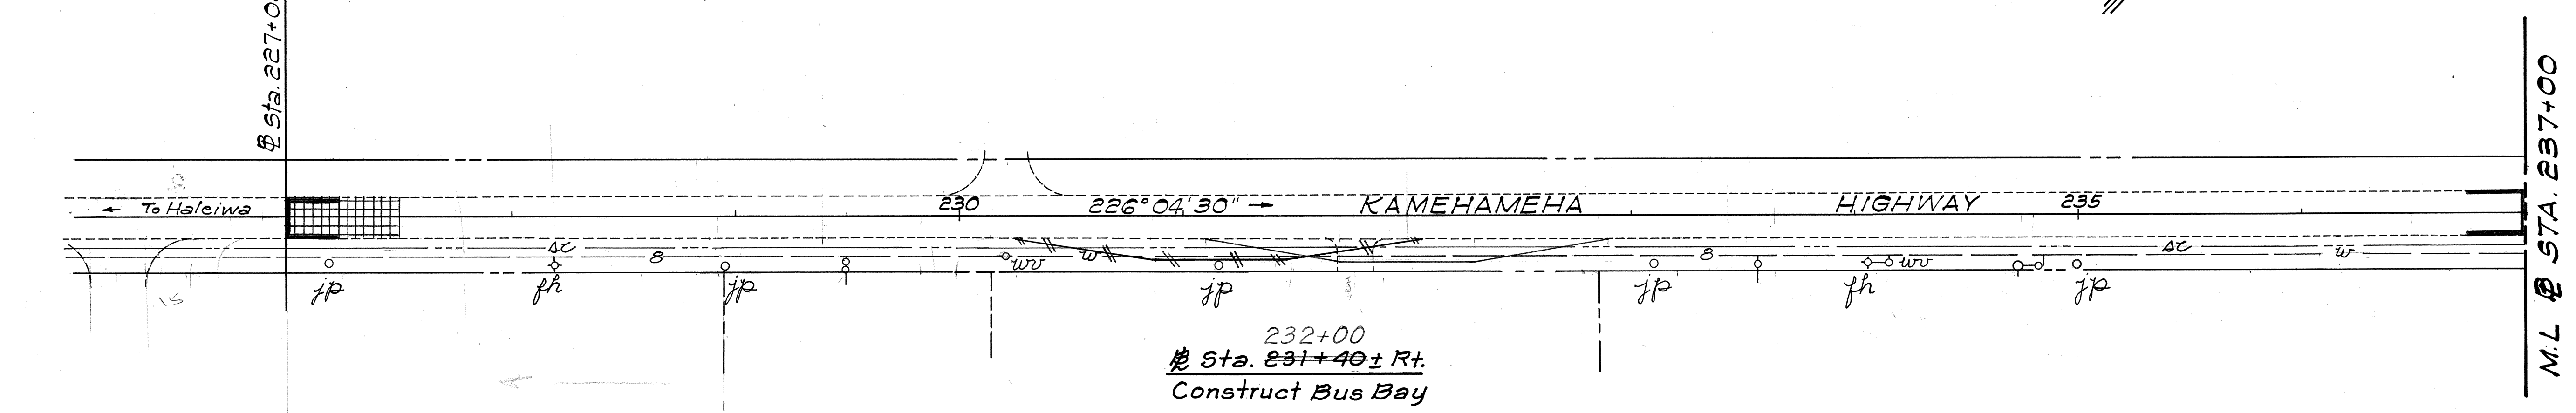

TRUE NORTH
Scale: 1" = 40'

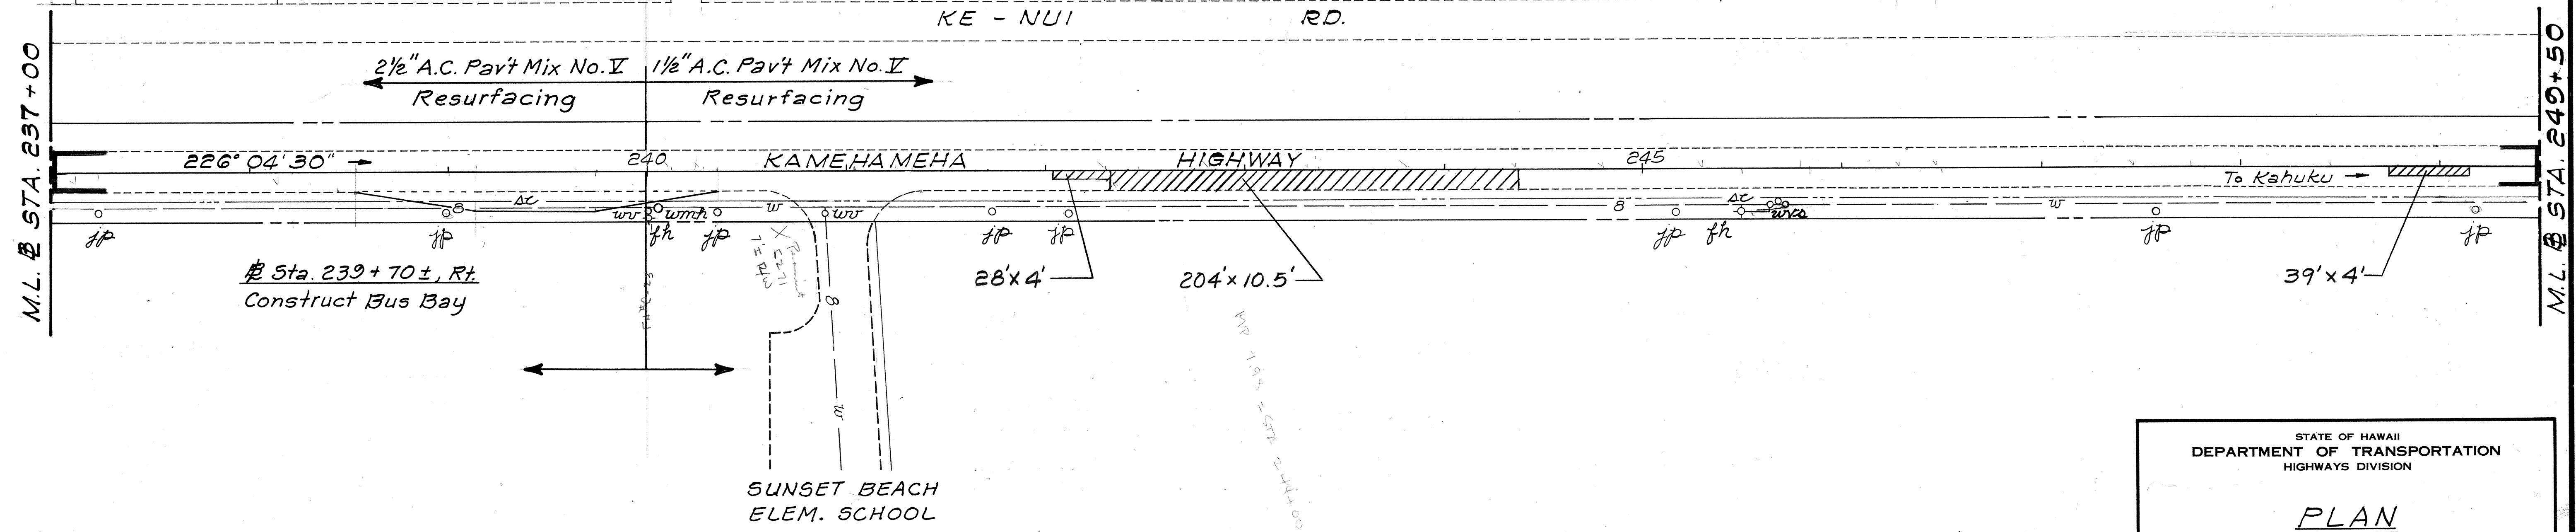


STATE OF HAWAII
DEPARTMENT OF TRANSPORTATION
HIGHWAYS DIVISION

PLAN
KAMEHAMEHA HWY. RESURFACING
PROJECT NO. 83B-01-88M
Scale: 1" = 40' Date: Mar., 1988
SHEET NO. 2 OF 6 SHEETS


ORIGINAL PLAN	DATE
DESIGNED BY	
TRACED BY	
QUANTITIES BY	
CHECKED BY	
NOTE BOOK	
No.	

ORIGINAL PLAN	SURVEY PLOTTED BY _____ DATE _____
NOTE BOOK	DRAWN BY _____
	TRACED BY _____
	DESIGNED BY _____
	QUANTITIES BY _____
No. _____	CHECKED BY _____


TRUE NORTH
scale: 1" = 40'

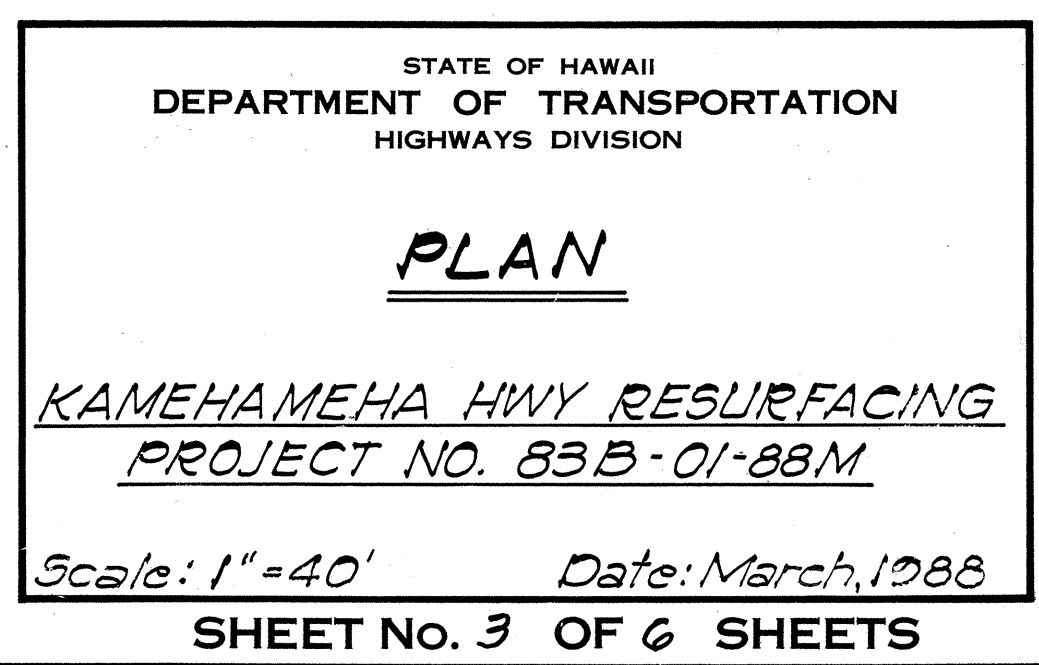

FED. ROAD DIST. NO.	STATE	PROJ. NO.	FISCAL YEAR	SHEET NO.	TOTAL SHEETS
HAWAII	HAW.	83B-01-88M	1988	9	19

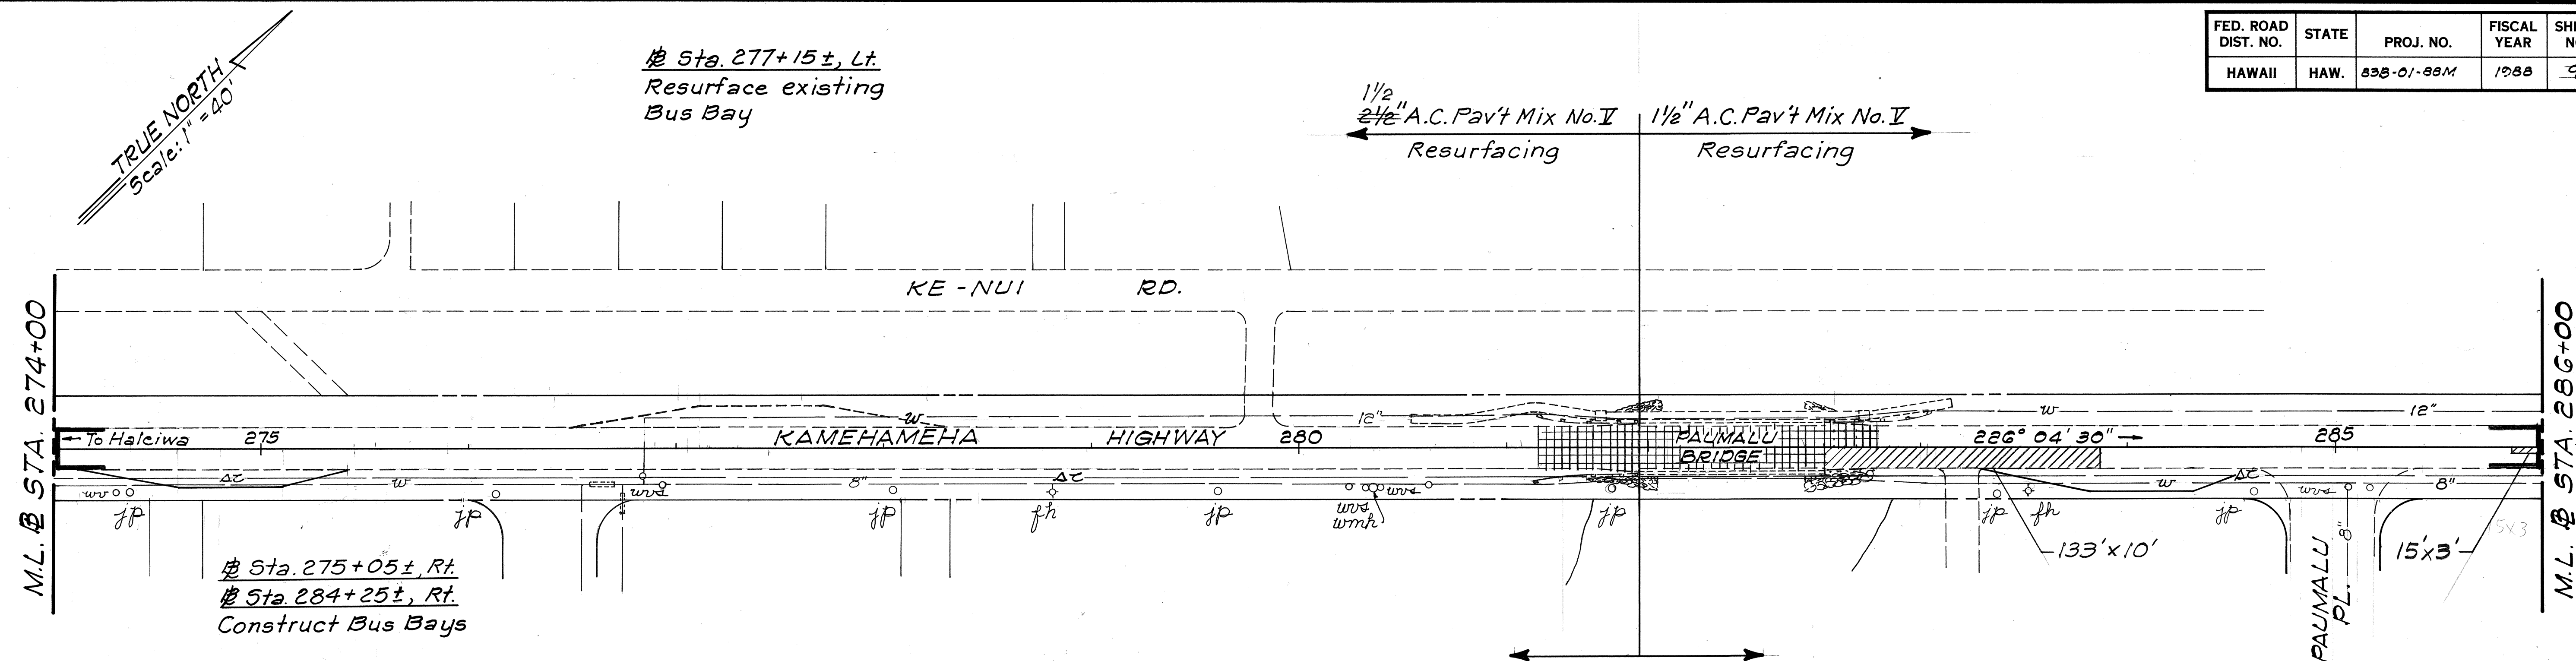

CURVE DATA
 $\Delta = 3^\circ 33' 30''$
 $R = 5,729.6$
 $T = 177.98$
 $C = 355.78$
 $L = 355.81$

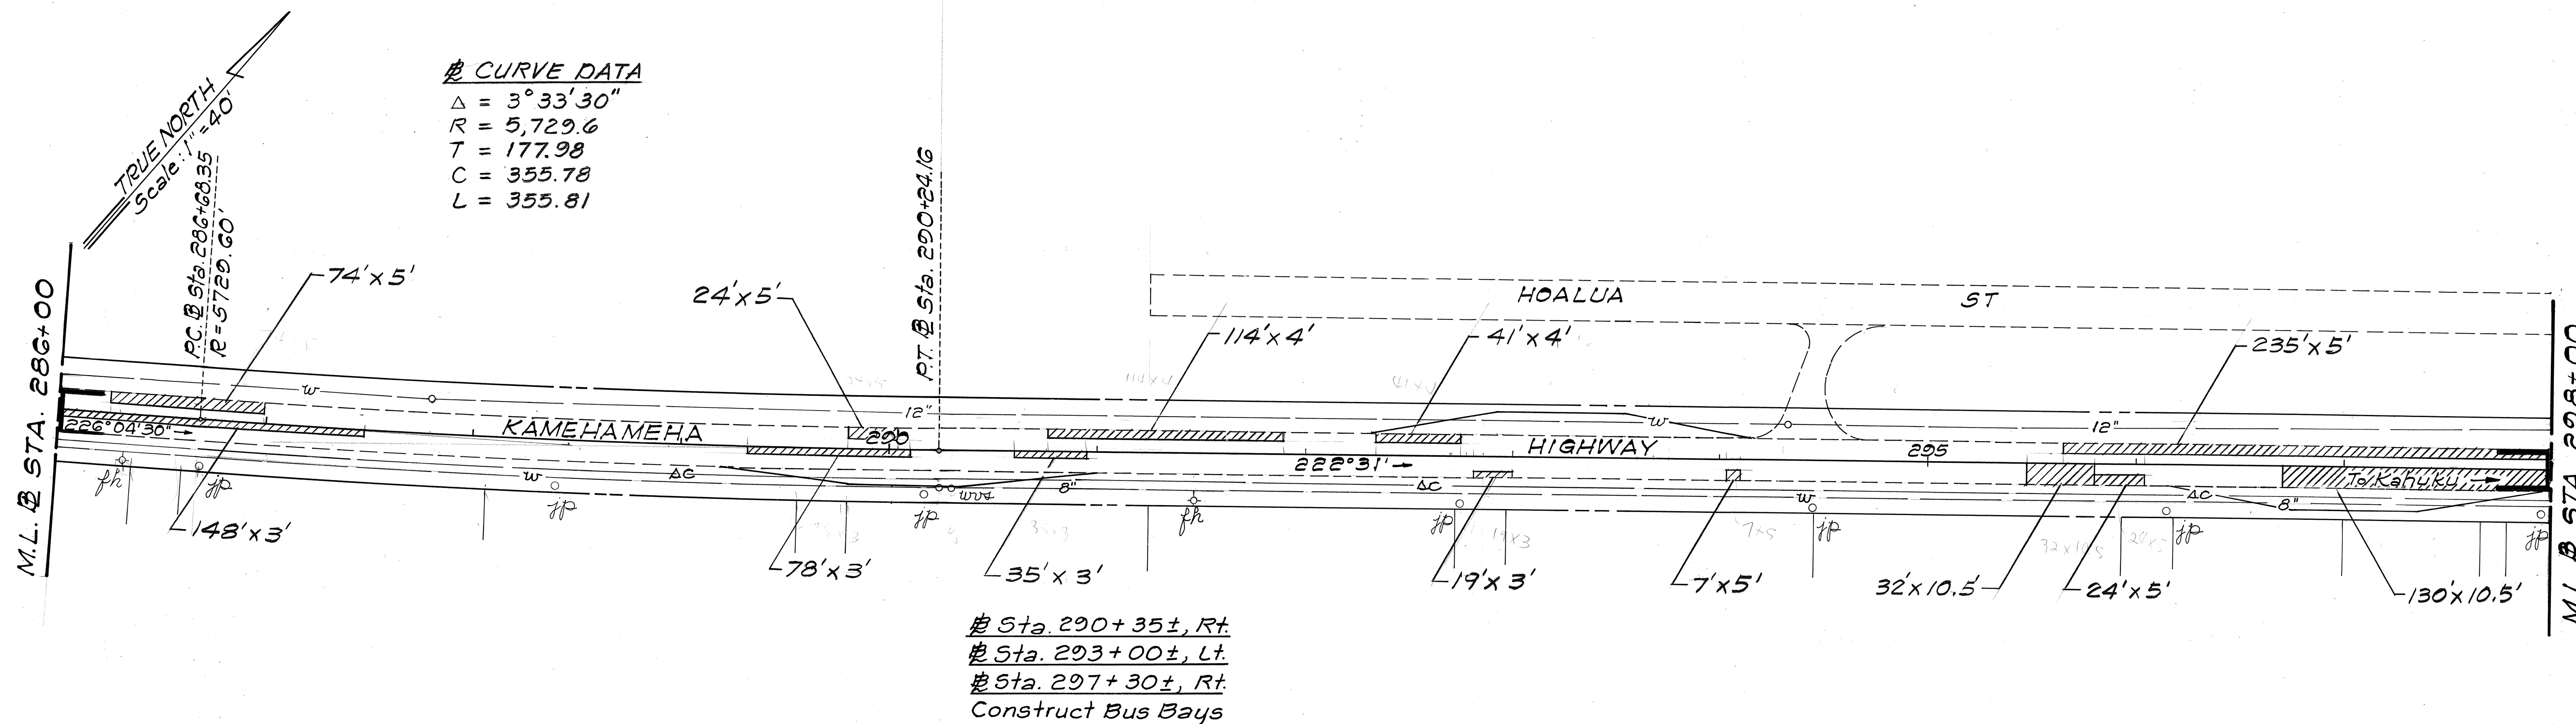

STATE OF HAWAII
DEPARTMENT OF TRANSPORTATION
HIGHWAYS DIVISION

PLAN

KAMEHAMEHA HWY RESURFACING
PROJECT NO. 83B-01-88M

Scale: 1" = 40' Date: March, 1988
SHEET No. 4 OF 6 SHEETS

ORIGINAL PLAN	DATE
SURVEY PLOTTED BY	
DRAWN BY	
DESIGNED BY	
QUANTITIES BY	
CHECKED BY	

TRUE NORTH
Scale: 1"=40'

FED. ROAD DIST. NO. STATE PROJ. NO. FISCAL YEAR
HAWAII HAW. 83B-01-88M 1988

HOALUA ST. KAHAUOLA ST.

KAMEHAMEHA HIGHWAY

Stationing: 298+00, 301+15, 305

Dimensions: 118'x5', 81'x5', 306'x5', 12'x3', 47'x4', 15'x5', 28'x4', 34'x10.5', 157'x10.5', 25'x10.5', 30'x10.5', 16'x4', 30'x3', 76'x5'

Other labels: 118'x5', 81'x5', 306'x5', 12'x3', 47'x4', 15'x5', 28'x4', 34'x10.5', 157'x10.5', 25'x10.5', 30'x10.5', 16'x4', 30'x3', 76'x5', 118'x5', 81'x5', 306'x5', 12'x3', 47'x4', 15'x5', 28'x4', 34'x10.5', 157'x10.5', 25'x10.5', 30'x10.5', 16'x4', 30'x3', 76'x5'

STATE OF HAWAII
DEPARTMENT OF TRANSPORTATION
HIGHWAYS DIVISION


PLAN

KAMEHAMEHA HWY RESURFACING
PROJECT NO. 83B-01-88M

Scale: 1"=40' Date: March, 1988

SHEET NO. 5 OF 6 SHEETS

FED. ROAD DIST. NO.	STATE	PROJ. NO.	FISCAL YEAR	SHEET NO.	TOTAL SHEETS
HAWAII	HAW.	83B-01-88M	1988	11	19

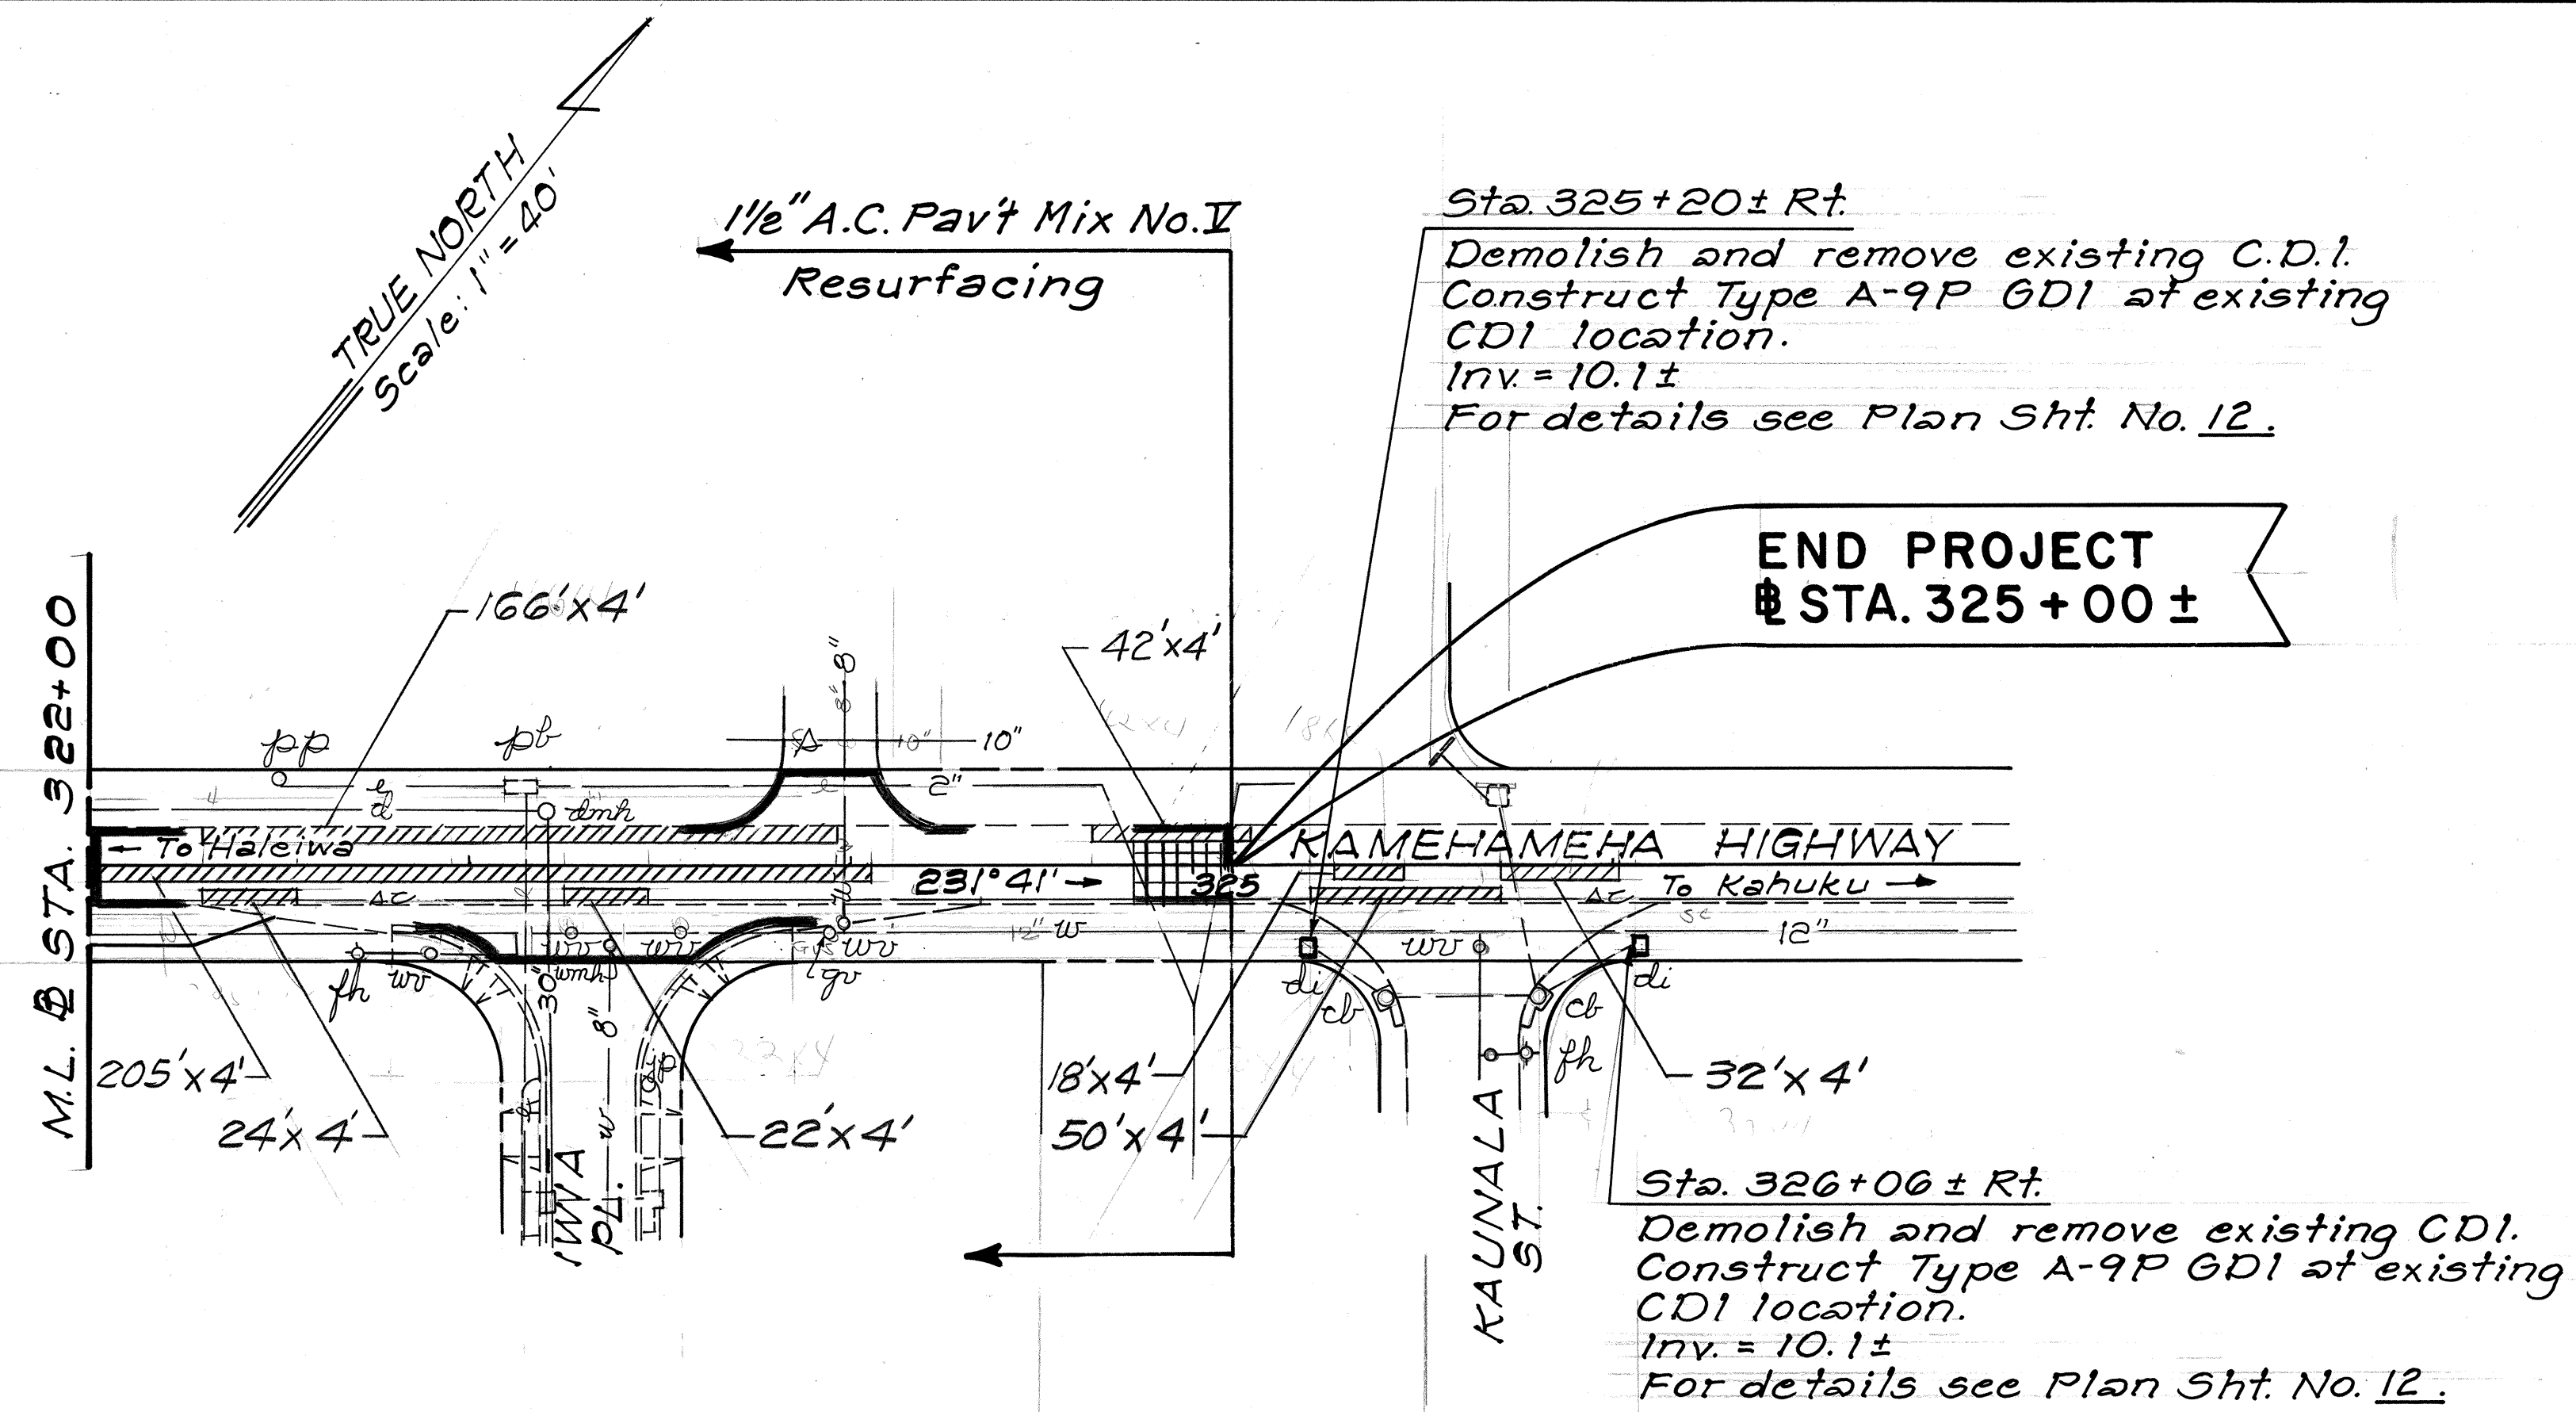

ORIGINAL PLAN	SURVEY PLOTTED BY	DATE
NOTE BOOK	DESIGNED BY	
No.	QUANTITIES BY	
	CHECKED BY	

STATE OF HAWAII
DEPARTMENT OF TRANSPORTATION
HIGHWAYS DIVISION

PLAN

KAMEHAMEHA HWY RESURFACING
PROJECT NO. 83B-01-88M

Scale: 1" = 40' Date: March, 1988

SHEET NO. 6 OF 6 SHEETS