	INDEX TO DRAWINGS
SHEET NO.	DESCRIPTION
Ì	TITLE SHEET
2	STANDARD PLANS SUMMARY
3	GENERAL NOTES AND SCHEDULES
4 - 5	TYPICAL SECTIONS AND DETAILS
6-11	PLANS
12 – 13 🛈	DRAINAGE DETAILS
14 - 19	SIGNING AND PAVEMENT MARKING PLANS AND DETAILS

•	

Plan Sht. No. 13S-1 is a supplementary sheet to this project. Total sheet count after "As-Built" postings: 20 sheets

HAWAII STATE OF

DEPARTMENT OF TRANSPORTATION


HIGHWAYS DIVISION HONOLULU, HAWAII "AS-BUILT" PLANS FOR

KAMEHAMEHA HIGHWAY RESURFACING

WAIMEA BAY & SUNSET BEACH ELEMENTARY SCHOOL TO KAUNALA STREET

PROJECT NO. 83B-01-88M

DISTRICT OF KOOLAULOA ISLAND OF OAHU

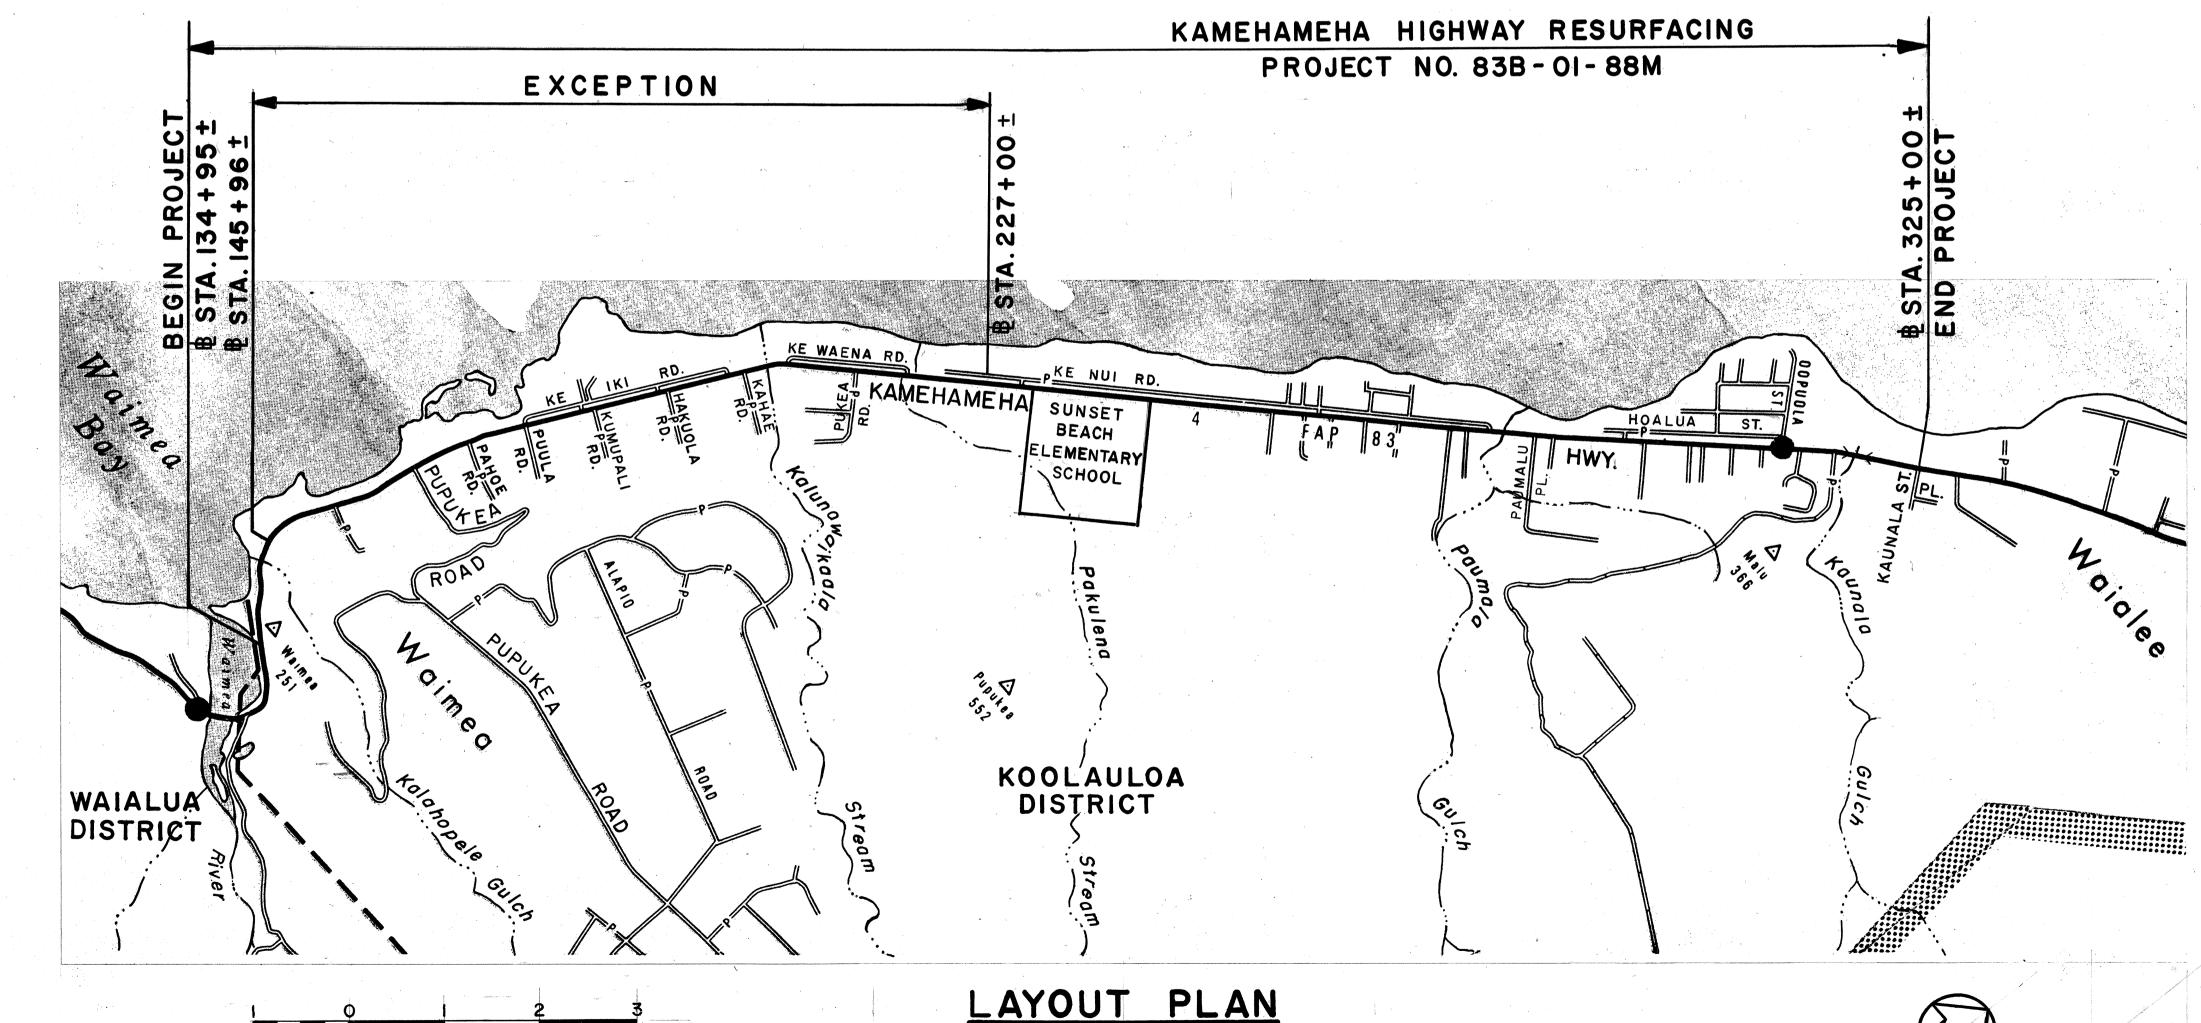

LOCATION OF PROJECT STATE OF HAWAII (N)

DIST. NO.

CHANGES MADE DURING CONSTRUCTION HAVE BEEN INCORPORATED ON THESE PLANS EXCEPT CHANGES IN THE ORIGINAL THEORETICAL QUANTITIES. FOR ACTUAL QUANTITIES, REFER TO PROJECT LEDGER AND/OR COMPUTATION BOOK.

Mand 18 For RESIDENT ENGINEER

FISCAL SHEET TOTAL YEAR NO. SHEETS

1988

PROJ. NO.

83B-01-88M

DEPARTMENT OF TRANSPORTATION STATE OF HAWAII APPROVED:

SCALE IN THOUSAND FEET

GROSS LENGTH OF PROJECT3.599 MILES NET LENGTH OF PROJECT 2.064 MILES

548-2456 PHONE

ROY