	INDEX TO DRAWINGS
SHEET NO.	DESCRIPTION
l {	TITLE SHEET
2	STANDARD PLANS SUMMARY
3-4	GENERAL NOTES, TYPICAL SECTION AND MISCELLANEOUS DETAILS
5 - 7	PLANS
8-11	TRAFFIC NOTES, LEGEND, DETAIL, LOOP DETECTORS, SIGNING AND PAVEMENT MARKINGS
4	
	er dikan

STATE OF HAWAII

DEPARTMENT OF TRANSPORTATION

HIGHWAYS DIVISION HONOLULU, HAWAII "AS-BUILT"


PLANS FOR

KAHEKILI HIGHWAY RESURFACING

VALLEY OF THE TEMPLES TO AHUIMANU STREAM BRIDGE

PROJECT NO. 83F - 01 - 88M

DISTRICT OF KOOLAUPOKO ISLAND OF OAHU

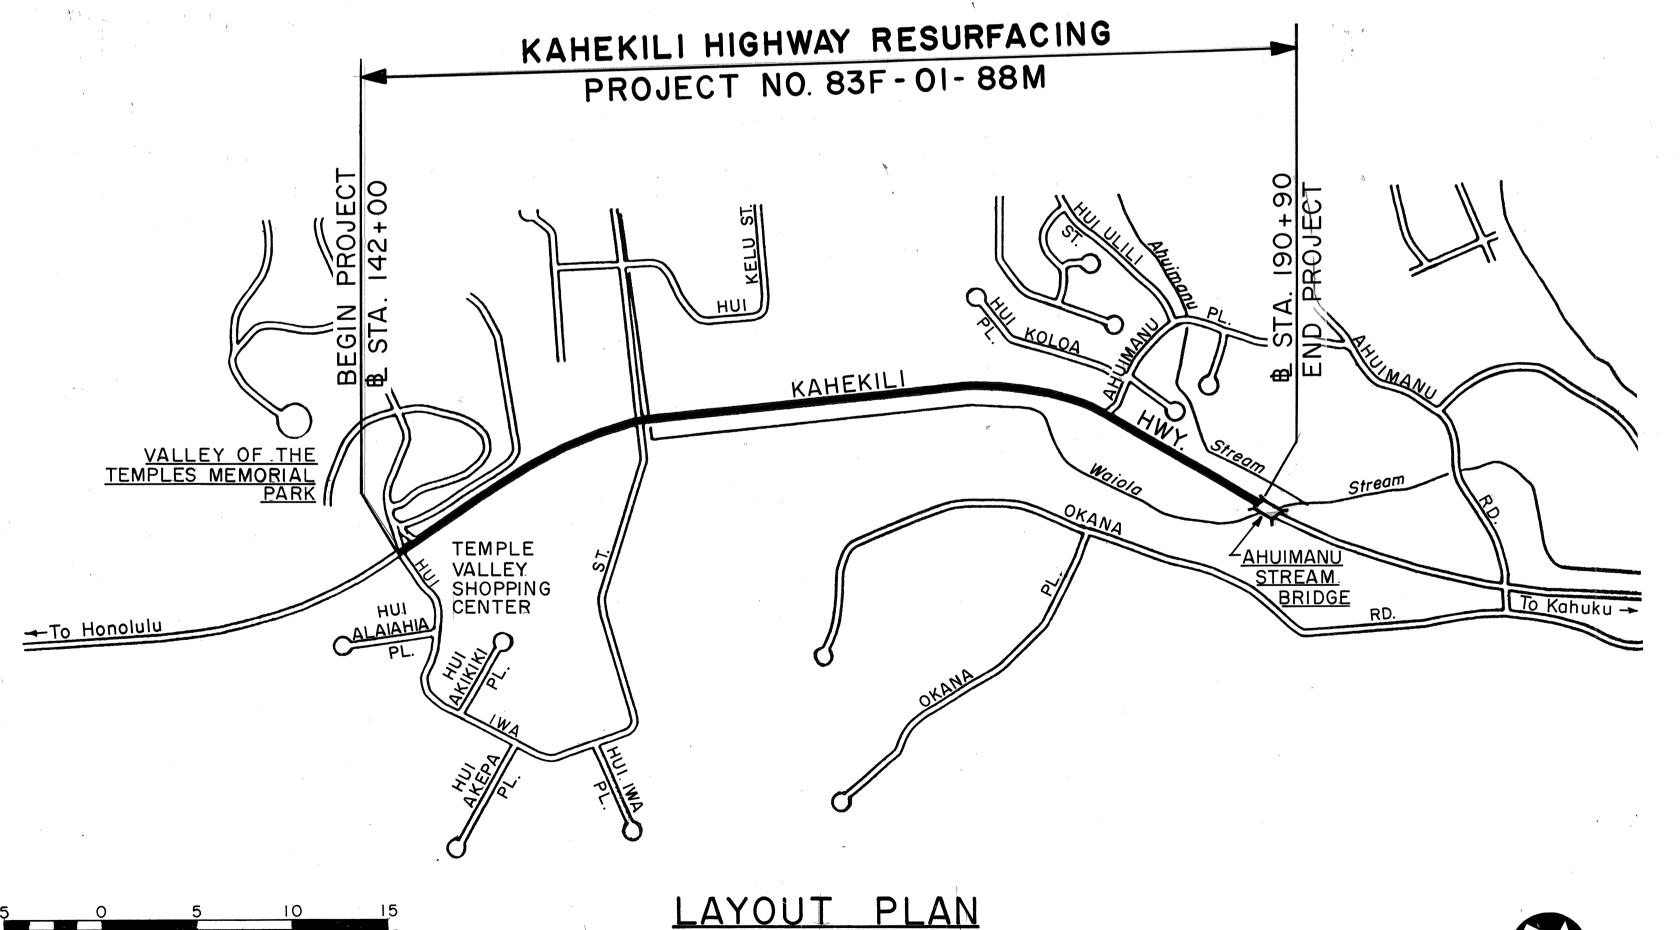

LENGTH OF PROJECT

M.P. 38.31 JO M.P. 37.37

Waidalua Haleiwa Punaluu STATE OF HAWAII MALOKAI Malawa Waidalua Haleiwa Punaluu Kadawa Waidalua Haleiwa Pearl City Kanahalu Kajaluu K

FED. ROAD DIST. NO.

83F-01-88M | 1988

NO SIGNIFICANT CHANGES WERE MADE DURING CONSTRUCTION ON THESE PLANS EXCEPT CHANGES IN THE ORIGINAL THEORETICAL QUANTITIES. FOR ACTUAL QUANTITIES, REFER TO PROJECT LEDGER AND/OR COMPUTATION BOOK.

Devi T. Hya RESIDENT ENGINEER

2/7/89 DATE

DEPARTMENT OF TRANSPORTATION STATE OF HAWAII APPROVED:

DIR. OF TRANSPORTATION

01-8-8-00