
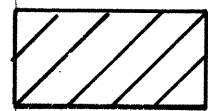


FED. ROAD DIST. NO.	STATE	PROJ. NO.	FISCAL YEAR	SHEET NO.	TOTAL SHEETS
HAWAII	HAW.	930D-01-88M	1988	5	20

LEGEND

-  Resurfacing Areas
-  Resurfacing Limits

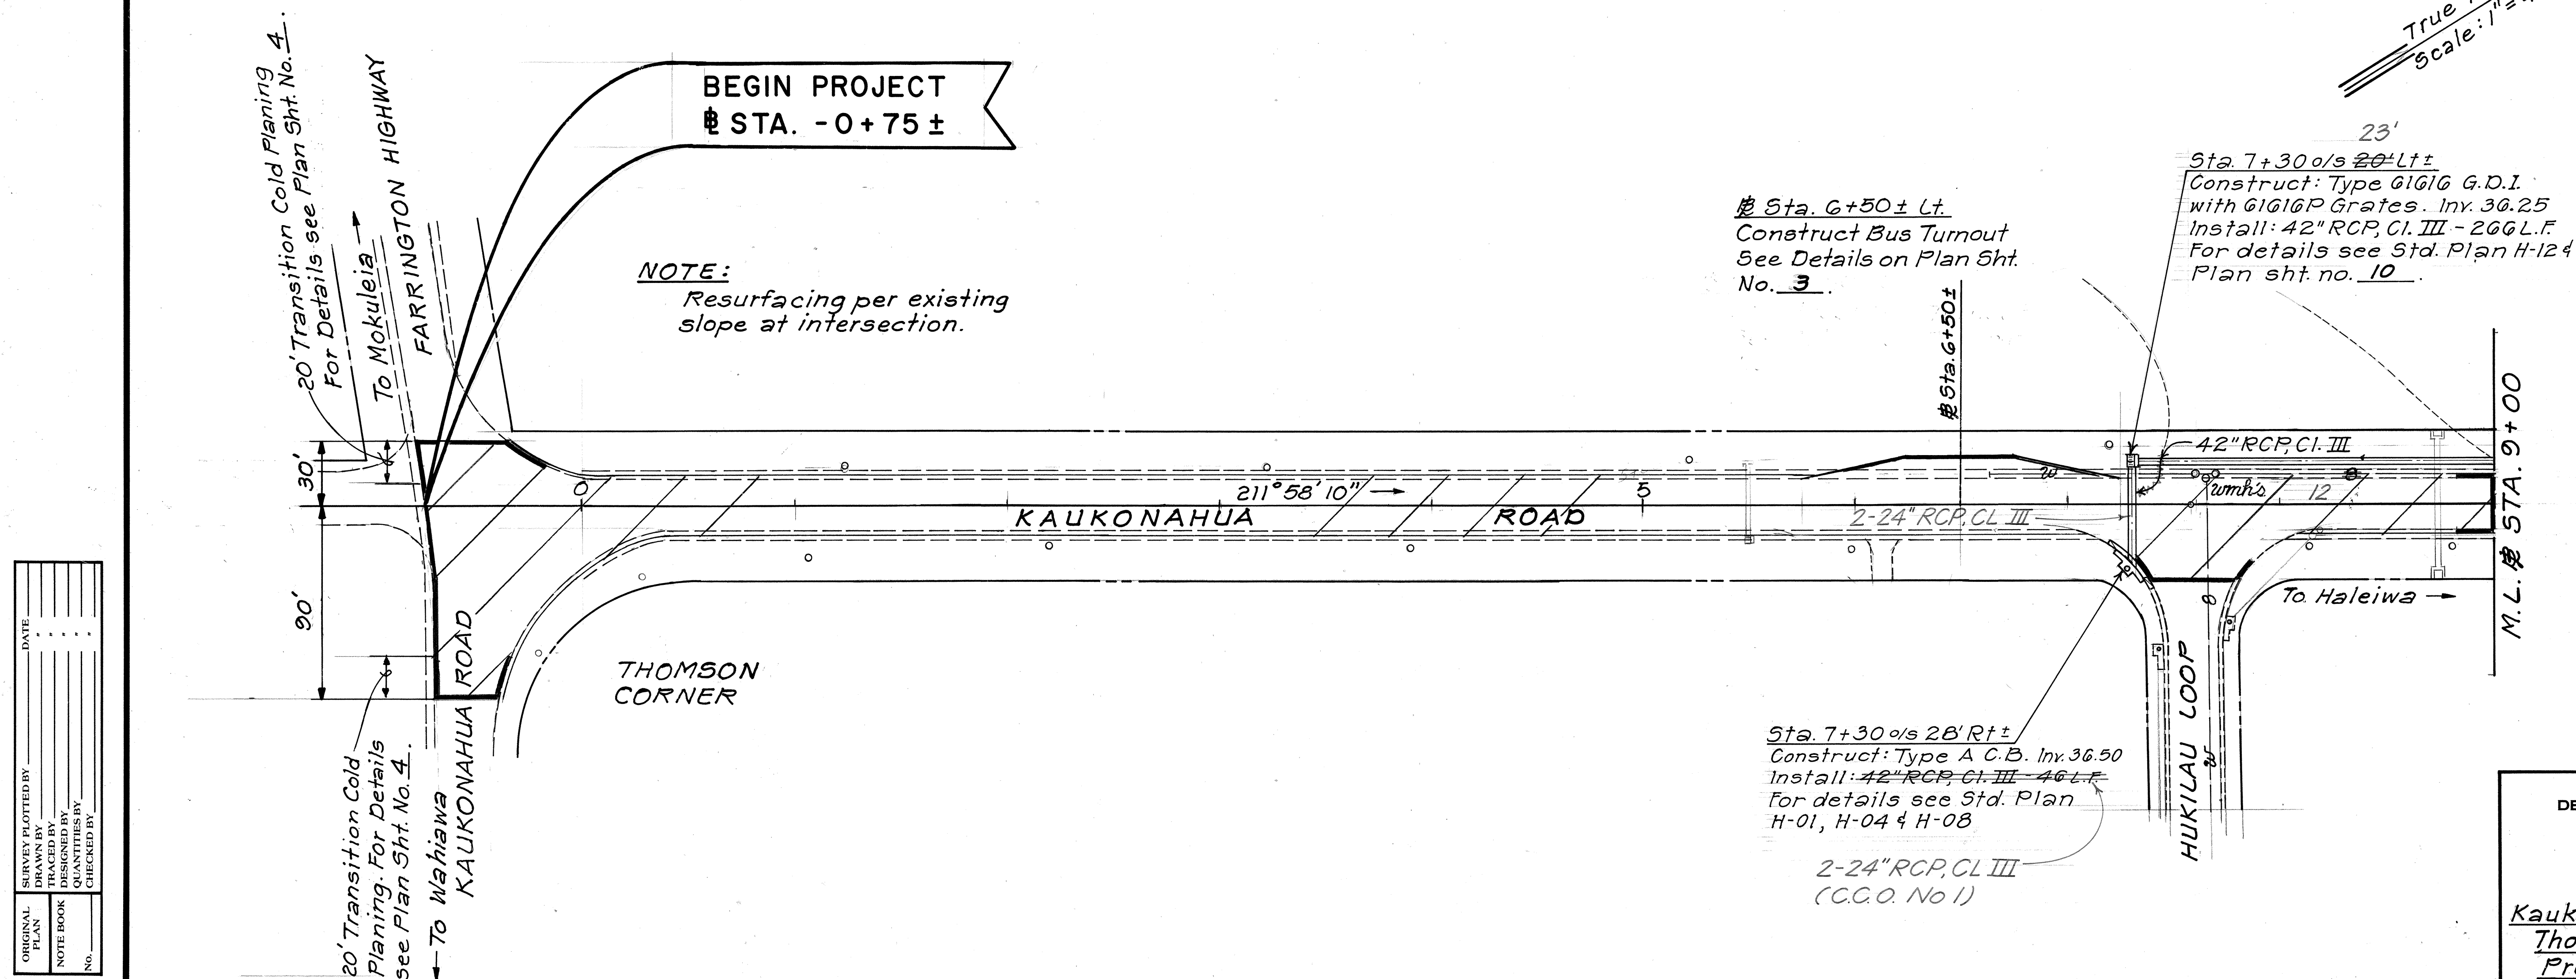

ORIGINAL PLAN	SURVEY PLOTTED BY	DATE
NOTE BOOK	DRAWN BY	
No.	DESIGNED BY	
	QUANTITIES BY	
	CHECKED BY	

STATE OF HAWAII
DEPARTMENT OF TRANSPORTATION
HIGHWAYS DIVISION

PLAN

Kaukonahua Road Resurfacing
Thomson Corner to Weed Jct.
Project No. 930D-01-88M


Scale: 1"=40' Date: April, 1988

SHEET No. 1 OF 5 SHEETS

FED. ROAD DIST. NO.	STATE	PROJ. NO.	FISCAL YEAR	SHEET NO.	TOTAL SHEETS
HAWAII	HAW.	930D-01-88M	1988	6	20

True North
Scale: 1"=40'


True North
Scale: 1"=40'

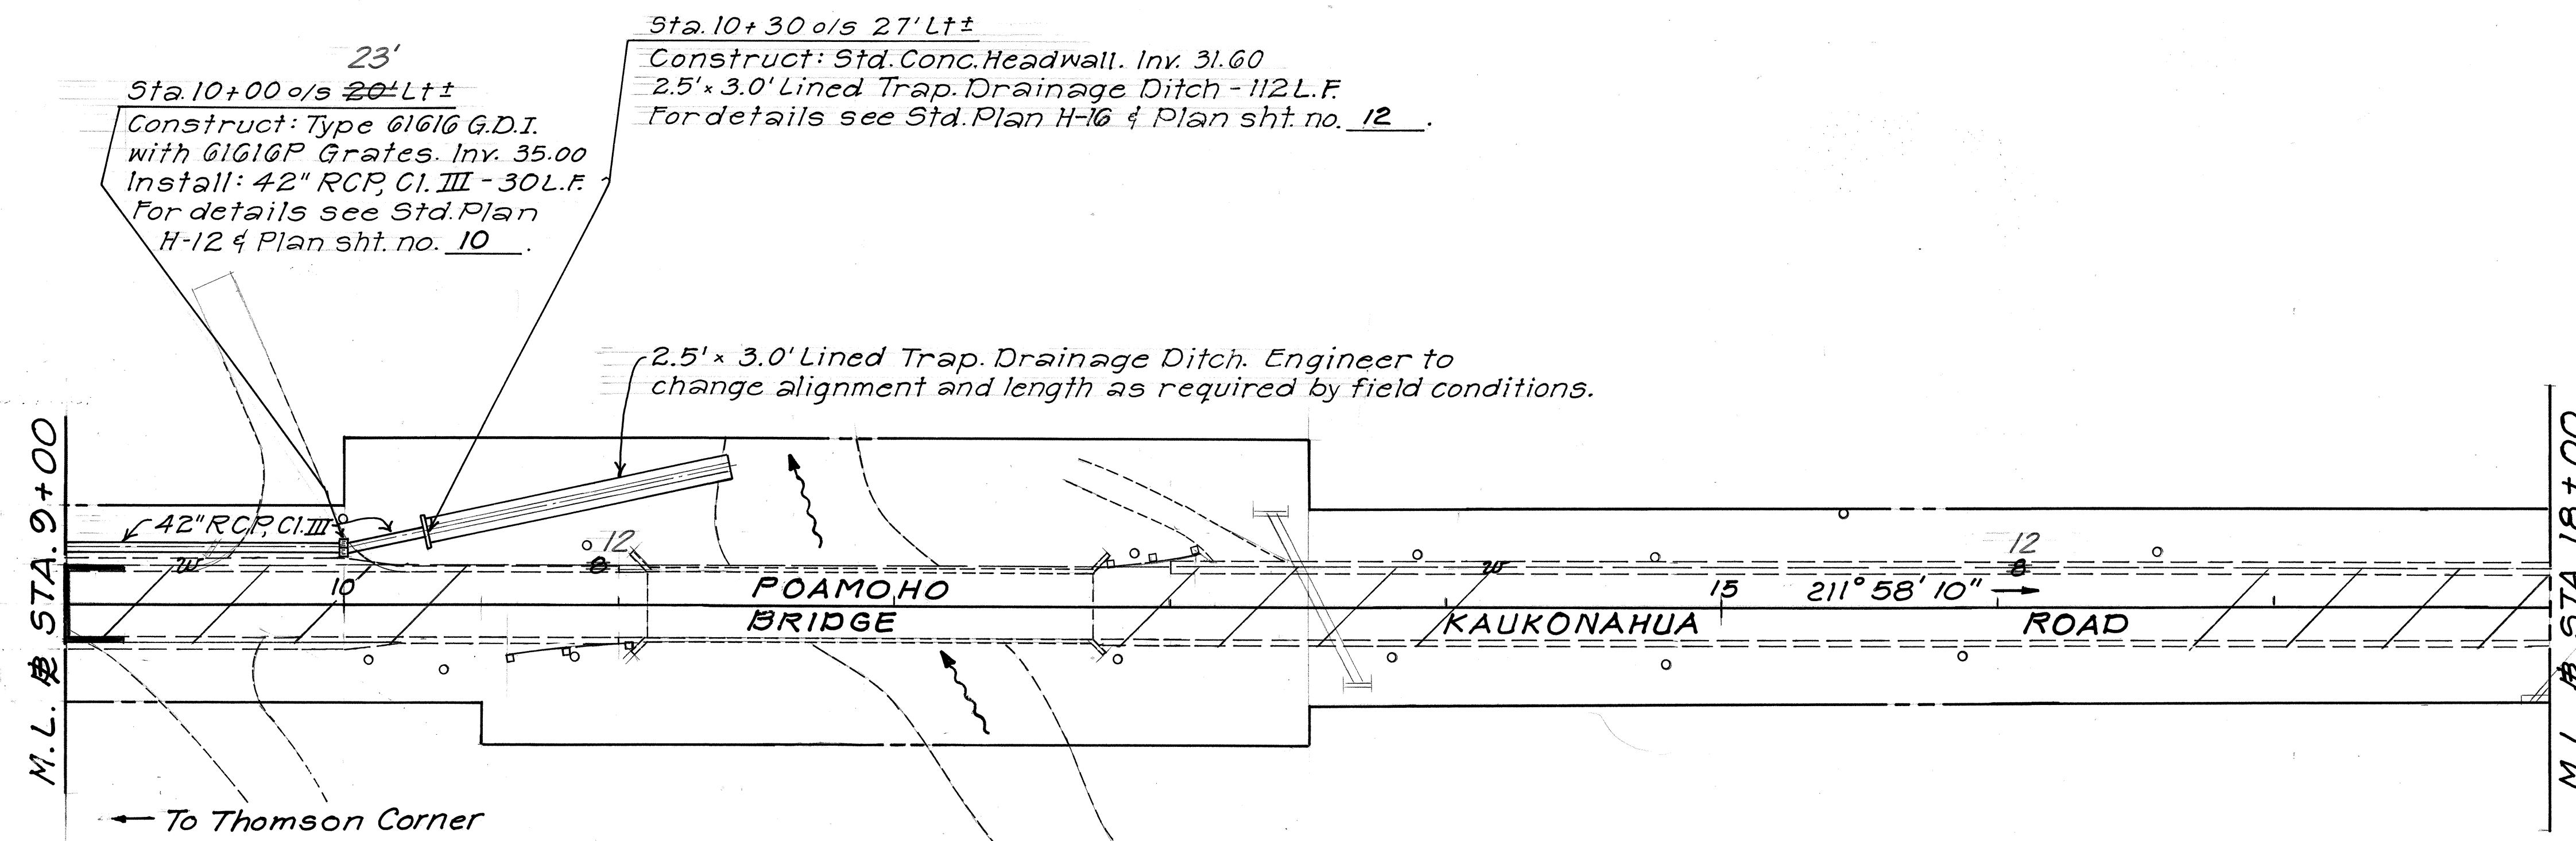

CURVE DATA
 $\Delta = 17^\circ 05' 40''$
 $R = 1432.50'$
 $T = 212.98'$
 $L_c = 427.39'$

(C.C.O. No. 3)
See Sht. C.O. 125-1,
Paved two driveways
Constructed earth
swale.

Waterline is 12-inch
till Kiekonea Way.

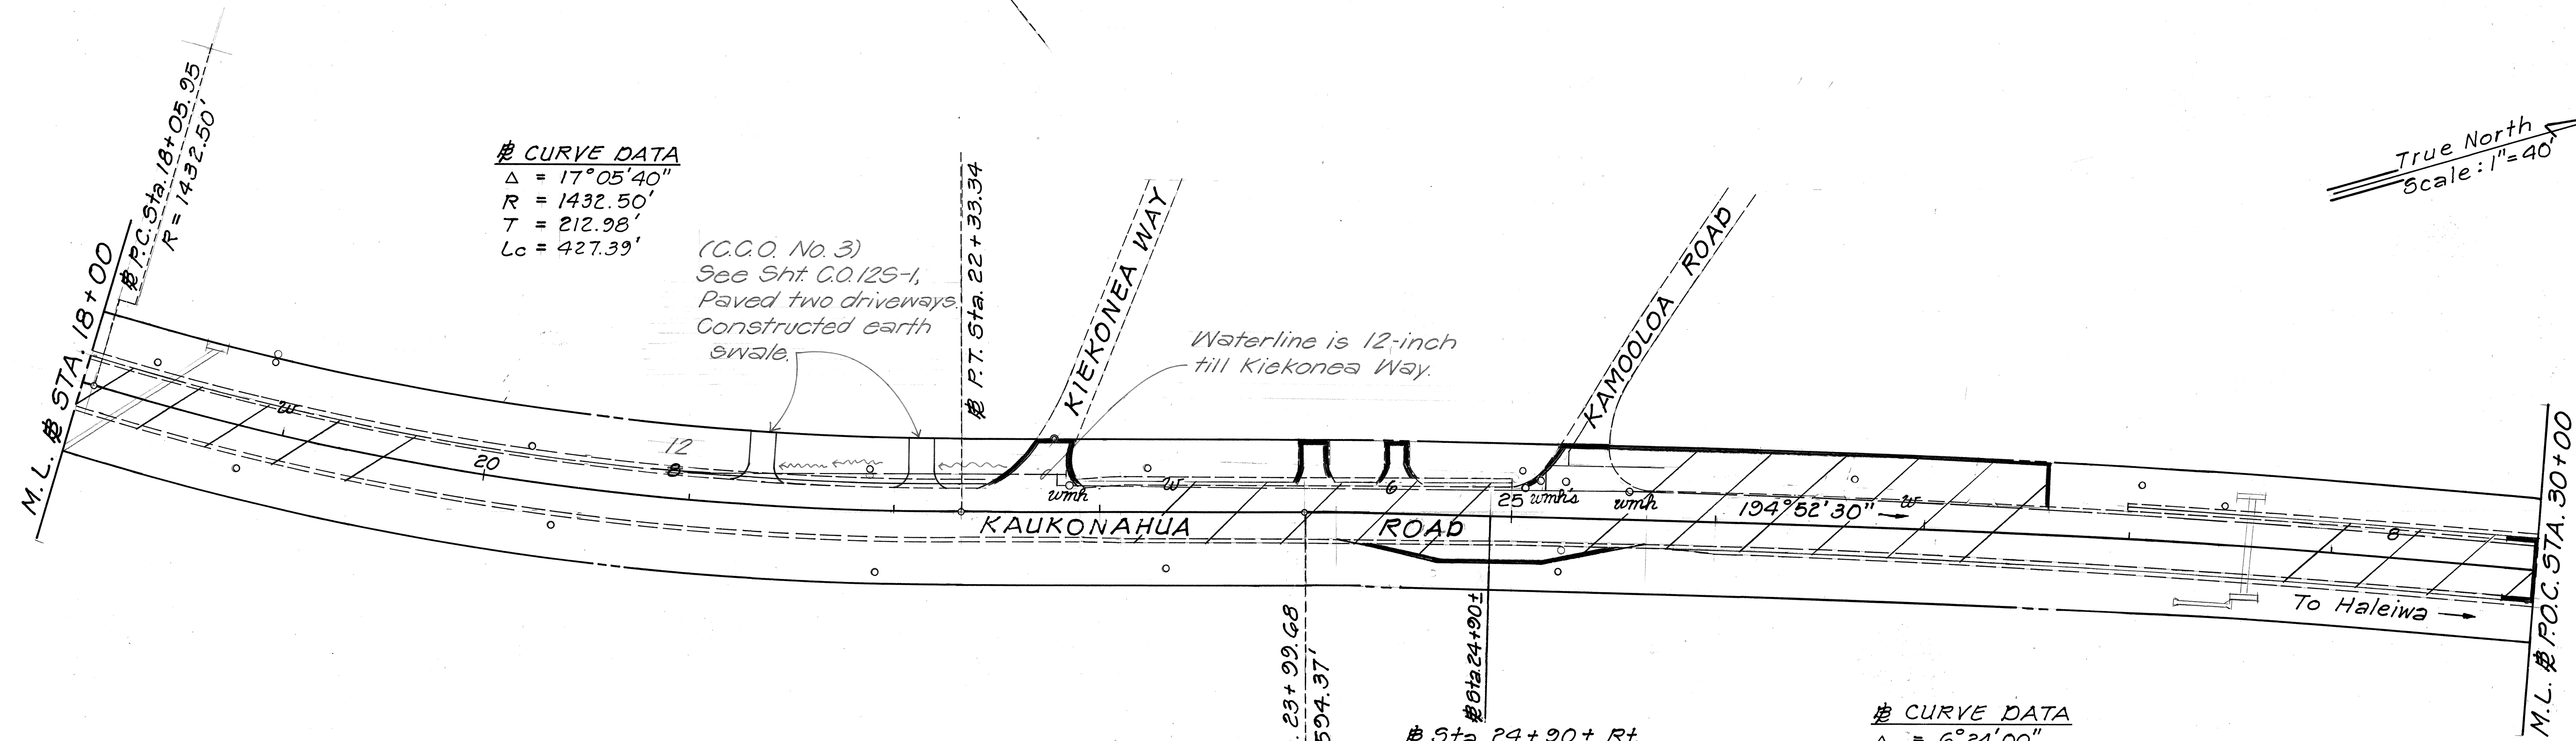

CURVE DATA
 $\Delta = 6^\circ 24' 00''$
 $R = 8594.37'$
 $T = 480.50'$
 $L_c = 960.00'$

Sta. 24+90 ± Rt.
Construct Bus Turnout
See Details on Plan Sht.
No. 3.

STATE OF HAWAII
DEPARTMENT OF TRANSPORTATION
HIGHWAYS DIVISION

PLAN



Kaukonahua Road Resurfacing
Thomson Corner to Weed Jct.
Project No. 930D-01-88M

Scale: 1"=40' Date: April, 1988

SHEET NO. 2 OF 5 SHEETS

ORIGINAL PLAN	DATE
DESIGNED BY	
TRACED BY	
NOTED BY	
CHECKED BY	

FED. ROAD DIST. NO.	STATE	PROJ. NO.	FISCAL YEAR	SHEET NO.	TOTAL SHEETS
HAWAII	HAW.	930D-01-88M	1988	7	20

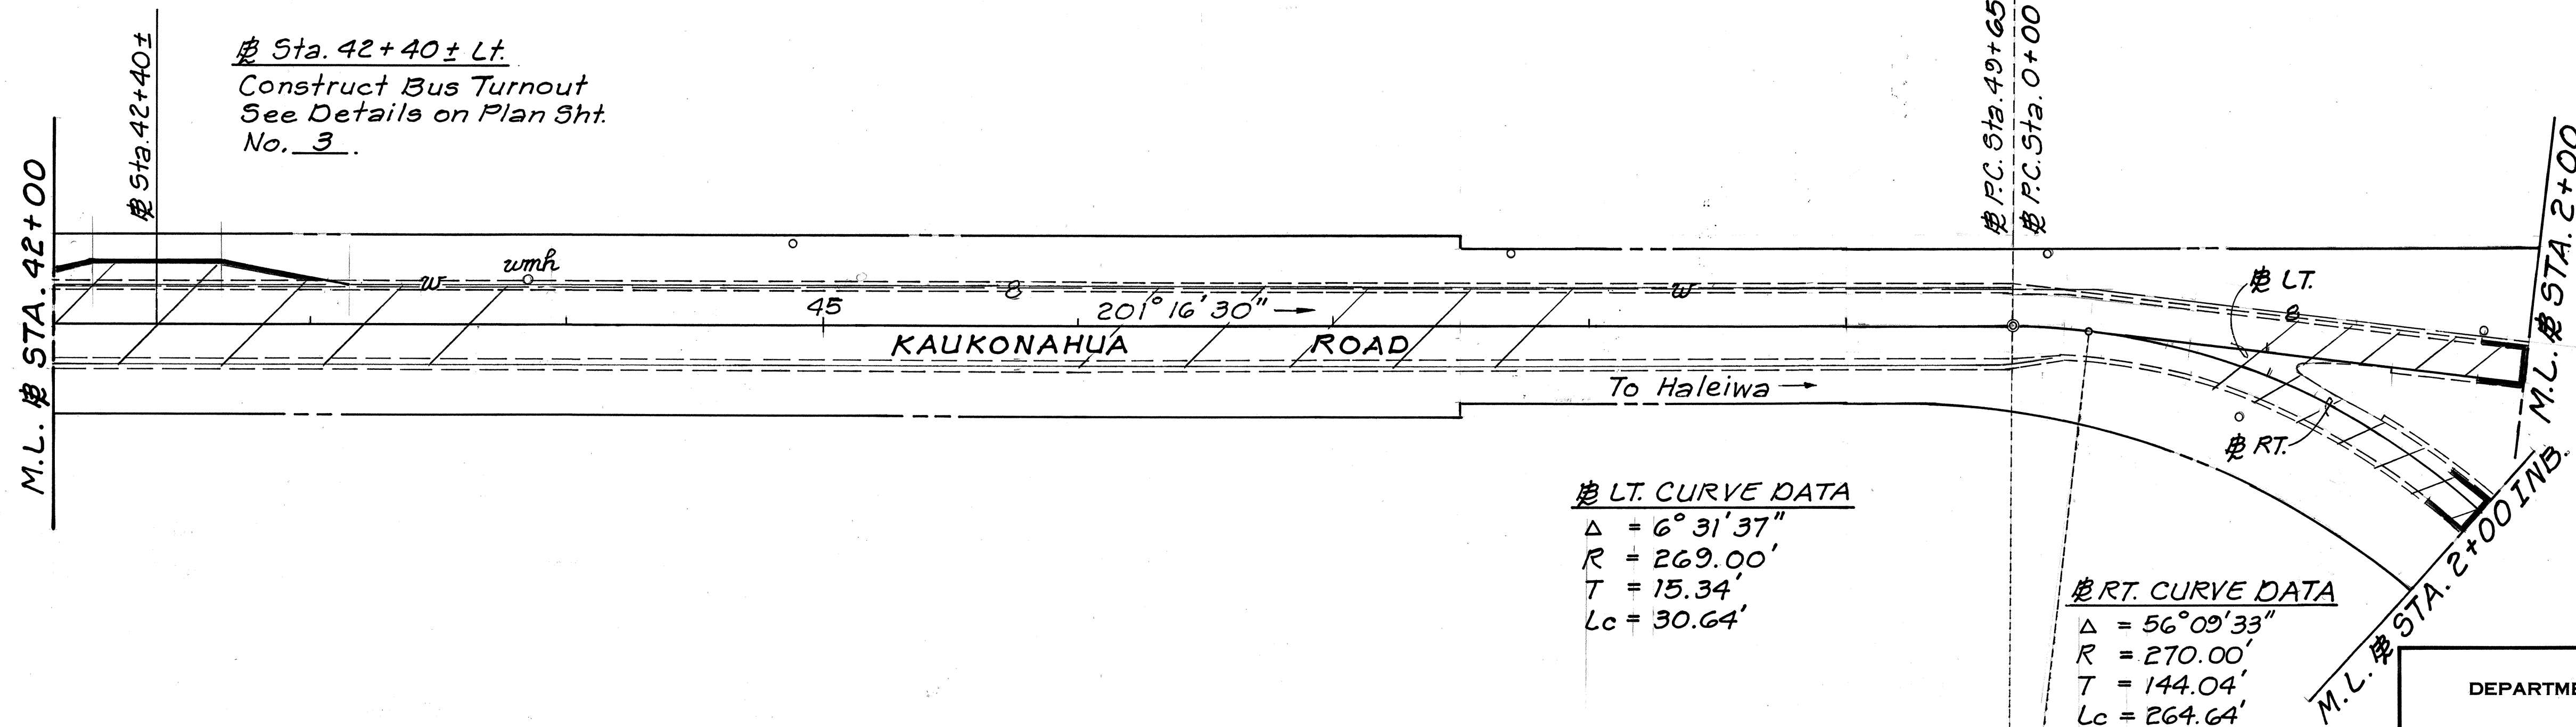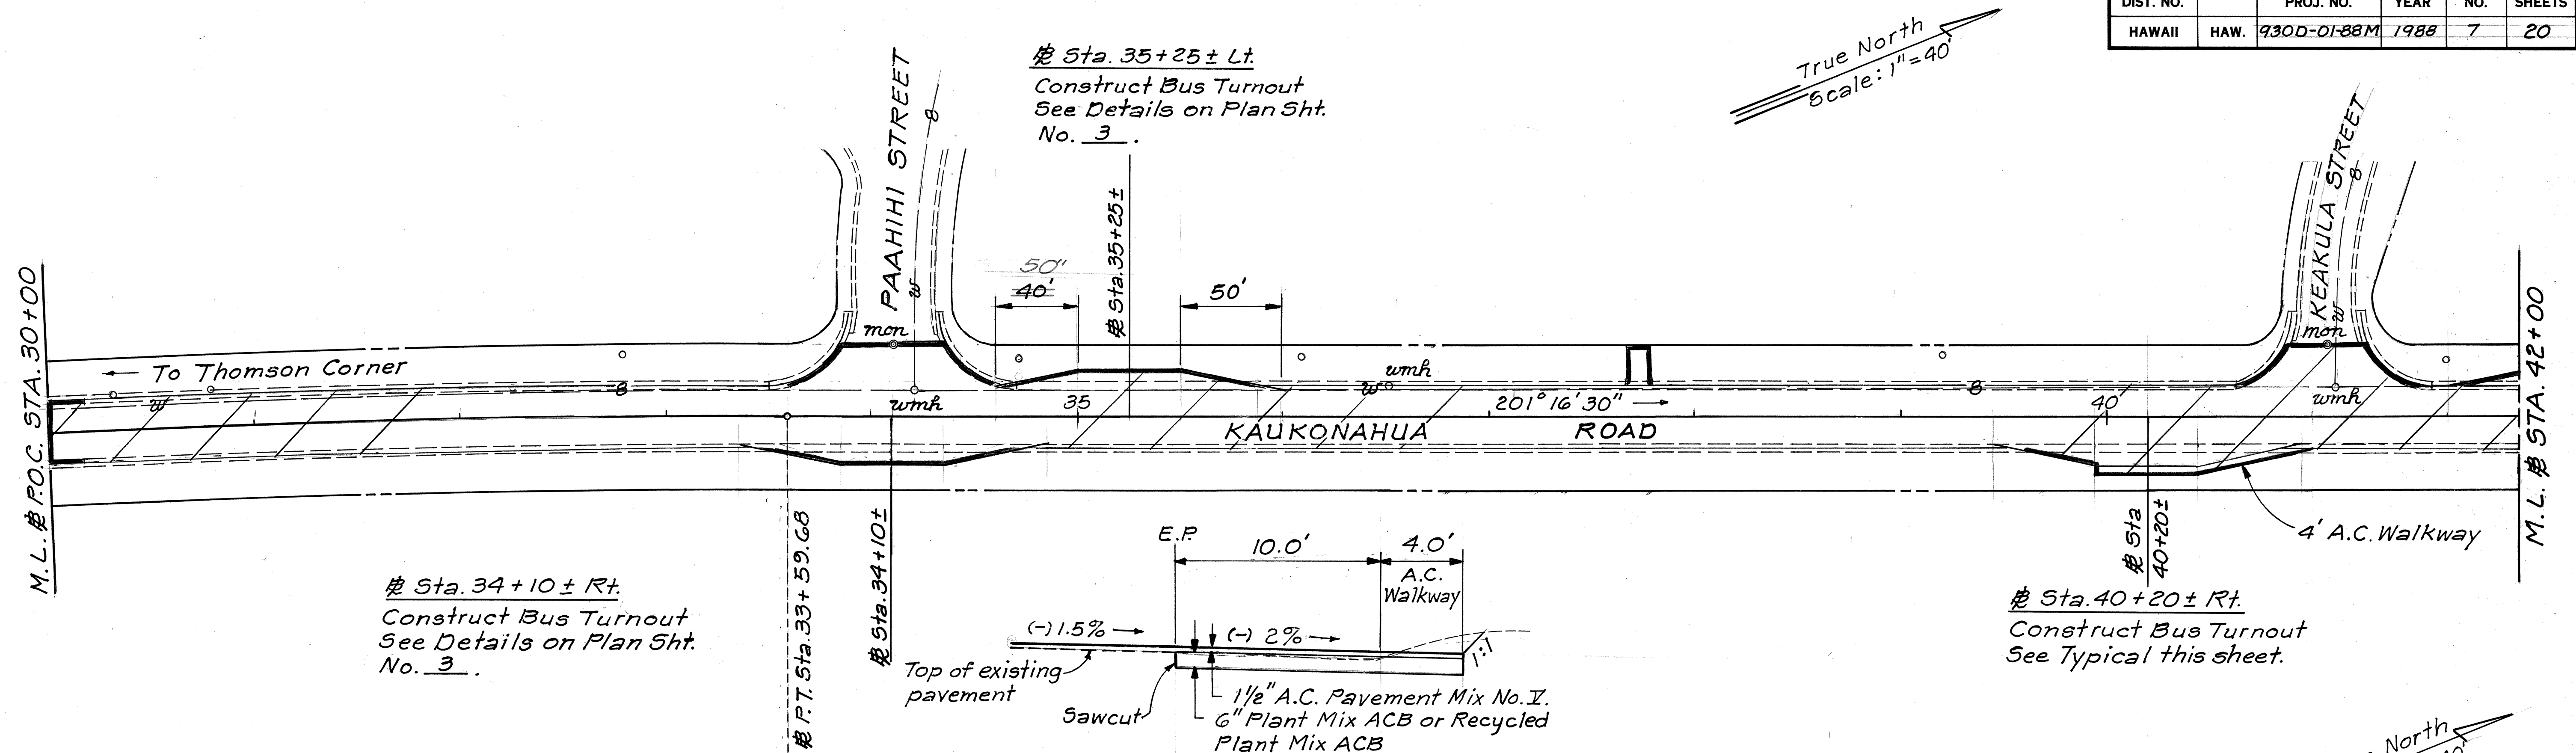

STATE OF HAWAII
DEPARTMENT OF TRANSPORTATION
HIGHWAYS DIVISION


PLAN

Kaukonahua Road Resurfacing
Thomson Corner to Weed Jct.
Project No. 930D-01-88M

Scale: 1"=40' Date: April, 1988
SHEET NO. 3 OF 5 SHEETS

ORIGINAL PLAN	DATE
DRAWN BY	
DESIGNED BY	
CHECKED BY	
NO.	

FED. ROAD DIST. NO.	STATE	PROJ. NO.	FISCAL YEAR	SHEET NO.	TOTAL SHEETS
HAWAII	HAW.	9300-01-88M	1988	8	20

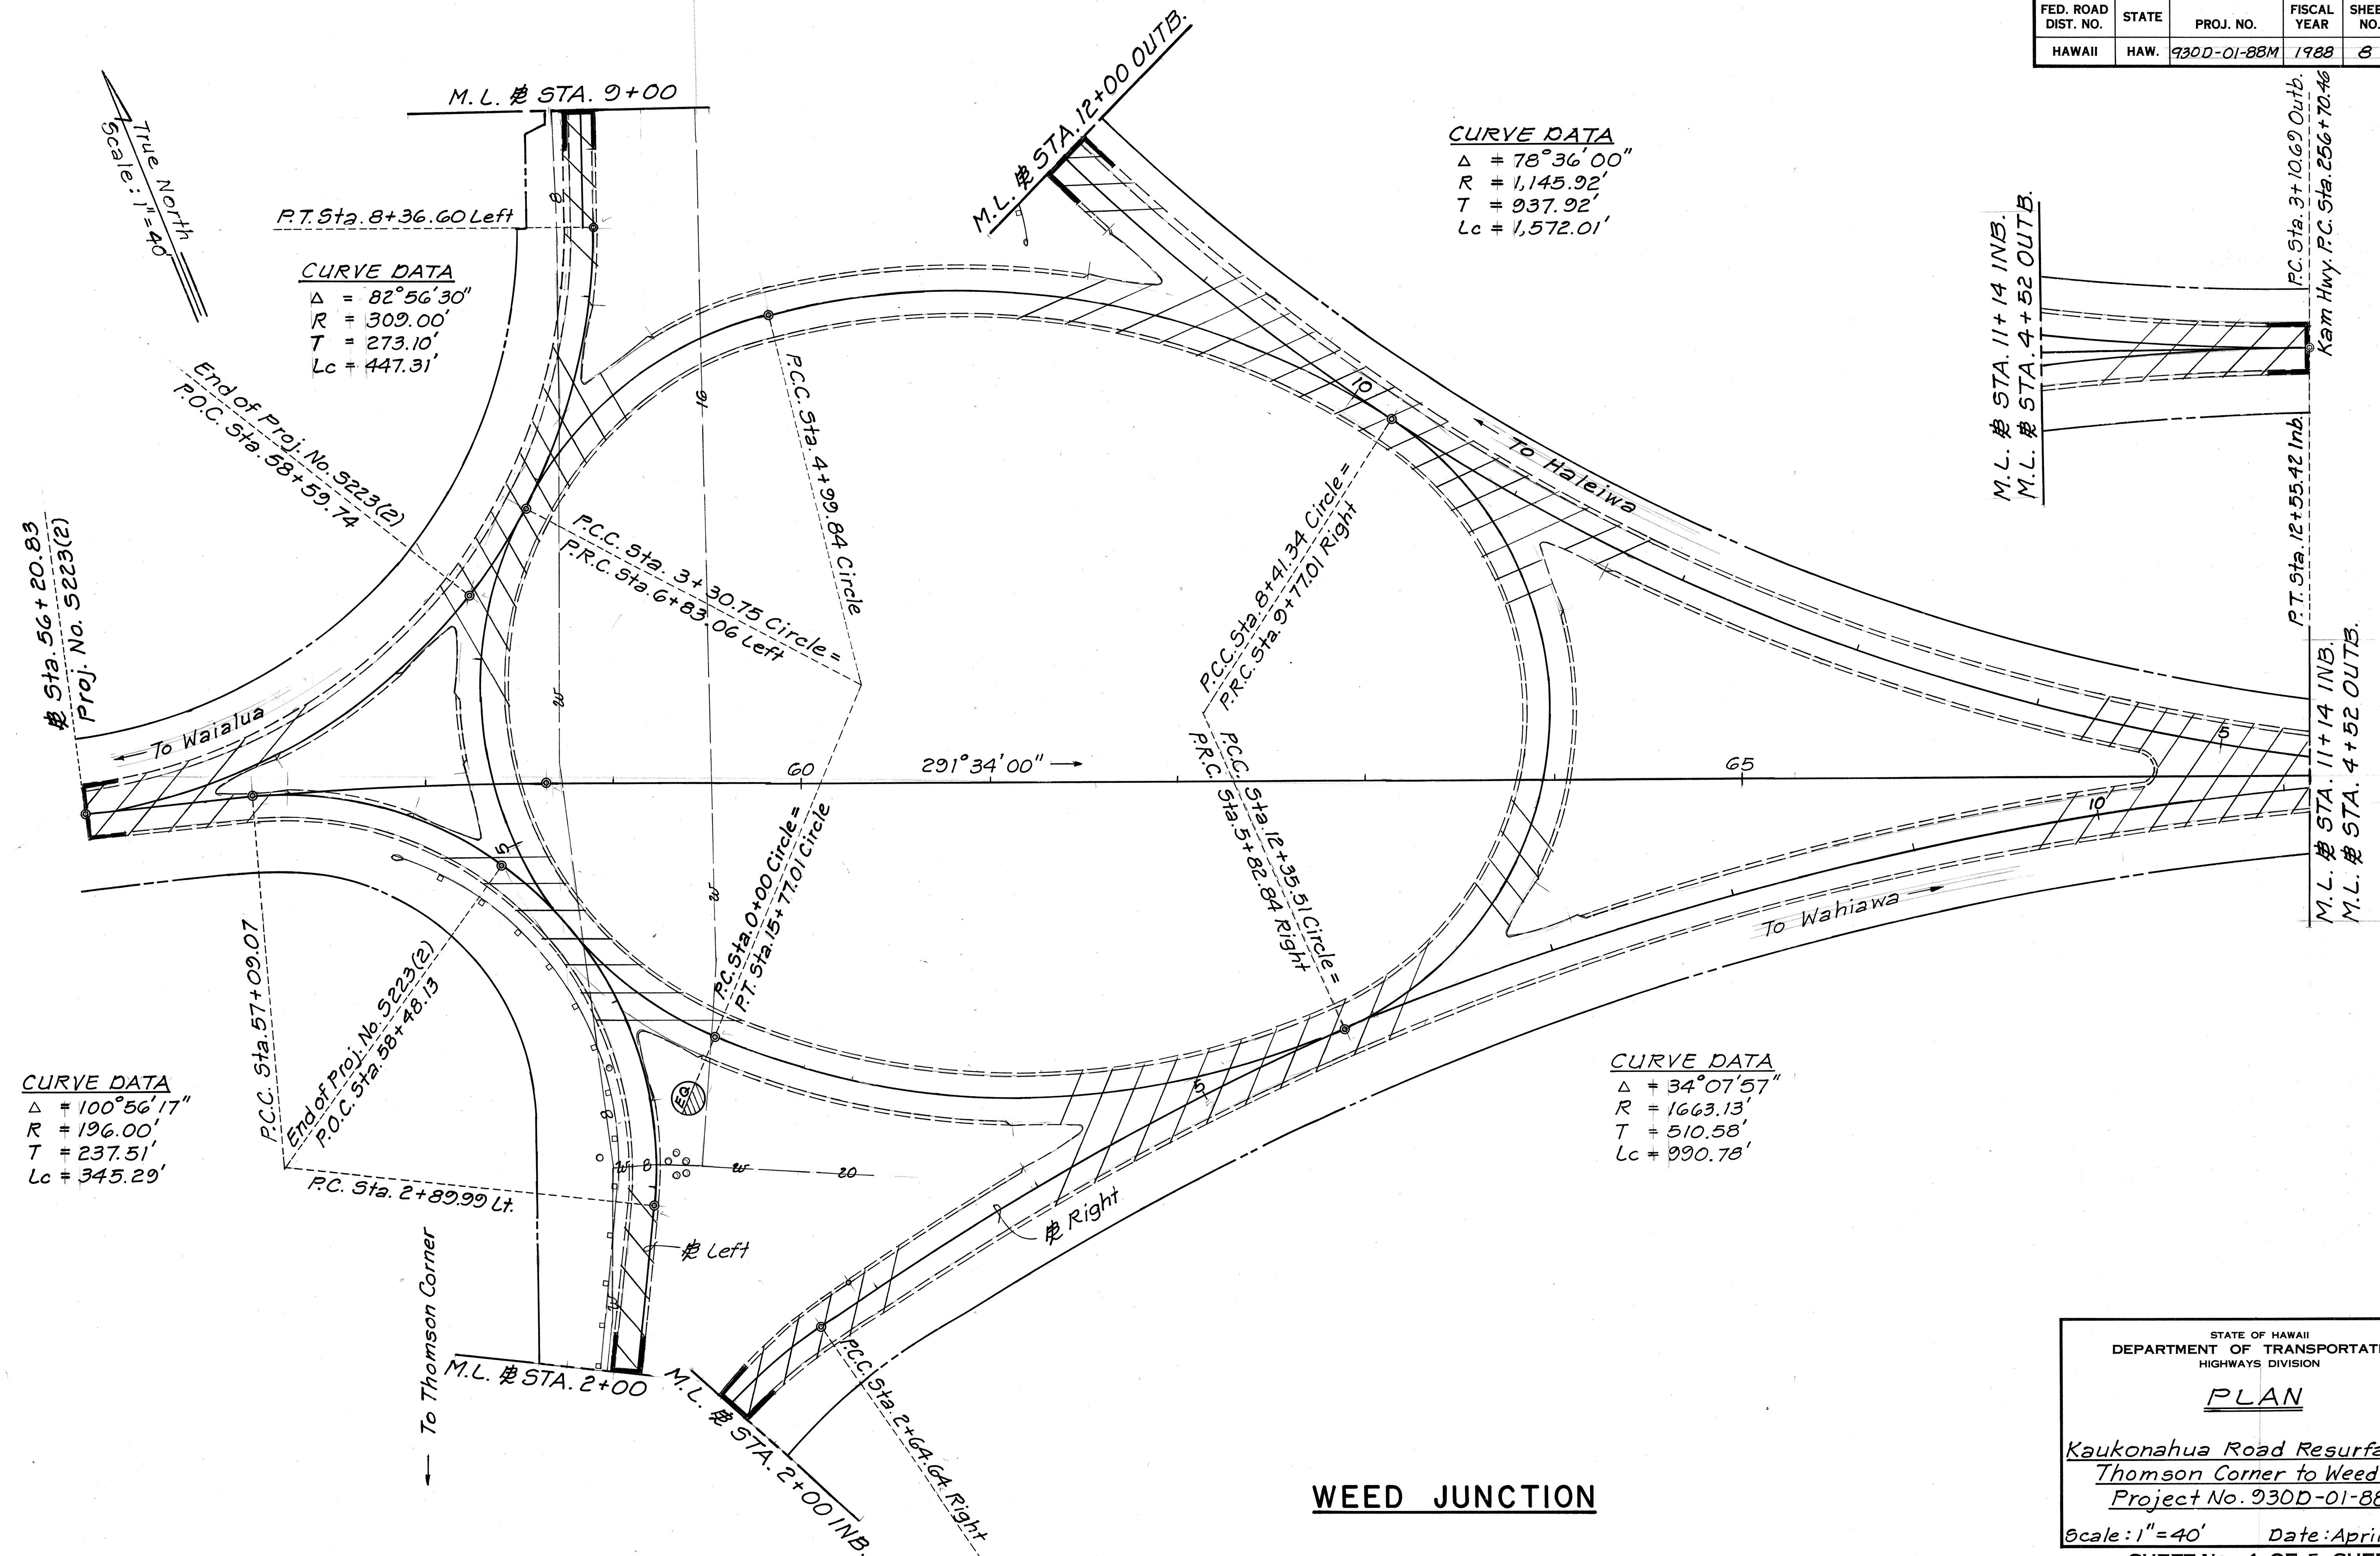

ORIGINAL PLAN	SURVEY PLOTTED BY _____ DATE _____
NOTE BOOK	DRAWN BY _____
	TRACED BY _____
	DESIGNED BY _____
	QUANTITIES BY _____
No. _____	CHECKED BY _____
No. _____	

STATE OF HAWAII
DEPARTMENT OF TRANSPORTATION
HIGHWAYS DIVISION

PLAN


Kaukonahua Road Resurfacing
Thomson Corner to Weed Jct.
Project No. 930D-01-88M

Scale: 1" = 40' Date: April, 1988

SHEET No. 4 OF 5 SHEETS

FED. ROAD DIST. NO.	STATE	PROJ. NO.	FISCAL YEAR	SHEET NO.	TOTAL SHEETS
HAWAII	HAW.	930D-01-88M	1988	9	20

True North
Scale: 1"=40'

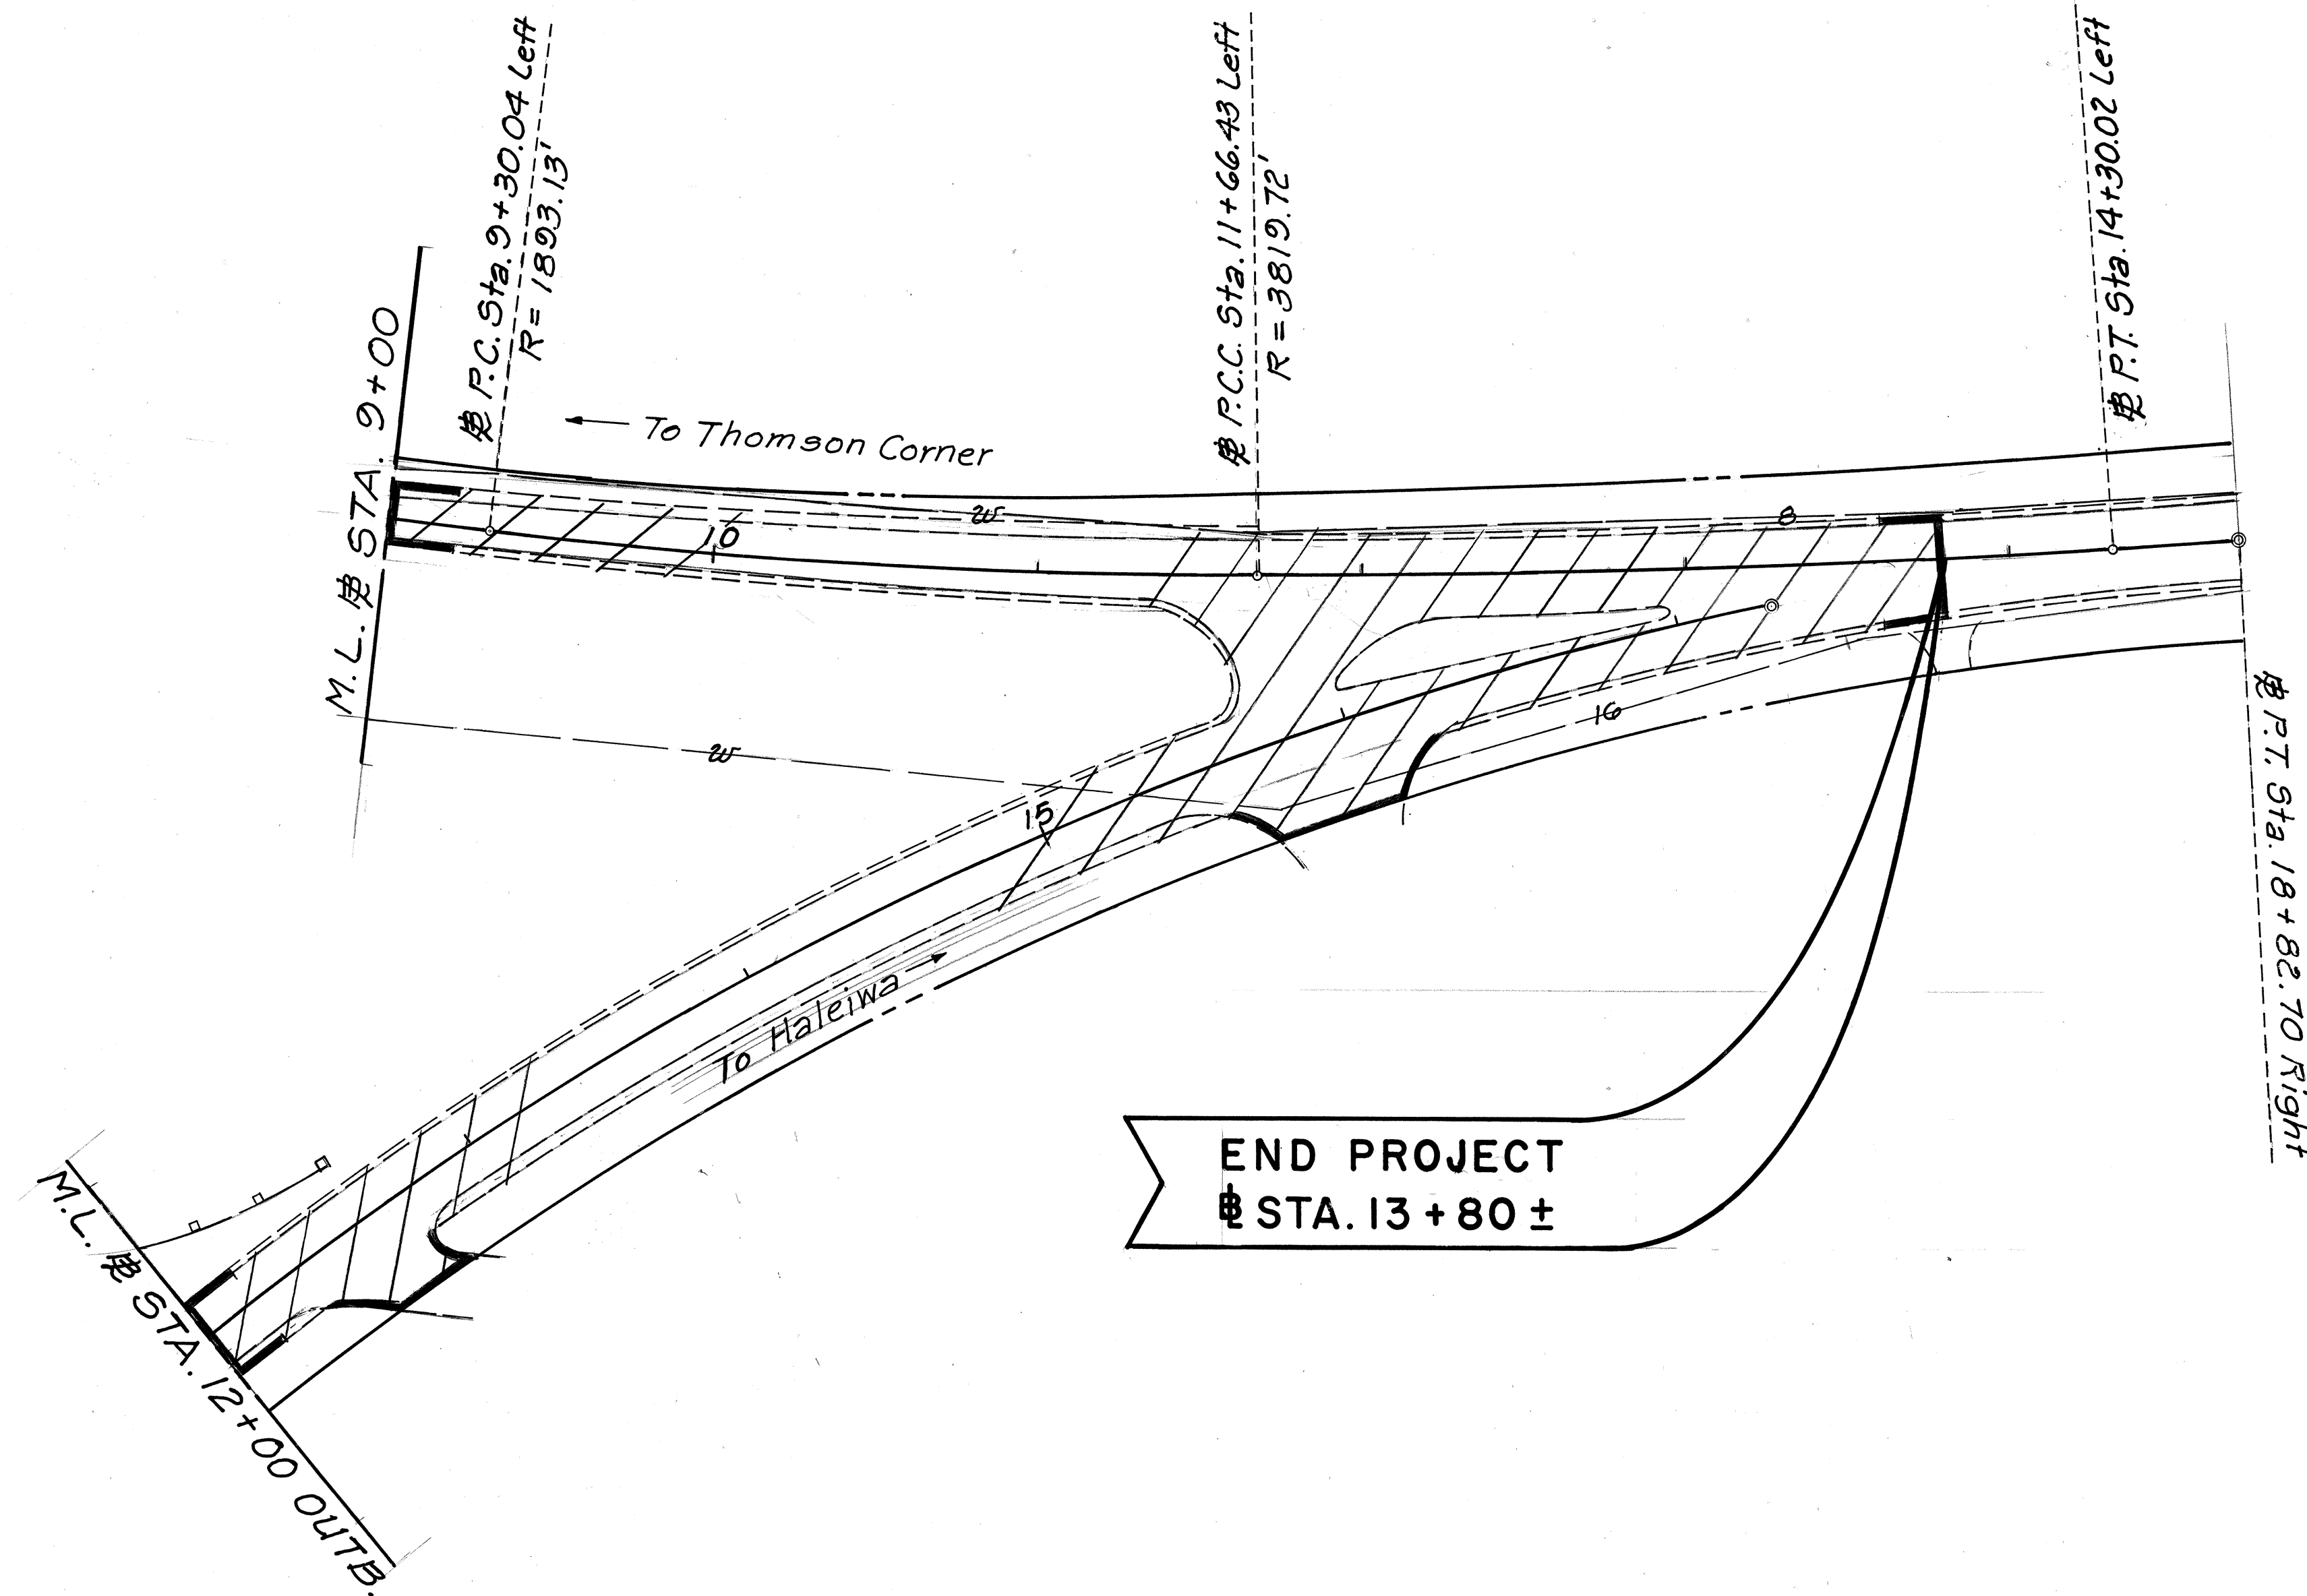

ORIGINAL PLAN	SURVEY PLOTTED BY	DATE
NOTE BOOK	DRAWN BY	
No.	DESIGNED BY	
	CHECKED BY	

STATE OF HAWAII
DEPARTMENT OF TRANSPORTATION
HIGHWAYS DIVISION

PLAN

Kaukonahua Road Resurfacing
Thomson Corner to Weed Jct.
Project No. 930D-01-88M

Scale: 1"=40' Date: April, 1988

SHEET NO. 5 OF 5 SHEETS