	√′
	INDEX TO DRAWINGS
SHEET NO.	DESCRIPTION
	TITLE SHEET
2	STANDARD PLANS SUMMARY
3	GENERAL NOTES & TYP. SECTIONS
4	TYPICAL SECTIONS & DETAILS
5-9	PLANS
10-12	DRAINAGE DETAILS
13-20	SIGNING AND STRIPING PLANS AND DETAILS
• .	
***************************************	
-	

\* C.O.12S-I IS A SUPPLEMENT SHEET TO THE CONTRACT PLANS. TOTAL = 21 SHEETS


STATE OF HAWAII


DEPARTMENT OF TRANSPORTATION HIGHWAYS DIVISION HONOLULU, HAWAII "AS-BUILT" PLANS FOR

KAUKONAHUA ROAD RESURFACING THOMSON CORNER TO WEED JUNCTION

PROJECT NO. 930D - 01 - 88M

DISTRICT OF WAIALUA ISLAND OF OAHU

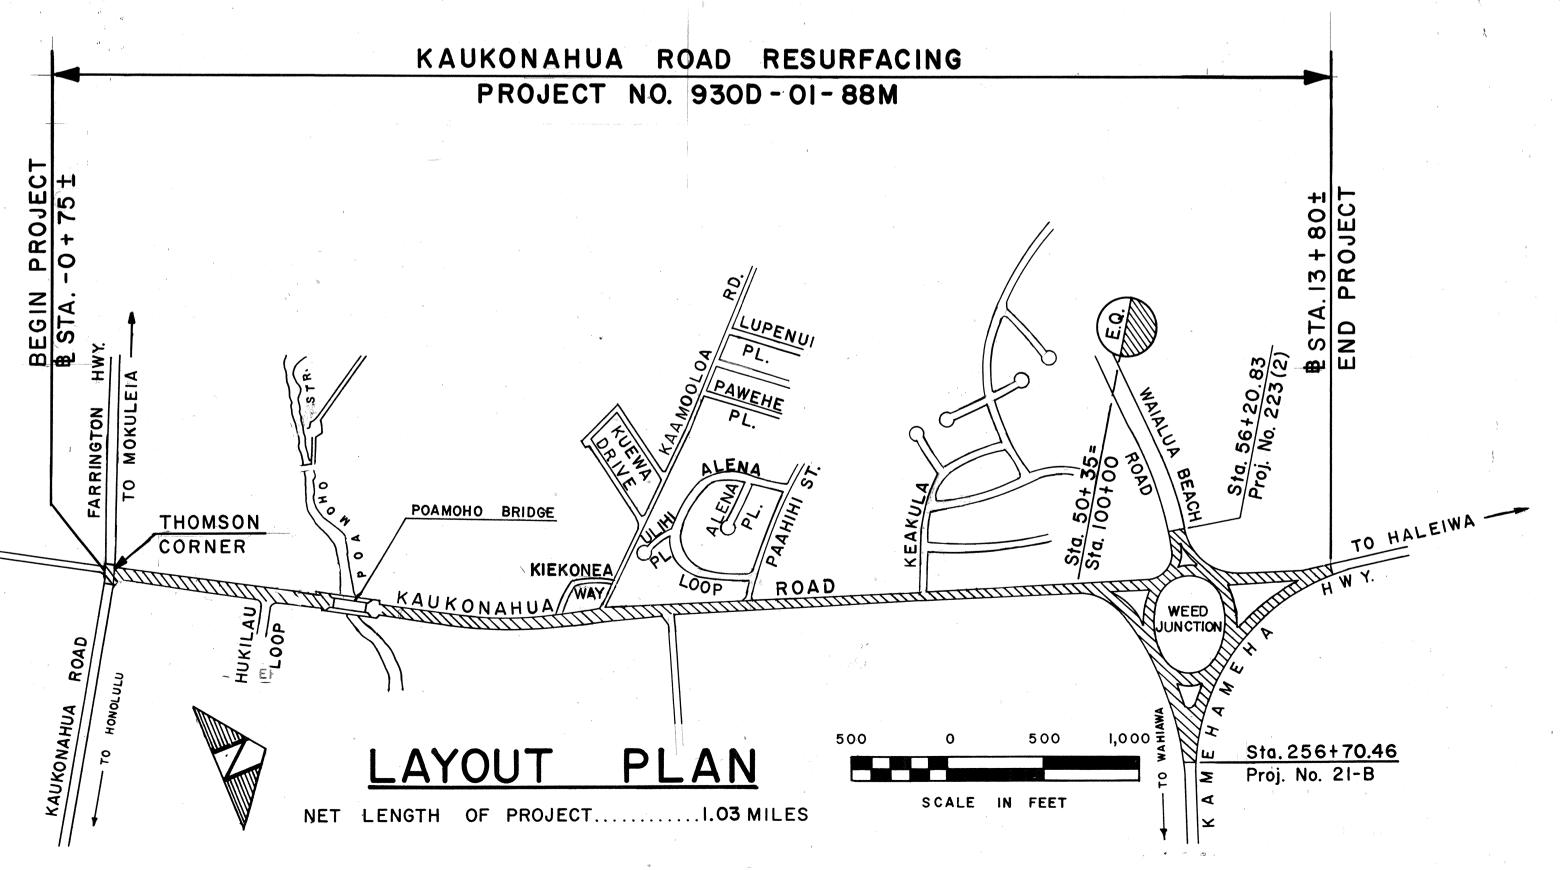

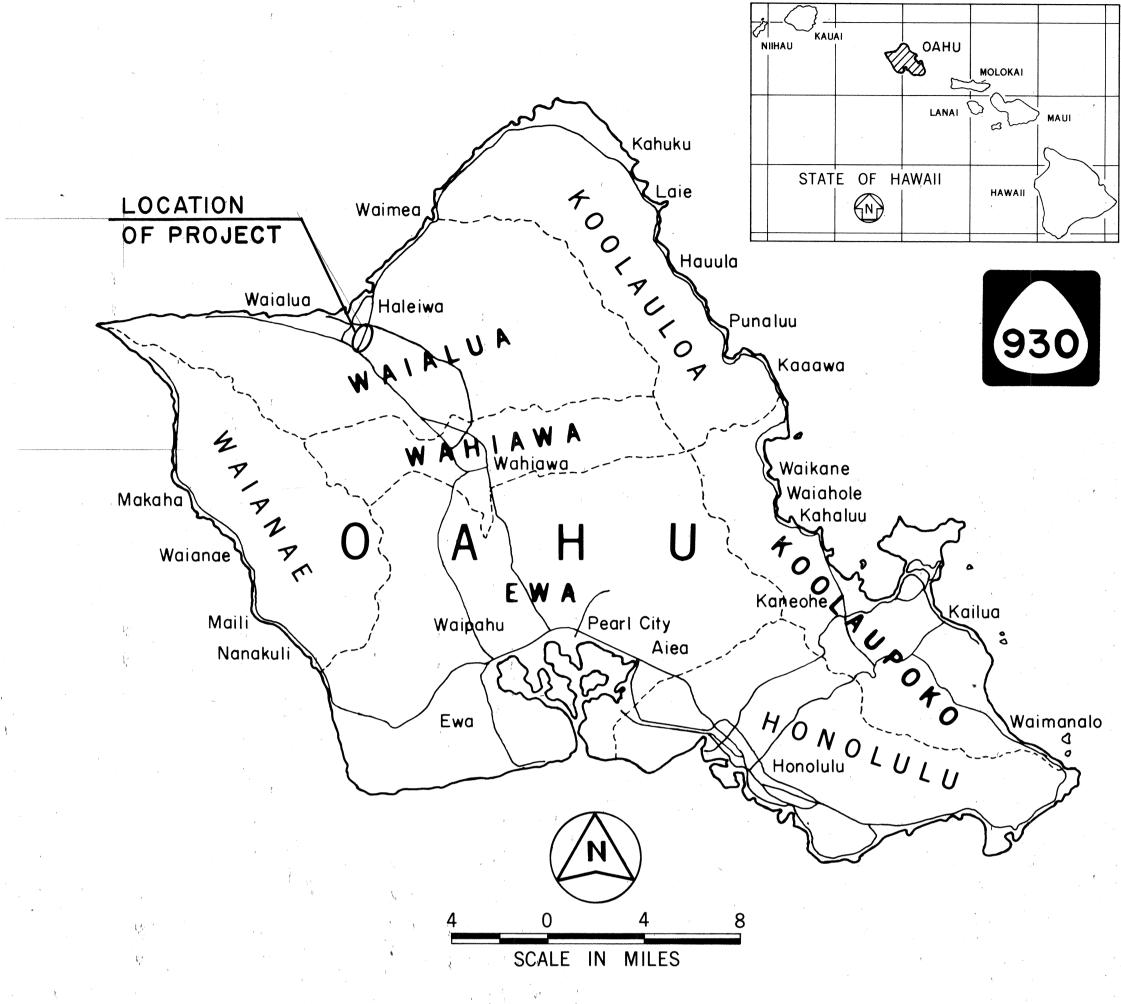

FED. ROAD DIST. NO.

QUANTITIES. FOR ACTUAL QUANTITIES, REFER TO PROJECT LEDGER AND/OR COMPUTATION BOOK

FISCAL SHEET YEAR NO.

PROJ. NO.

930D-01-88M

DEPARTMENT OF TRANSPORTATION STATE OF HAWAII