


FED. ROAD DIST. NO.	STATE	PROJ. NO.	FISCAL YEAR	SHEET NO.	TOTAL SHEETS
HAWAII	HAW.	83G-01-88M	1988	13	18

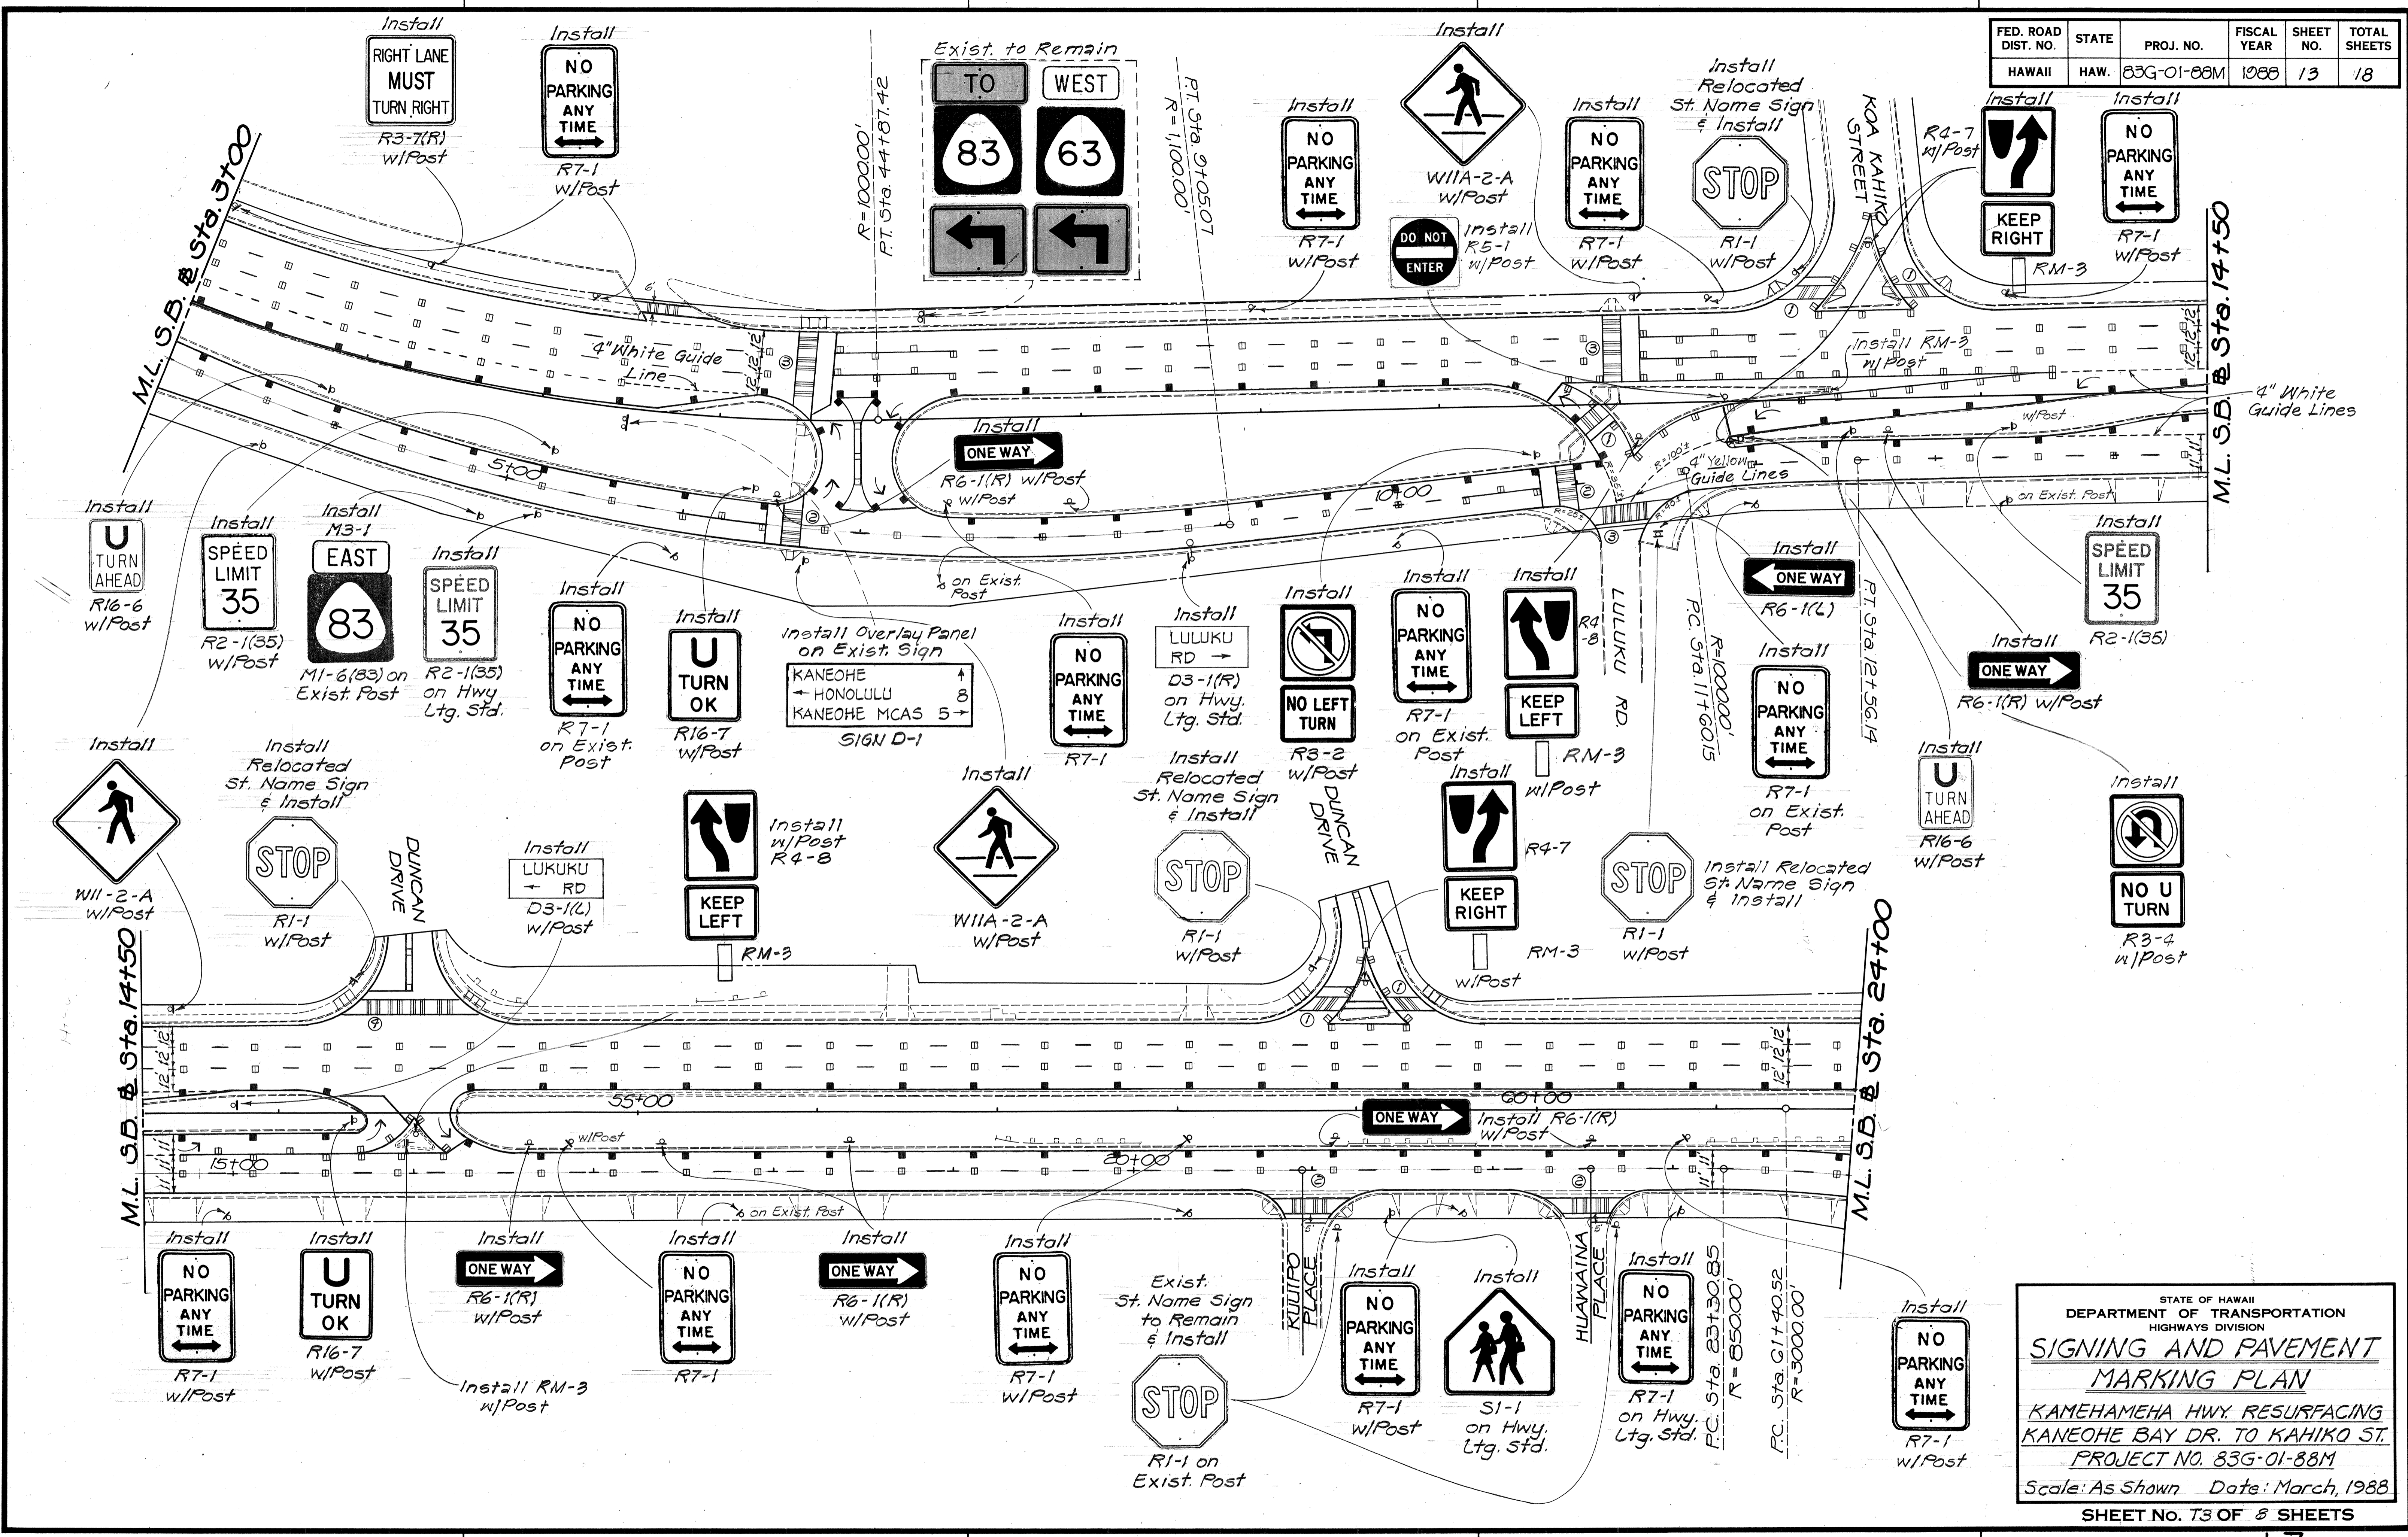

DATE	_____
SURVEY PLOTTED BY	_____
DRAWN BY	_____
DESIGNED BY	_____
QUANTITIES BY	_____
CHECKED BY	_____
ORIGINAL PLAN	_____
NOTE BOOK	_____
No.	_____

STATE OF HAWAII
DEPARTMENT OF TRANSPORTATION
HIGHWAYS DIVISION


SIGNING AND PAVEMENT MARKING PLAN

KAMEHAMEHA HWY. RESURFACING
KANEHOE BAY DR. TO KAHIKO ST.
PROJECT NO. 83G-01-88M

Scale: As Shown Date: March, 1988

SHEET NO. 13 OF 8 SHEETS

FED. ROAD DIST. NO.	STATE	PROJ. NO.	FISCAL YEAR	SHEET NO.	TOTAL SHEETS
HAWAII	HAW.	83G-01-88M	1988	15	18

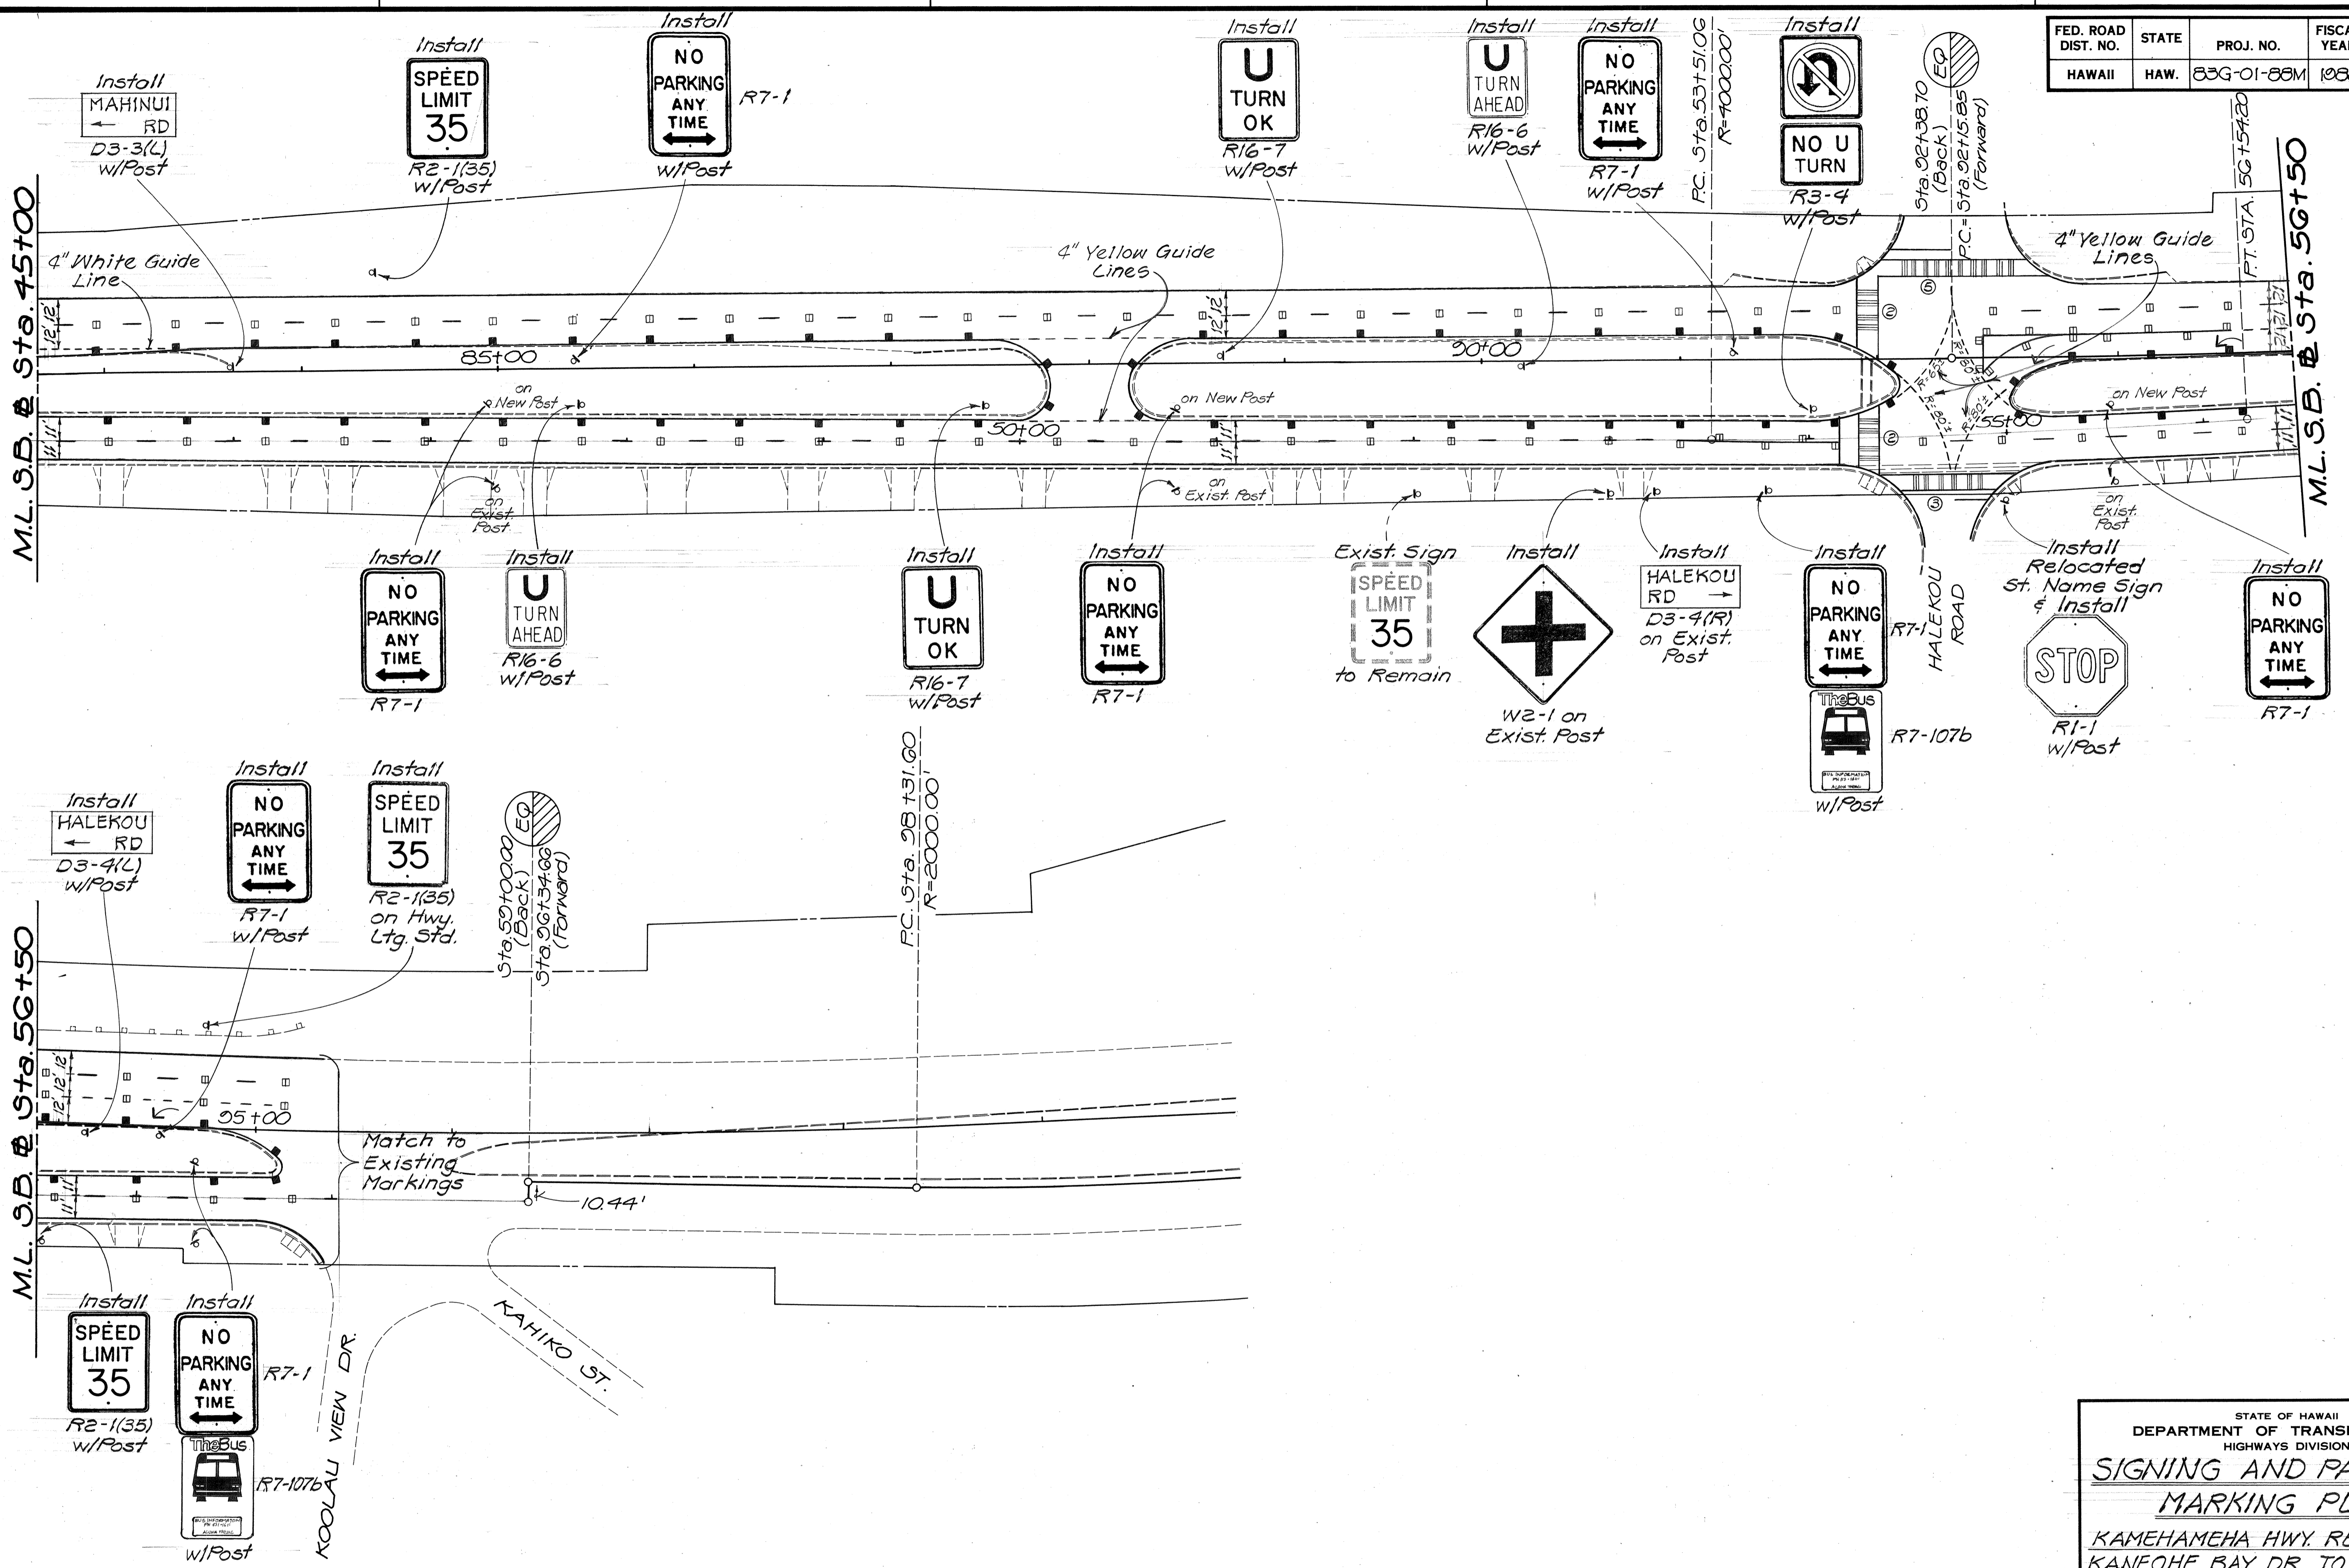

SURVEY PLOTTED BY	DATE
DRAWN BY	
TRACED BY	
QUANTITIES BY	
CHECKED BY	
ORIGINAL PLAN	
NOTE BOOK	
No.	

STATE OF HAWAII
DEPARTMENT OF TRANSPORTATION
HIGHWAYS DIVISION
SIGNING AND PAVEMENT MARKING PLAN
KAMEHAMEHA HWY. RESURFACING
KANEHOE BAY DR. TO KAHIKO ST.
PROJECT NO. 83G-01-88M
Scale: As Shown Date: March, 1988
SHEET NO. 15 OF 8 SHEETS