

INDEX TO DRAWINGS	
SHEET NO.	DESCRIPTION
1	TITLE SHEET
2	STANDARD PLANS SUMMARY
3 - 4	TYPICAL SECTIONS & MISCEL- LANEOUS RESURFACING DETAILS
5	GENERAL NOTES
6	MISC. SCHEDULES & LEGENDS
7 - 10	ROADWAY PLANS
11	PAVEMENT MARKING LEGEND, NOTES & DETAILS
12 - 15	SIGNING & PAVEMENT MARKING PLANS
16 - 18	MISC. TRAFFIC DETAILS & SUMMARIES

STATE OF HAWAII

DEPARTMENT OF TRANSPORTATION

HIGHWAYS DIVISION

HONOLULU, HAWAII

"AS BUILT"

PLANS FOR



KAMEHAMEHA HIGHWAY RESURFACING

KANEOME BAY DRIVE TO KAHIKO STREET

PROJECT NO. 83G-01-88M

DISTRICT OF KOOLAUPOKO

ISLAND OF OAHU

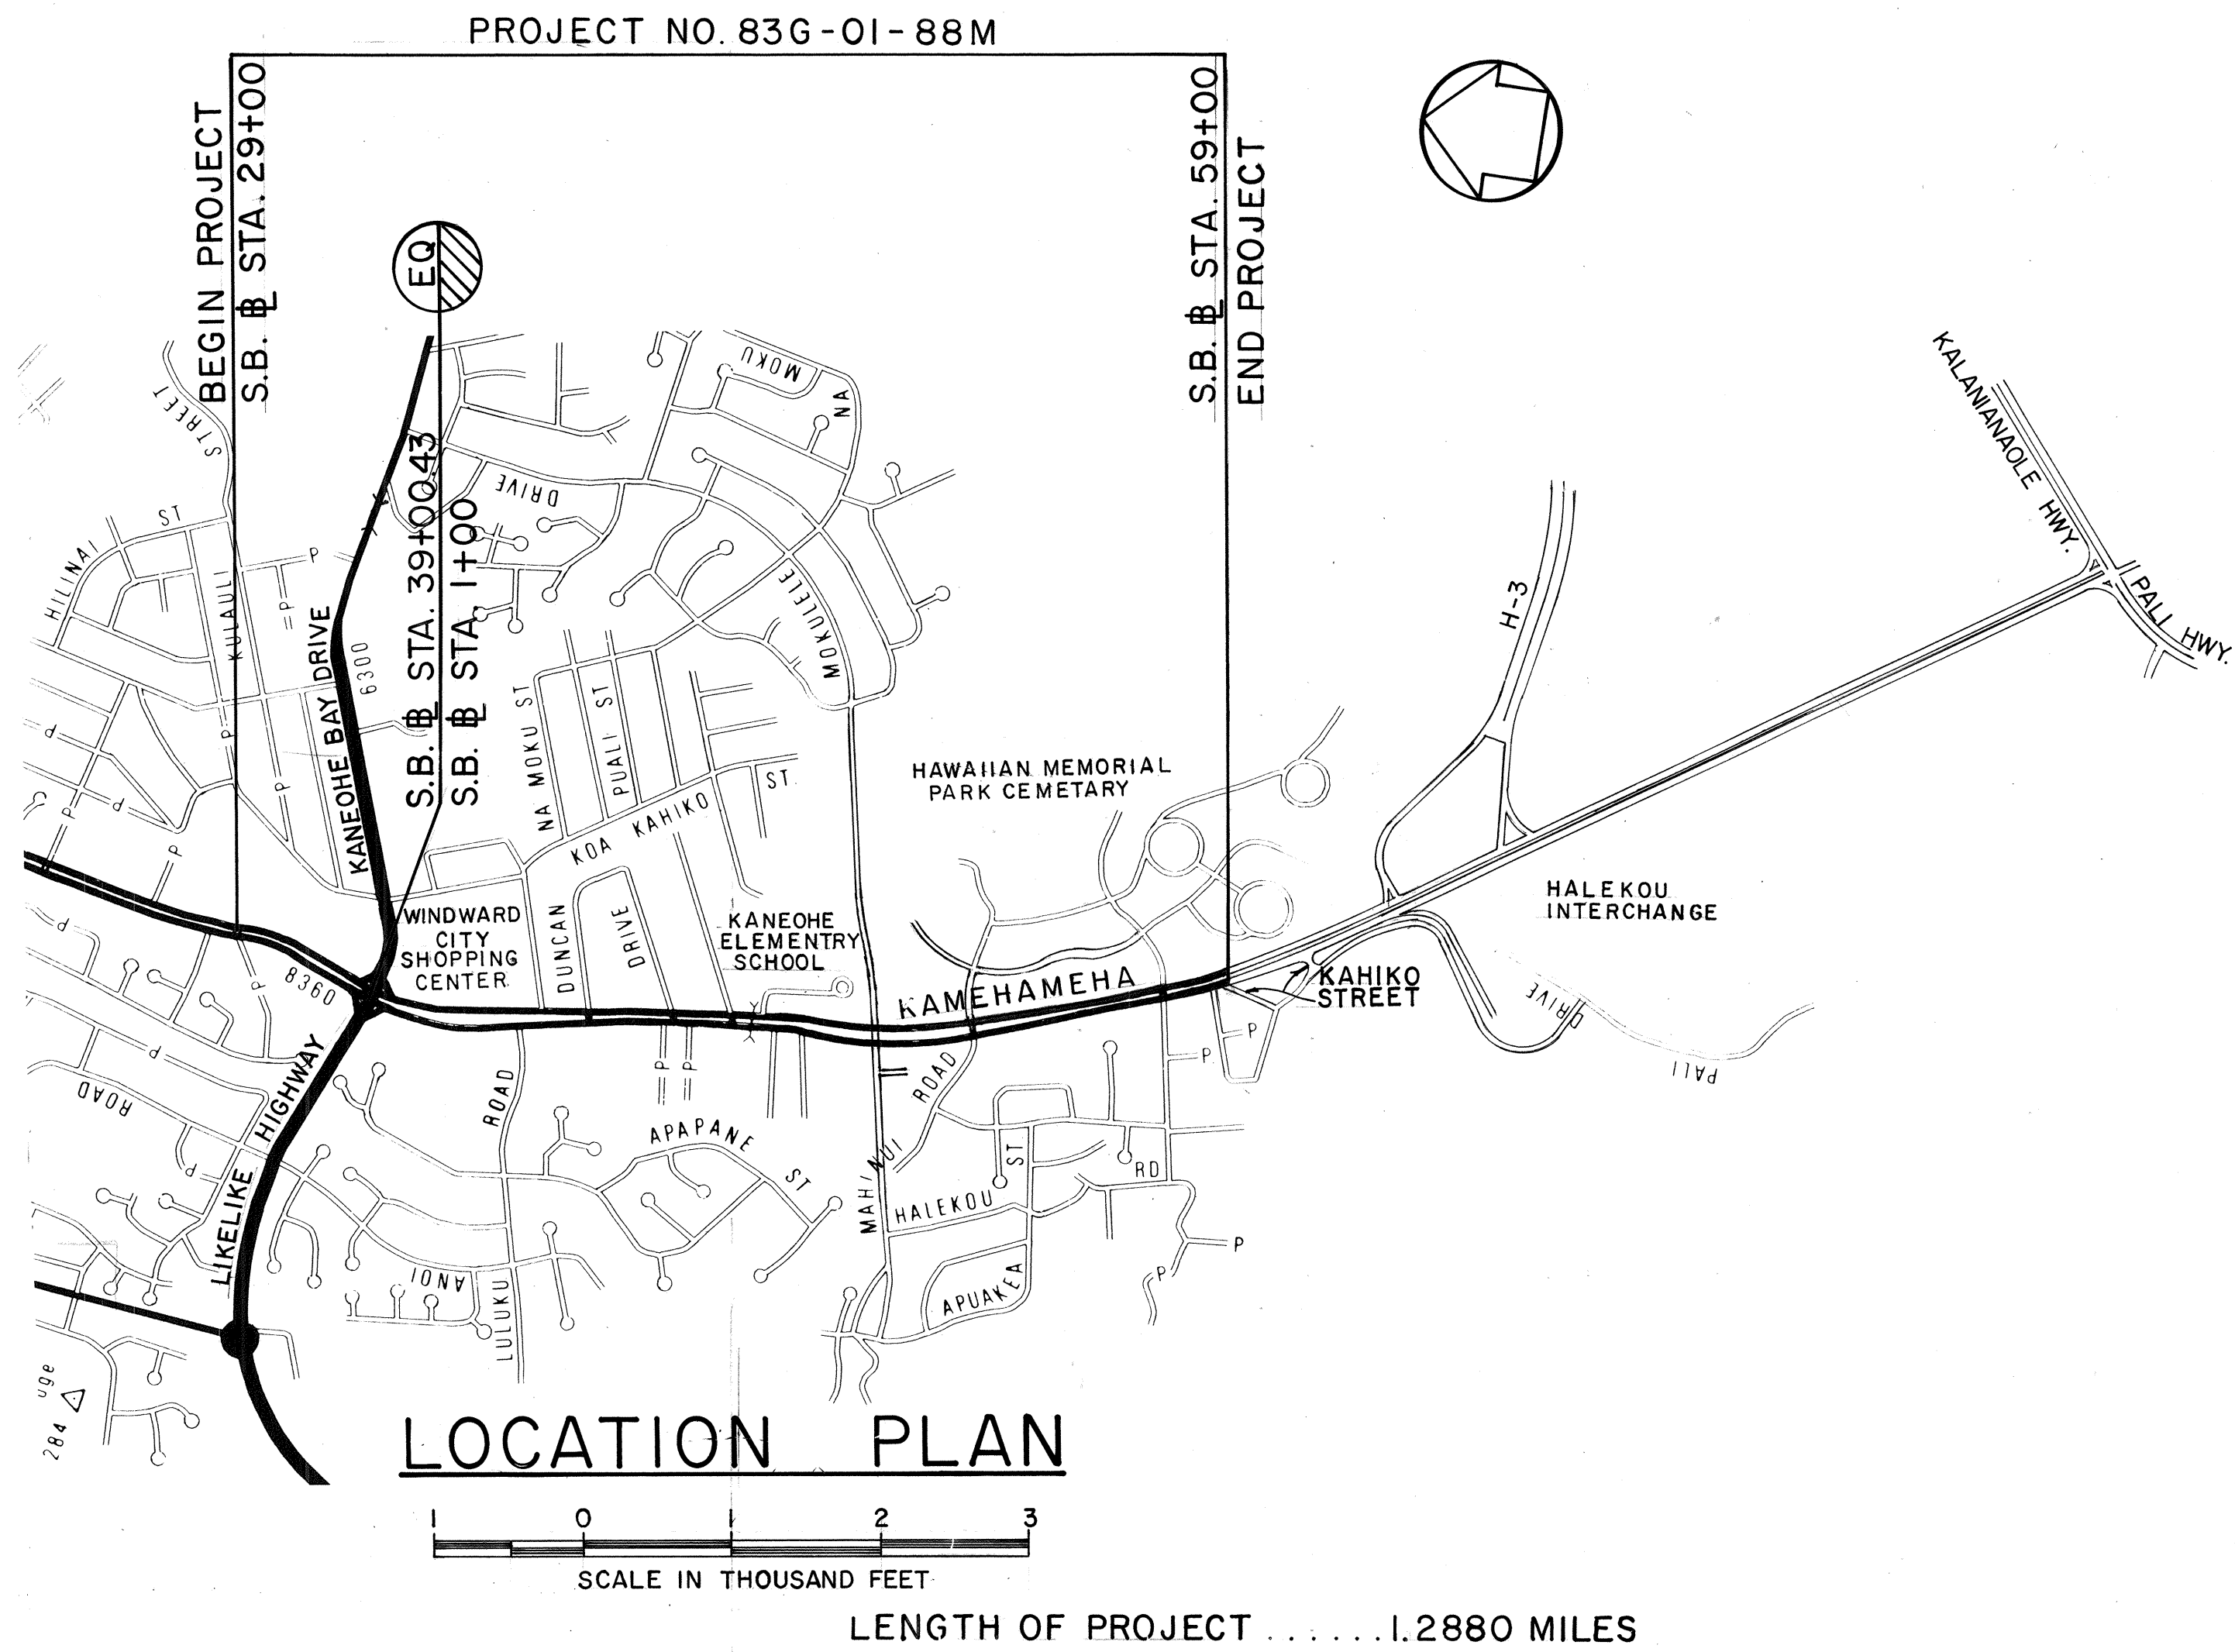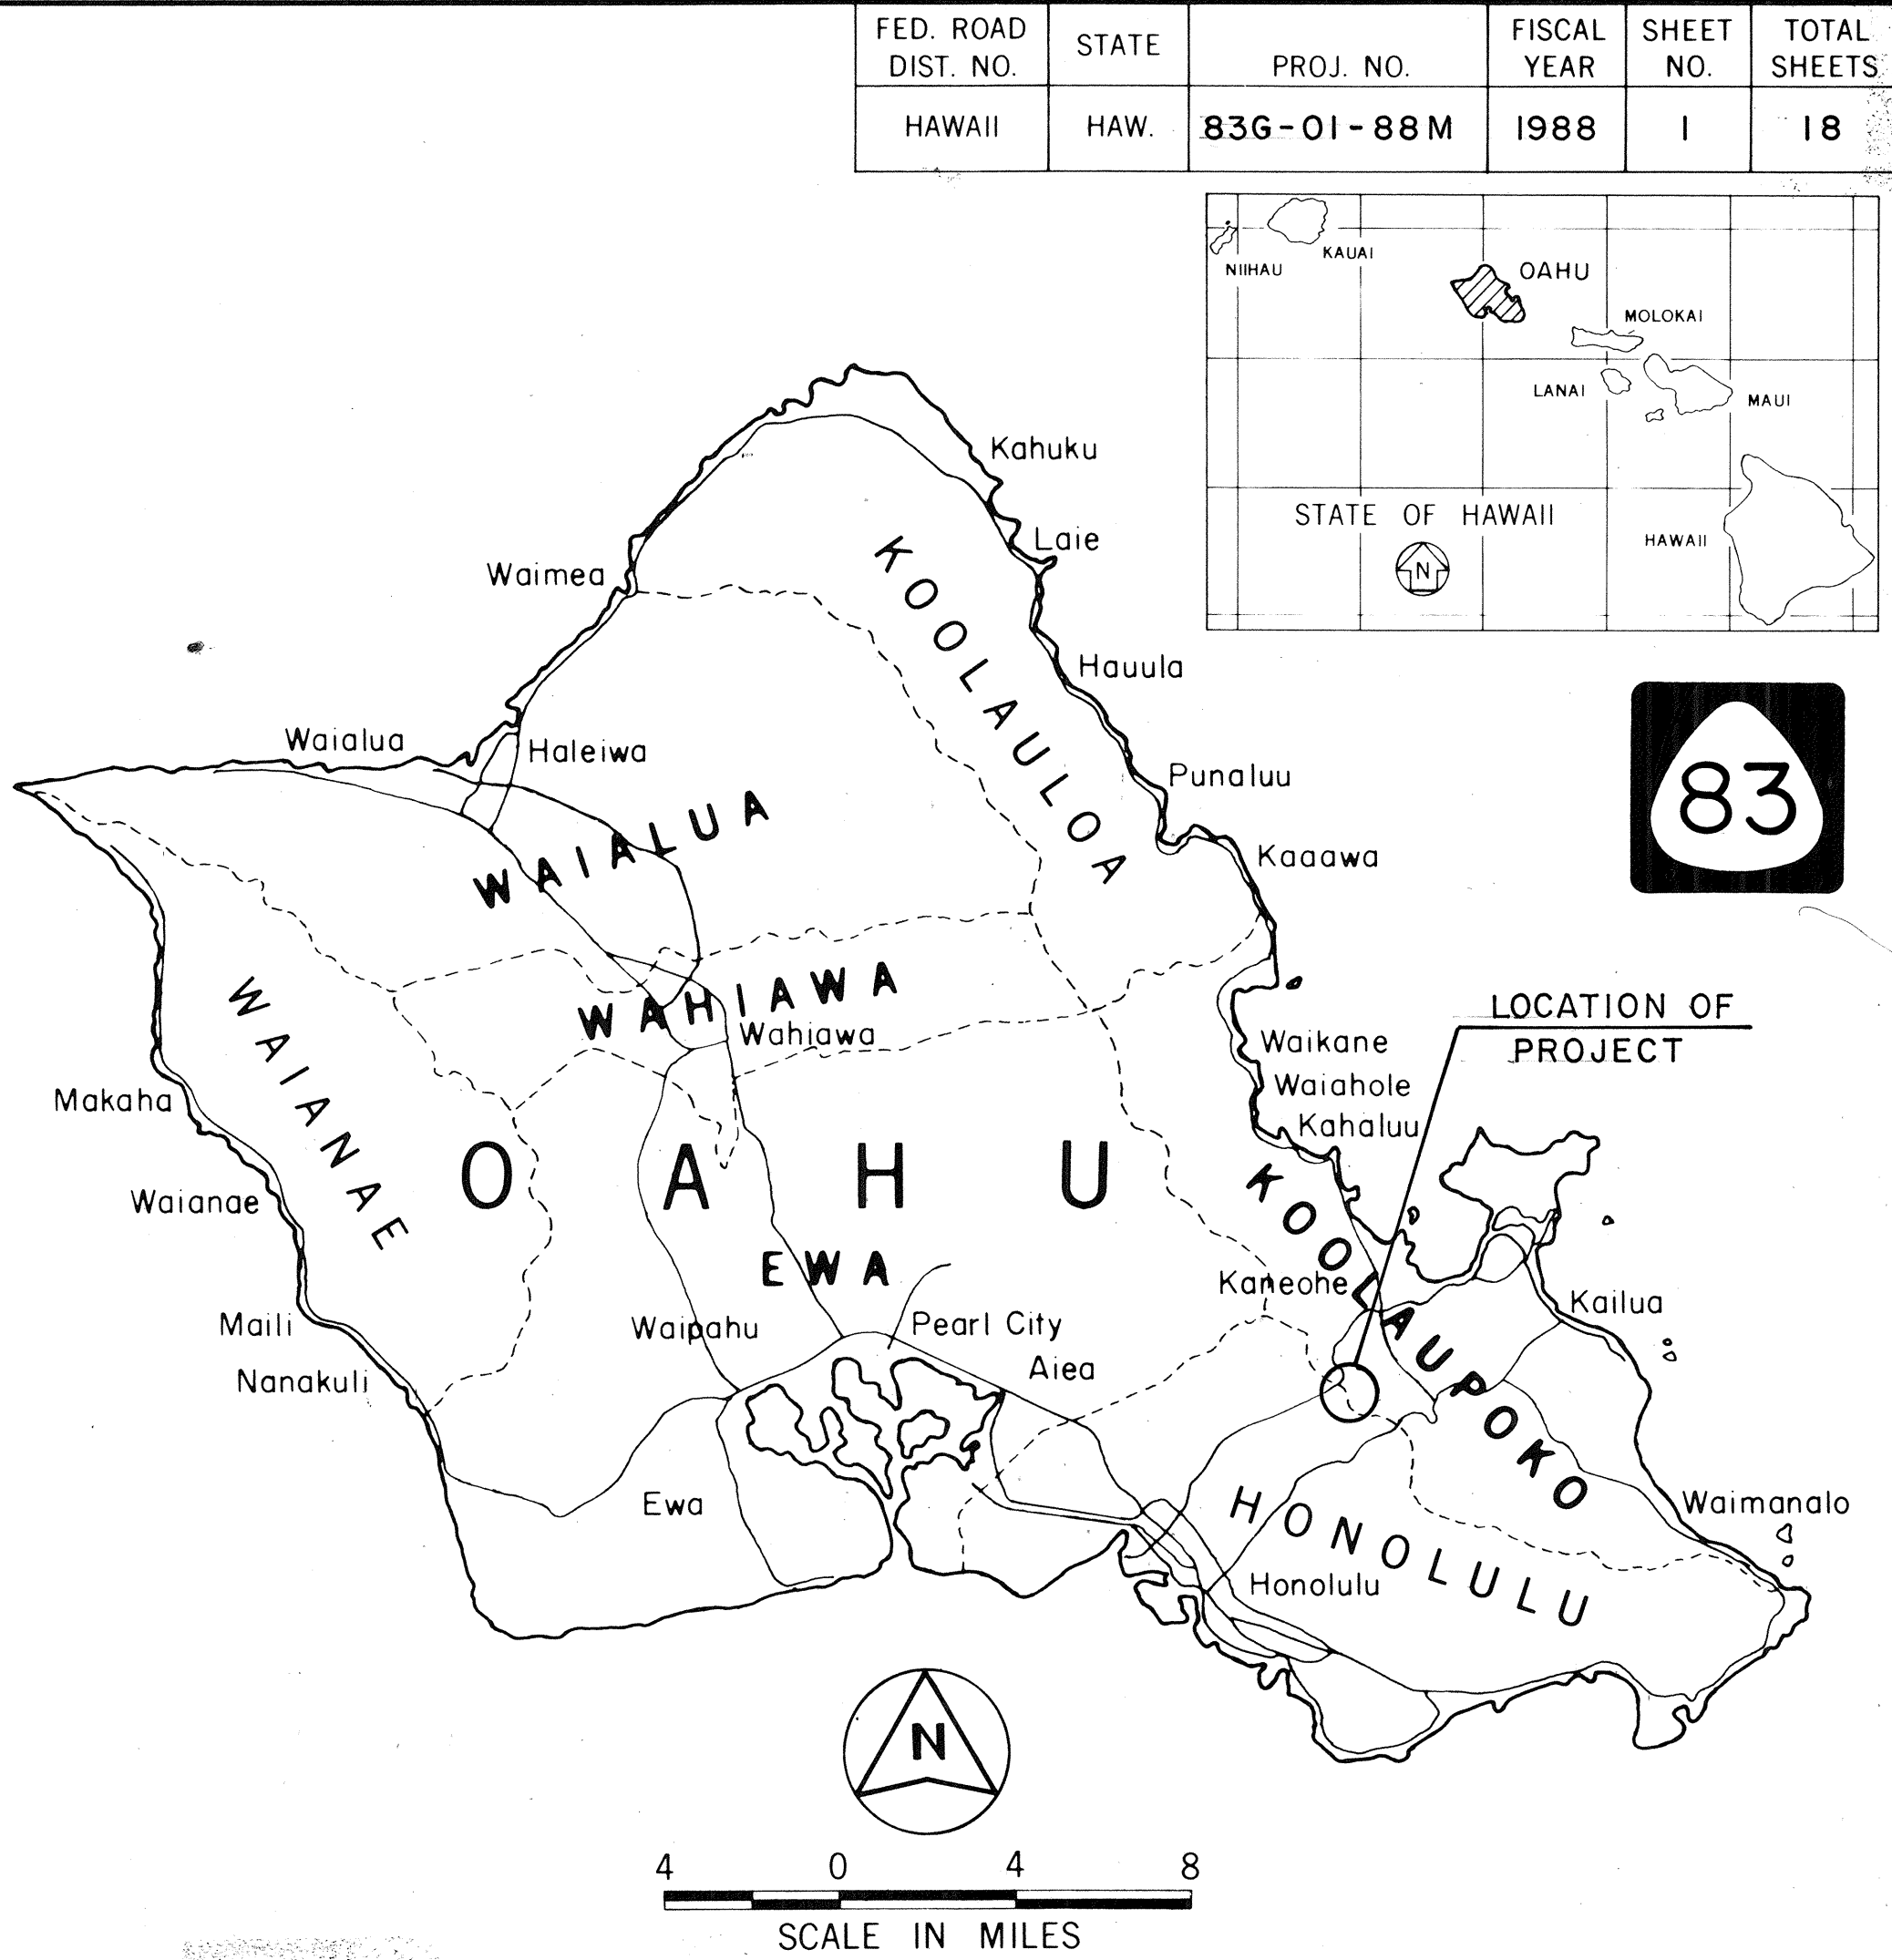

CHANGES MADE DURING CONSTRUCTION HAVE BEEN INCORPORATED ON THESE PLANS EXCEPT CHANGES IN THE ORIGINAL THEORETICAL QUANTITIES. FOR ACTUAL QUANTITIES, REFER TO PROJECT LEDGER AND/OR COMPUTATION BOOK.

[Signature]
RESIDENT ENGINEER

8/1/97
DATE

DEPARTMENT OF TRANSPORTATION
STATE OF HAWAII

APPROVED:
[Signature] 5/13/88
DIR. OF TRANSPORTATION DATE

DESIGN UNIT A RICHARD TAKAESU 548-4125 MAY 1988
DESIGNED BY P. S. & E. BY PHONE DATE