	INDEX TO DRAWINGS
SHEET NO.	DESCRIPTION
1	TITLE SHEET
2	STANDARD PLANS SUMMARY
3	NOTES & LEGEND
4	TRAFFIC SIGNAL PLAN
5	PAVEMENT MARKING/STRIPING &
	SIGNING PLAN
6	LOOP DETECTOR DETAILS
4	
angan managin manaman angan sa 	
,	
	,

STATE OF HAWAII

DEPARTMENT OF TRANSPORTATION

HIGHWAYS DIVISION HONOLULU, HAWAII


"AS BUILT"


PLANS FOR

KAMEHAMEHA HIGHWAY TRAFFIC SIGNALS AT LULUKU ROAD

PROJECT NO. 83G-01-89

DISTRICT OF KOOLAUPOKO
ISLAND OF OAHU

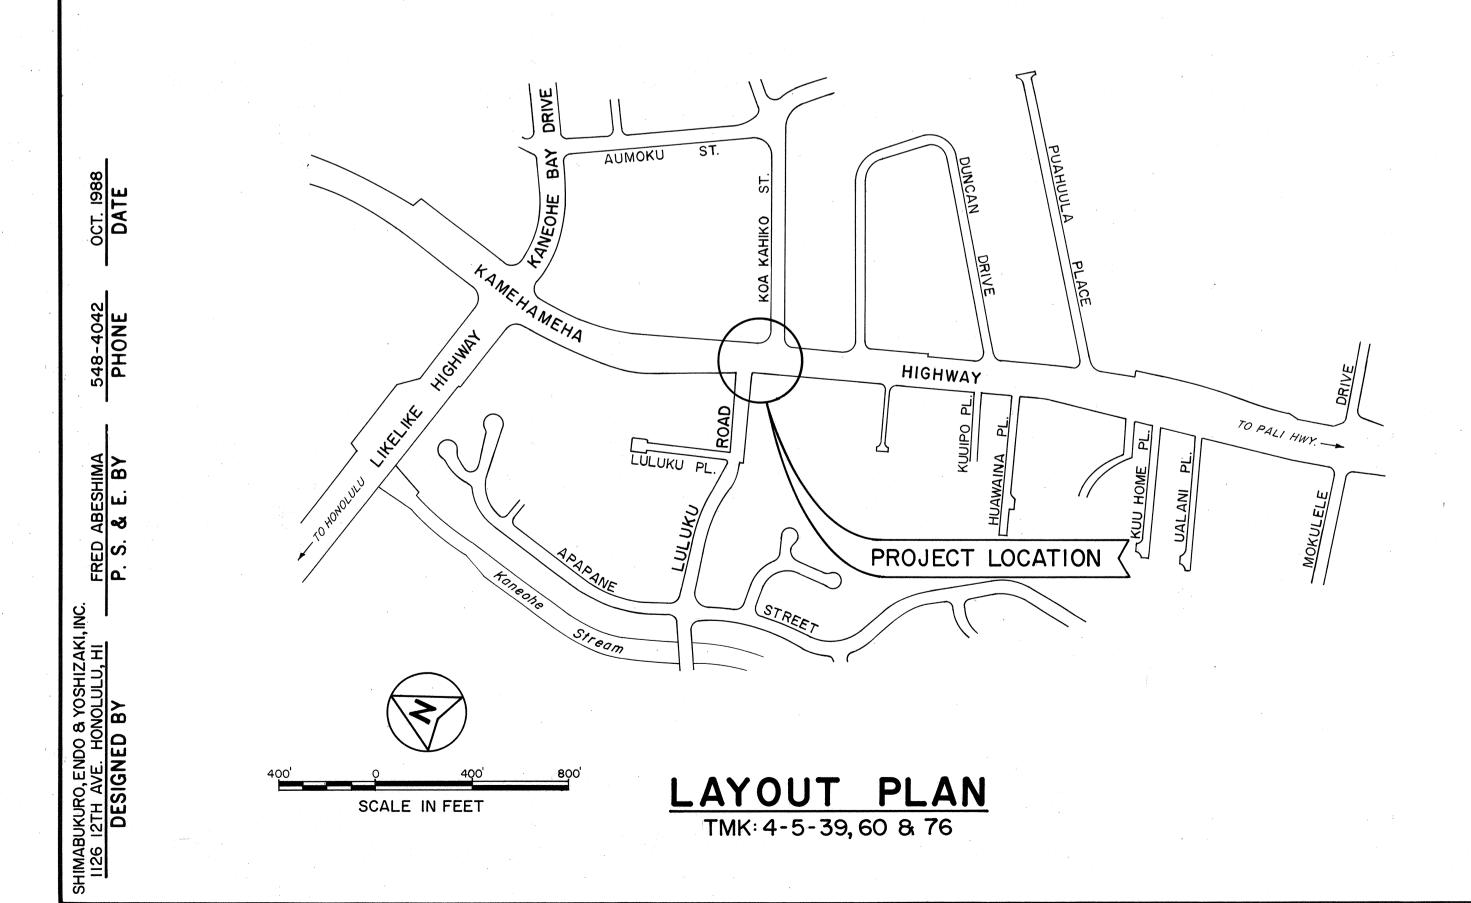

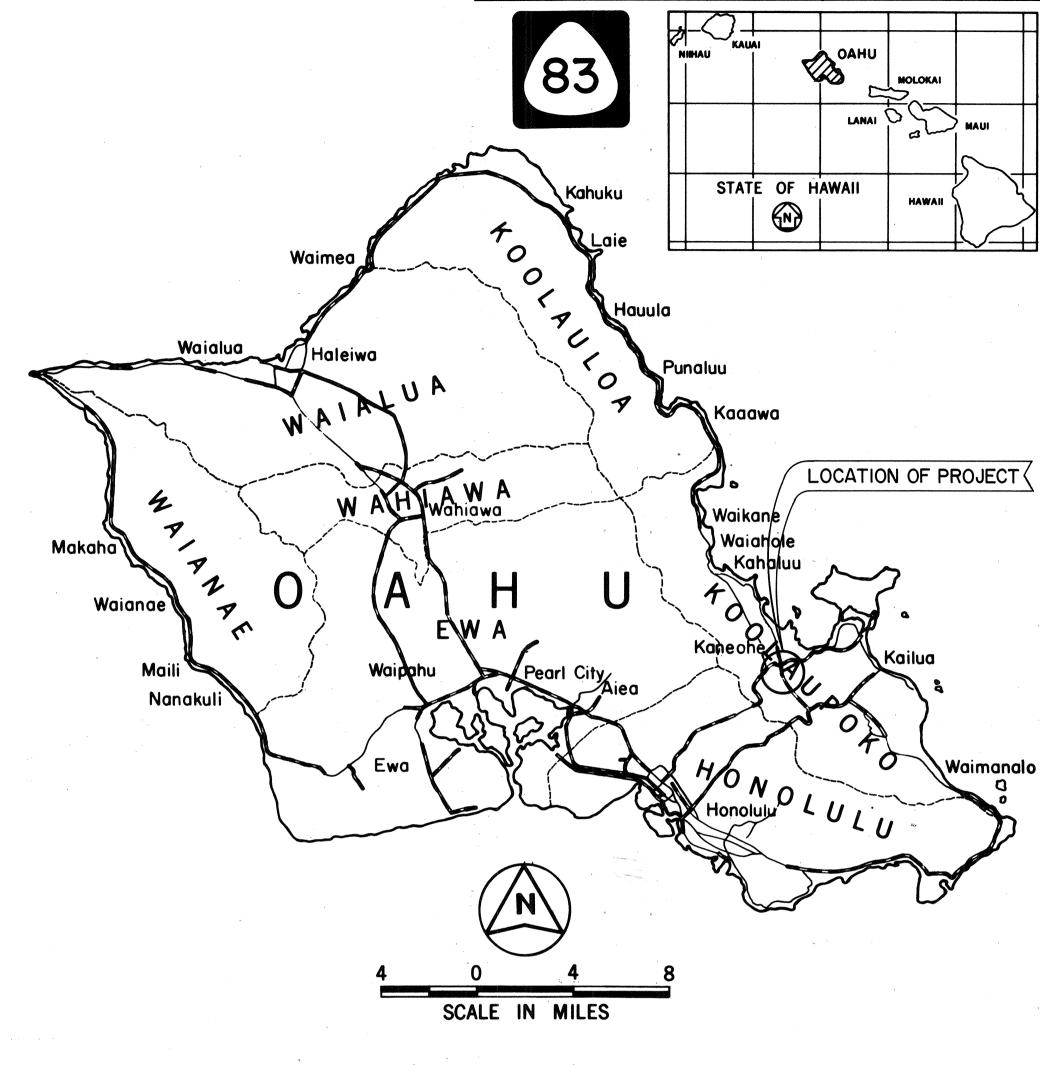

FED. ROAD DIST. NO. FISCAL SHEET YEAR NO.

PROJ. NO.

839-01-89

FEDERAL AID PROJECTS PREVIOUSLY CONSTRUCTED
OR UNDER CONSTRUCTION

CHANGES MADE DURING CONSTRUCTION HAVE BEEN INCORPORATED ON THESE PLANS EXCEPT CHANGES IN THE ORIGINAL THEORETICAL QUANTITIES, FOR ACTUAL QUANTITIES, REFER TO PROJECT LEDGER AND/OR COMPUTATION BOOK.

RESIDENT ENGINEER

DATE

DEPARTMENT OF TRANSPORTATION
STATE OF HAWAII

APPROVED:

| Lange | 10/12/88 |
DIR. OF TRANSPORTATION DATE