



FED. ROAD DIST. NO.	STATE	PROJ. NO.	FISCAL YEAR	SHEET NO.	TOTAL SHEETS
HAWAII	HAW.	83D-01-89M	1989	6	7

NOTE:

1. Spall locations are for illustration purposes only. Actual locations are to be determined by the Engineer in the field.
2. The Contractor is directed to Subsection 695.03(F) Protection of Property, Subsection 104.04 Maintenance of Traffic and Subsection 107.13 Public Convenience and Safety of the Standard Specification and/or Special Provisions.


ESTIMATED QUANTITIES

ITEM NO.	ITEM	UNIT	* QUANTITY
676.1000	Repairs of Spalls	S.F.	1000 S.F.
677.1000	Sealing Cracks	L.F.	50 L.F.

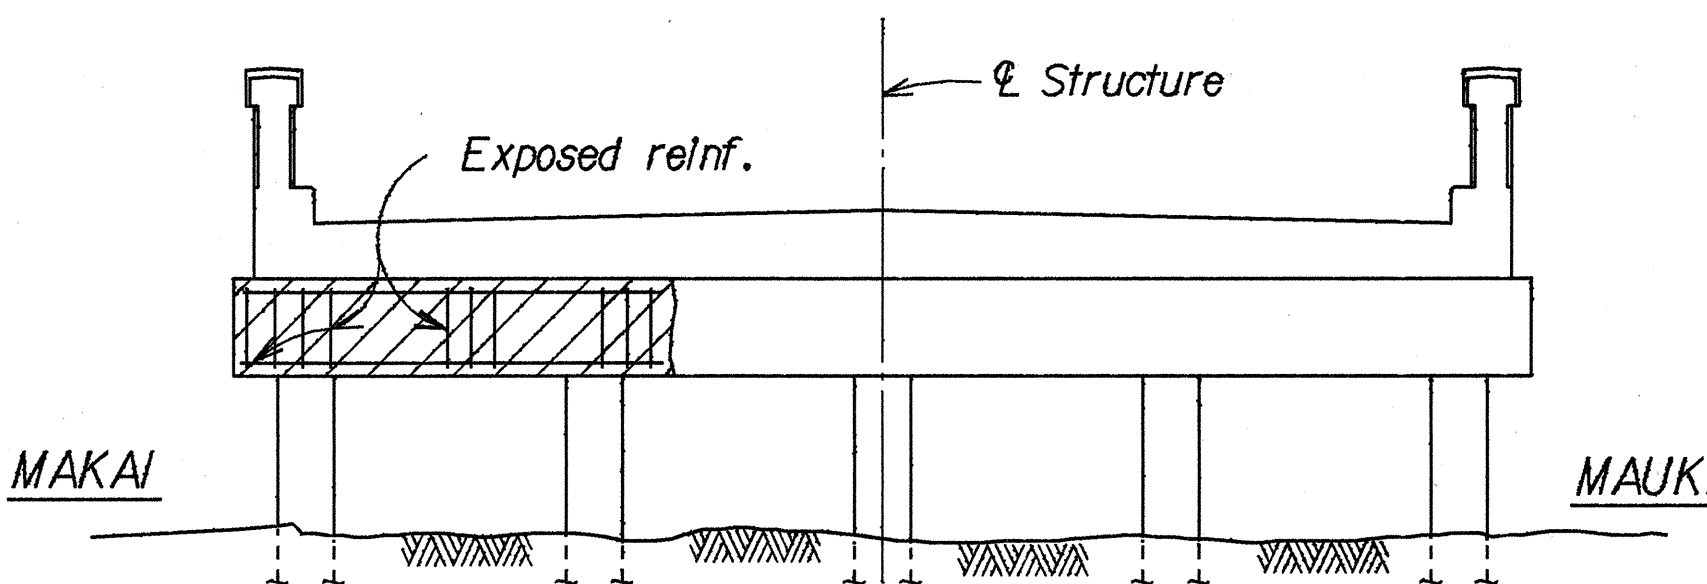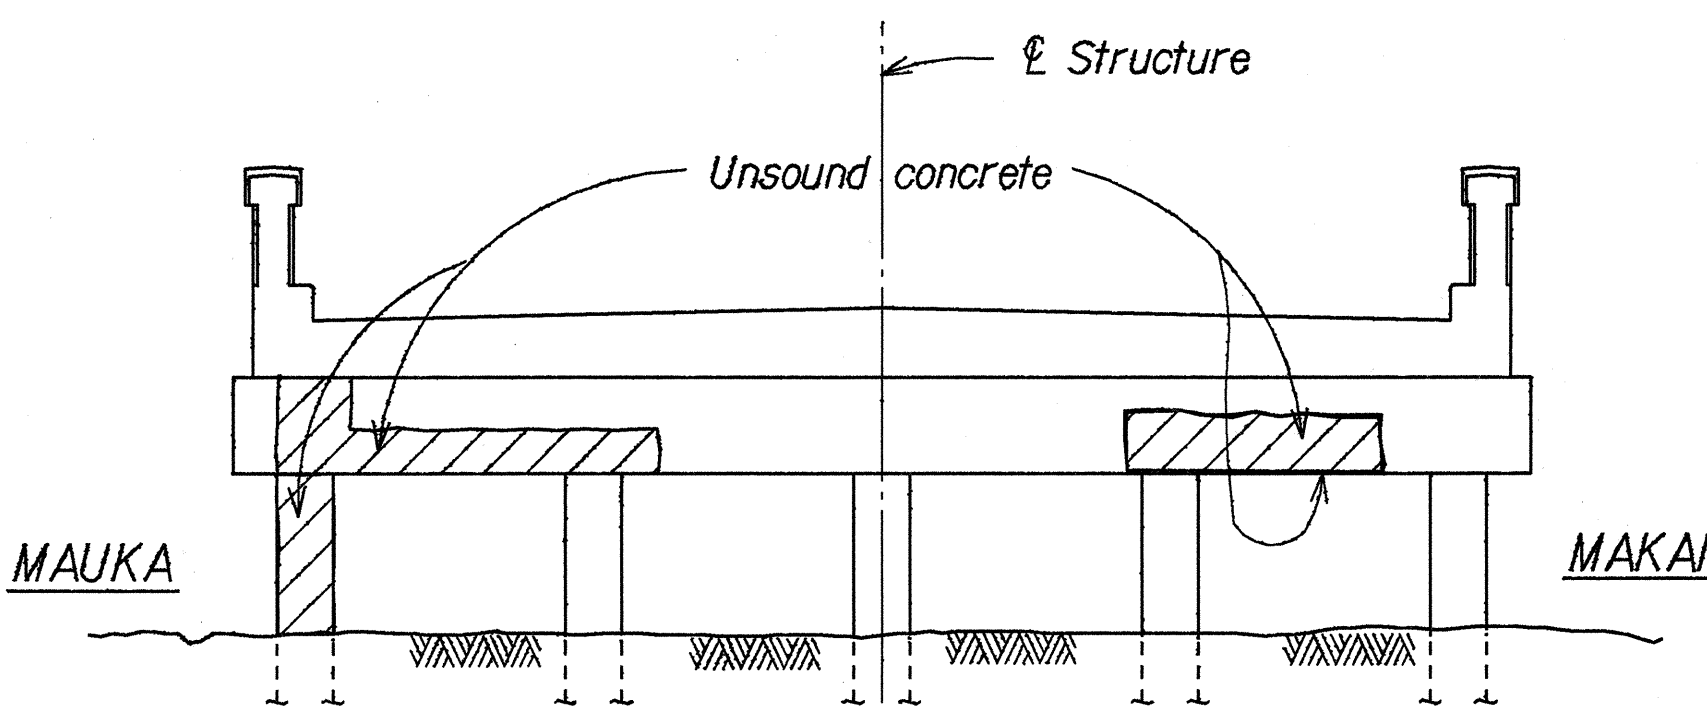

REFLECTED CEILING PLAN

Scale: 1/4"=1'-0"

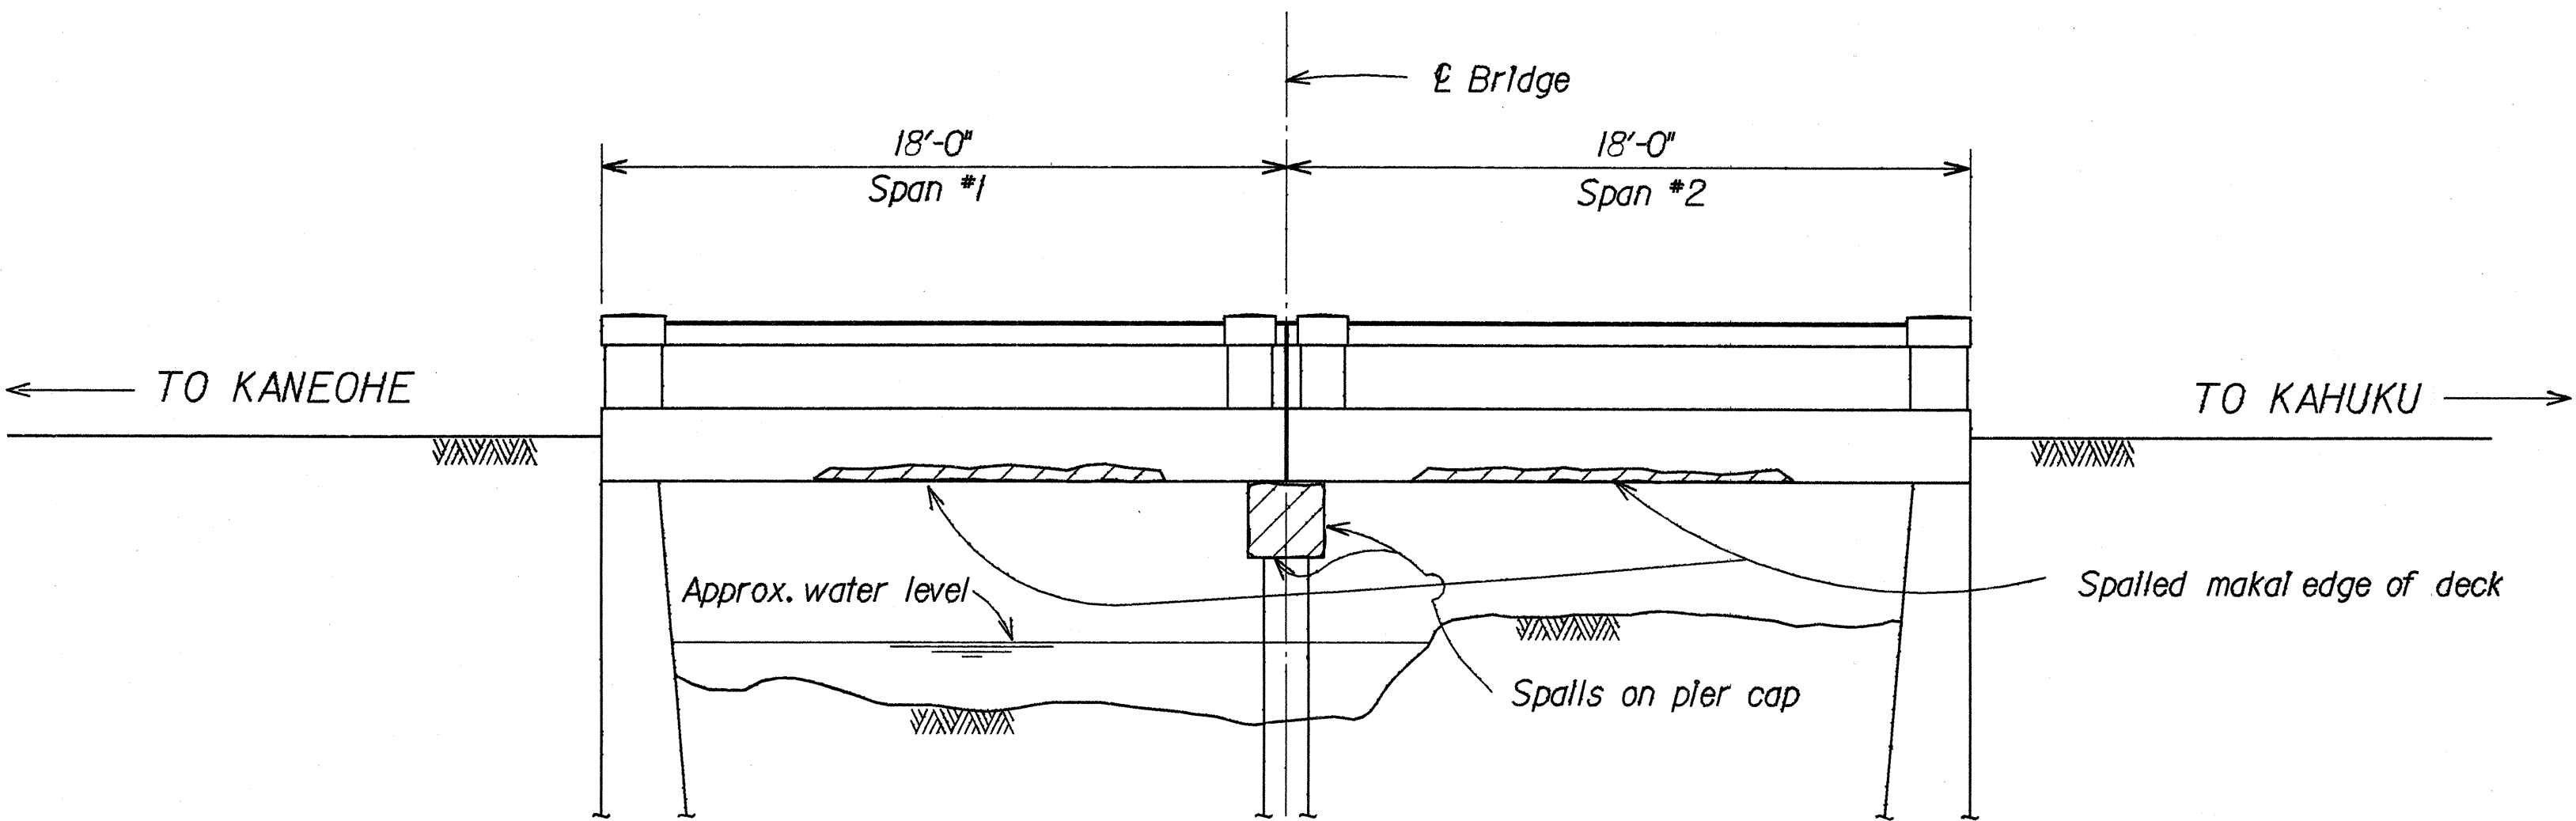

STATE OF HAWAII
DEPARTMENT OF TRANSPORTATION
HIGHWAYS DIVISION

NORTH PUNALUU BRIDGE

REPAIRS AND MODIFICATIONS

KAMEHAMEHA HIGHWAY

Project No. 83D-01-89M

Scale: As Shown

Date: February 1989

SHEET No. P4 OF 5 SHEETS

FED. ROAD DIST. NO.	STATE	PROJ. NO.	FISCAL YEAR	SHEET NO.	TOTAL SHEETS
HAWAII	HAW.	83D-01-89M	1989	C.O.6S-1	12

GENERAL NOTES

DESIGN SPECIFICATIONS -- AASHTO:

AASHTO Standard Specifications for Highway Bridges (13th edition), with subsequent Interim Specifications, 1984, 1985, 1986, 1987 & 1988.

DESIGN LIVE LOAD:

85 psf

ALLOWABLE DESIGN STRESSES:

1. Reinforced concrete: $f_c = 0.40 f'_c$
2. Reinforcing steel: $f_s = 20,000 \text{ psi}$ for Grade 40;
3. Prestressed concrete: see Sht. No. S4

MATERIALS:

1. Reinforced concrete: Class A
2. Reinforcing steel: ASTM A615, Grade 40
3. Prestressed concrete: see Sht. No. S4
4. Structural steel: see Sht. No. S3

CONSTRUCTION METHODS:

1. Refer to Standard Specifications for Road and Bridge Construction, 1985 Edition and Special Provisions.

REFERENCE:

1. Refer to Standard Plans for additional details and notes not covered by details and typical drawings.

GENERAL NOTES:

1. Items noted Incidental will not be paid for separately.
2. All preformed elastomeric bearing pads and premolded joint filler shall be Incidental to concrete.
3. The Contractor shall verify all dimensions in the field before commencing work.
4. The Contractor shall verify the location of all existing utility lines near the structures, and notify their respective owners before commencing work.
5. The Contractor shall be solely responsible for the protection of the adjacent property, utilities, existing and new structures from damage due to construction and shall repair any damage at his own expense to the satisfaction of the Engineer.
6. Dress approach to walkway as required and as directed by the Engineer.

ESTIMATED QUANTITIES

ITEM NO.	ITEM	UNIT	QUANTITY
206.5500	Structure Excavation	C.Y.	43
206.7000	Structure Backfill	C.Y.	21
503.1065	Concrete in Abutments	C.Y.	2
504.7500	Prestressed Concrete Plank	S.F.	171
507.4600	1'-5" high Galvanized Iron Pipe Rail	L.F.	46
507.4700	3'-6" high Galvanized Iron Pipe Rail	L.F.	109
507.7600	New Concrete End Post	Ea.	2
507.9000	3"ø Drilled Holes for Rail	Ea.	10
508.0100	C.R.M.	C.Y.	19
608.1100	Reinforced Concrete Sidewalk	S.Y.	34

8-23-89 Change Order for construction of footwalk at Kaunala Bridge





DATE REVISION

STATE OF HAWAII
DEPARTMENT OF TRANSPORTATION
HIGHWAYS DIVISION

LAYOUT PLAN, FOOTWALK PLAN & SECTION,
GENERAL NOTES AND ESTIMATED QUANTITIES

KAMEHAMEHA HIGHWAY
BRIDGE REPAIR AND MODIFICATION
Project No. 83D-01-89M
Scale: As Noted (KAUNALA STREAM BRIDGE) Date: April 11, 1989


SHEET No. 1 OF 5 SHEETS

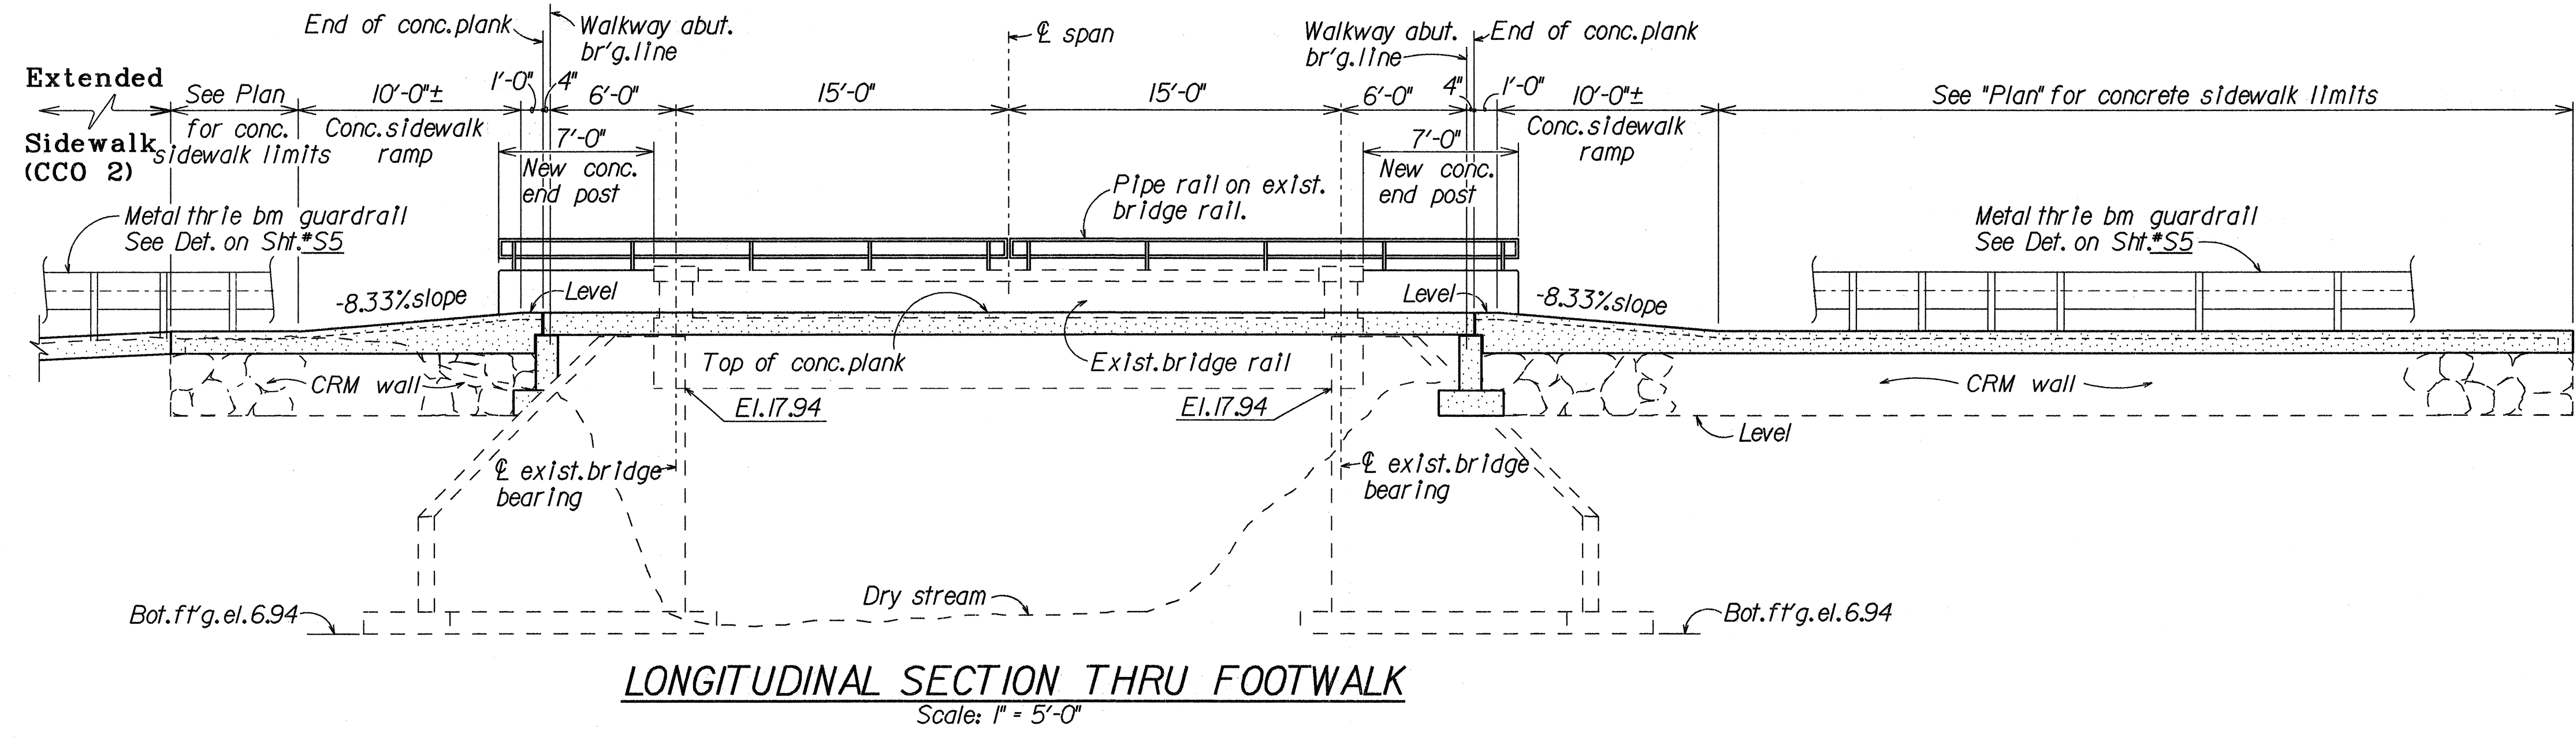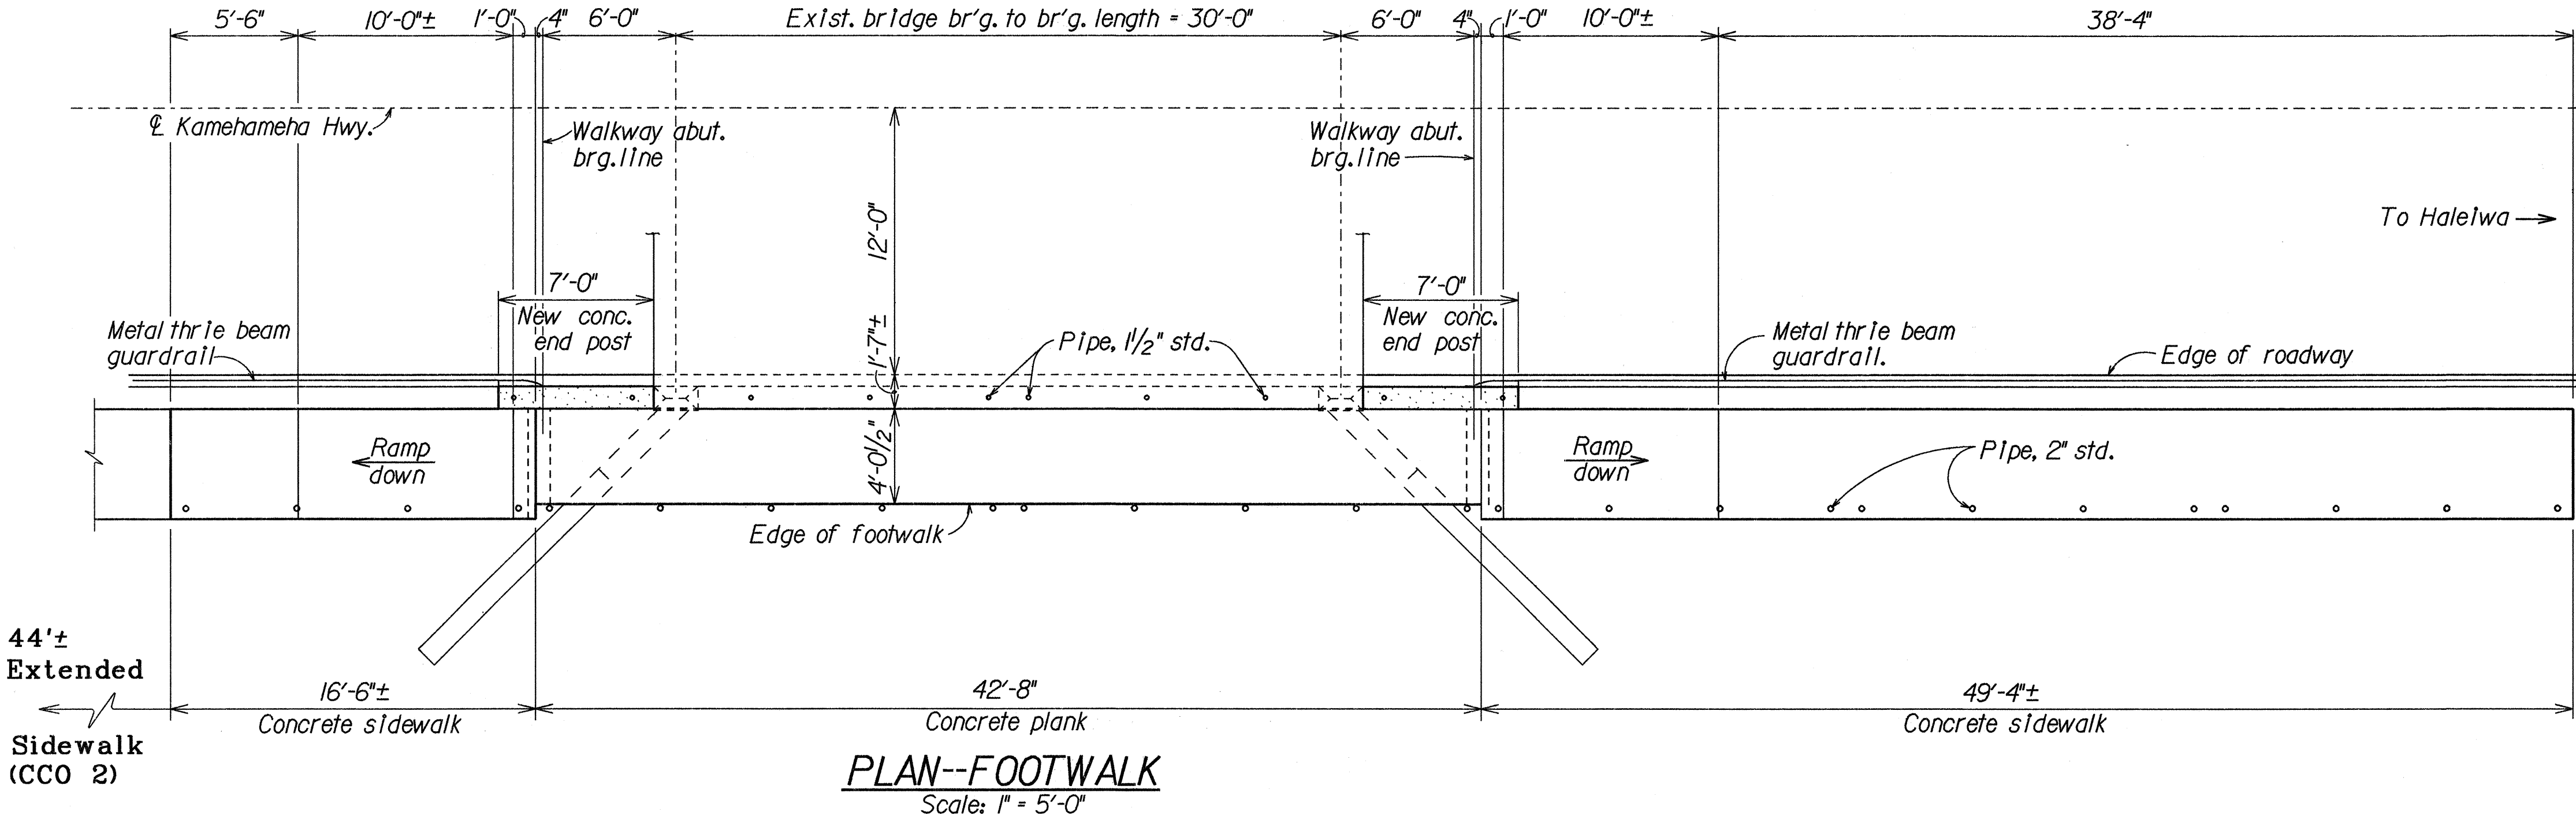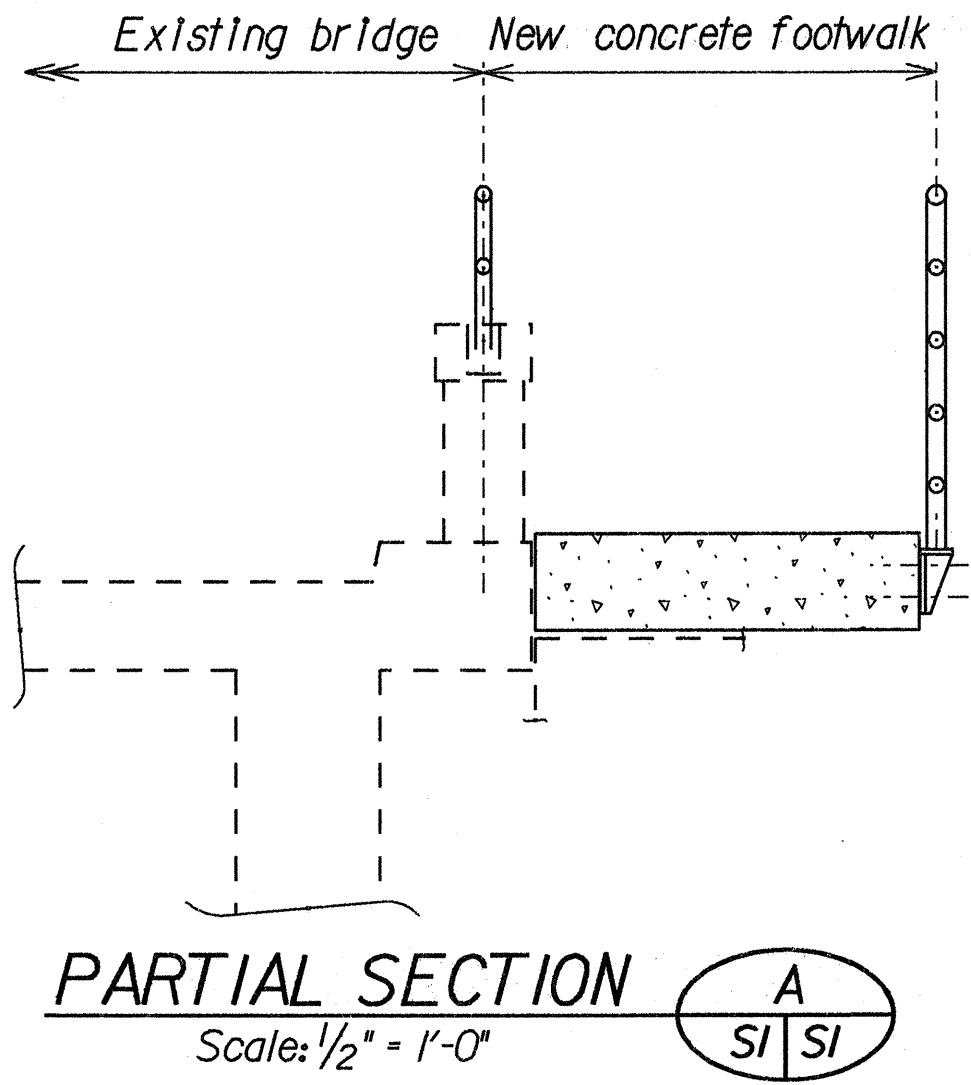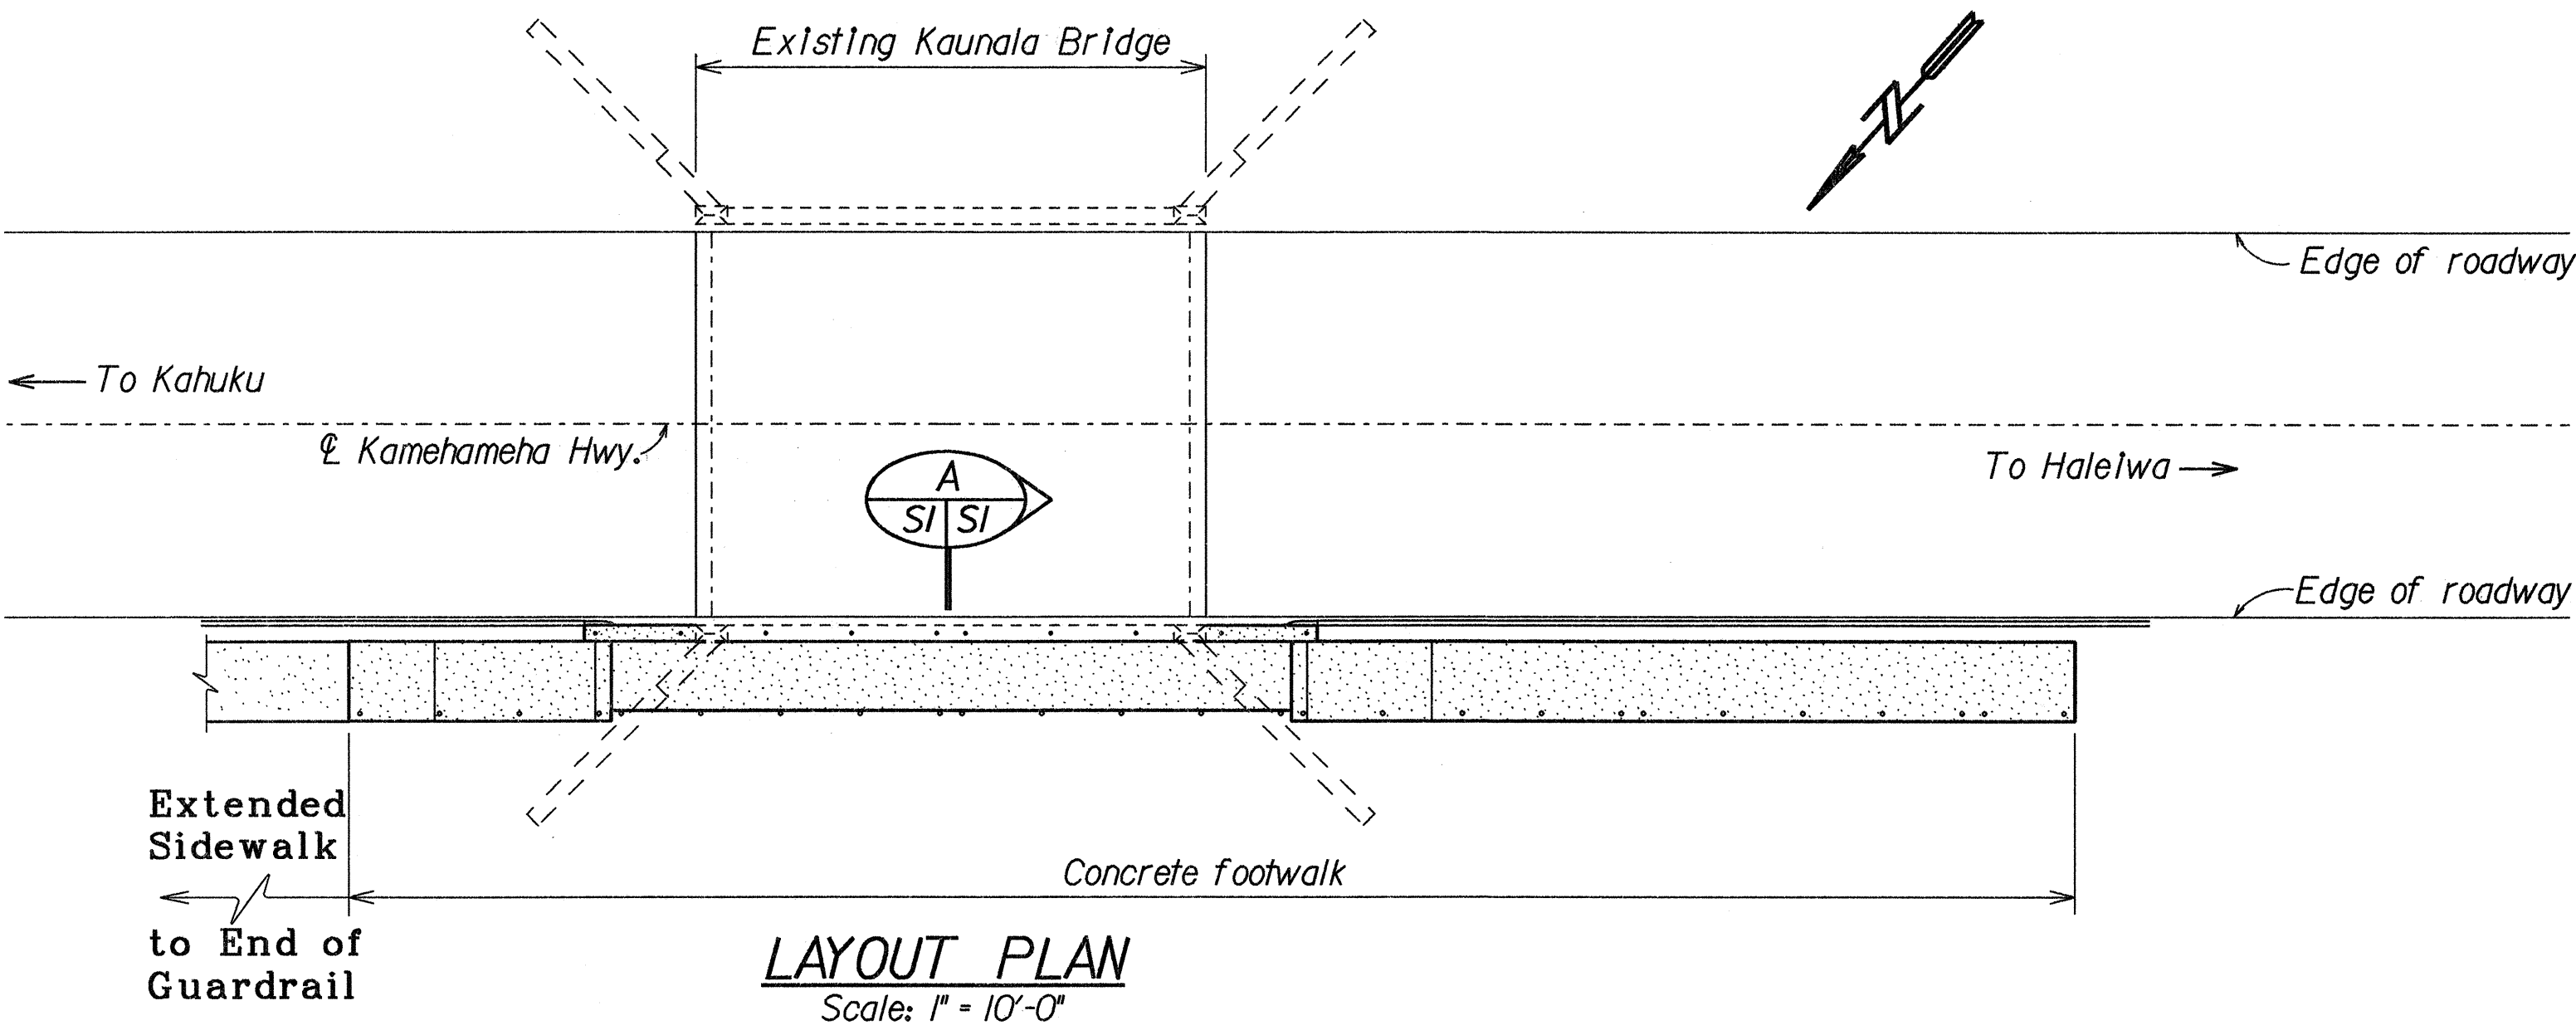


SURVEY PLOTTED BY	DATE
DRAWN BY	APR 1989
TRACED BY	APR 1989
NOTED BY	APR 1989
QUANTITIES BY	APR 1989
CHECKED BY	APR 1989
ORIGINAL PLAN	
NOTE BOOK	
NO. KAUNALA	

C.O. 6S-1


FED. ROAD DIST. NO.	STATE	PROJ. NO.	FISCAL YEAR	SHEET NO.	TOTAL SHEETS
HAWAII	HAW.	83D-01-89M	1989	C.O.6S-2	12

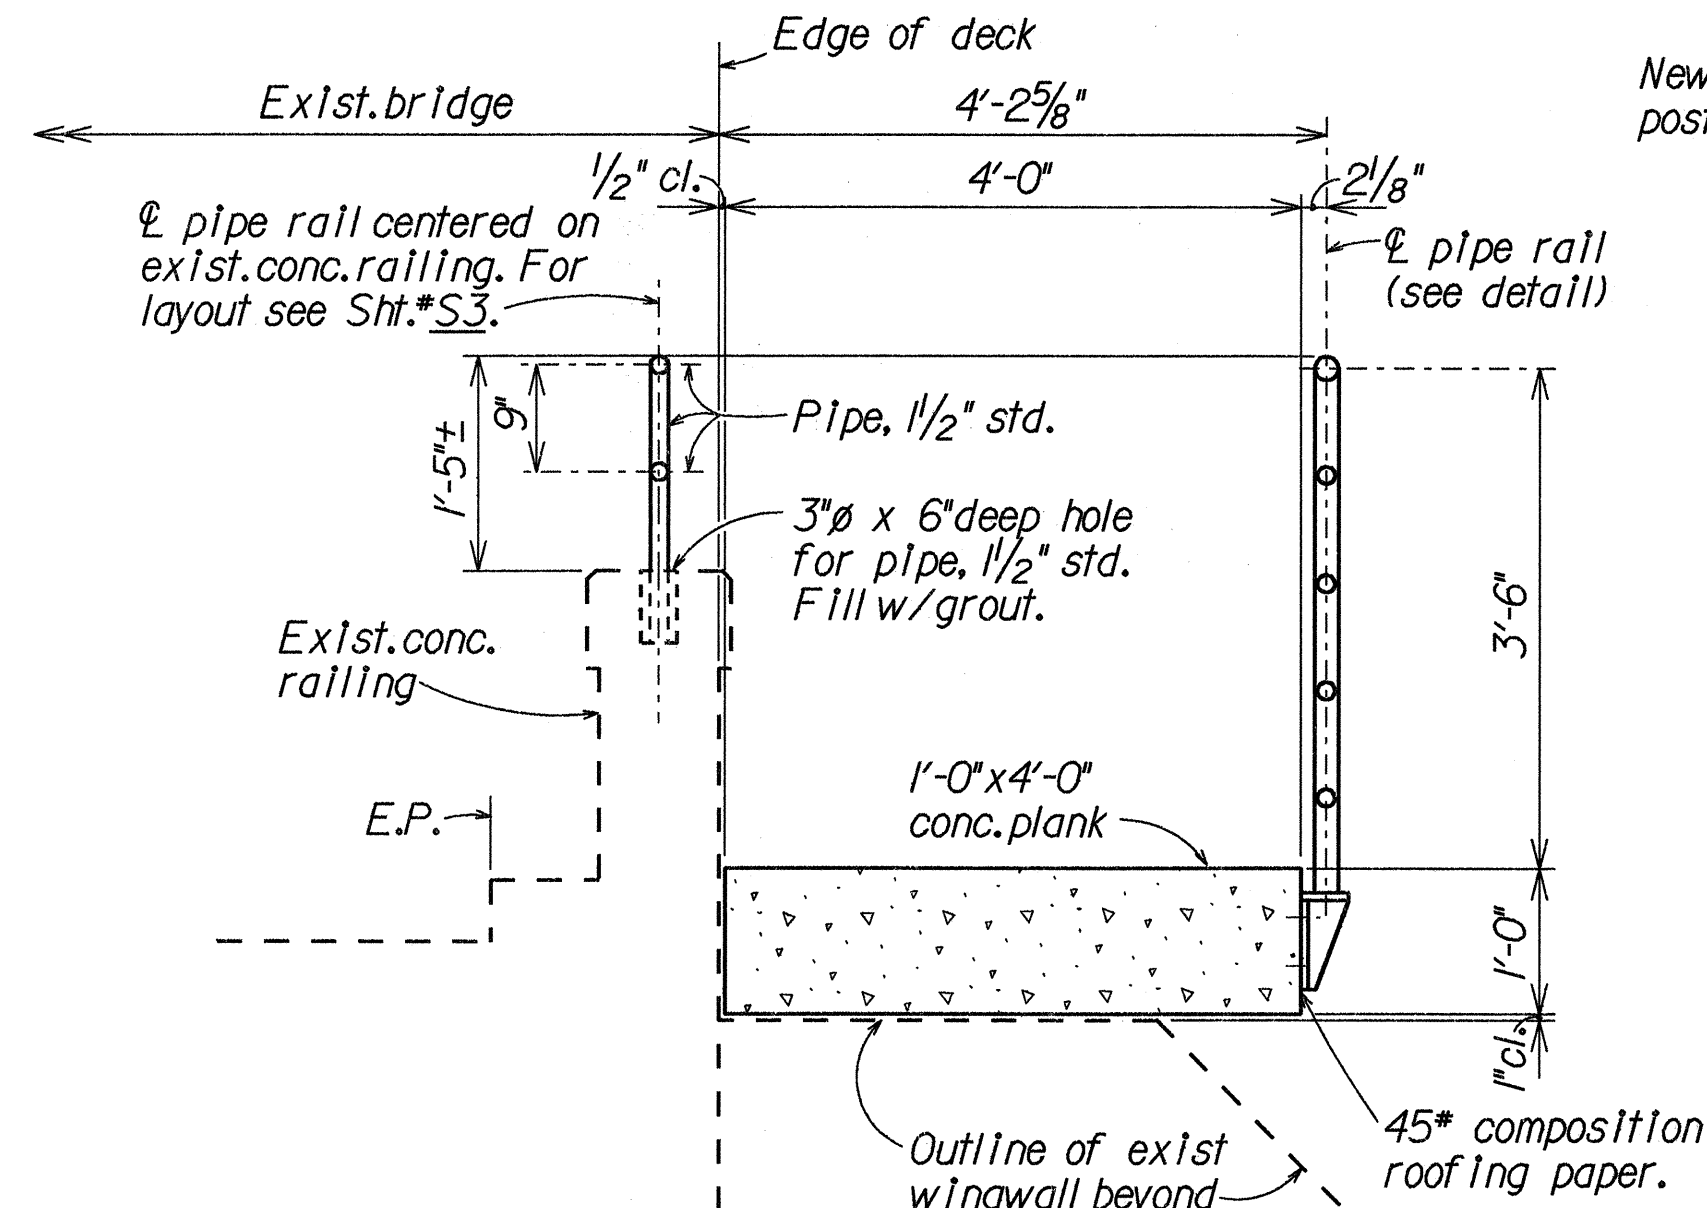


SECTION @ EXISTING BRIDGE
Scale: $\frac{3}{4}'' = 1'-0''$

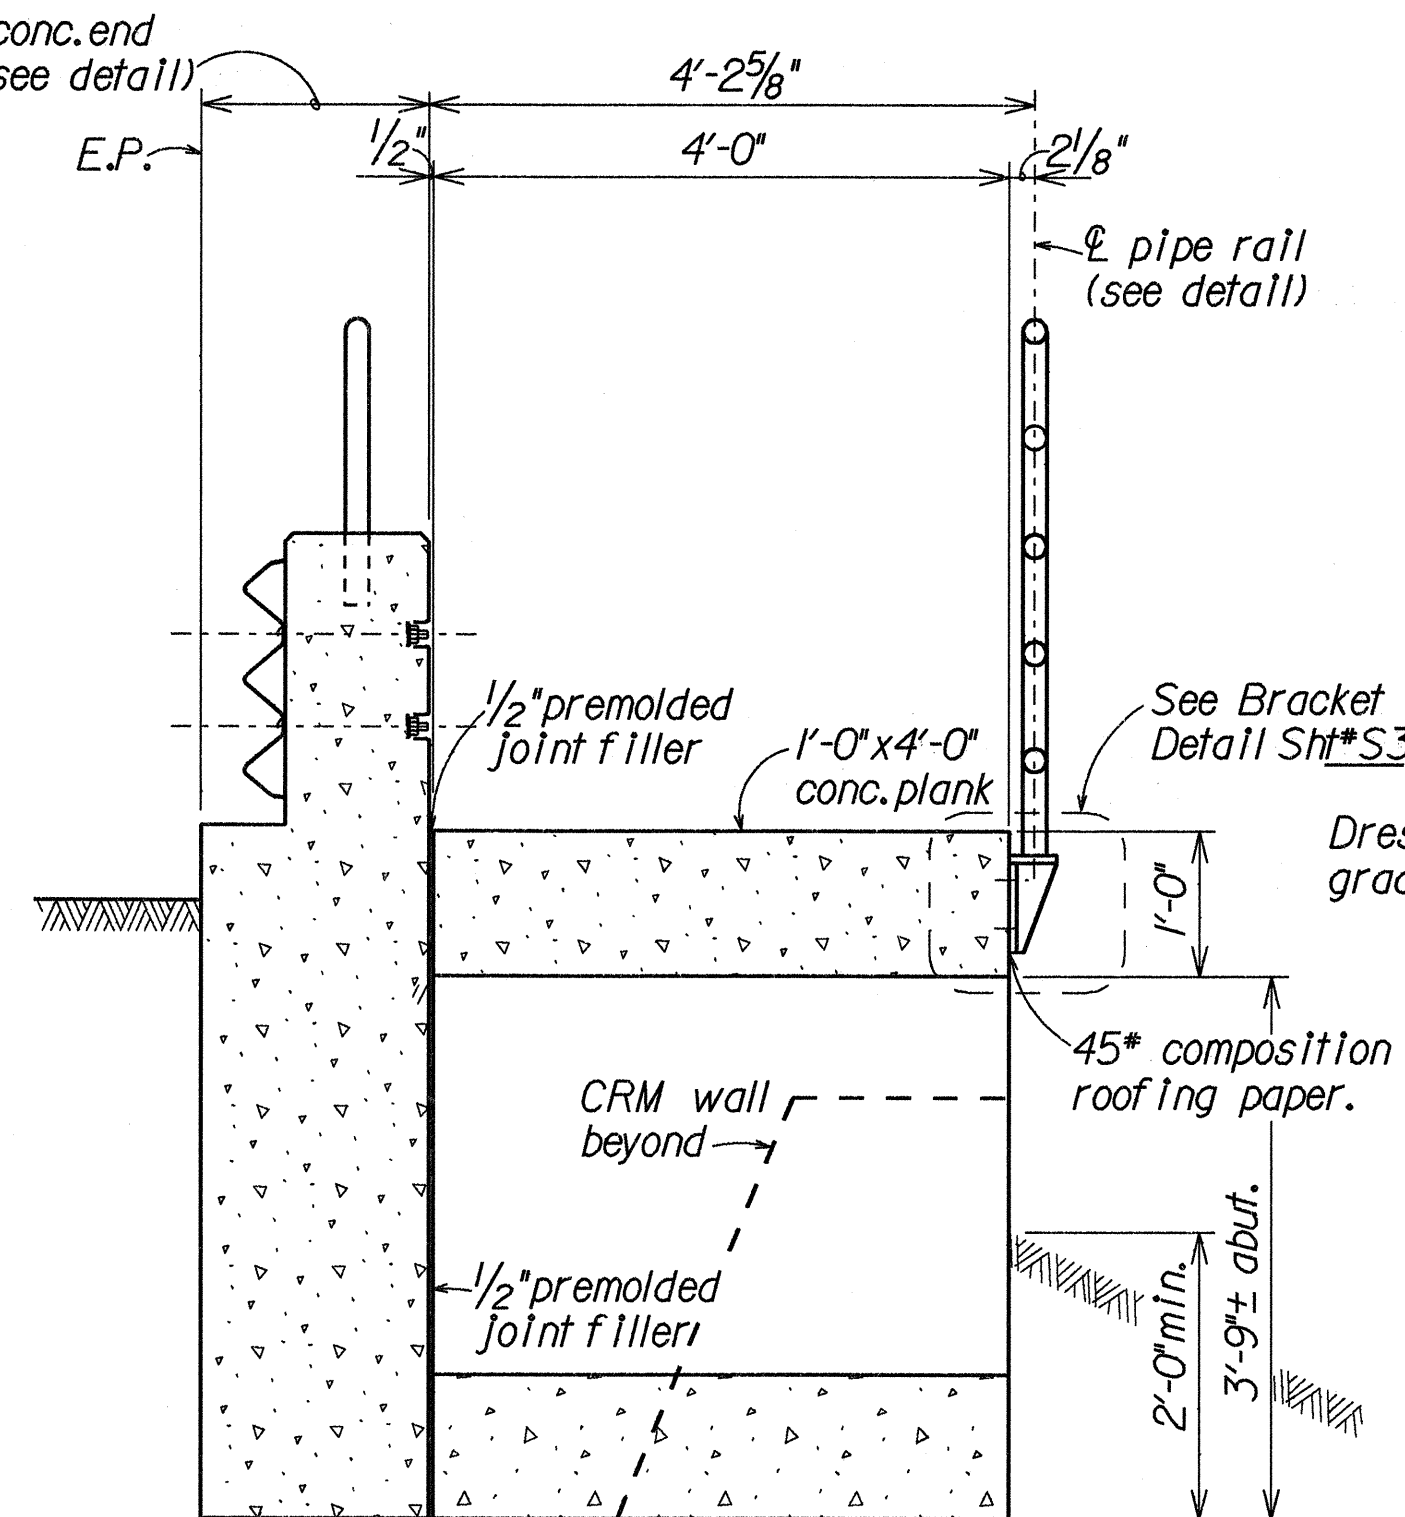


SECTION @ WALKWAY ABUTMENT
Scale: $\frac{3}{4}'' = 1'-0''$

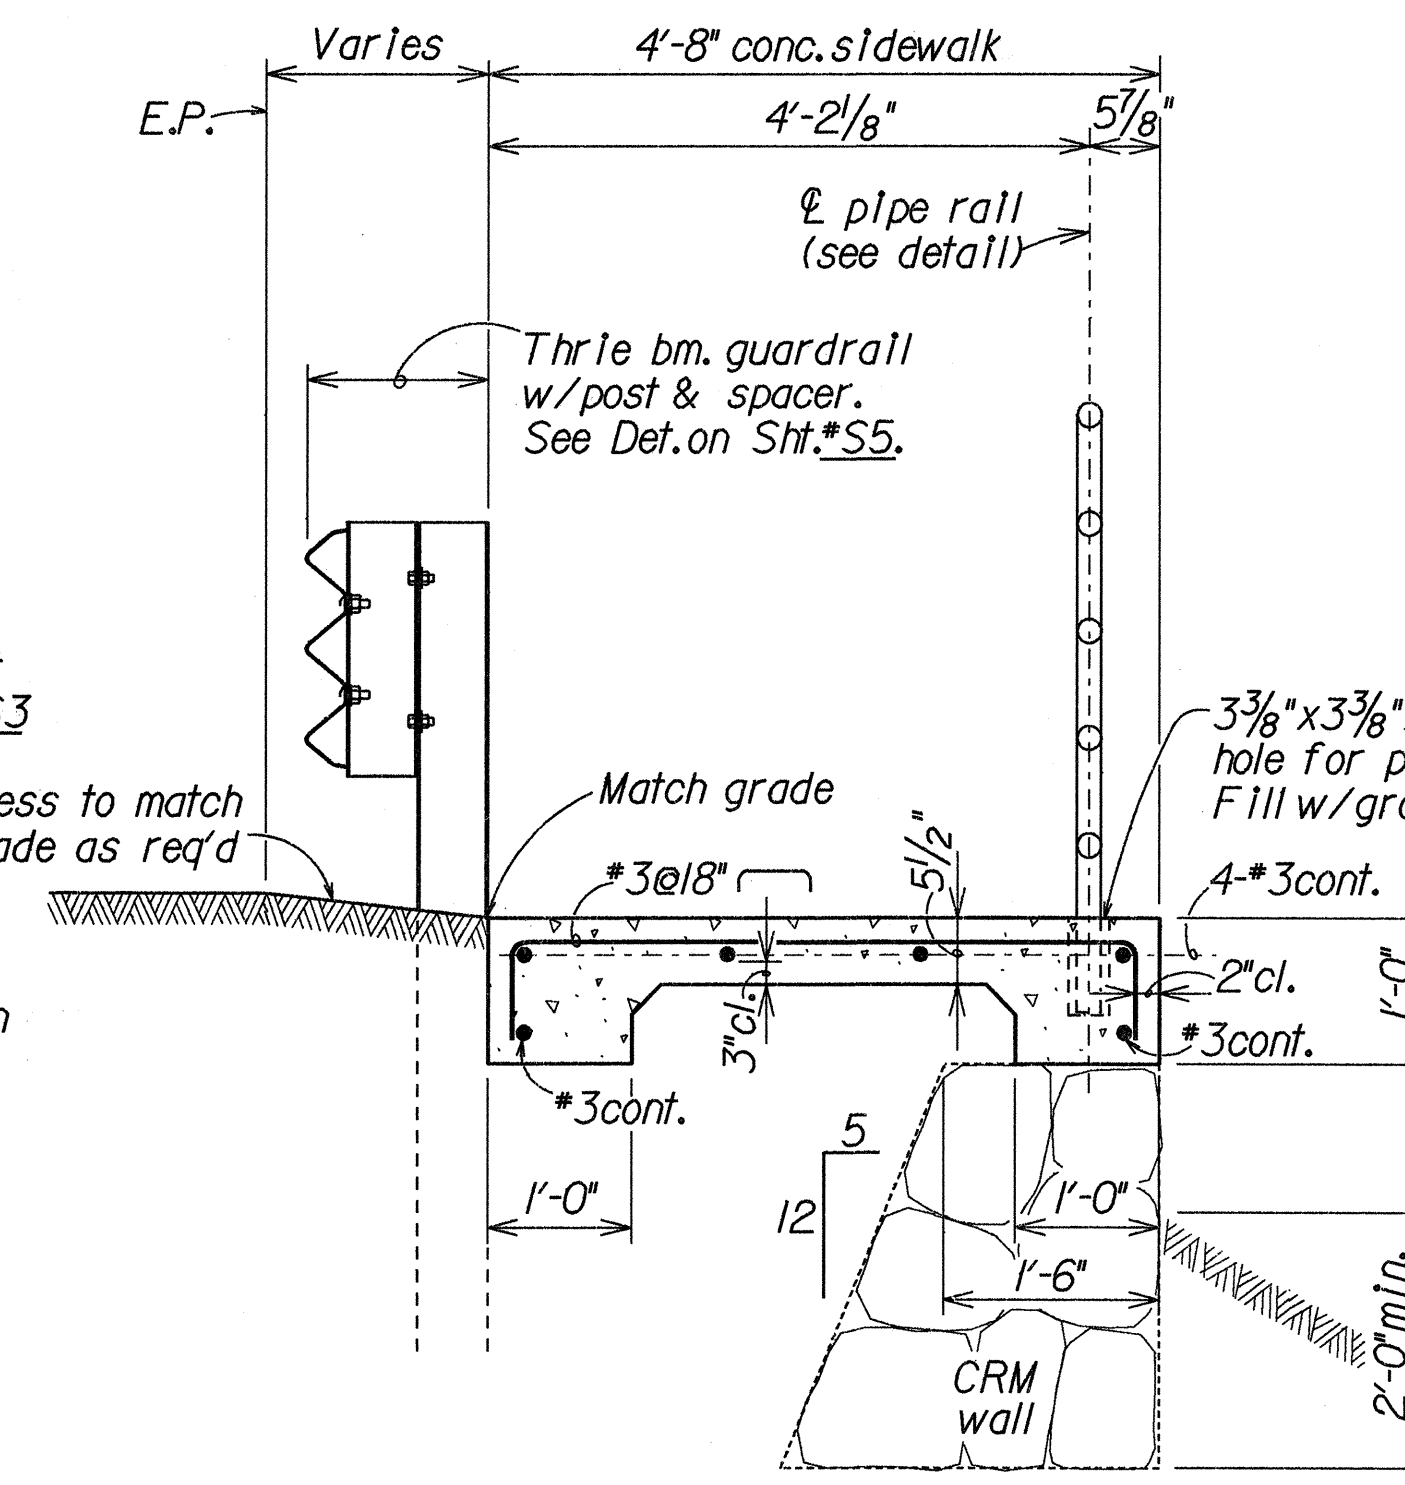


SECTION @ CONCRETE SIDEWALK
Scale: $\frac{3}{4}'' = 1'-0''$

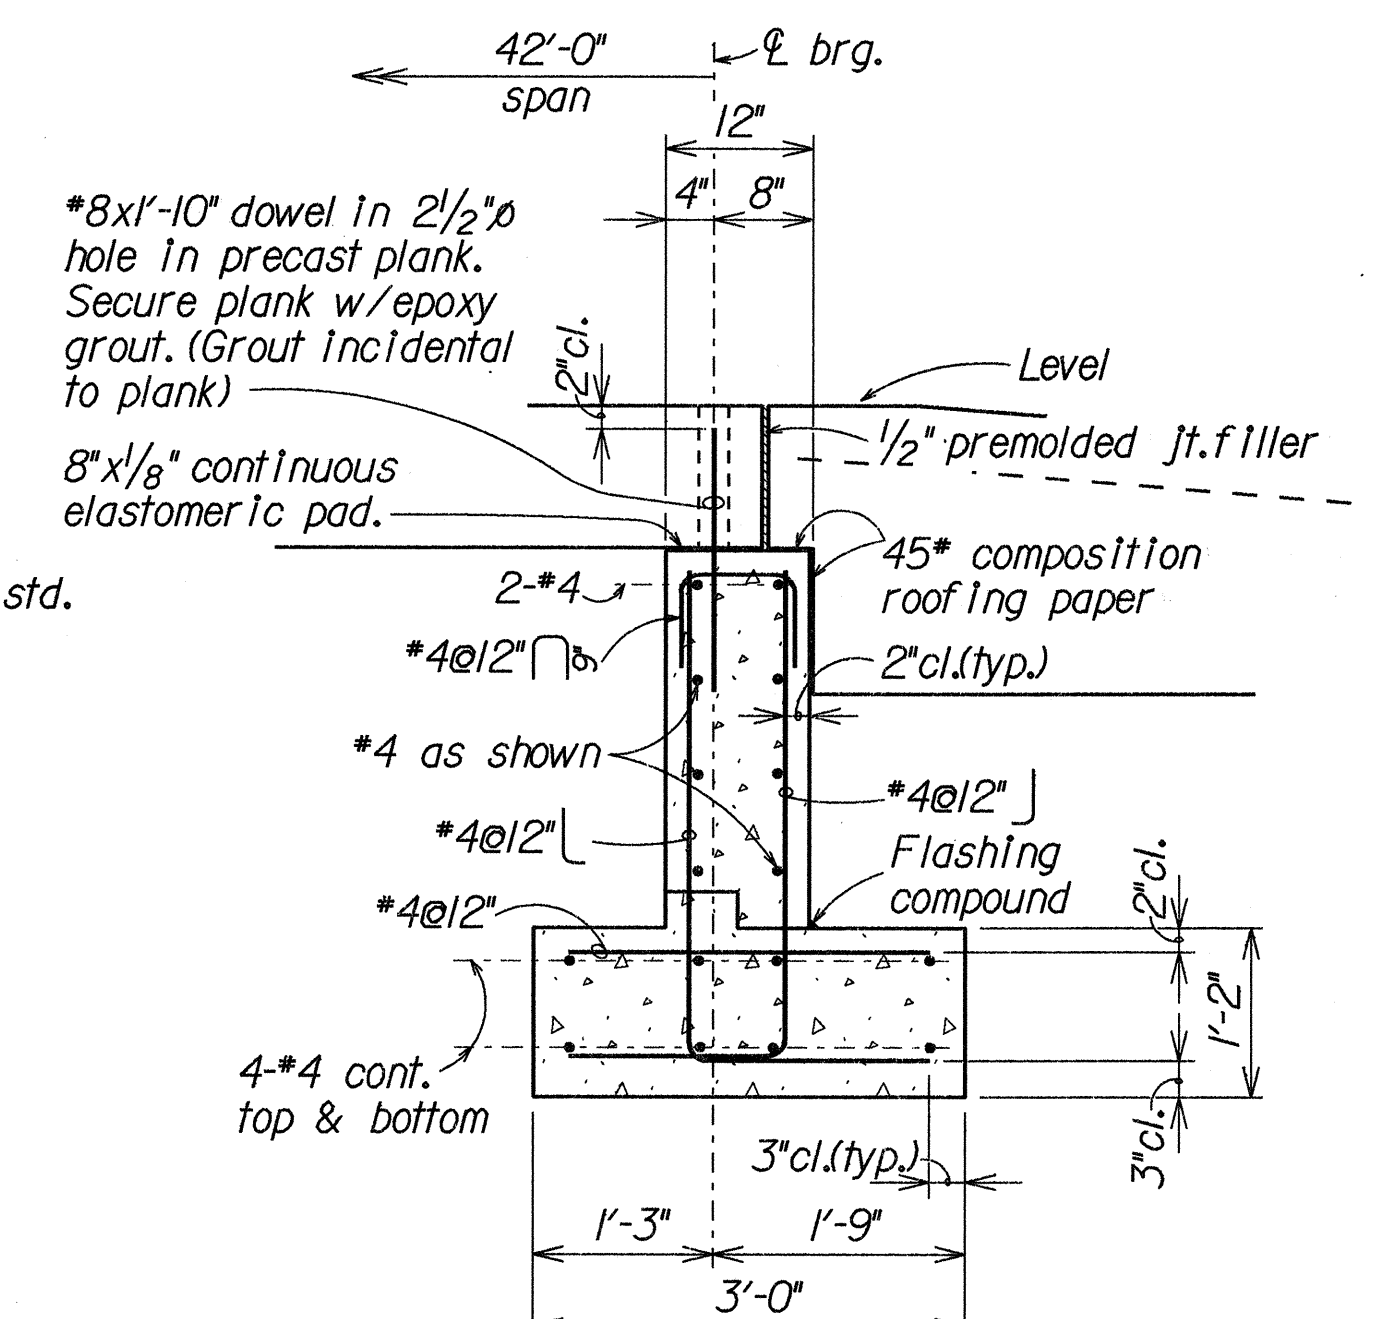

TYPICAL FOOTWALK ABUTMENT
Scale: $\frac{3}{4}'' = 1'-0''$

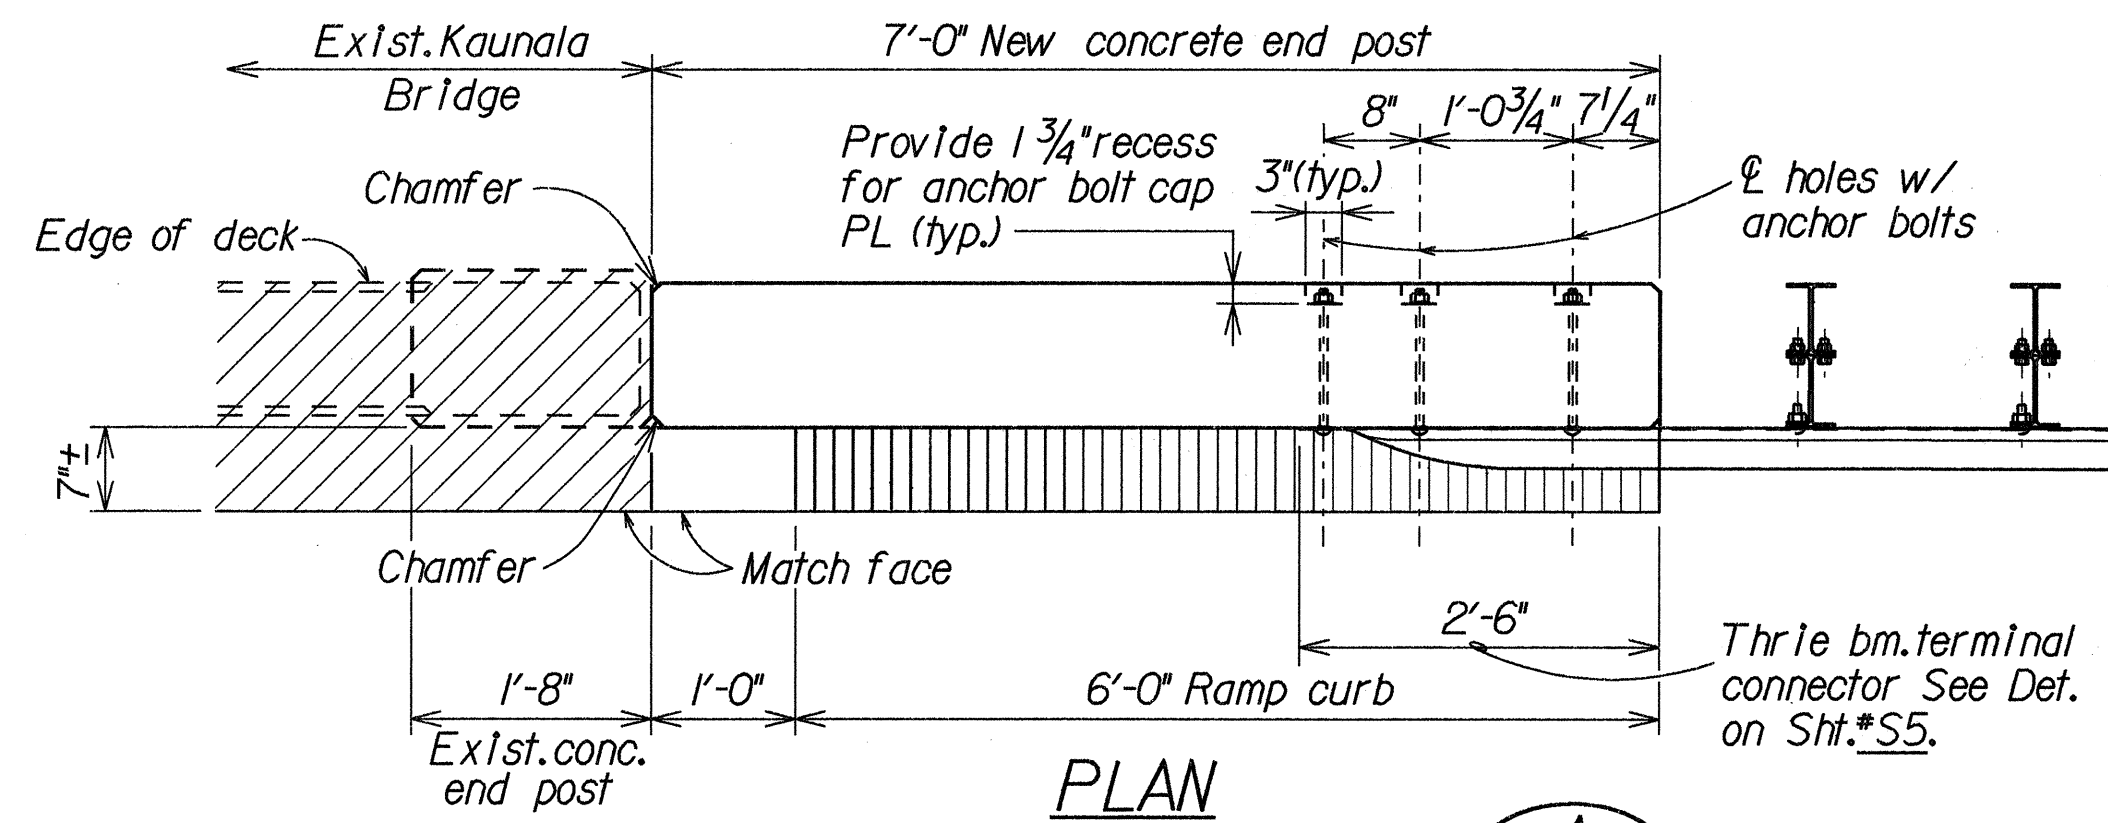


PLAN

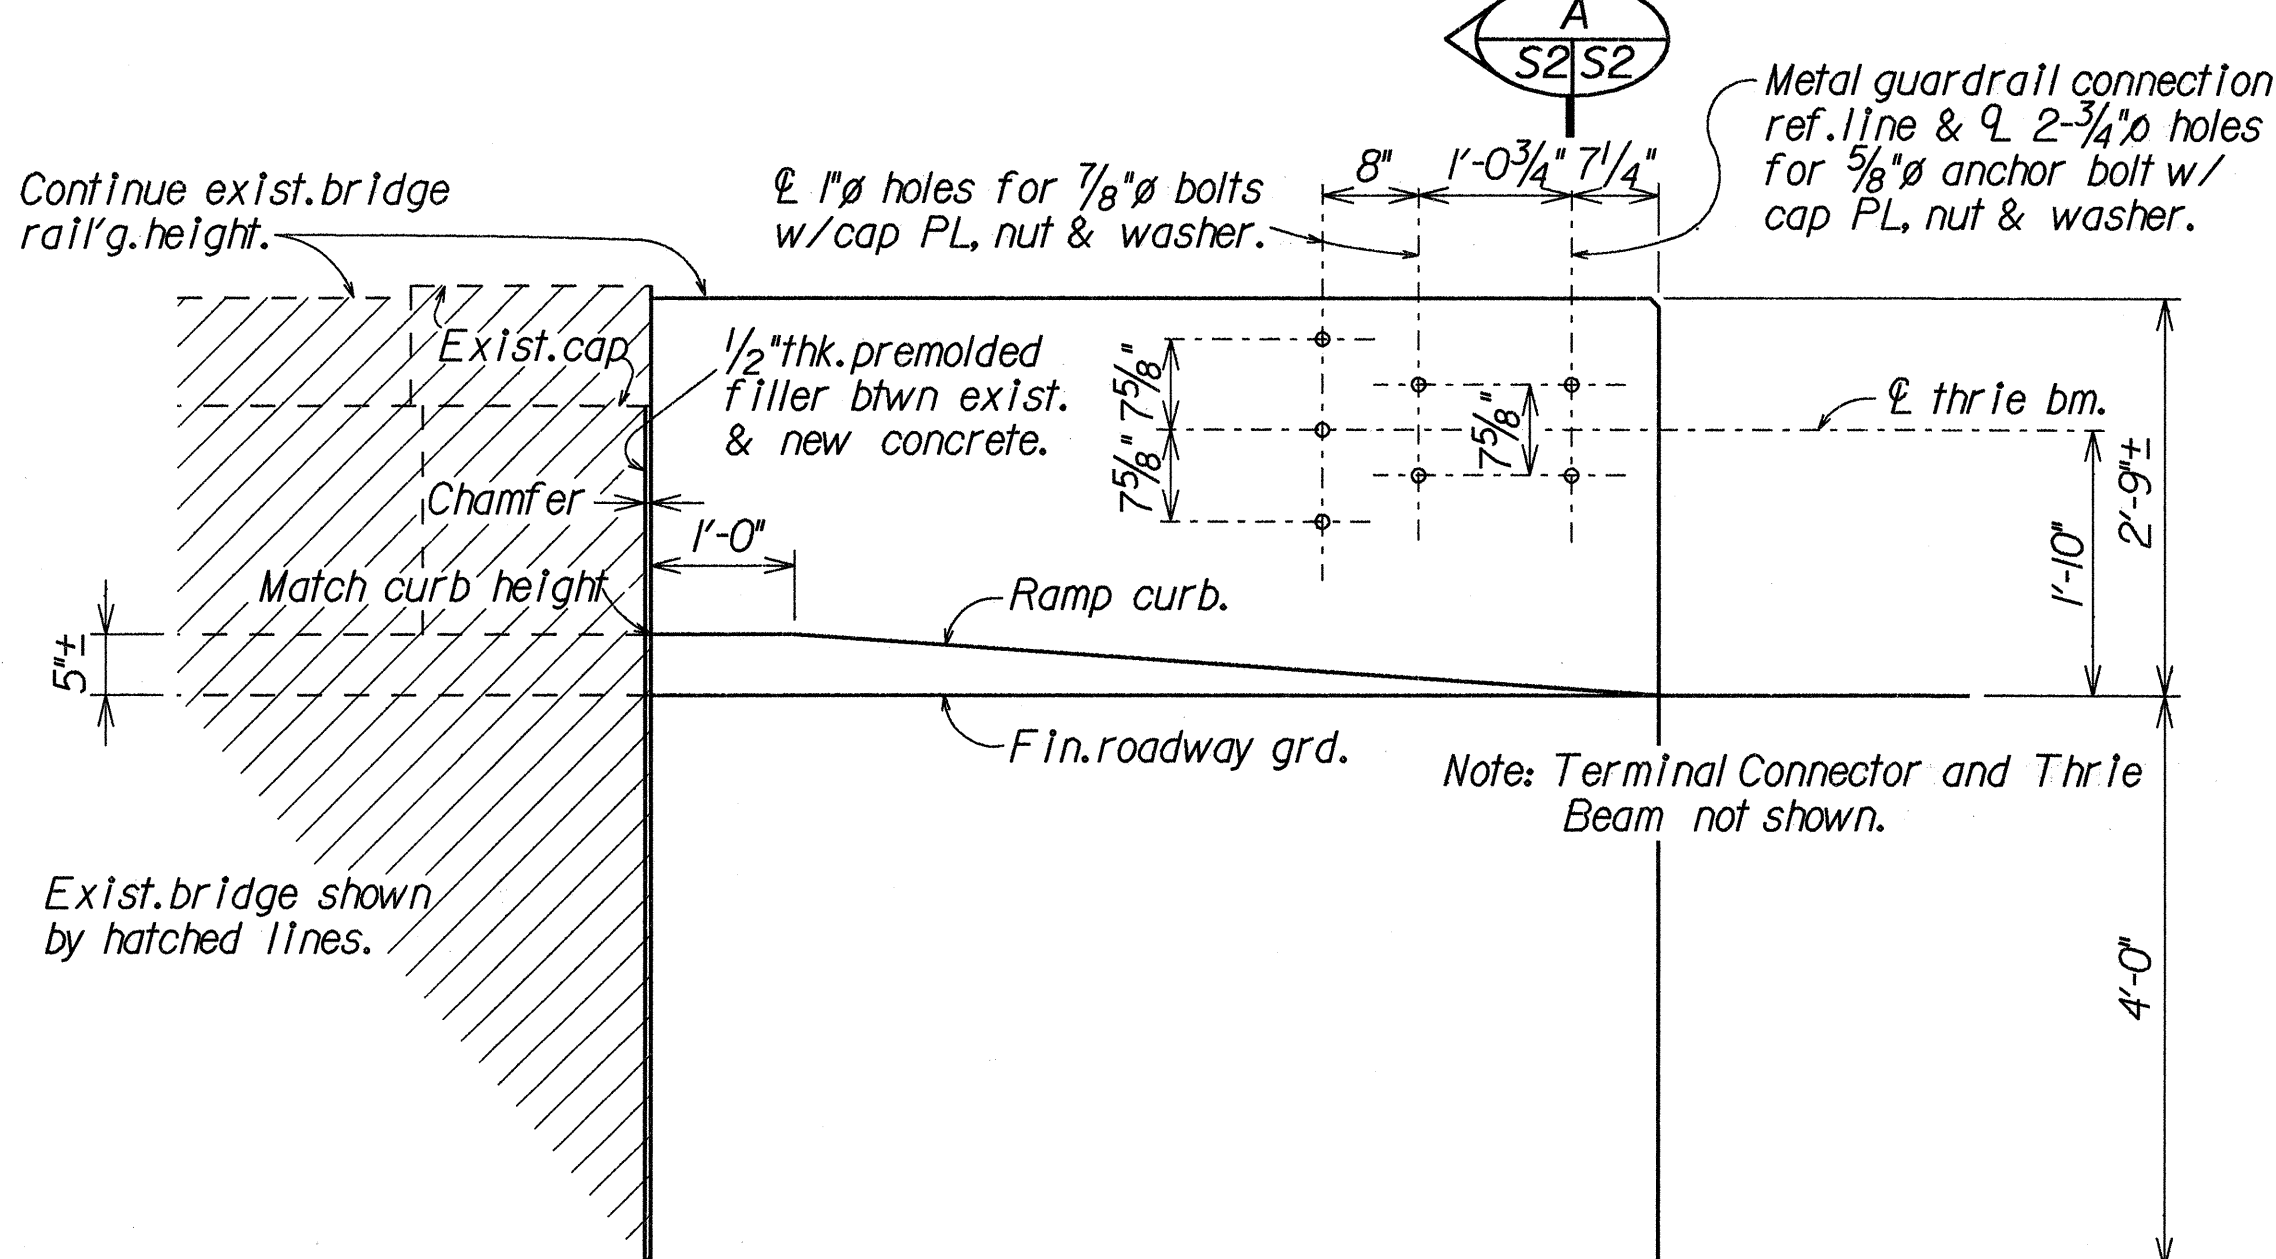


ELEVATION


NEW CONCRETE END POST (NORTH RAILING) DETAILS
Scale: $\frac{3}{4}'' = 1'-0''$

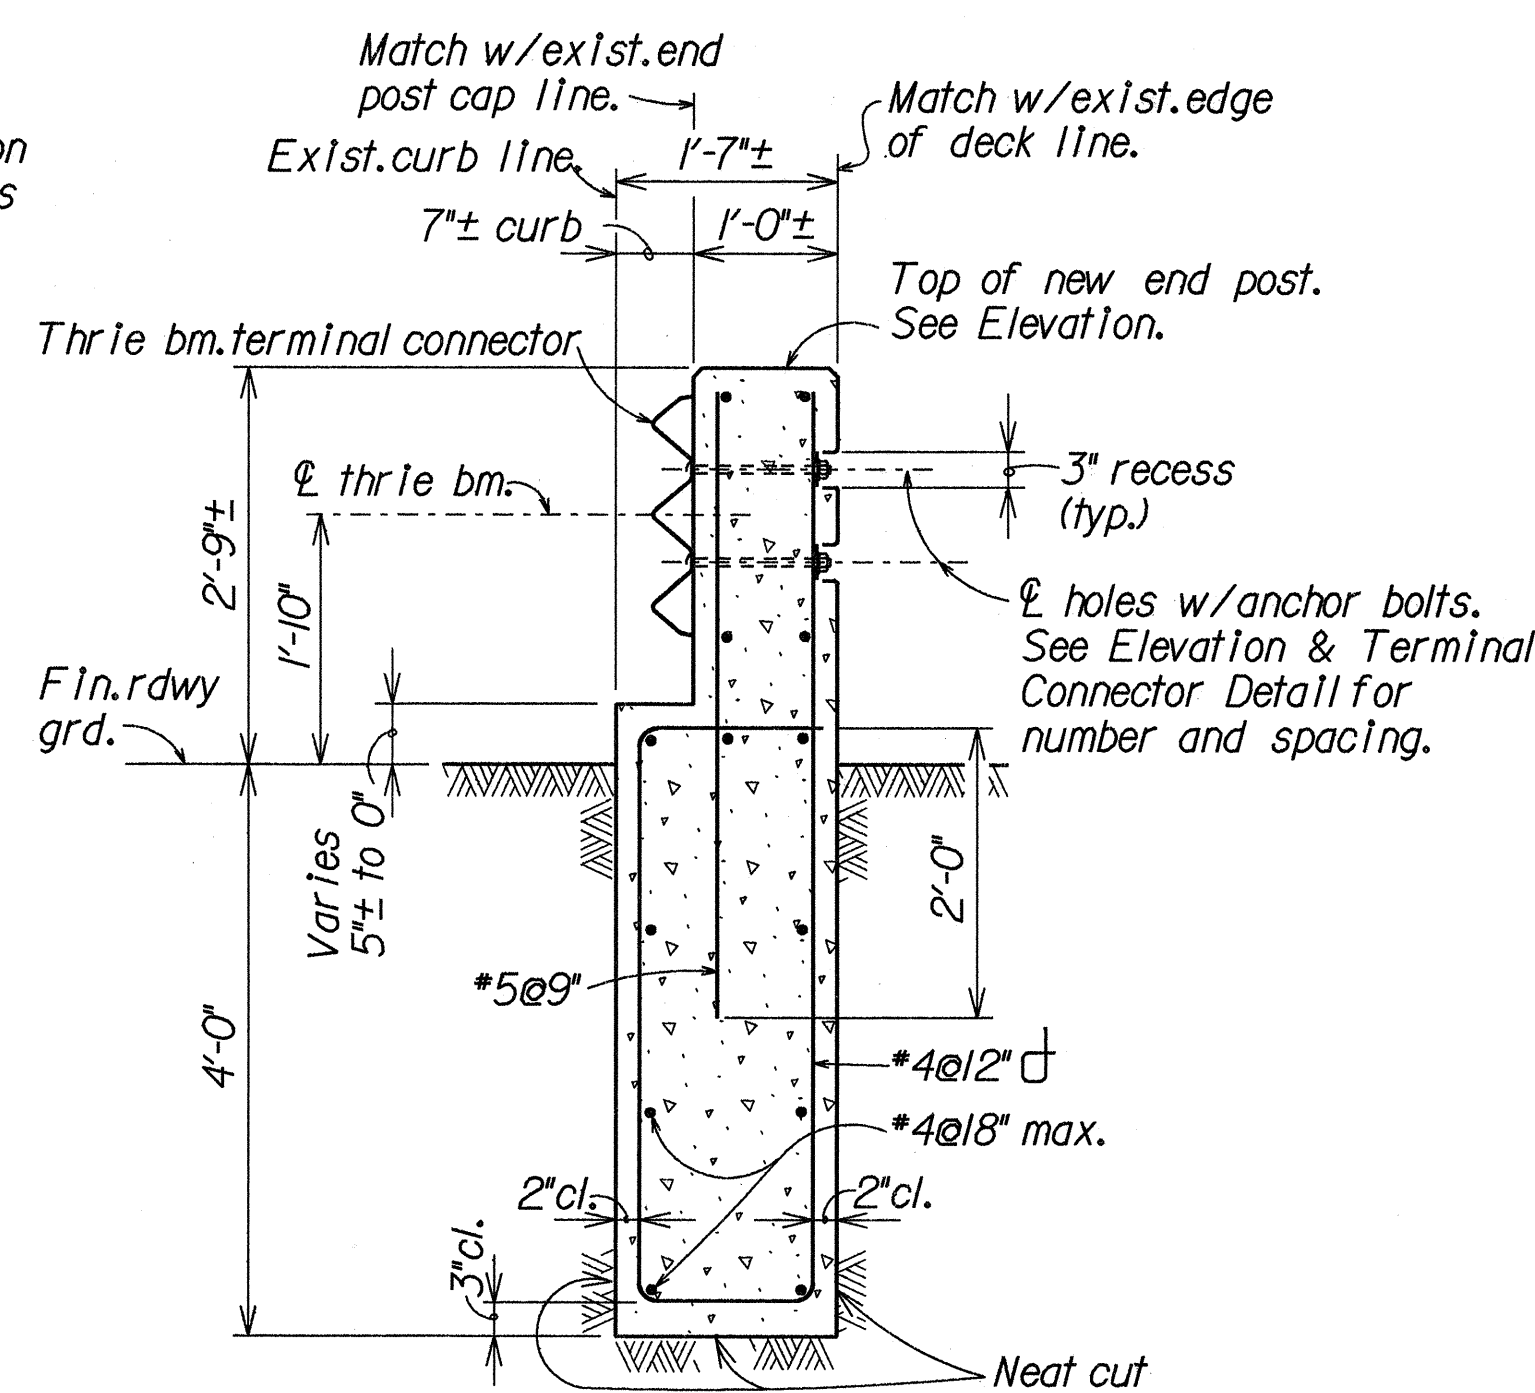

SECTION @ NEW CONCRETE END POST (NORTH RAILING) DETAILS

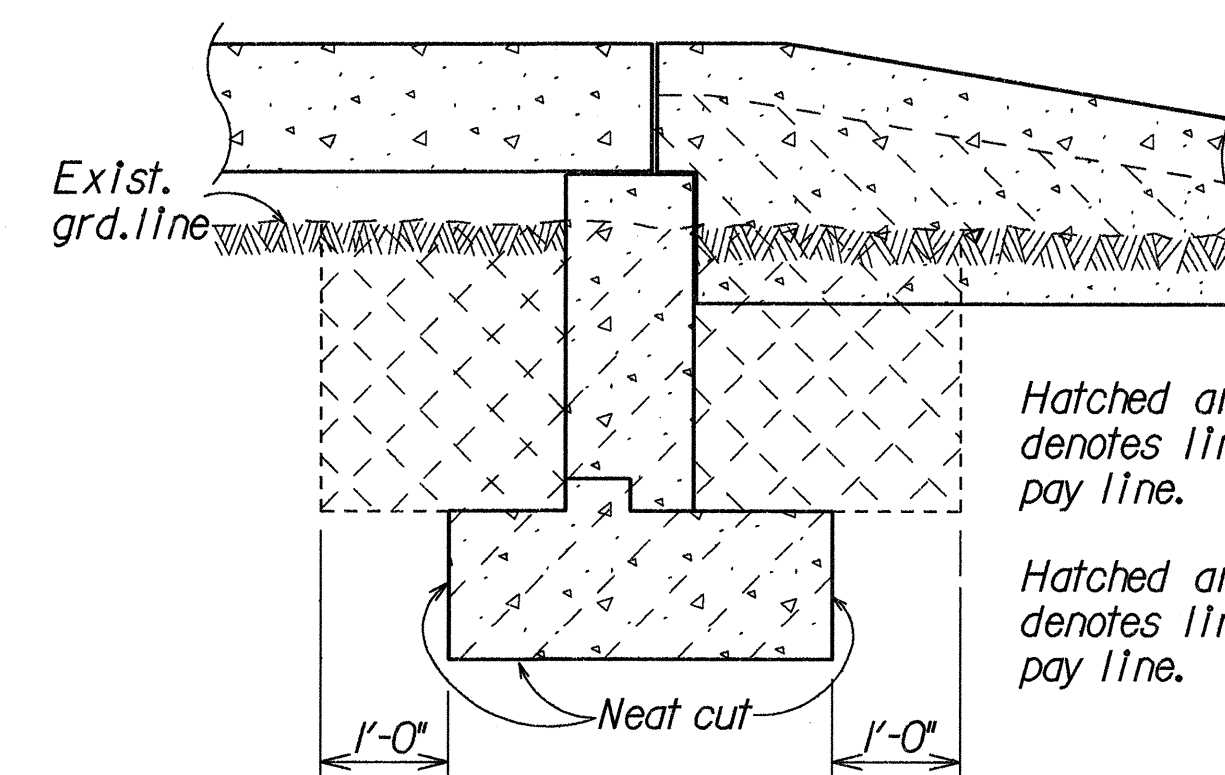

AT ABUTMENT

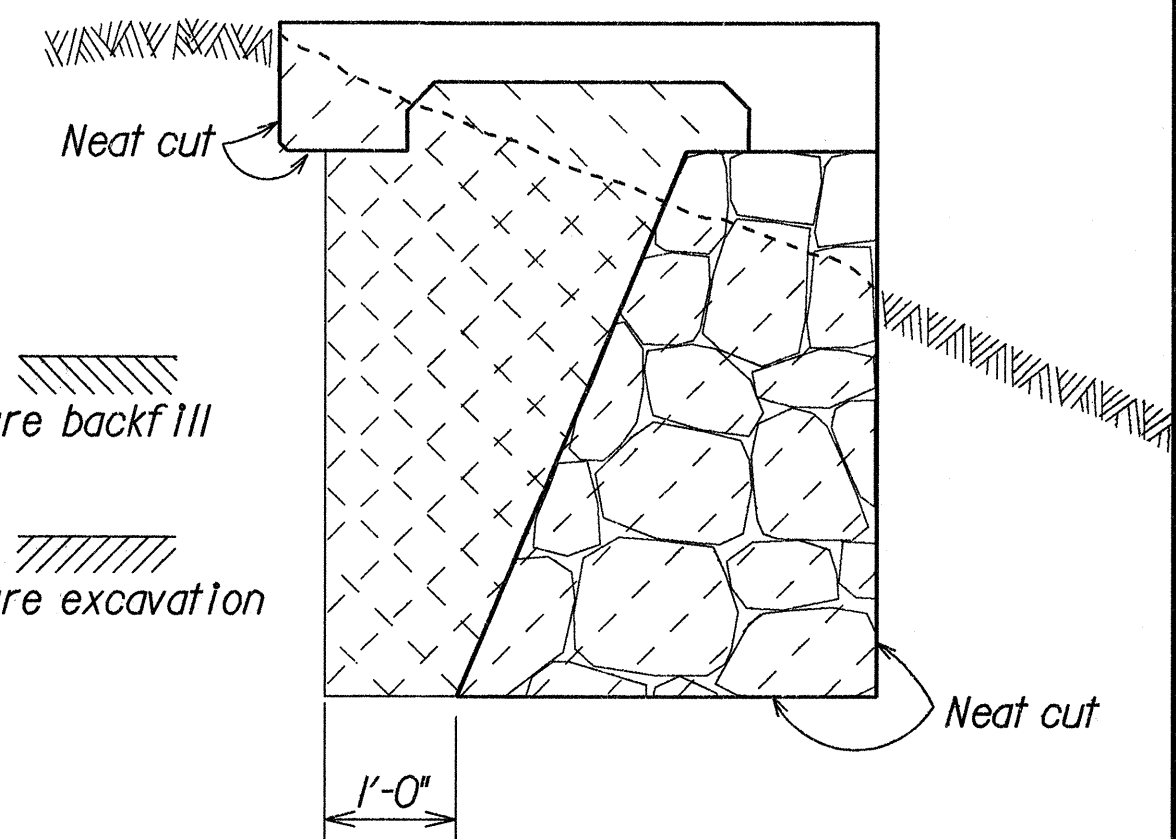


AT SIDEWALK & CRM WALL


STRUCTURAL EXCAVATION AND BACKFILL PAY LIMITS
Not to Scale

8-23-89	Change Order for construction of footwalk at Kaunala Bridge.
DATE	REVISION
STATE OF HAWAII DEPARTMENT OF TRANSPORTATION HIGHWAYS DIVISION	
SECTIONS, NEW CONCRETE END POST DETAILS AND STRUCTURE EXCAVATION KAMEHAMEHA HIGHWAY BRIDGE REPAIR AND MODIFICATION Project No. 83D-01-89M	
Scale: As Noted	(KAUNALA STREAM BRIDGE) Date: April 11, 1989
SHEET No. S2 OF 5 SHEETS	


FED. ROAD DIST. NO.	STATE	PROJ. NO.	FISCAL YEAR	SHEET NO.	TOTAL SHEETS
HAWAII	HAW.	83D-01-89M	1989	C.O.6S-3	12

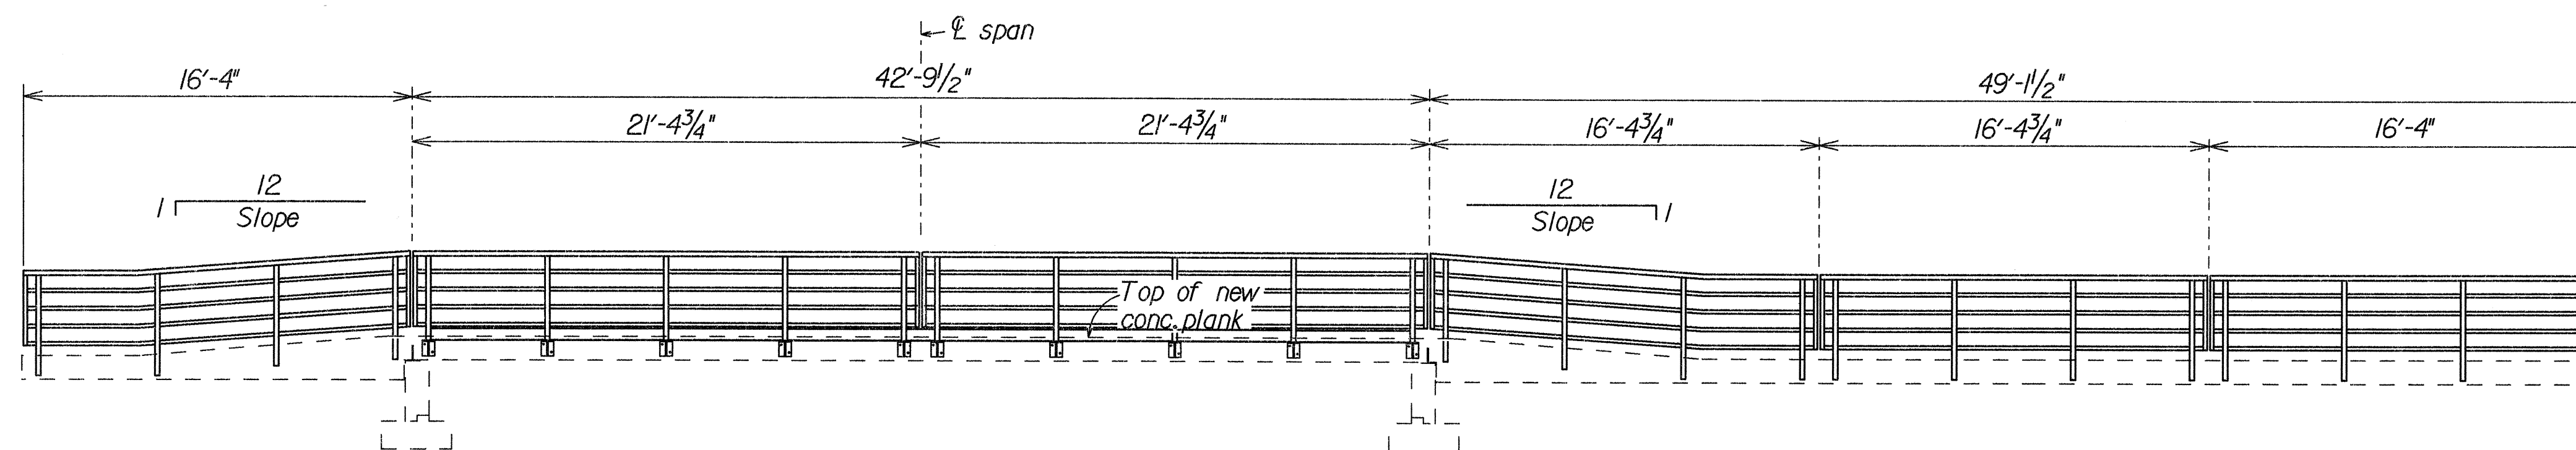

ELEVATION--PIPE RAILING ON FOOTWALK
Scale: 1" = 5'-0"

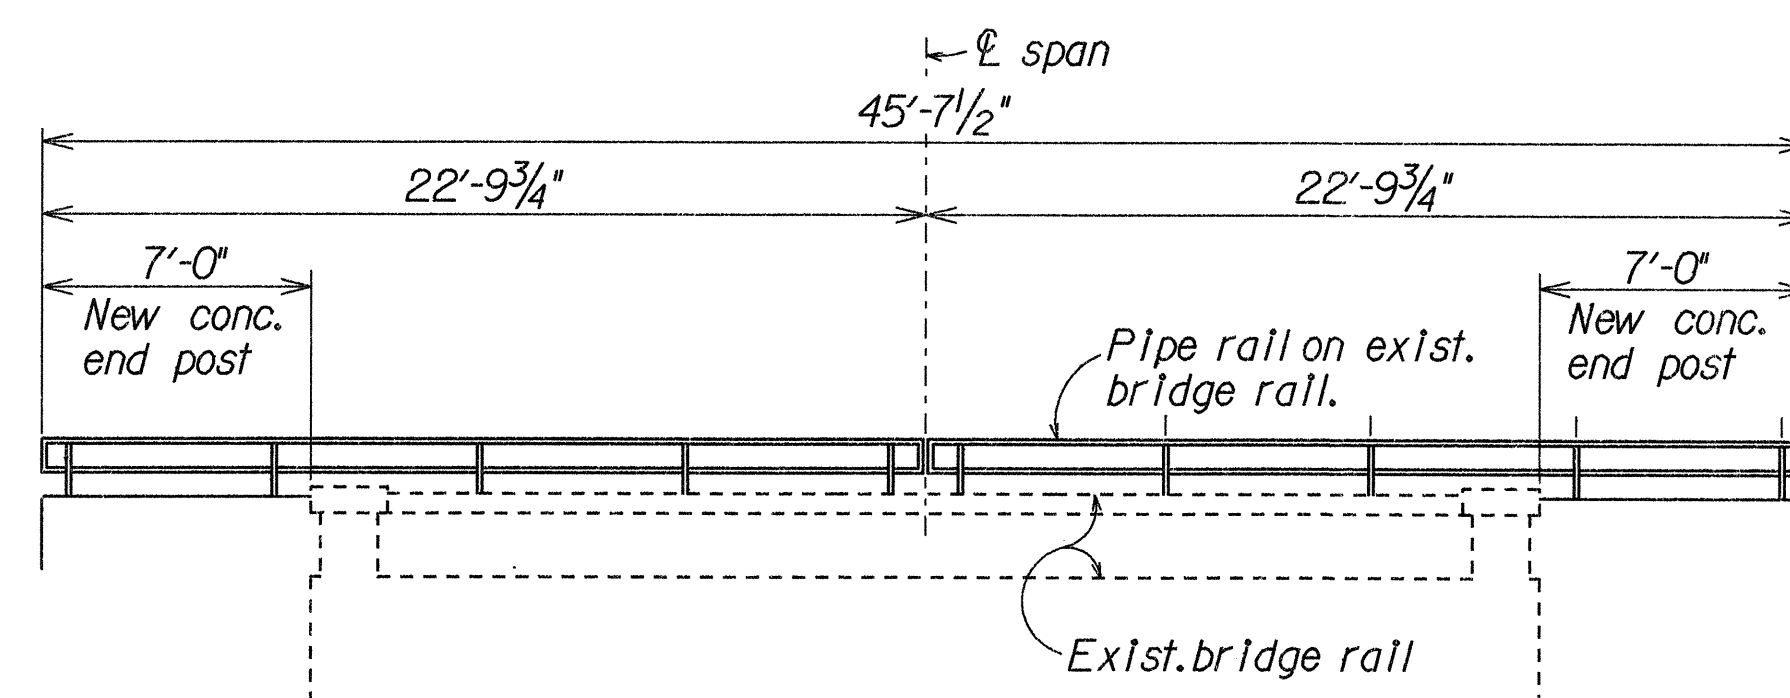


ELEVATION--PIPE RAILING ON EXISTING BRIDGE RAIL
Scale: 1" = 5'-0"

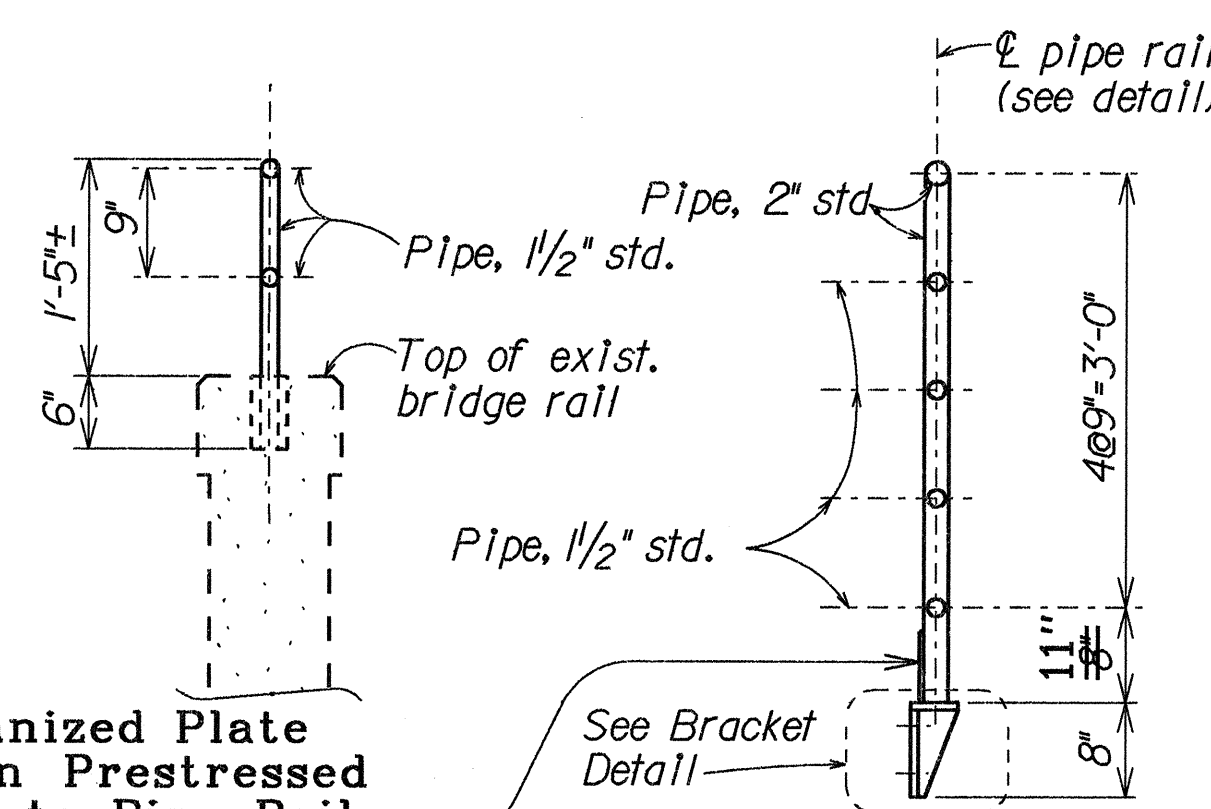


6"x1/4" Galvanized Plate continuous on Prestressed Plank Welded to Pipe Rail and Bracket (Field Change)

TYPICAL RAIL SECTIONS
Scale: 3/4" = 1'-0"

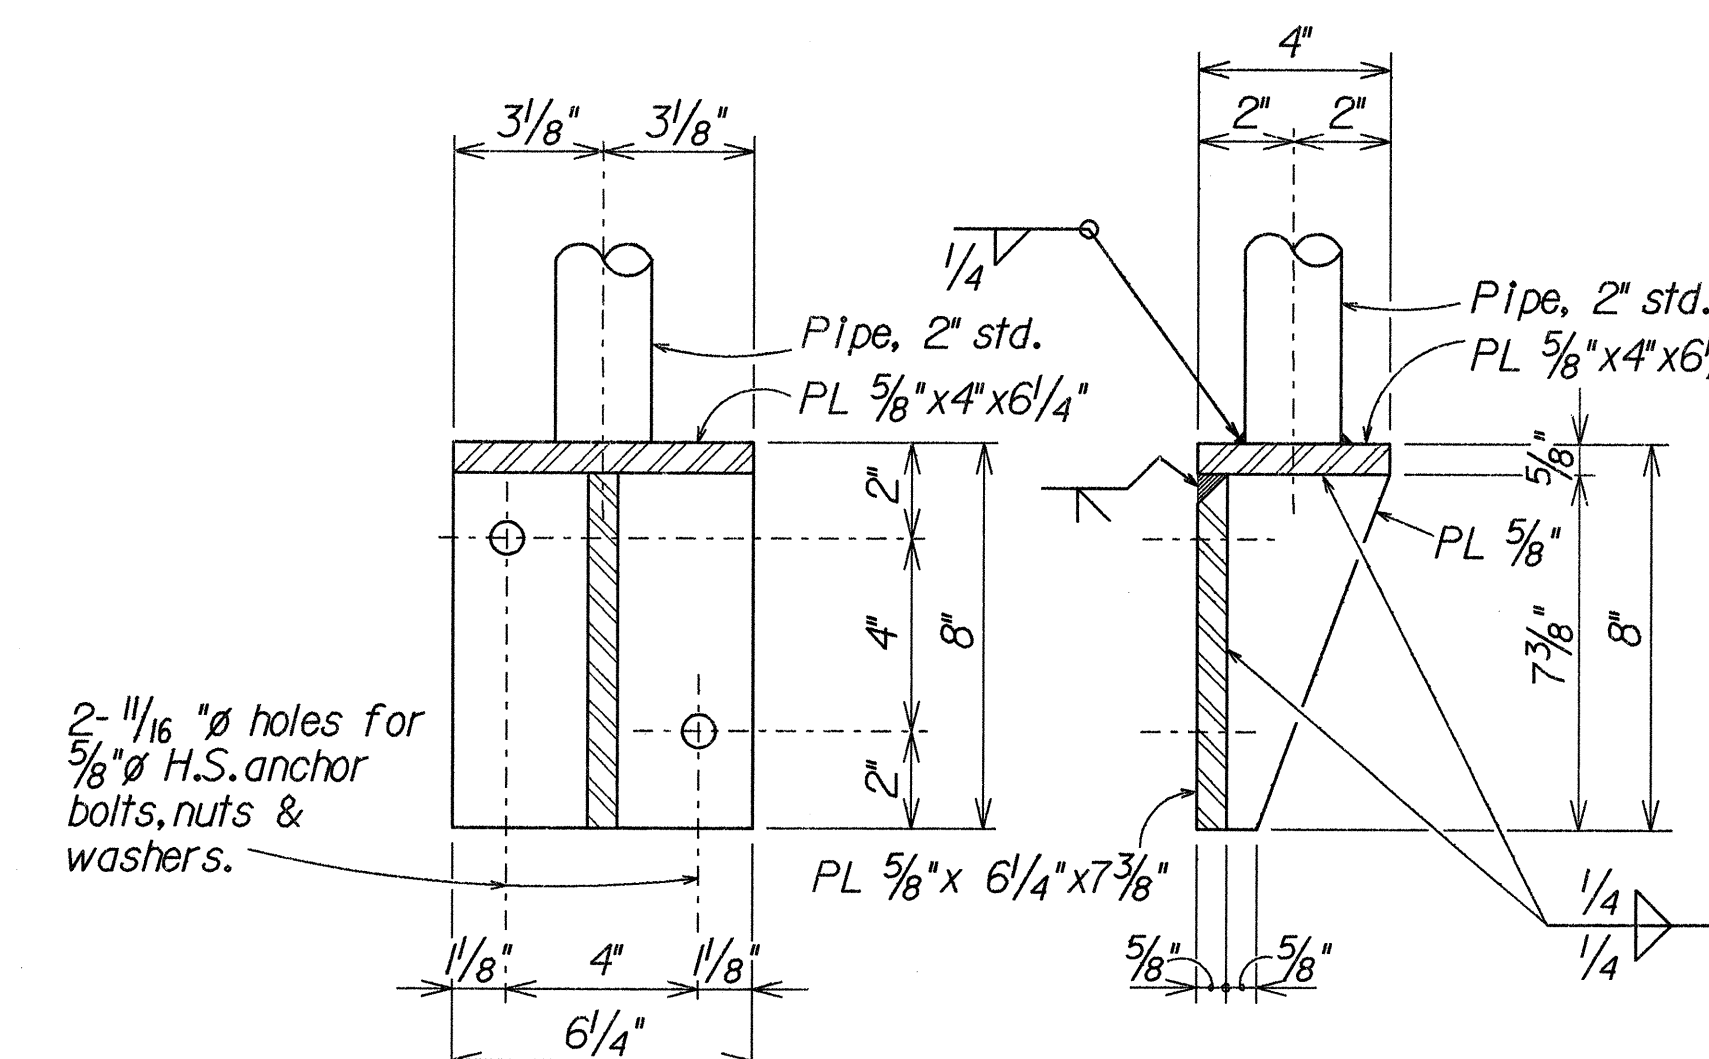


BRACKET DETAIL
Scale: 3" = 1'-0"

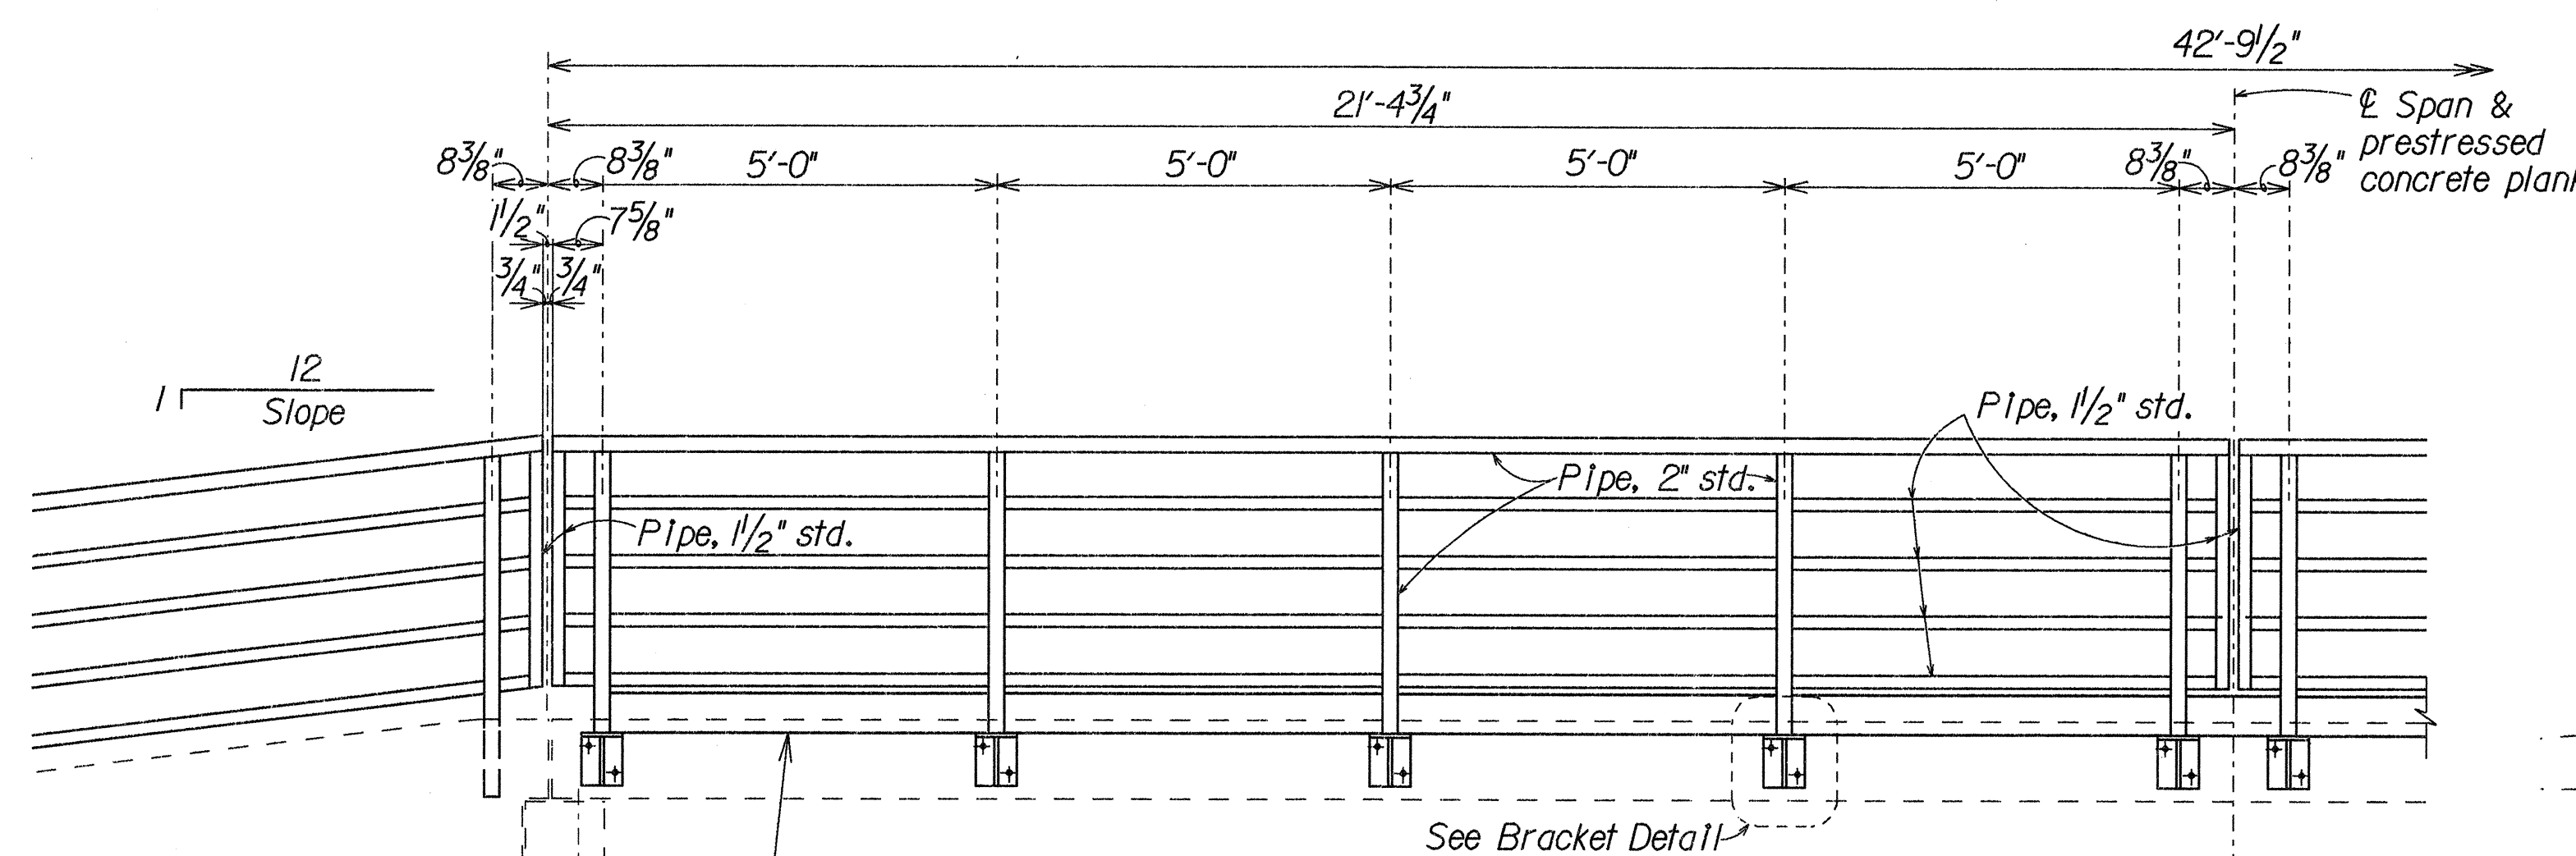

PARTIAL ELEVATION

6"x1/4" Galvanized Plate Continuous on Prestressed Plank (Field Change)

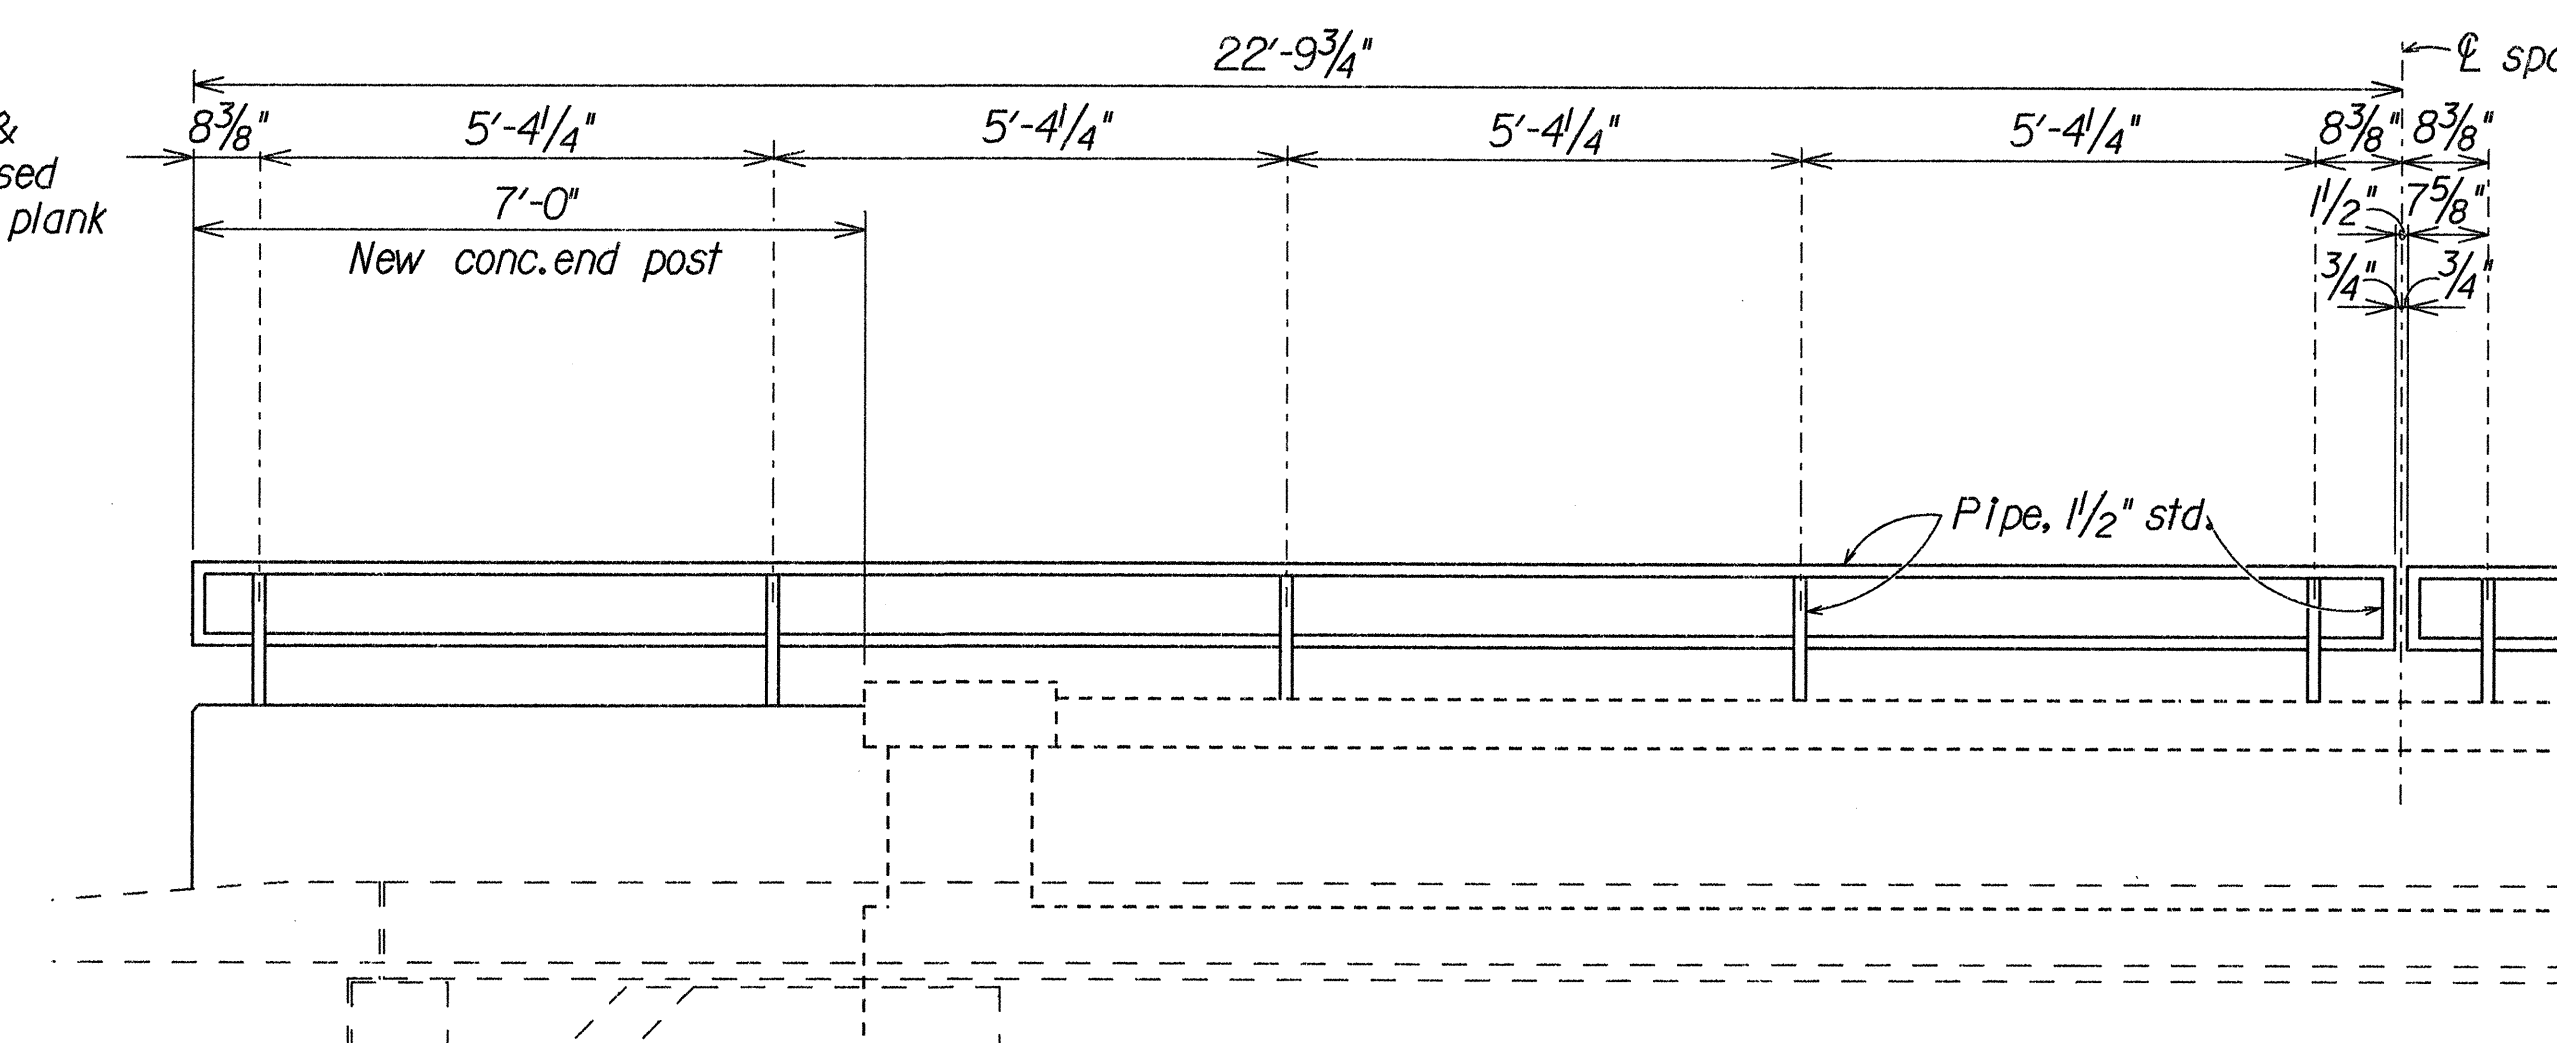

PARTIAL ELEVATION

PIPE RAILING DETAILS
Scale: 1/2" = 1'-0"

STRUCTURAL STEEL NOTES

1. Structural steel plates shall conform to ASTM A36.
2. Pipe shall conform to ASTM A53 Grade B.
3. Electrodes shall be E60XX.
4. All structural steel assemblies and hardware shall be hot-dip galvanized after fabrication.
5. H.S. anchor bolts -- ~~ASTM A93 Grade B8 Class 2 w/nuts & washers conforming to ASTM A94 Grade 8A~~ (Field Change)


8-23-89	Change Order for construction of footwalk at Kaunala Bridge
DATE	REVISION

STATE OF HAWAII DEPARTMENT OF TRANSPORTATION HIGHWAYS DIVISION	
PIPE RAILING DETAILS AND STRUCTURAL STEEL NOTES	
KAMEHAMEHA HIGHWAY BRIDGE REPAIR AND MODIFICATION Project No. 83D-01-89M	
Scale: As Noted	(KAUNALA STREAM BRIDGE) Date: April 1989
SHEET No. 53 OF 5 SHEETS	


C.O. 6S-3

ORIGINAL PLAN	DATE: APR 1989
DESIGNED BY: J.S.	DATE: APR 1989
NOTED BY: J.S.	DATE: APR 1989
CHECKED BY: J.S.	DATE: APR 1989


FED. ROAD DIST. NO.	STATE	PROJ. NO.	FISCAL YEAR	SHEET NO.	TOTAL SHEETS
HAWAII	HAW.	83D-01-89M	1989	C.O.6S-4	12

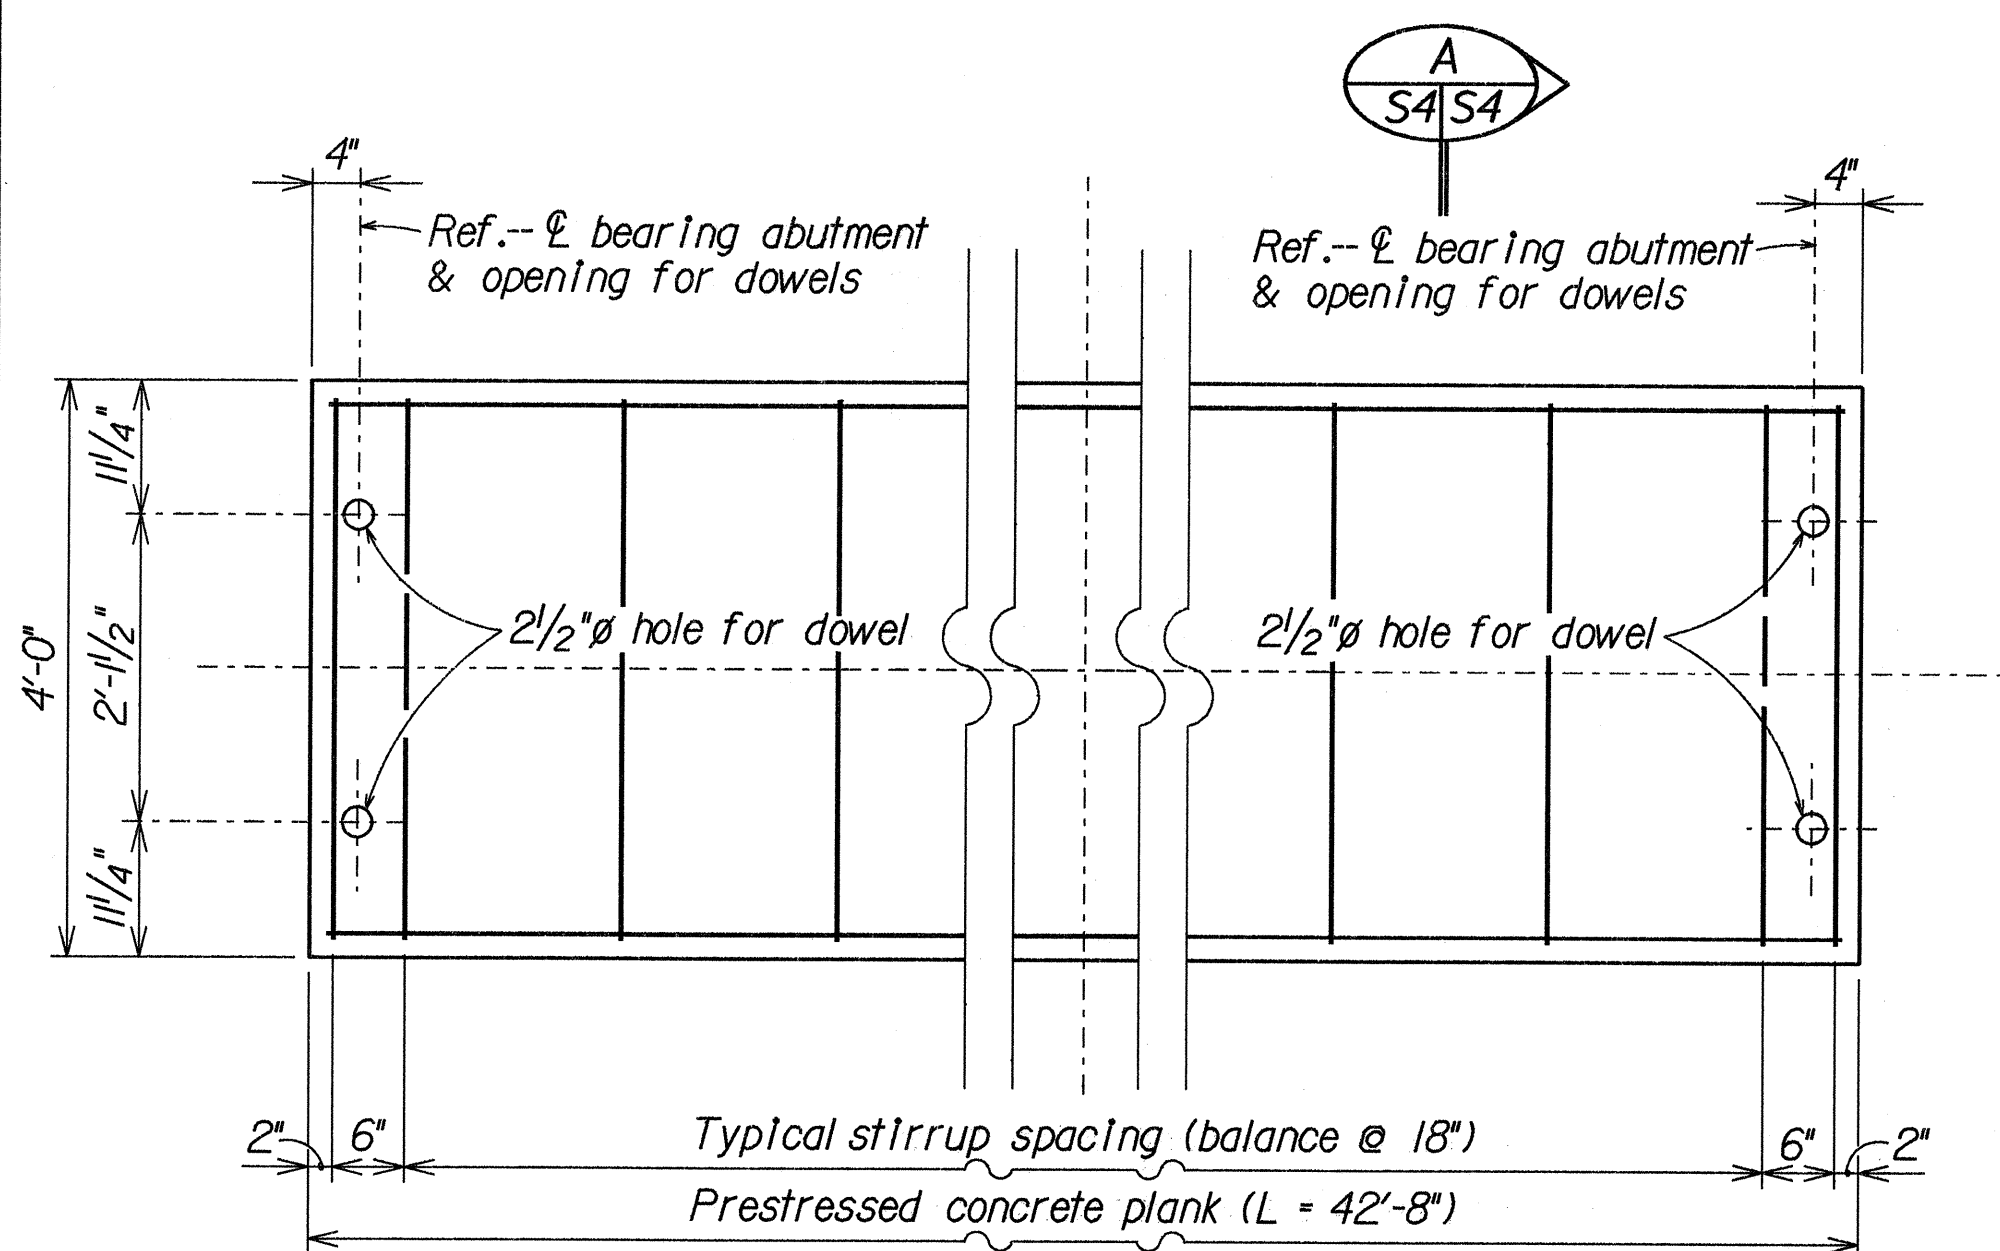

PARTIAL PLAN--END DETAIL
Scale: 3/4" = 1'-0"

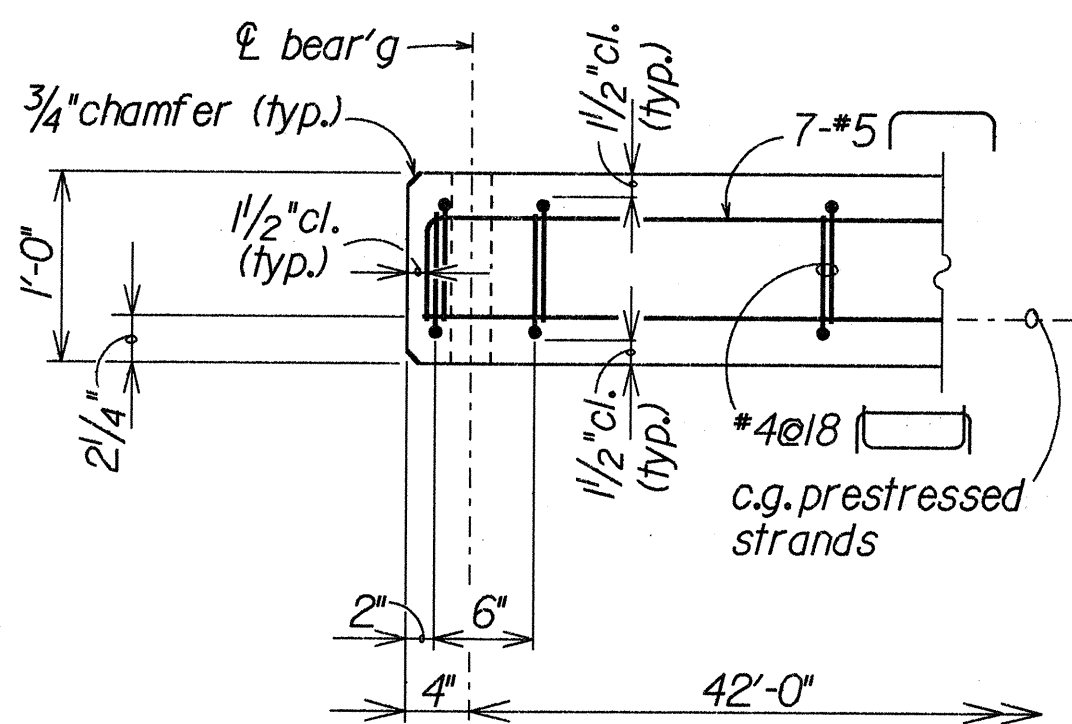

ELEVATION--END DETAIL
Scale: 1" = 1'-0"

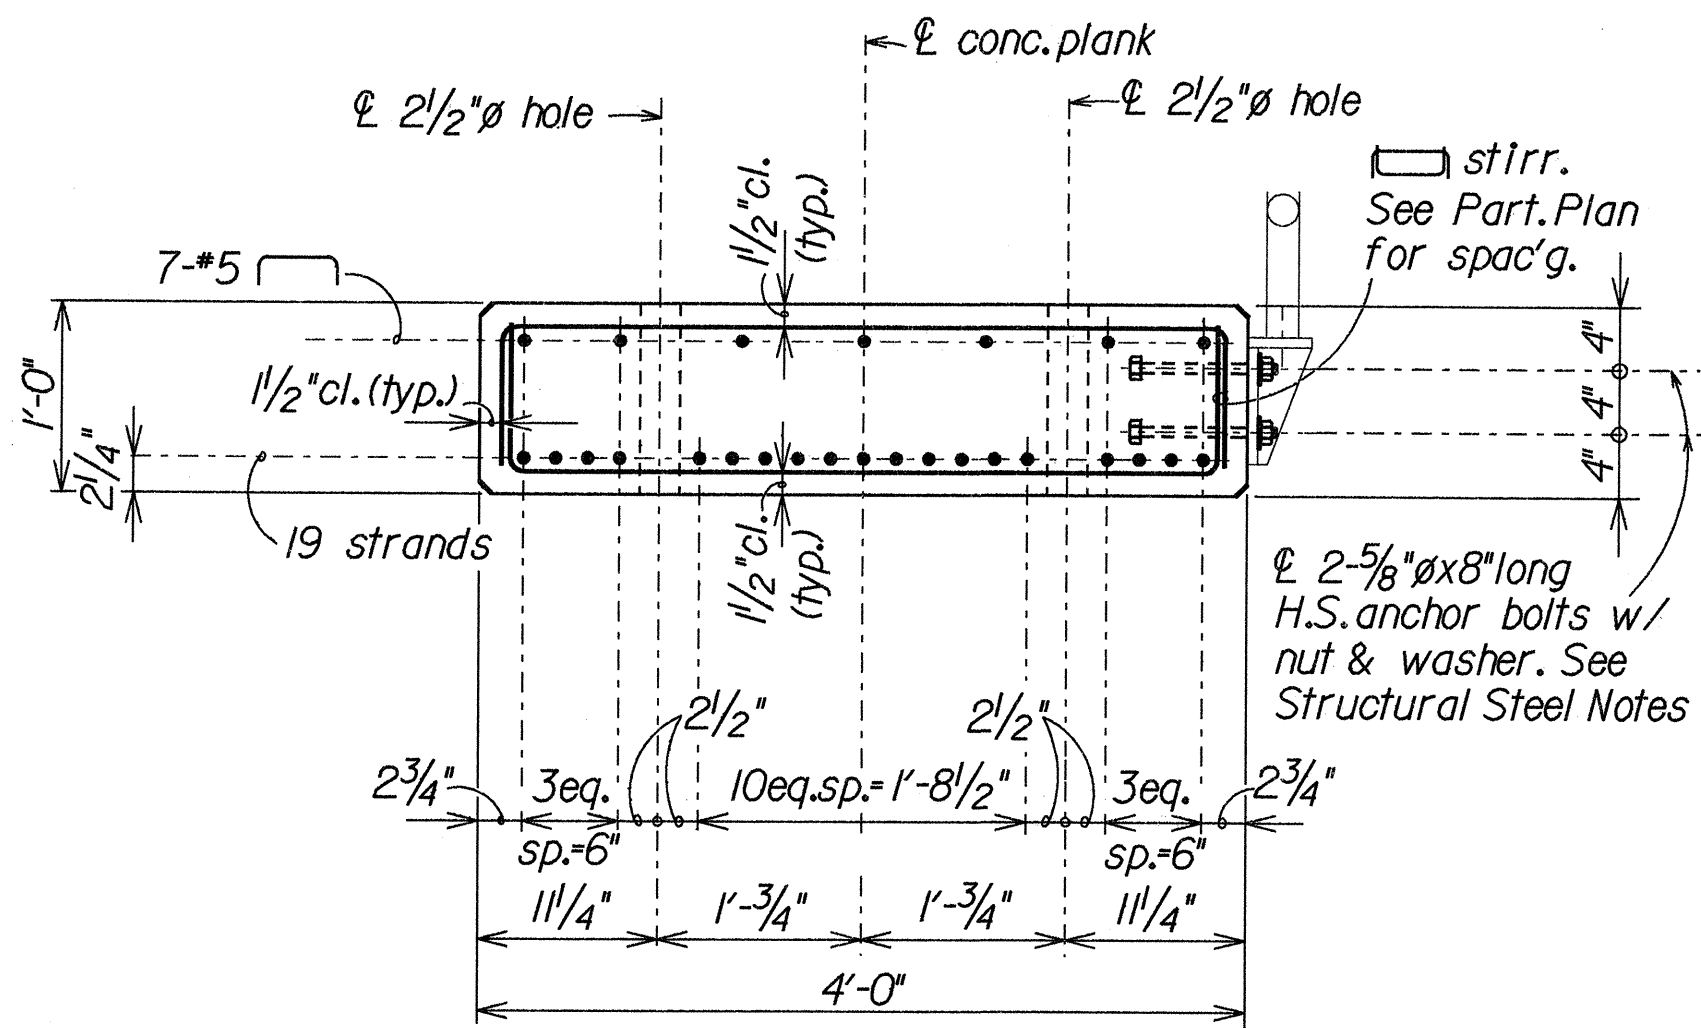

SECTION A
Scale: 1" = 1'-0"

PRESTRESS NOTES

Prestressed Concrete Plank

$f'_c = 6,000\text{psi @ 28days}$
 $f_{ci} = 5,000\text{psi @ transfer}$

Prestressed Strands

- Prestressed strands shall be 1/2" 270ksi, 7-wire stress-relieved strands (ASTM A416). Total losses other than friction = 45,000psi.
- Allowable stresses in strands shall be in accordance with Design Specifications (See General Notes).
- Effective Prestressed Force = 447.6k.

Notes

- For inserts in prestressed plank for railing connections, refer to corresponding details.
- The calculated camber includes the effect of the initial prestress force and the weight of the plank upon removal from the prestressing bed. Calculated camber value does not account for any camber growth of the plank. The actual camber at time of placement shall not exceed the calculated camber by more than 100%. Calculated midspan camber = 9/16". Contractor shall submit record of camber to the Engineer. This record shall include cambers at time of defensioning, delivery, and placement.

8-23-89 Change Order for construction of footwalk at Kaunala Bridge.

DATE REVISION

STATE OF HAWAII
DEPARTMENT OF TRANSPORTATION
HIGHWAYS DIVISION
**PRESTRESSED CONCRETE PLANK SECTIONS
AND PRESTRESS NOTES**
KAMEHAMEHA HIGHWAY
BRIDGE REPAIR AND MODIFICATION
Project No. 83D-01-89M

Scale: As Noted (KAUNALA STREAM BRIDGE) Date: April 11, 1989

SHEET No. S4 OF 5 SHEETS


C.O. 6S-4

ORIGINAL PLAN	SURVEY PLOTTED BY	DATE
NOTE BOOK	DRAWN BY	APR 1989
NO. KAUNALA	DESIGNED BY	APR 1989
	CHECKED BY	APR 1989
	IN CHARGE	APR 1989

FED. ROAD DIST. NO.	STATE	PROJ. NO.	FISCAL YEAR	SHEET NO.	TOTAL SHEET
HAWAII	HAW.	83D-01-89M	1989	C.06S-5	12


NOTES:

1. "Terminal Connector" shall be fabricated from 10 gauge steel conforming to the requirements of AASHTO M180.
2. All anchor bolts shall be high strength bolts conforming to the requirements of ASTM 325.
3. Anchor bolt length shall be such that a snug fit of the elements and full thread engagement plus 1/4"(max) is attained.
4. "Terminal Connector", tapered box and standard spacer; including all anchor bolts, cap PL, nuts and washers; shall be hot-dip galvanized after fabrication.
5. First 25'-0" of guardrail adjoining "Terminal Connector" shall be of galvanized steel and supports spaced as shown on the detail drawings.
6. Heads of through anchor bolts shall be placed on the traffic side of the end block; those at the thru spacer block excepted.
7. Where double (nested) beam occur, 12" "Backup Plate" not required.
8. Double (nest 1st panel) thru beam elements at all end post connections, except on highways with one-way traffic pattern, use single thru beam element at end post on trailing end only.

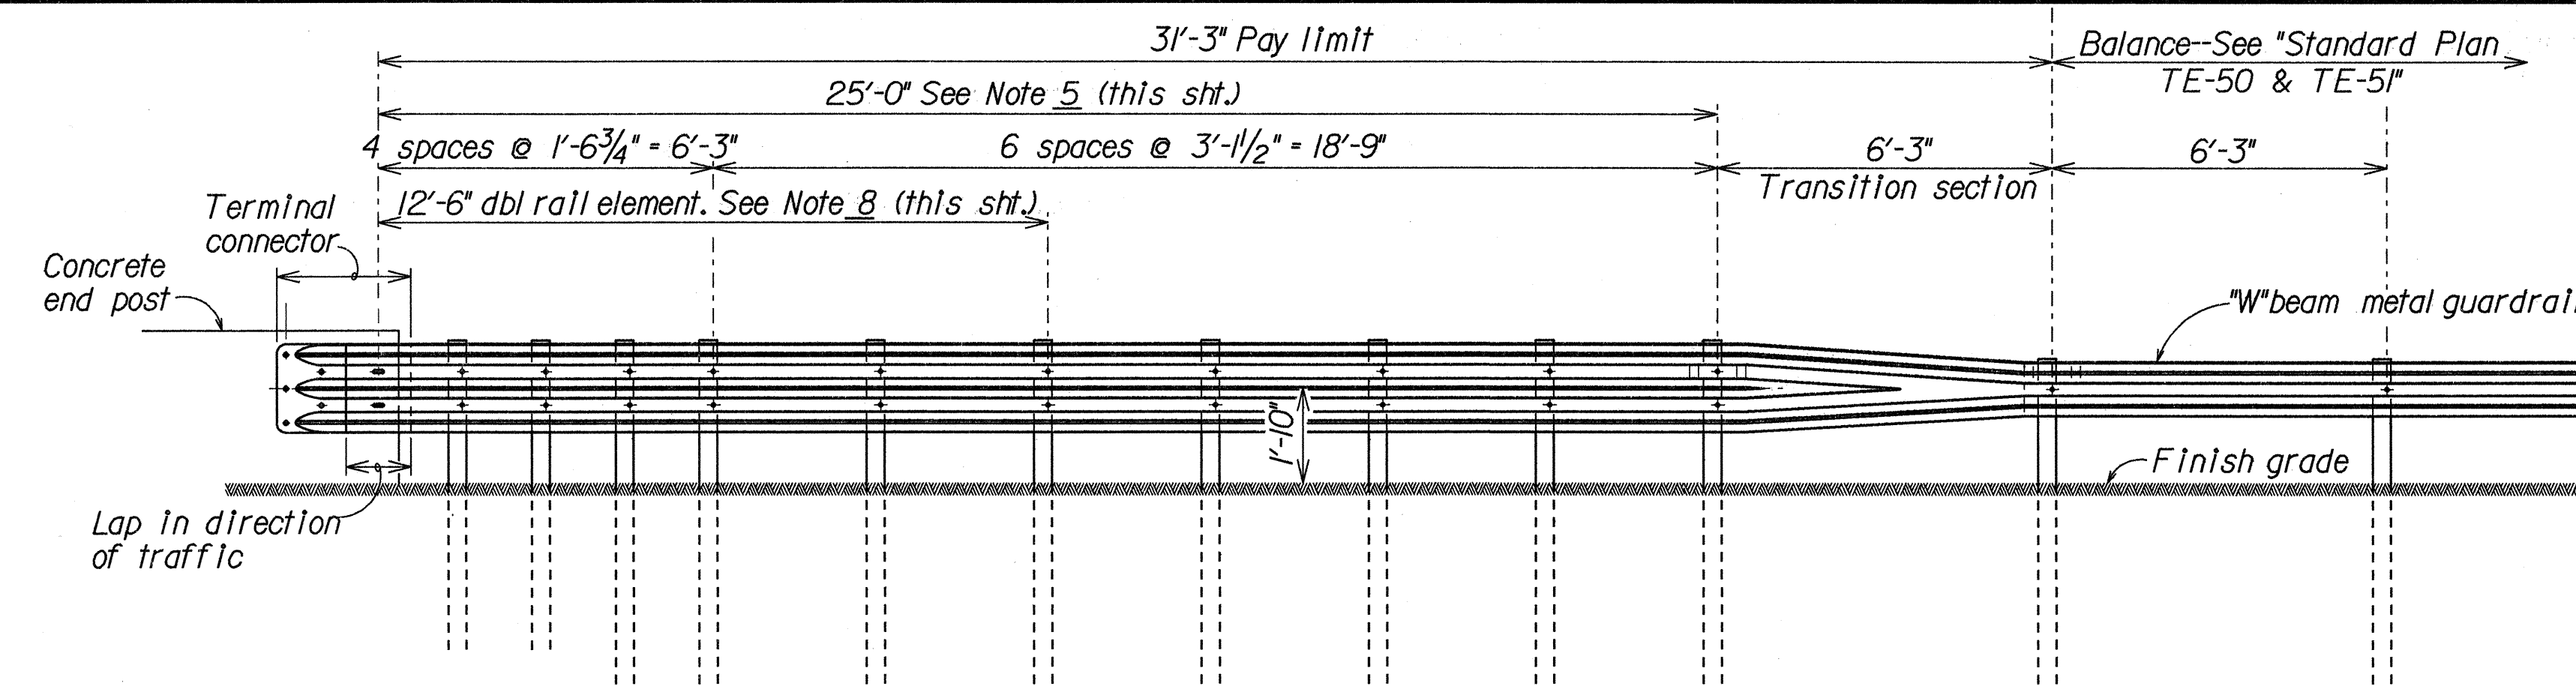


GUARDRAIL POST SPACING DETAIL

Scale: $\frac{3}{8}" = 1'-0"$

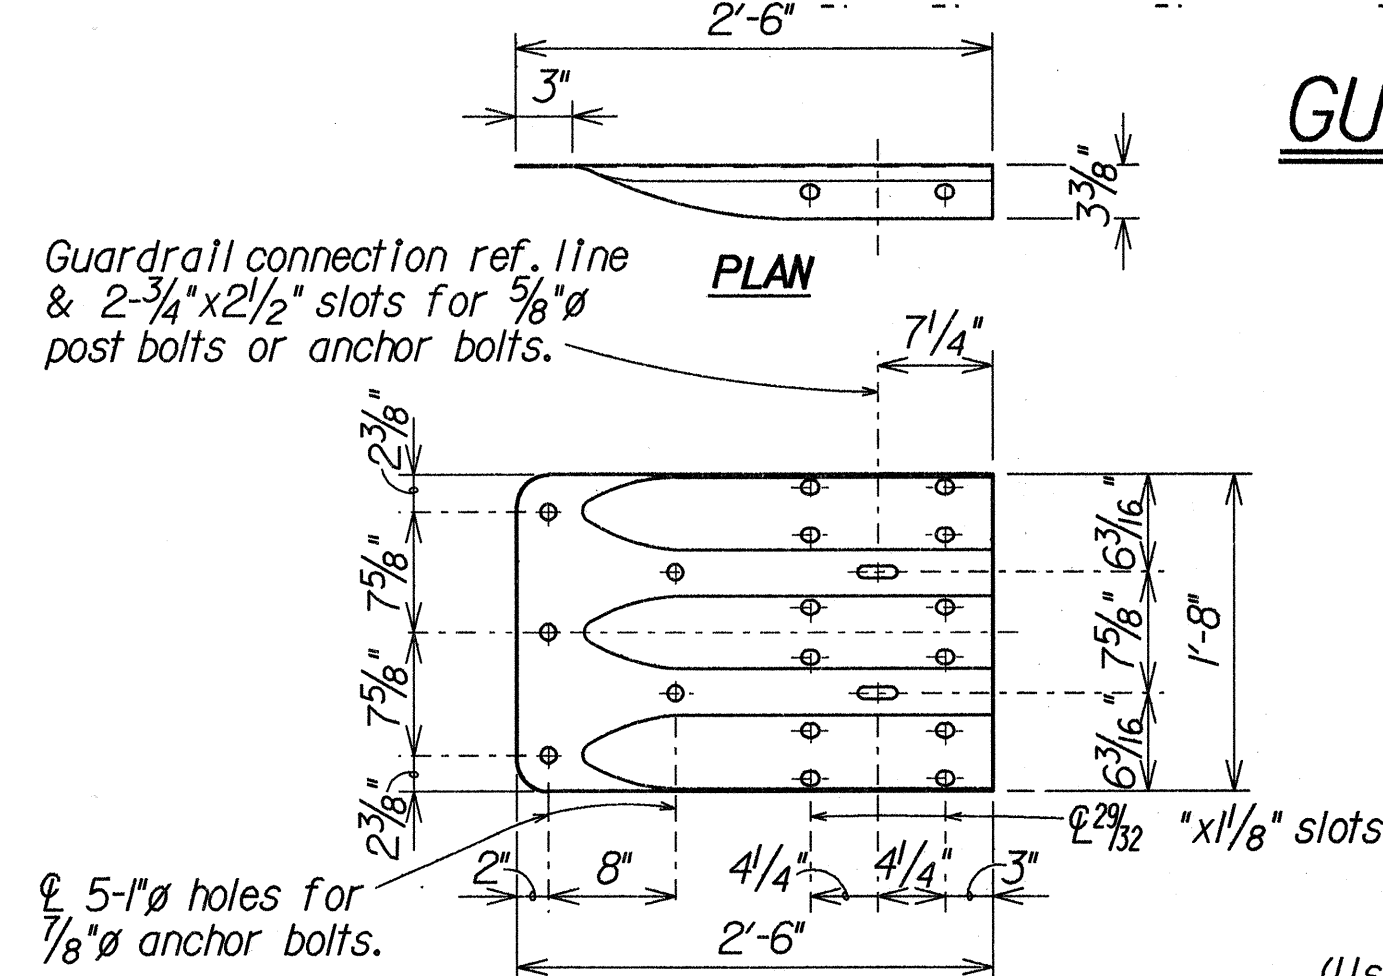


ELEVATION
TERMINAL CONNECTOR

Scale: 1" = 1'-0"

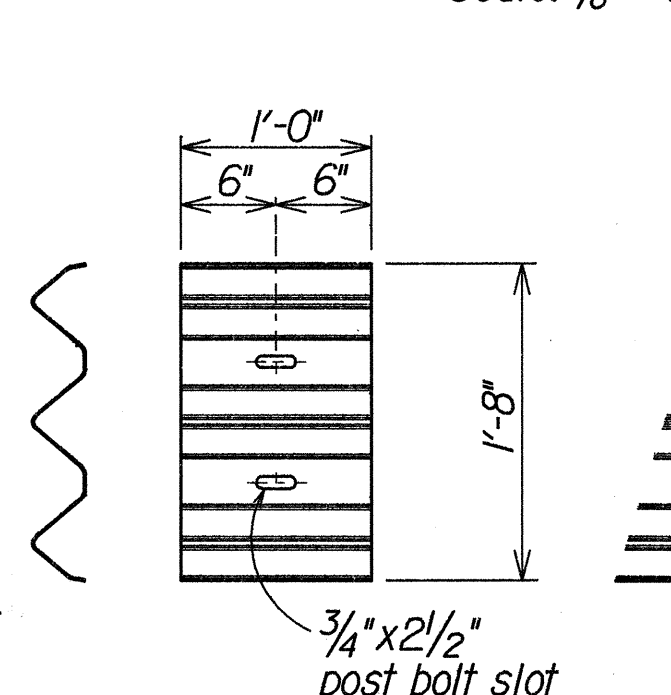


BACKUP PLATE

Scale: 1" = 1'-0"

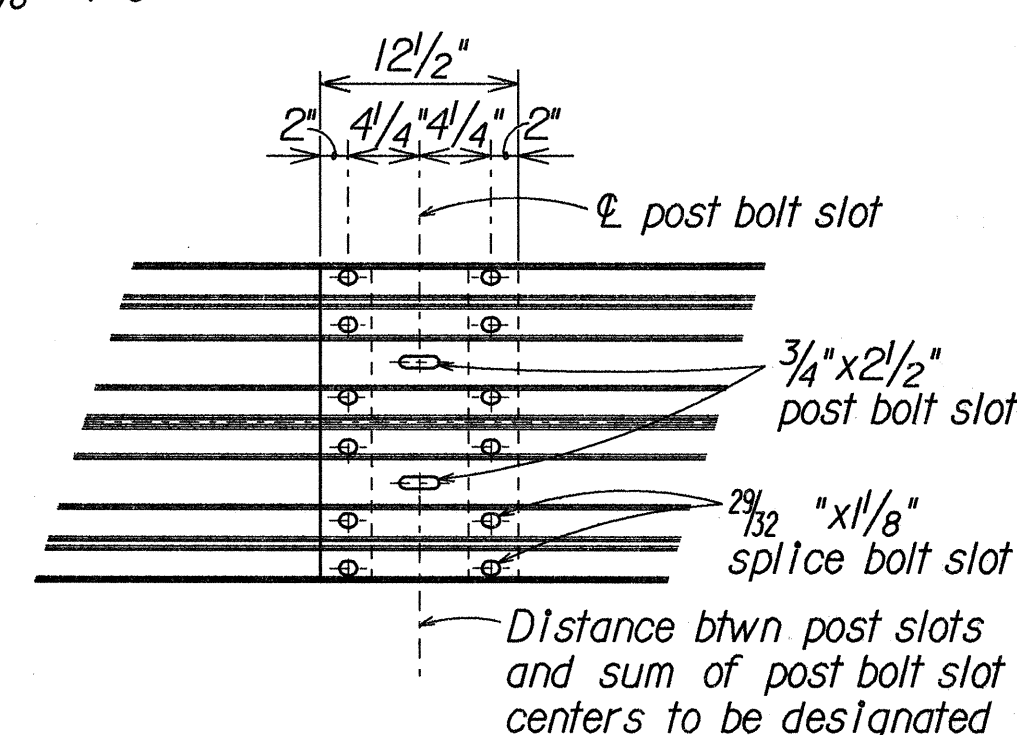


RAIL SPLICE

Scale: 1" = 1'-0"

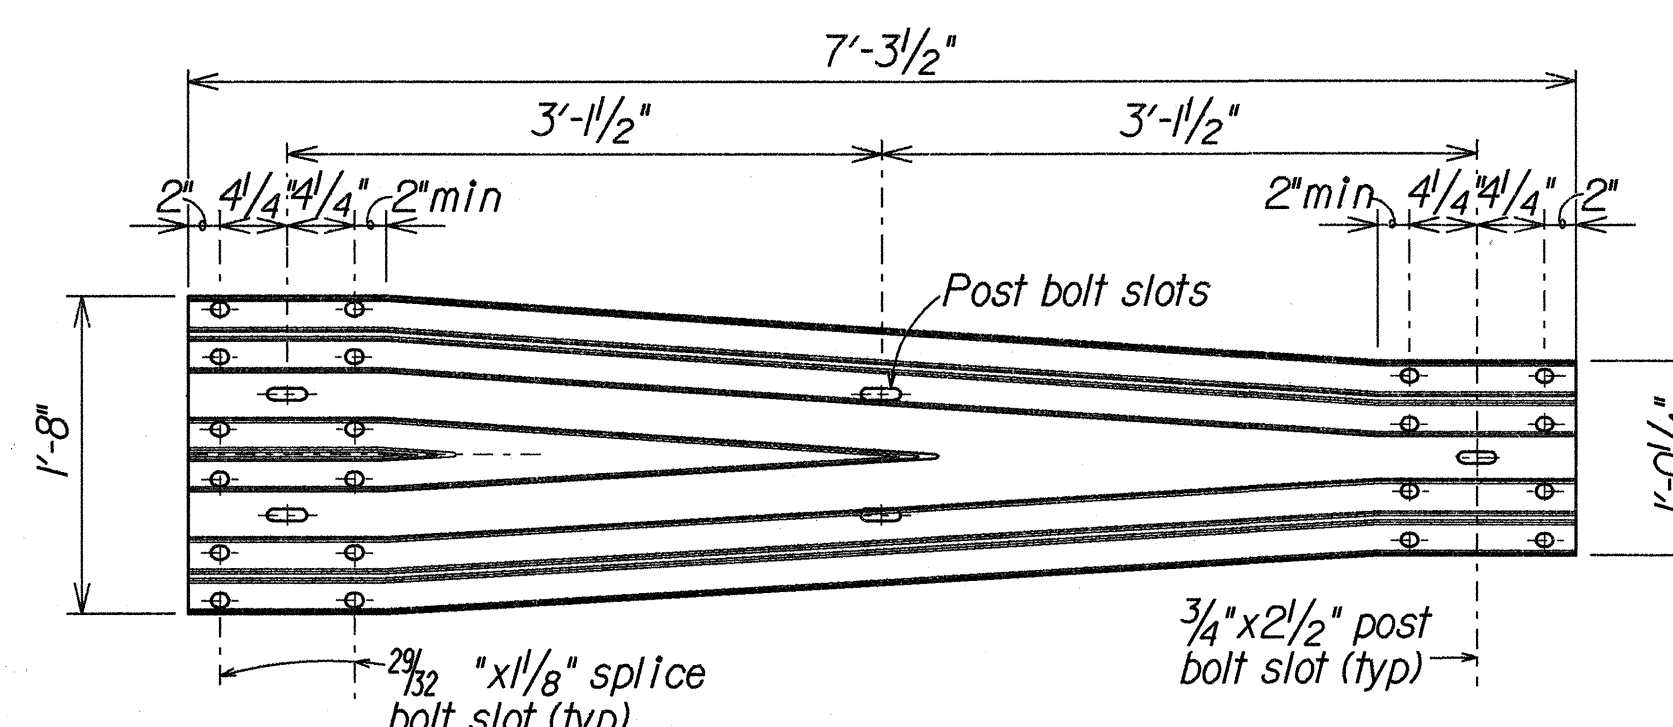


TRANSITION SECTION

Scale: $1'' = 1'-0$

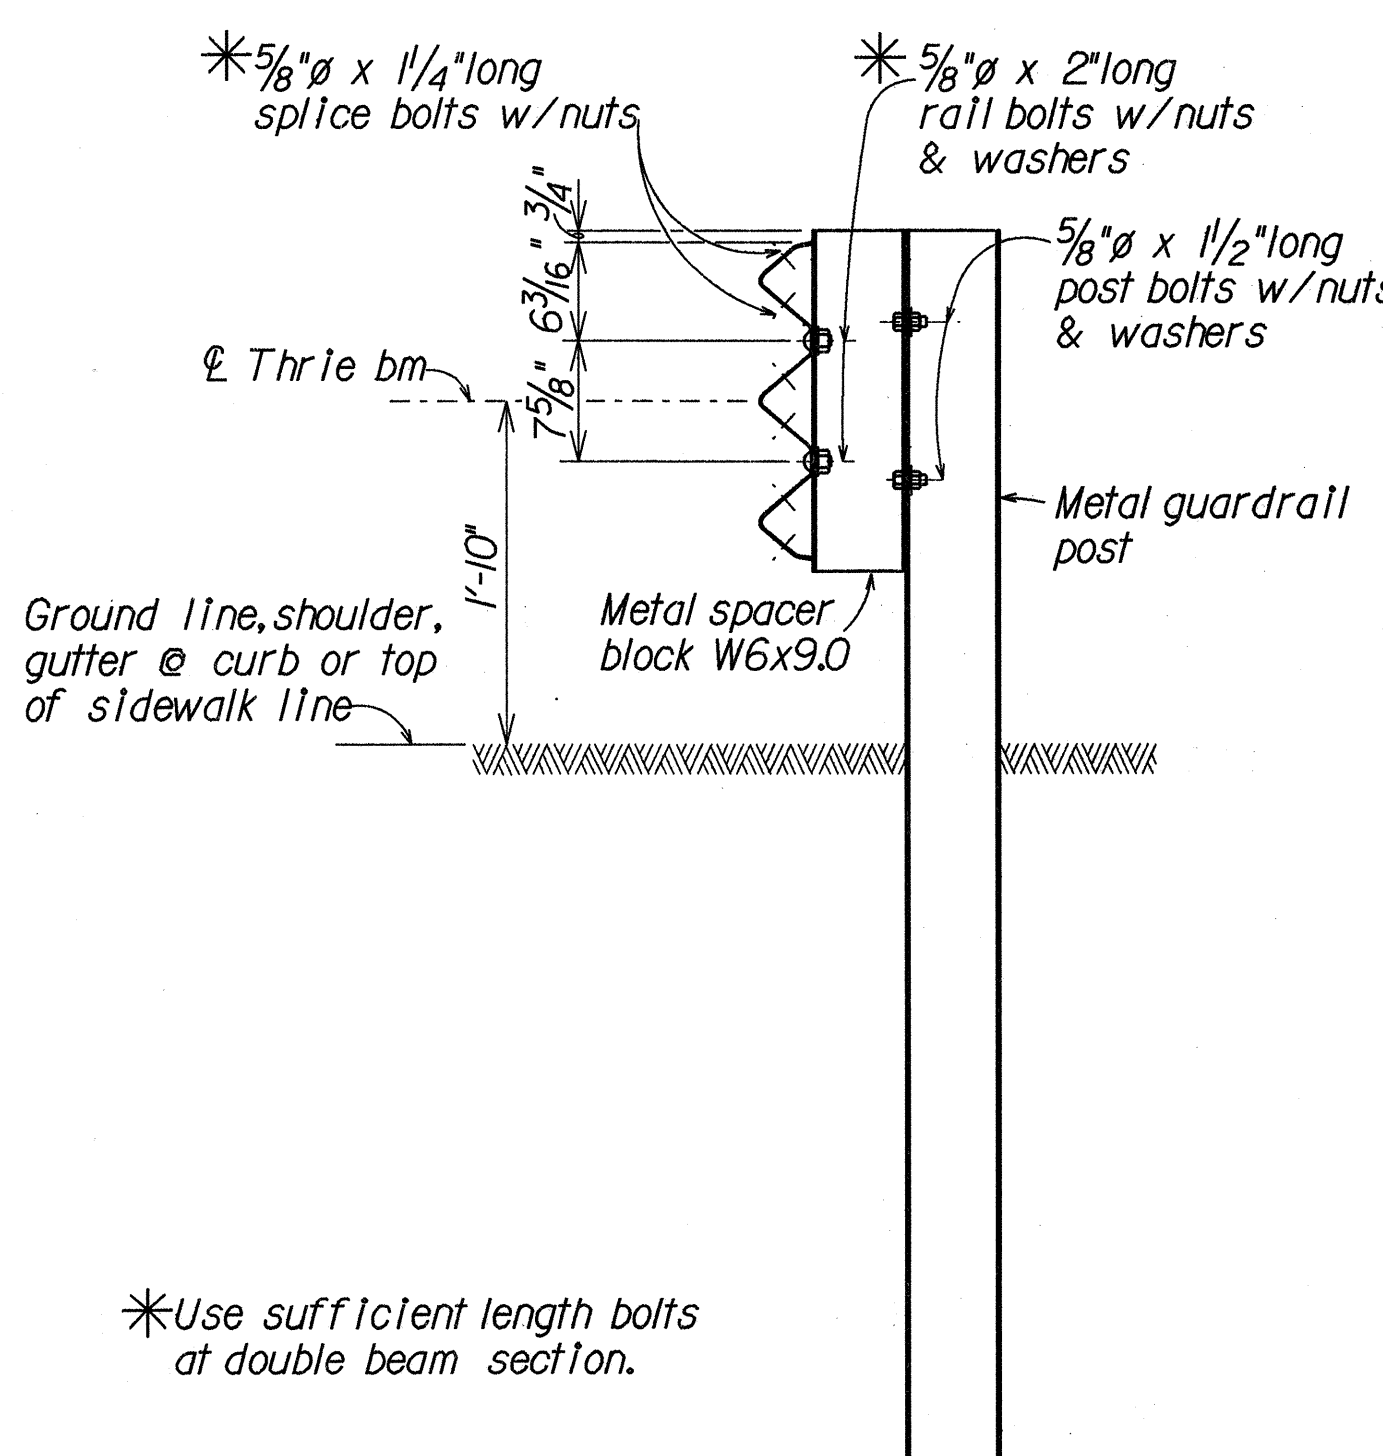


TYPICAL SECTION

METAL GUARDRAIL ON METAL POST
WITH METAL SPACER BLOCK
Scale: 1" = 1'-0"

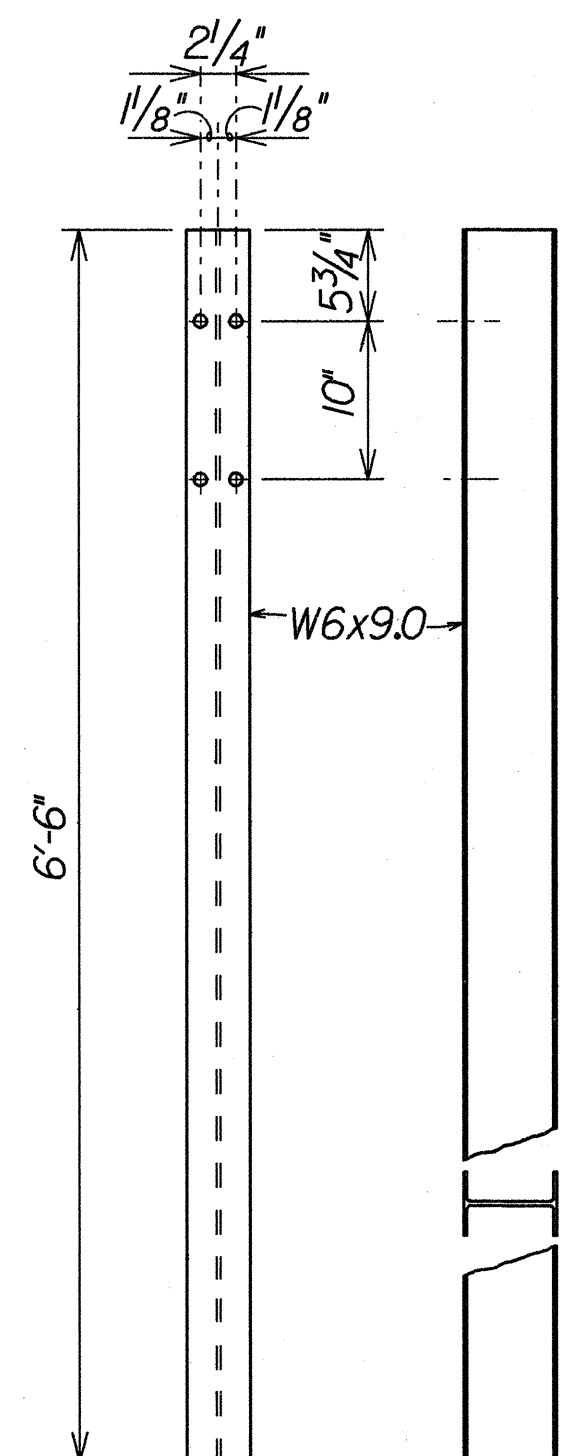

FRONT SIDE


COST DET.
Scale: $1'' = 1'-0''$

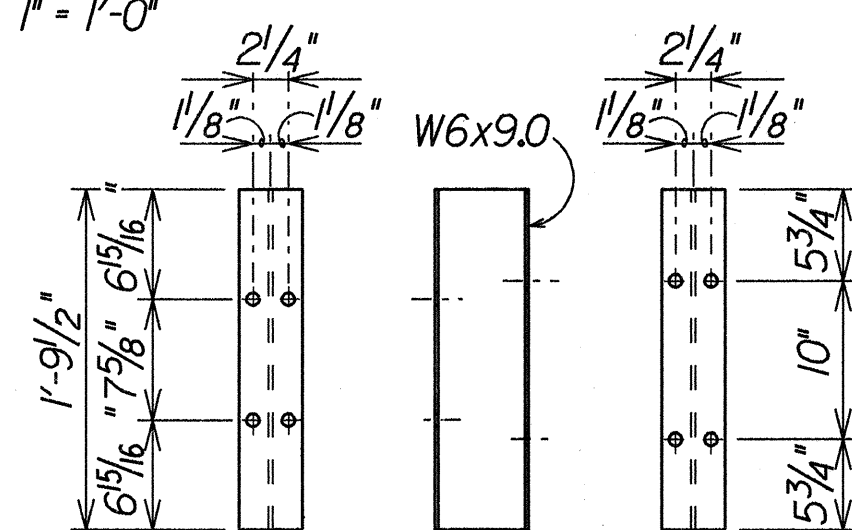


FRONT SIDE REAR

SPACER BLOCK DETAILS

Scale: $1'' = 1'-0''$

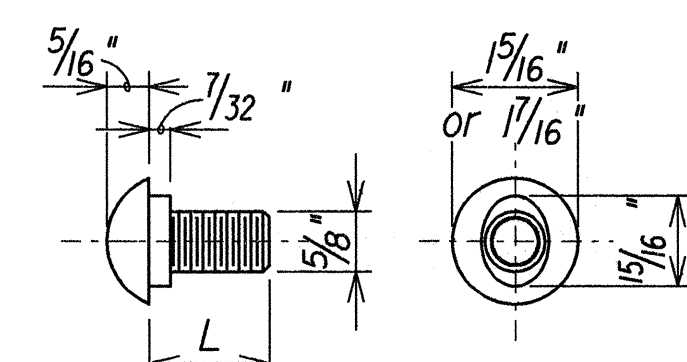


	<i>L</i>	<i>Thread Length</i>
* * *	1 1/4"	Full thread
* *	2"	1 1/2" min. thread length

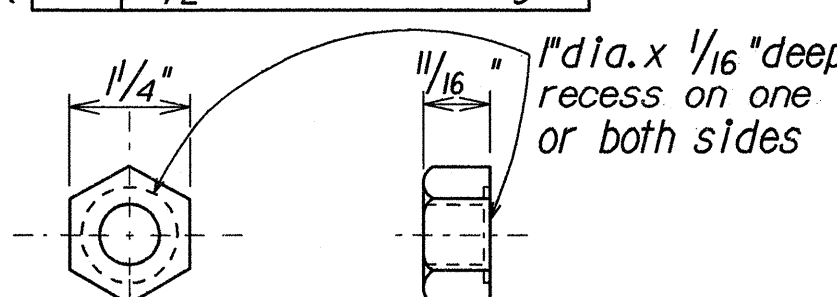


5/8"Ø BUTTON HEAD BOLT
& RECESS NUT

Scale: 6" = 1'-0"

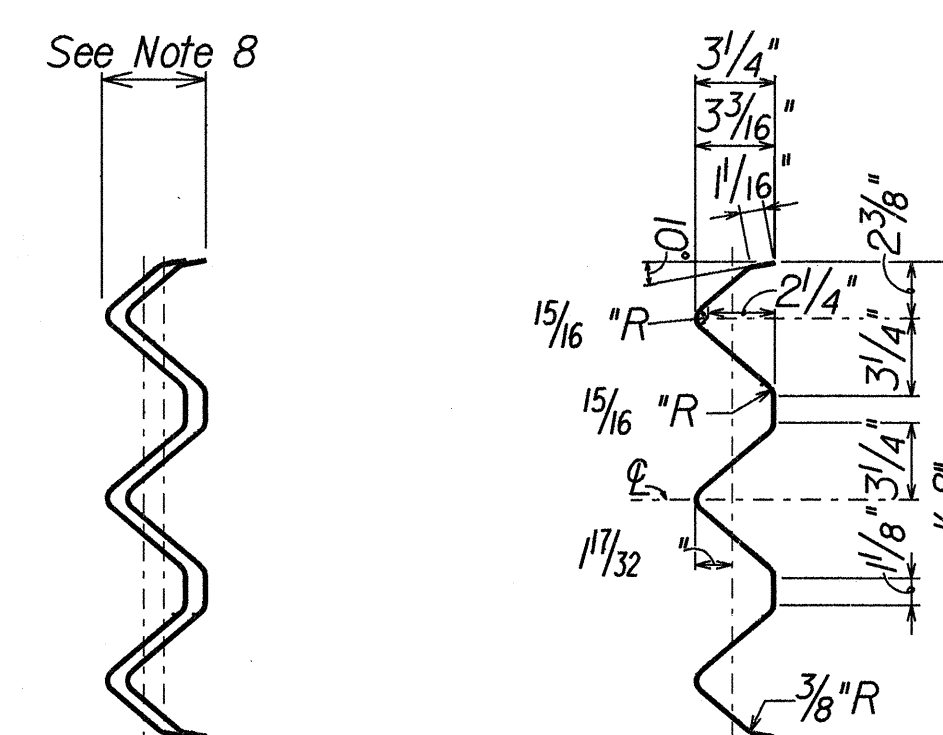


DOUBLE SINGLE
SECTION THRU RAIL ELEMENT

Scale: $1\frac{1}{2}'' = 1'-0''$

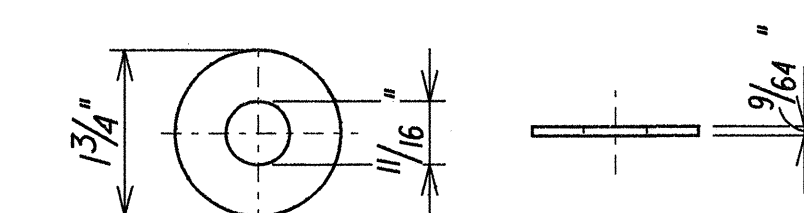

STEEL WASHER FOR $\frac{5}{8}$ "Ø BOLT

Scale: 6" = 1'-0"

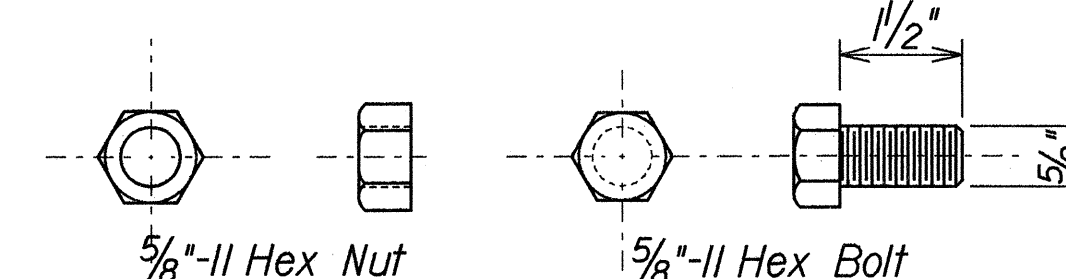

5/8"Ø HEX BOLT & NUT


Scale: 6" = 1'-0"

TYPE 3 THRIE BEAM GUARDRAIL AND APPURTENANCES DETAILS

8-23-89	Change Order for construction of footwalk at Kaunala Bridge.
DATE	REVISION
STATE OF HAWAII DEPARTMENT OF TRANSPORTATION HIGHWAYS DIVISION <u>GUARDRAIL TYPE 3 THRIE BEAM</u> <u>APPURTENANCES AND POST SPACING DETAIL</u> <u>KAMEHAMEHA HIGHWAY</u> <u>BRIDGE REPAIR AND MODIFICATION</u> <u>Project No. 83D-01-89M</u>	
Scale: As Shown	(KAUNALA STREAM BRIDGE)
Date: Apr 11 1986	
SHEET No. 55 OF 5 SHEETS	


C.O. 6S-5

FED. ROAD DIST. NO.	STATE	PROJ. NO.	FISCAL YEAR	SHEET NO.	TOTAL SHEETS
HAWAII	HAW.	83D-01-89M	1990	C0.6S-6	13

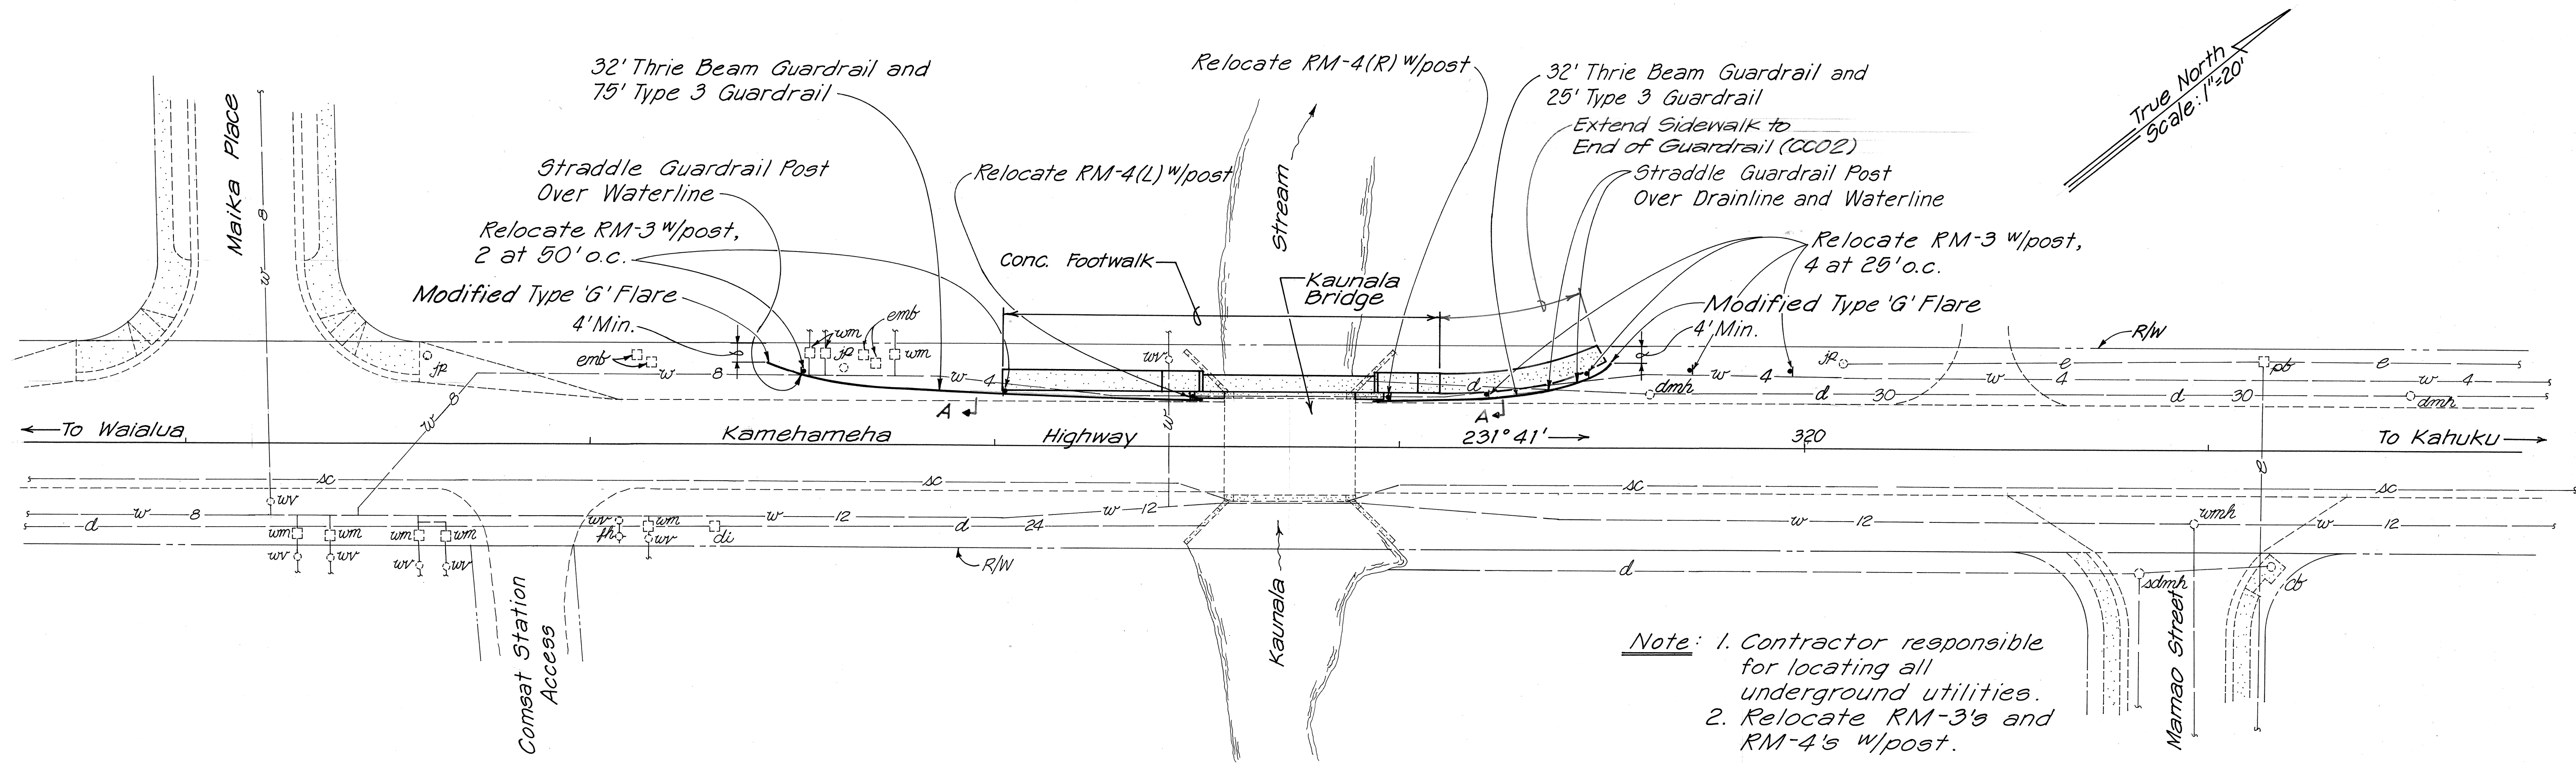

GUARDRAIL LAYOUT PLAN

Scale: 1"=20'

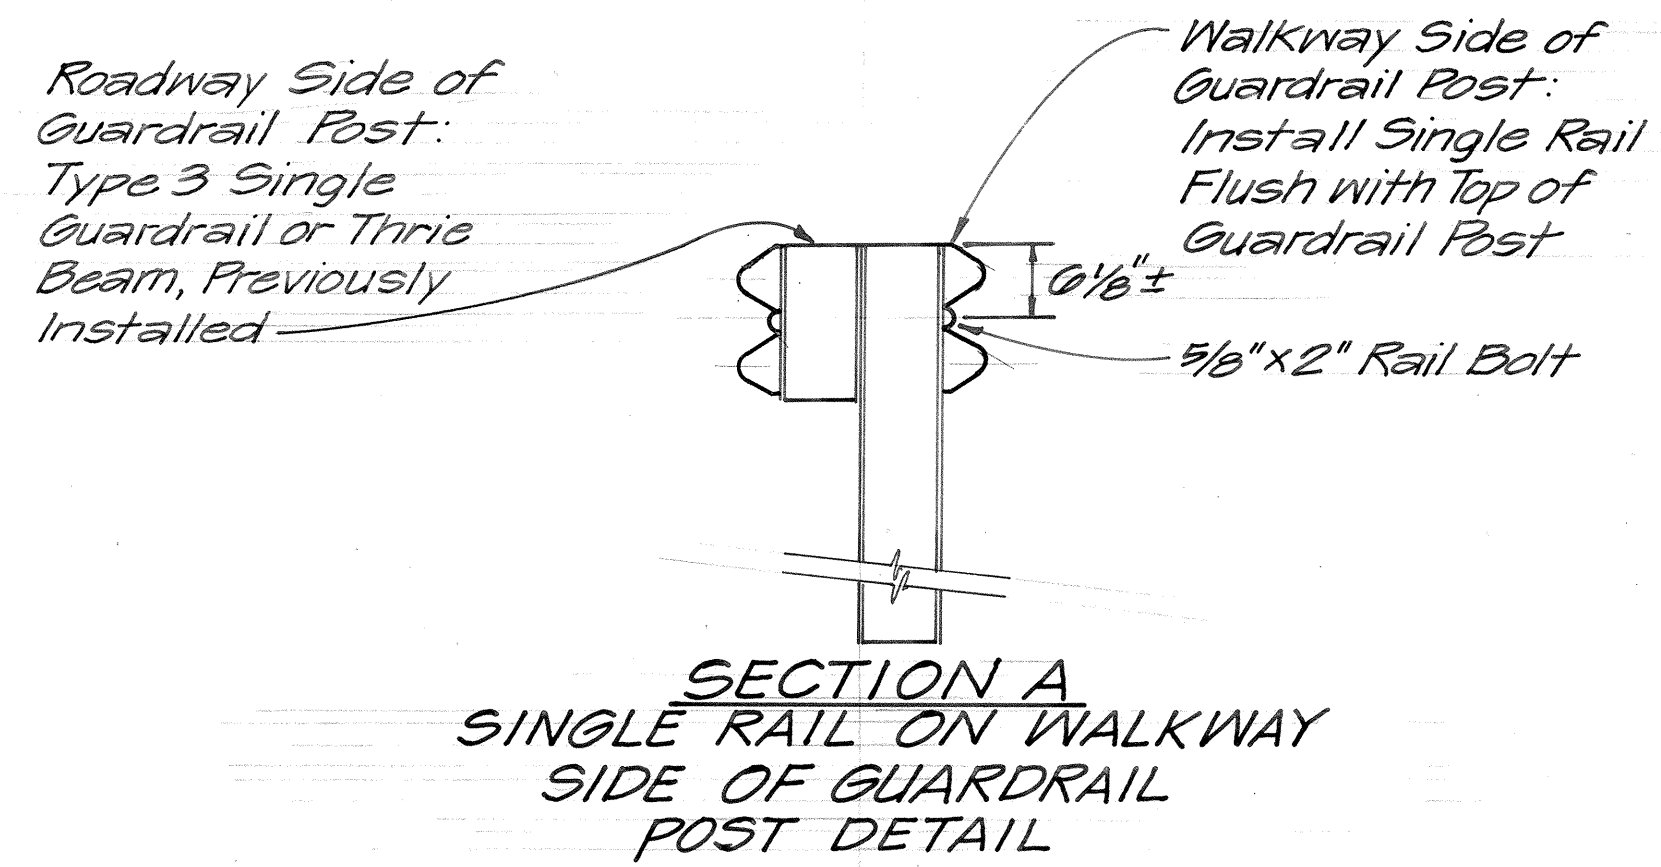

- Notes:
- 1.) See Plan Sheet C0.6S-2 for Typical Sidewalk Cross Section.
 - 2.) Omit Back Plates for Single Rail on Walkway Side of Guardrail Post.

(CCO 2)
Note: This tracing prepared during "As-Built" posting.

8/23/89 Change Order for construction of footwalk at Kaunala Bridge.

DATE REVISION

STATE OF HAWAII
DEPARTMENT OF TRANSPORTATION
HIGHWAYS DIVISION

GUARDRAIL LAYOUT PLAN

KAMEHAMEHA HIGHWAY
BRIDGE REPAIR AND MODIFICATION
Project No. 83D-01-89M
(KAUNALA BRIDGE)

Scale: 1"=20' Date: Aug. 1989

SHEET No. 1 OF 1 SHEETS