	INDEX TO DRAWINGS	
SHEET NO.	DESCRIPTION	
ong the analysis of the second	TITLE SHEET	
2	STANDARD PLANS SUMMARY	
3	GENERAL NOTES AND LEGEND	
4 + 5	TYPICAL SECTIONS AND DETAILS	
6 - 18	ROADWAY PLANS	•
19 - 33	SIGNING AND PAVEMENT MARKING LEGEND, DETAILS, NOTES AND PLANS	
	,	
1		
		Mark II.
Y ARE	SS-I, C.O.33S-2, C.O.33S-3, C.O.33S-2 SUPPLEMENT SHEETS TO THE CONT S: TOTAL = 37	ł, RACT
· · · · · · · · · · · · · · · · · · ·		

MAY, 1989DATE

RICHARD NED BY STATE OF HAWAII

DEPARTMENT OF TRANSPORTATION
HIGHWAYS DIVISION
HONOLULU, HAWAII

"AS BUILT"


PLANS FOR


KAMEHAMEHA HIGHWAY RESURFACING

VICINITY OF WAIALEE BRIDGE TO KAHUKU ELEMENTARY & HIGH SCHOOL

PROJECT NO. 83BC-03-89M

DISTRICT OF KOOLAULOA ISLAND OF OAHU

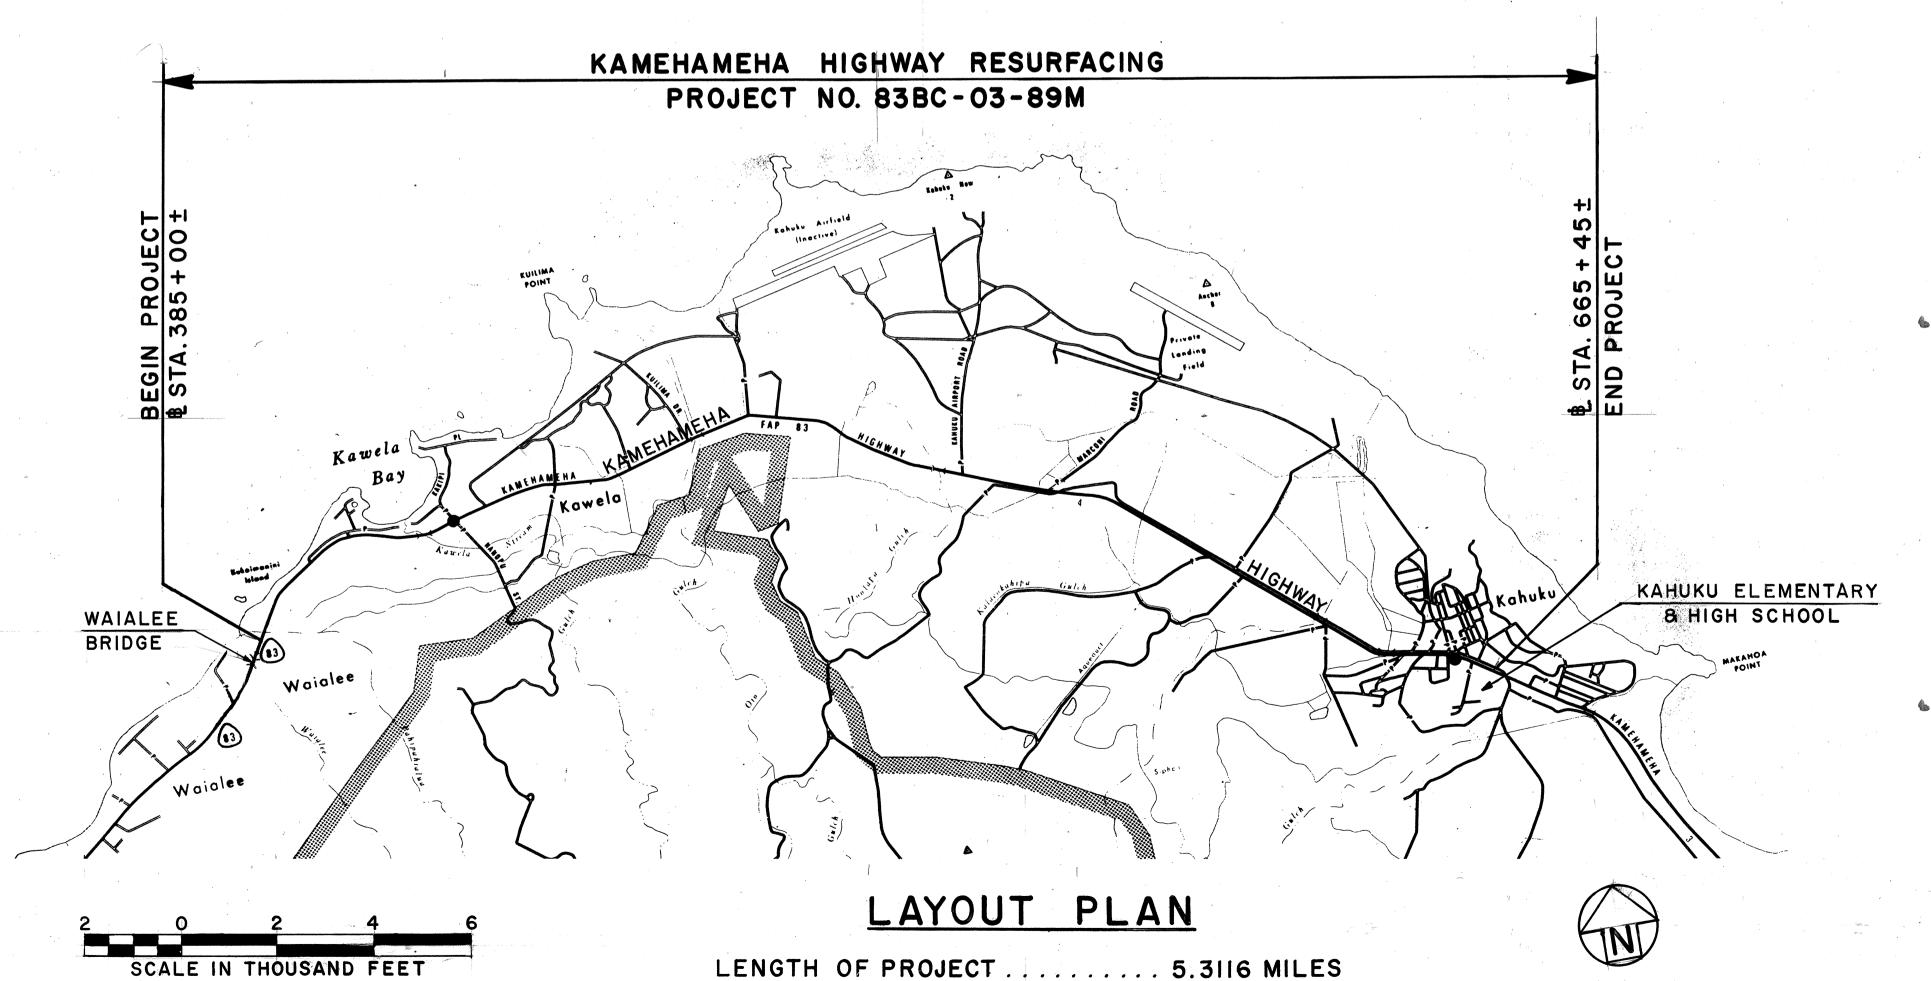

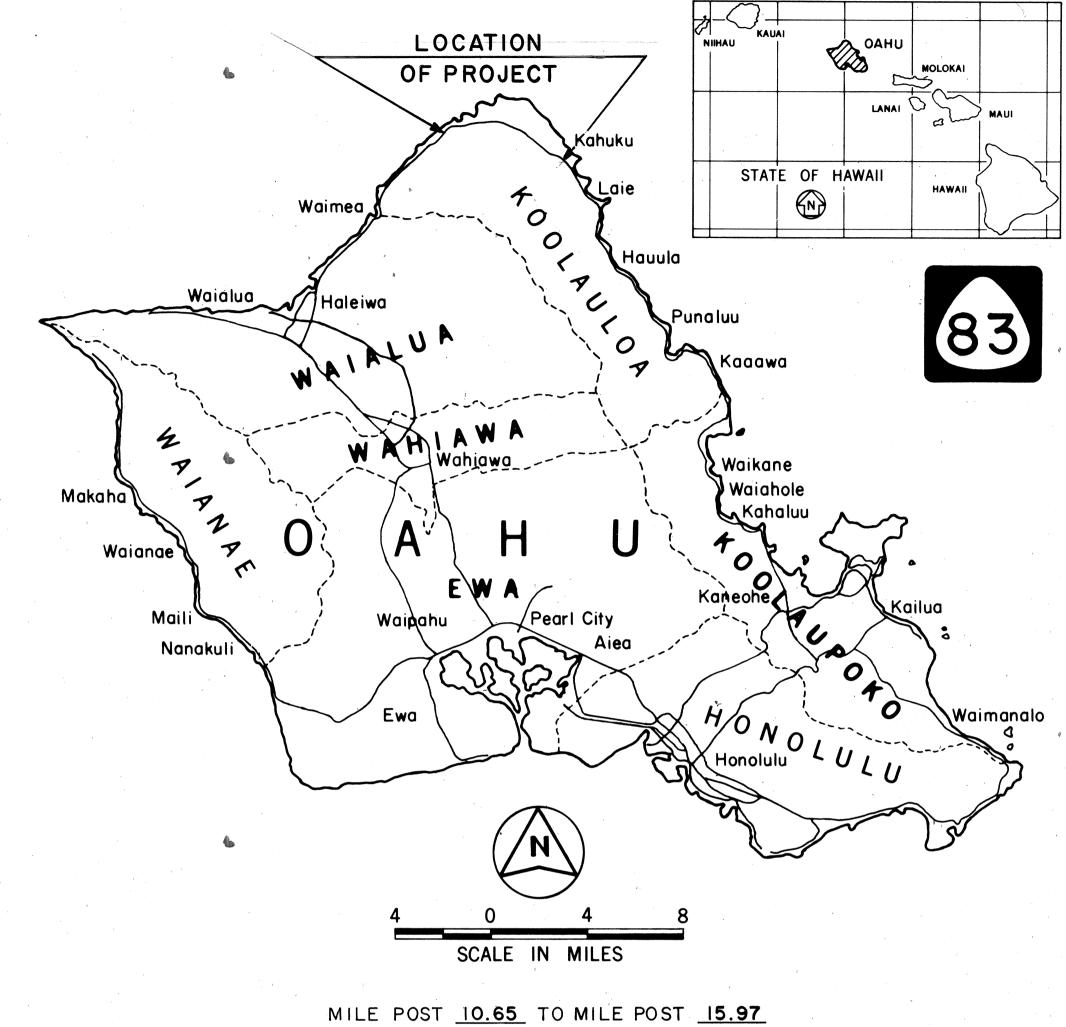

FED. ROAD DIST. NO.

NO SIGNIFICANT CHANGES WERE MADE DURING CONSTRUCTION ON THESE PLANS EXCEPT CHANGES IN THE ORIGINAL THEORETICAL QUANTITIES. FOR ACTUAL QUANTITIES, REFER TO PROJECT LEDGER AND/OR COMPUTATION BOOK.

RESIDENT ENGINEER DATE

DEPARTMENT OF TRANSPORTATION STATE OF HAWAII

APPROVED:

DIR. OF TRANSPORTATION

DATE

FISCAL SHEET TOTAL YEAR NO. SHEETS

PROJ. NO.

83BC-03-89M