

INDEX TO DRAWINGS	
SHEET NO.	DESCRIPTION
1	TITLE SHEET
2	STANDARD PLANS SUMMARY
3	LAYOUT PLAN, LONGITUDINAL SECTION & GENERAL NOTES
4	PART LAYOUT PLAN AND FOOTBRIDGE DETAILS
5	PLAN--FOOTBRIDGE & TYPICAL SECTIONS
6	STRUCTURE EXCAVATION & MISCELLANEOUS DETAILS

STATE OF HAWAII
DEPARTMENT OF TRANSPORTATION
HIGHWAYS DIVISION

"AS-BUILT"
PLANS FOR
KAMEHAMEHA HIGHWAY
WAIMANANA BRIDGE PEDESTRIAN WALKWAY
PROJECT NO. 83D-02-89

DISTRICT OF KOOLAULOA
ISLAND OF OAHU



NO SIGNIFICANT CHANGES WERE MADE DURING
CONSTRUCTION ON THESE PLANS EXCEPT CHANGES
IN THE ORIGINAL THEORETICAL QUANTITIES. FOR
ACTUAL QUANTITIES, REFER TO PROJECT LEDGER
AND/OR COMPUTATION BOOK.

for


RESIDENT ENGINEER

DATE

11/26/01

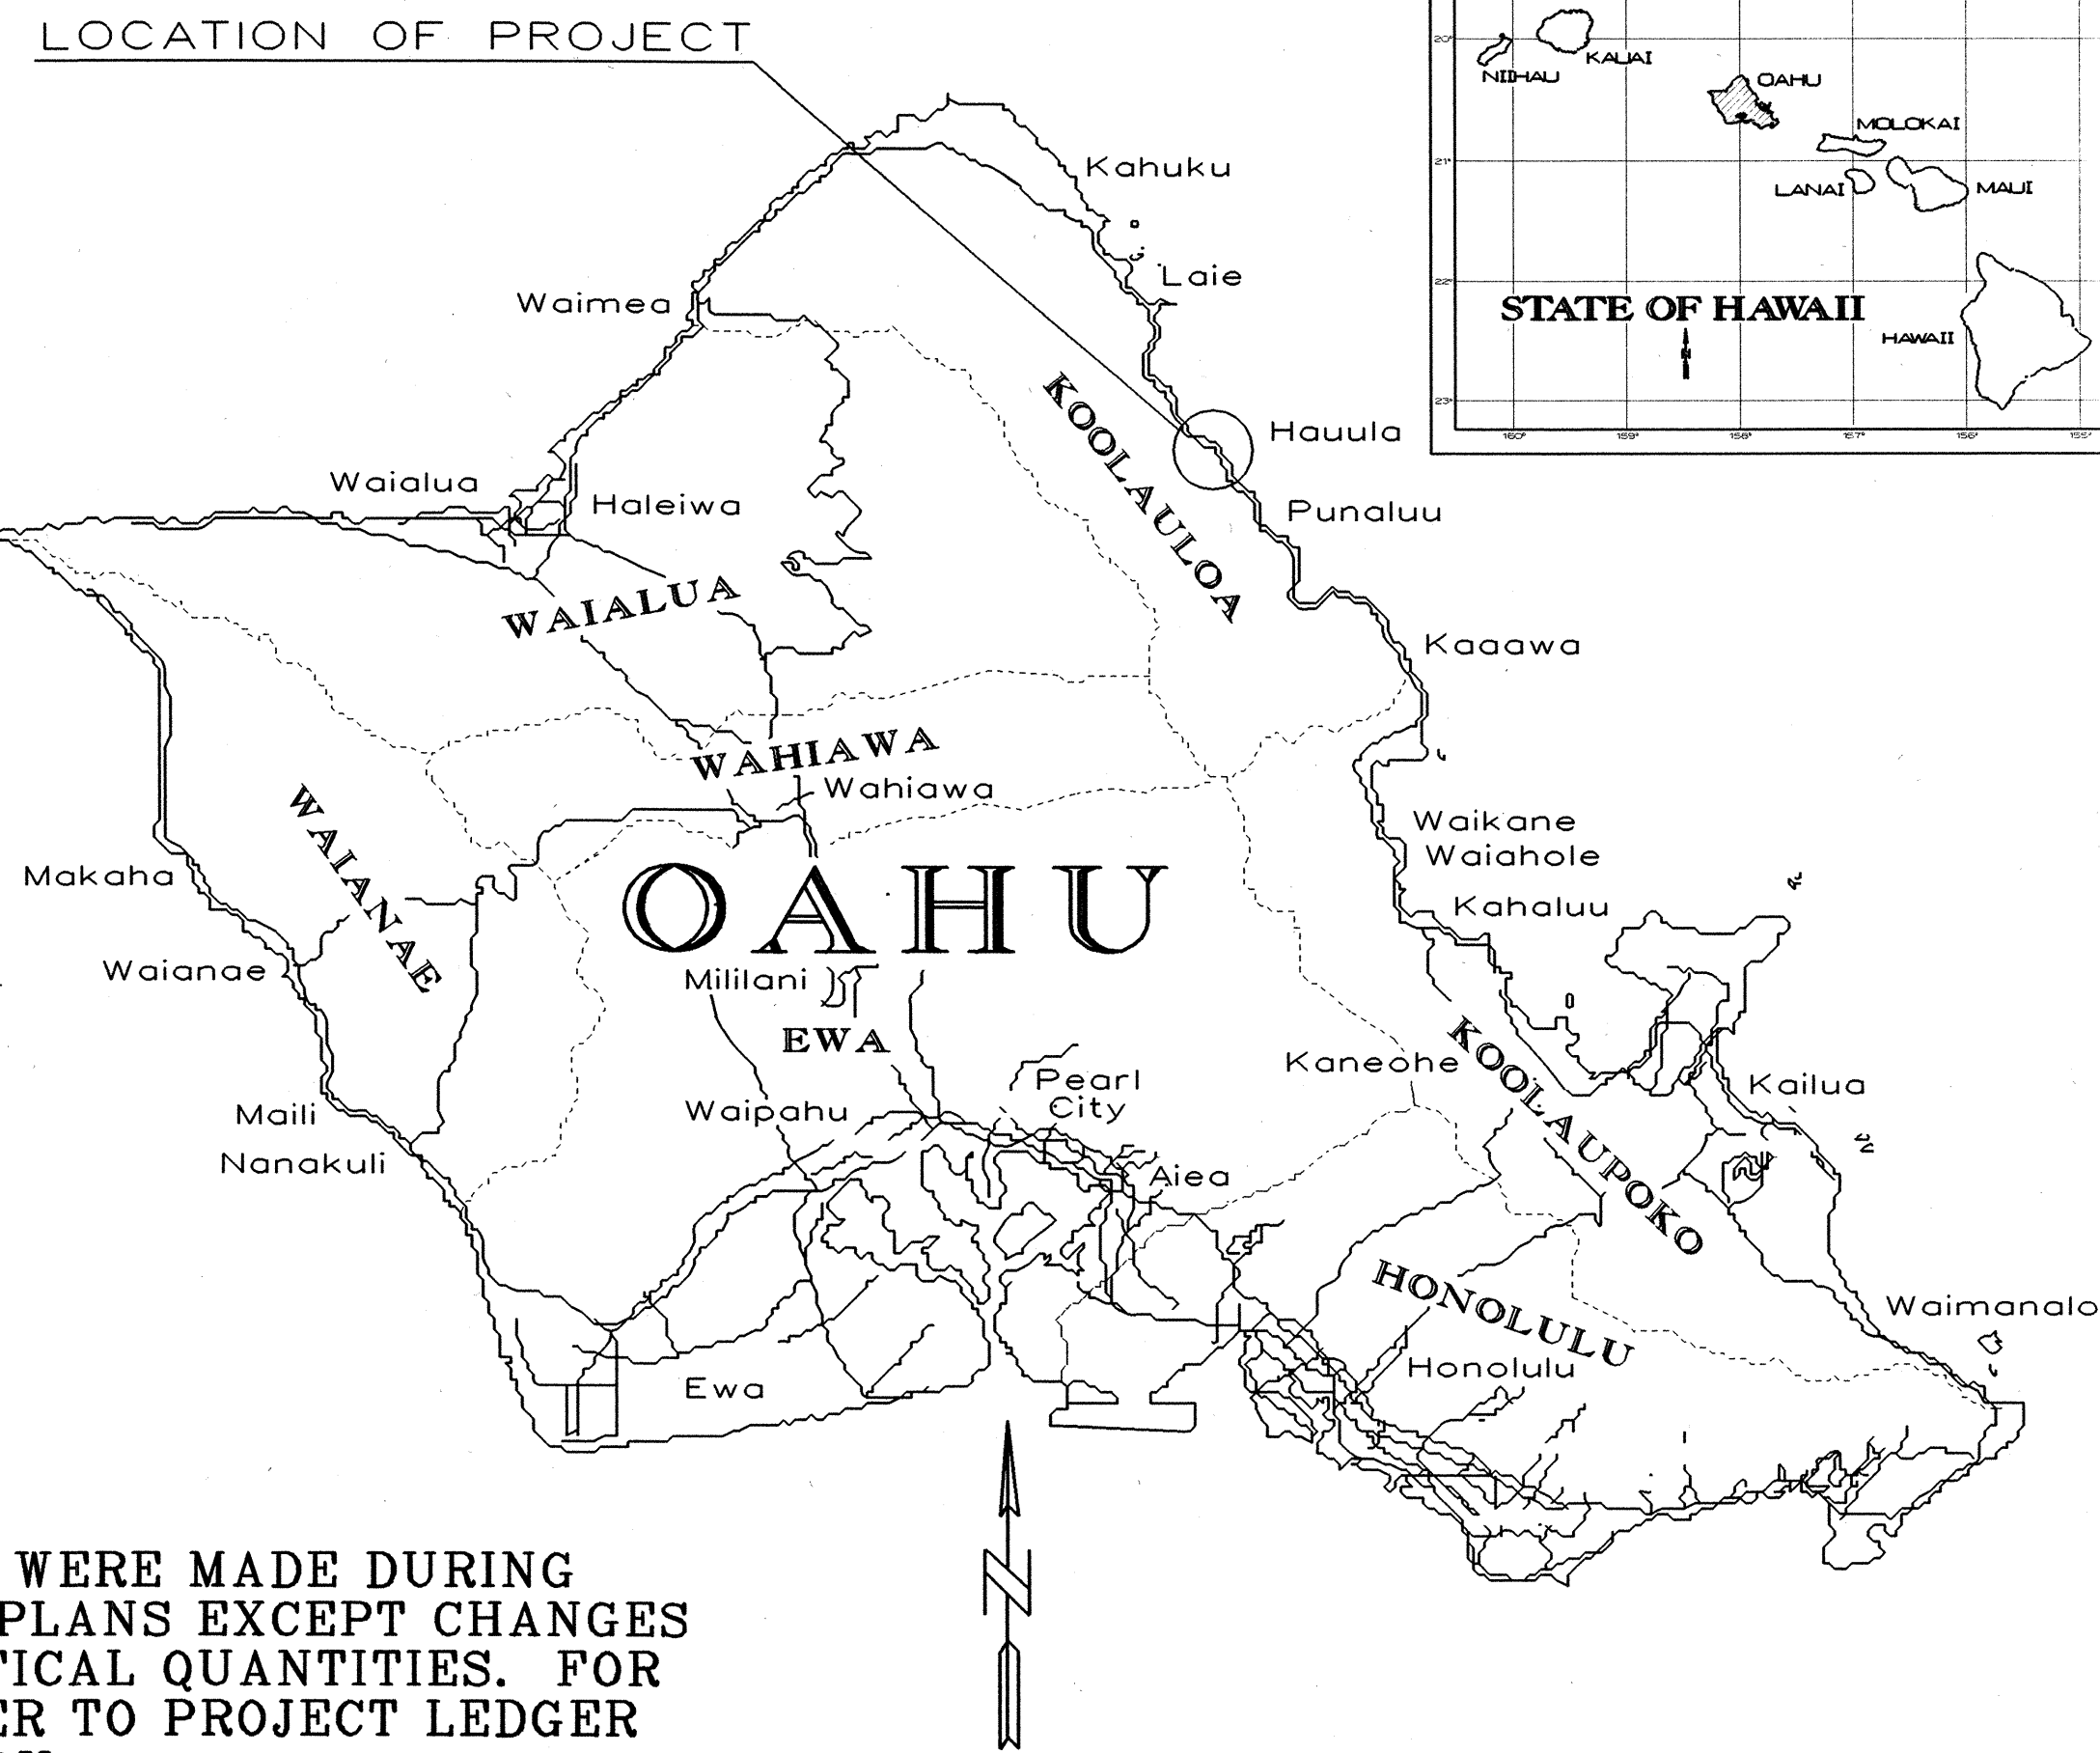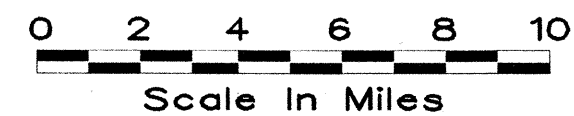

FED. ROAD DIST. NO.	STATE	PROJ. NO.	FISCAL YEAR	SHEET NO.	TOTAL SHEETS
HAWAII	HAW.	83D-02-89	1990	1	6

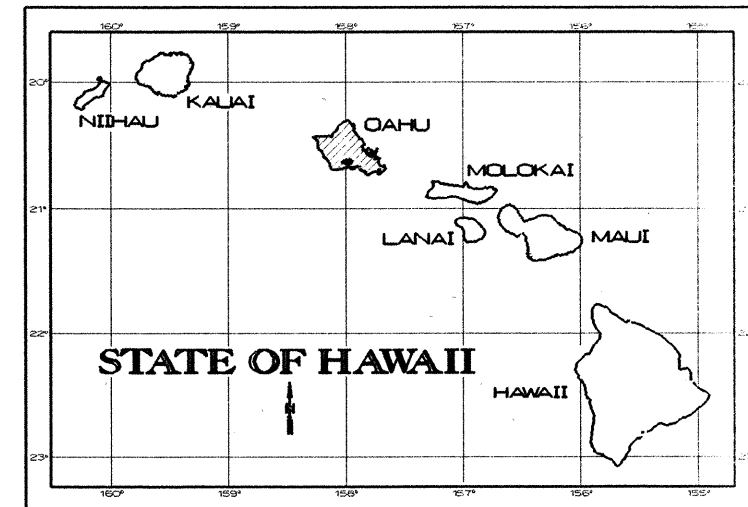

PROJECT SITE
PROJ. NO. 83D-02-89
(Waimanana Bridge
0.02Mi. South of Pokiwa Pl.)

ORIGINAL PLAN	DESIGNED BY	DATE
NOTE BOOK	TRACED BY	SEP 1989
N. 1010	QUANTITIES BY	SEP 1989
	CHECKED BY	SEP 1989

HWY-DB

DESIGNED BY

PHONE: 548-7535

UNIT A

P. S. & E. BY

HWY-DD

PHONE

548-4125

SEPT 1989

DATE

DEPARTMENT OF TRANSPORTATION STATE OF HAWAII	
APPROVED:	
<i>Edmund L. ...</i>	12/5/99
DIRECTOR OF TRANSPORTATION	DATE

"AS-BUILT"