

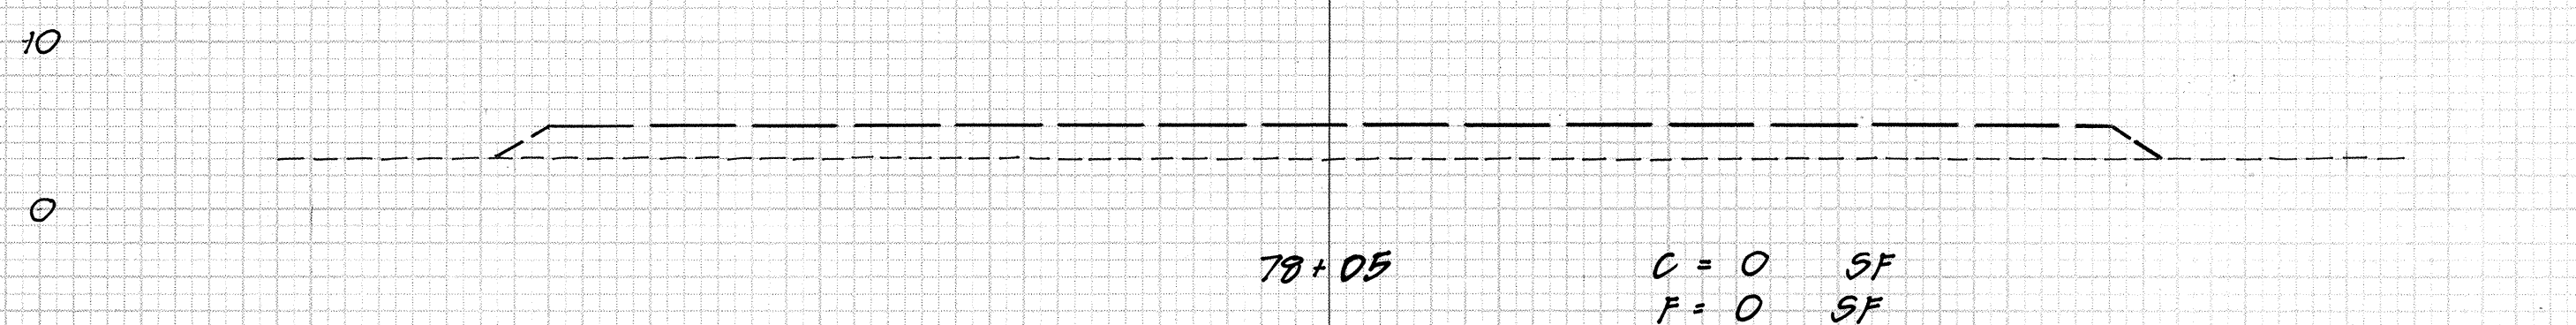
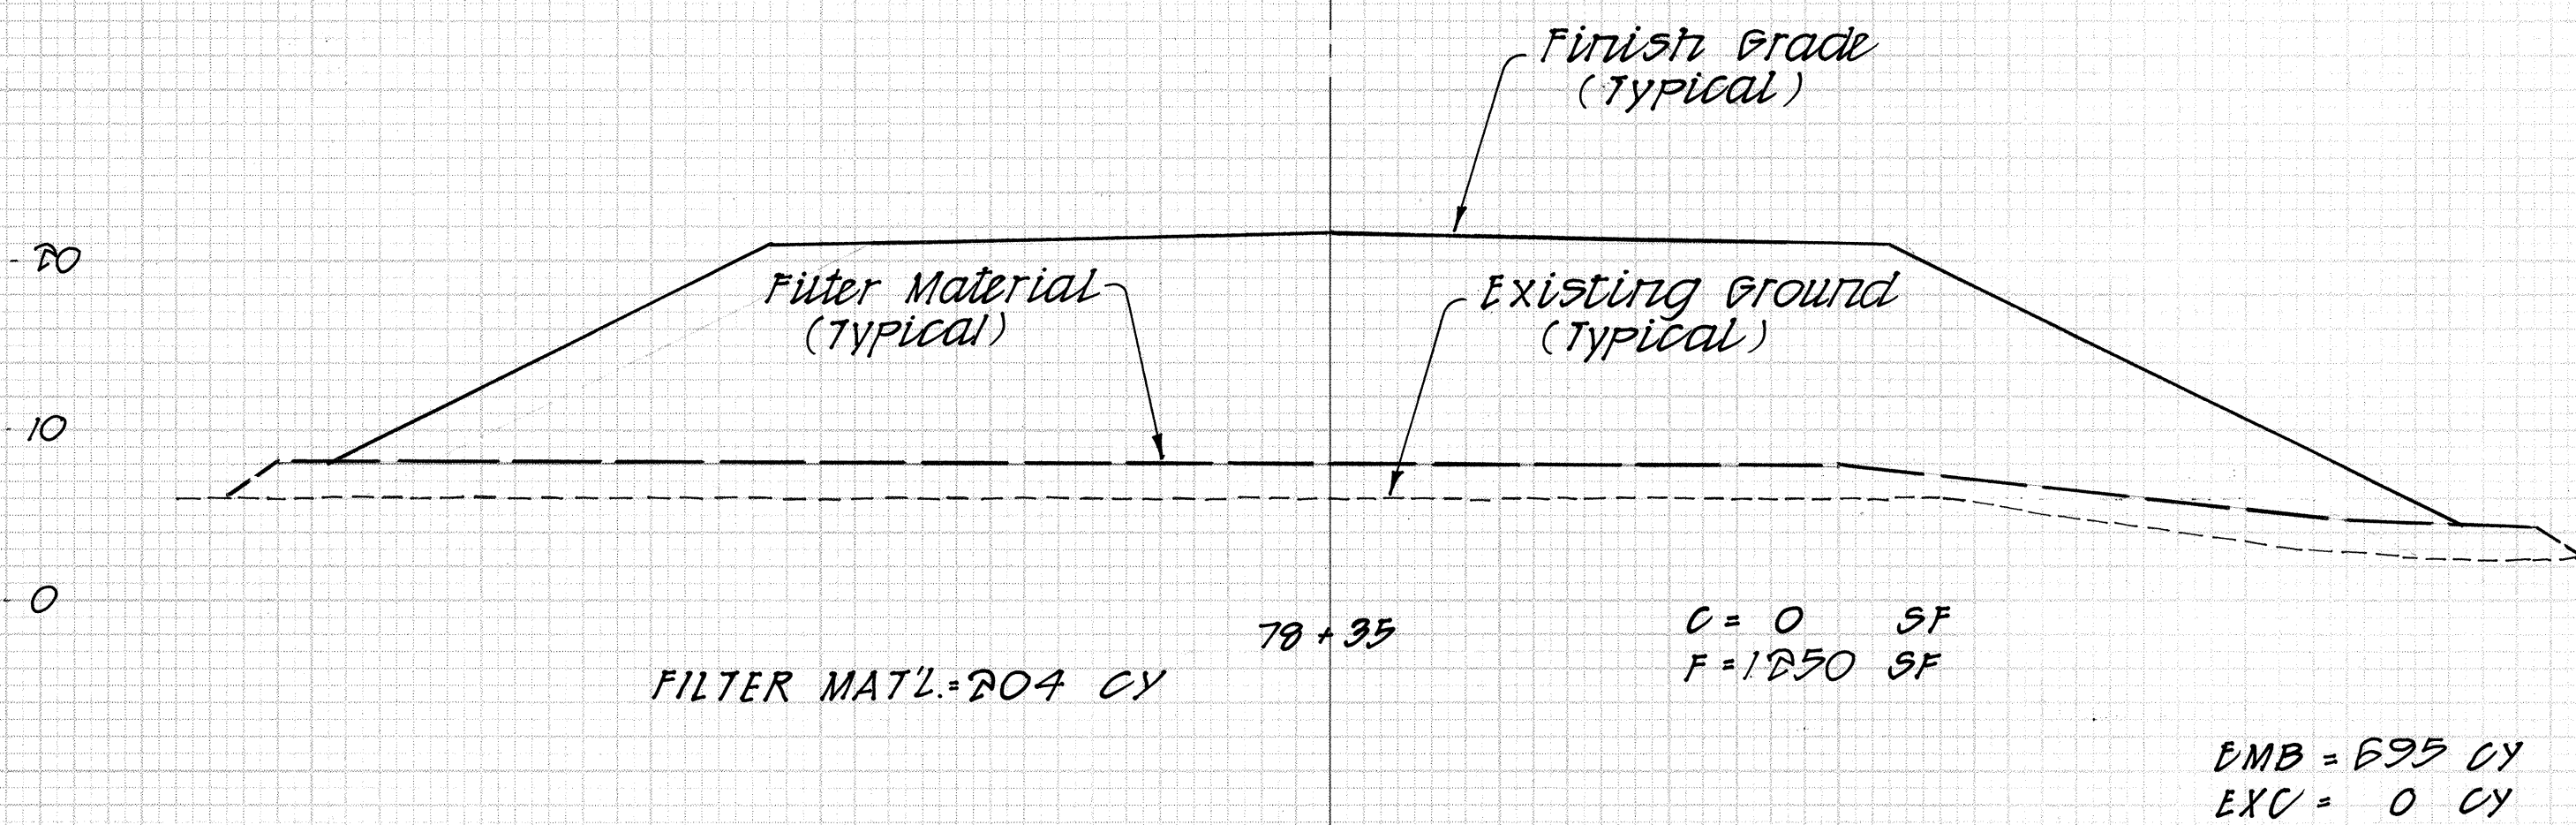
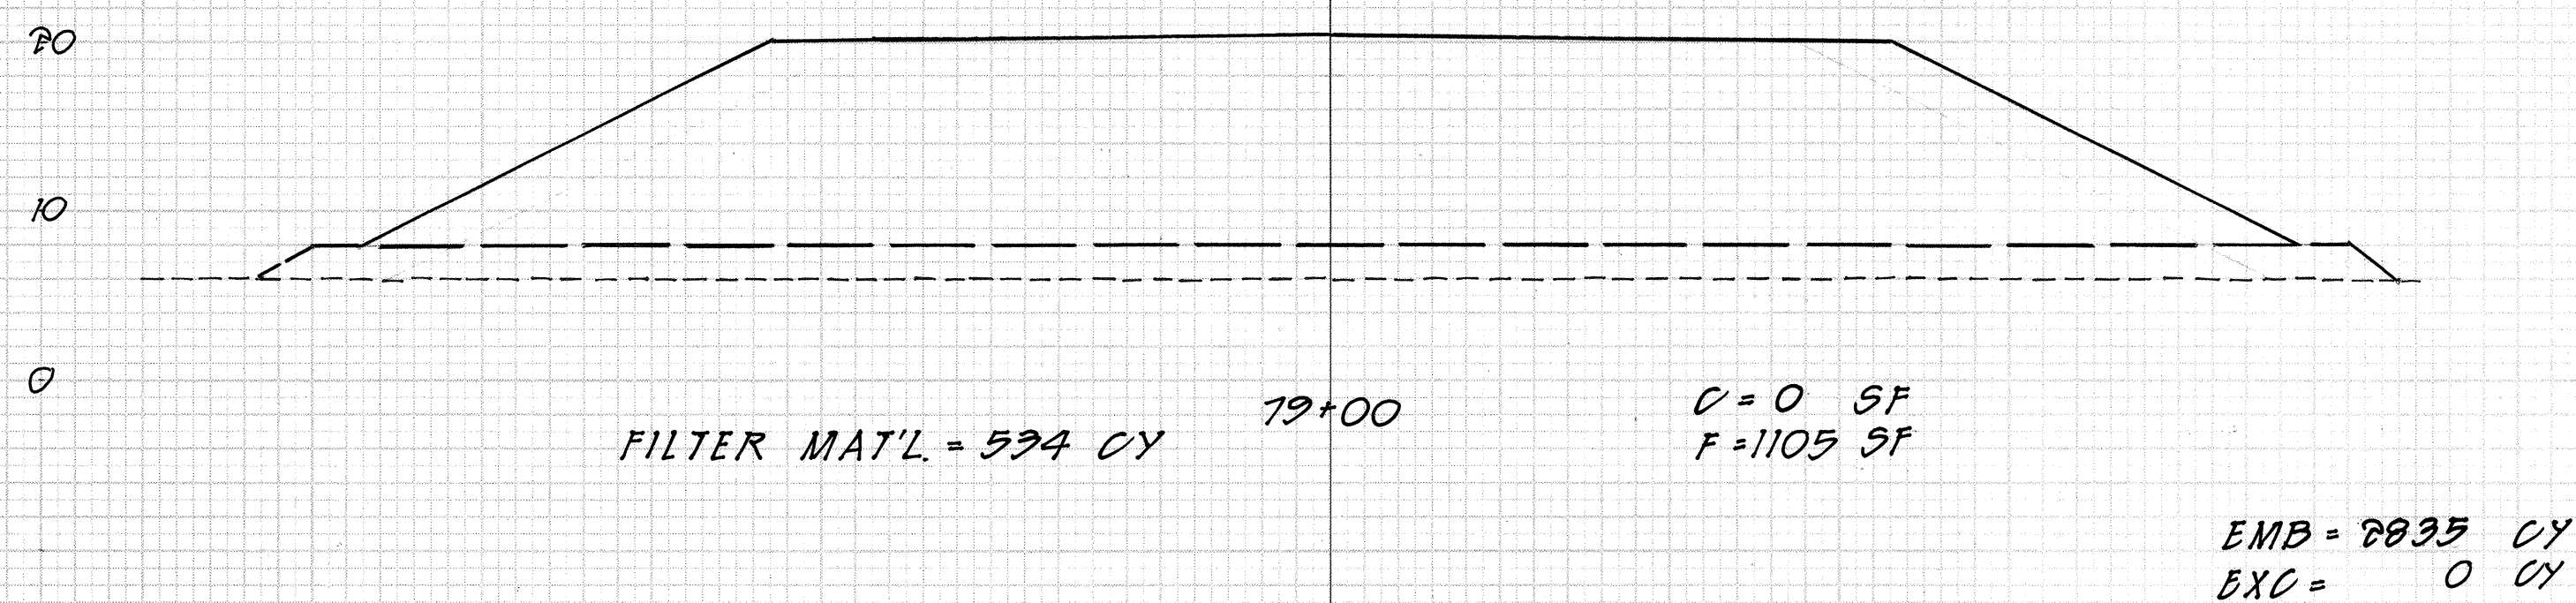


FED. ROAD DIST. NO.	STATE	STATE PROJ. NO.	FISCAL YEAR	SHEET NO.	TOTAL SHEETS
HAWAII	HAW.	83A-01-90	1990	7	9




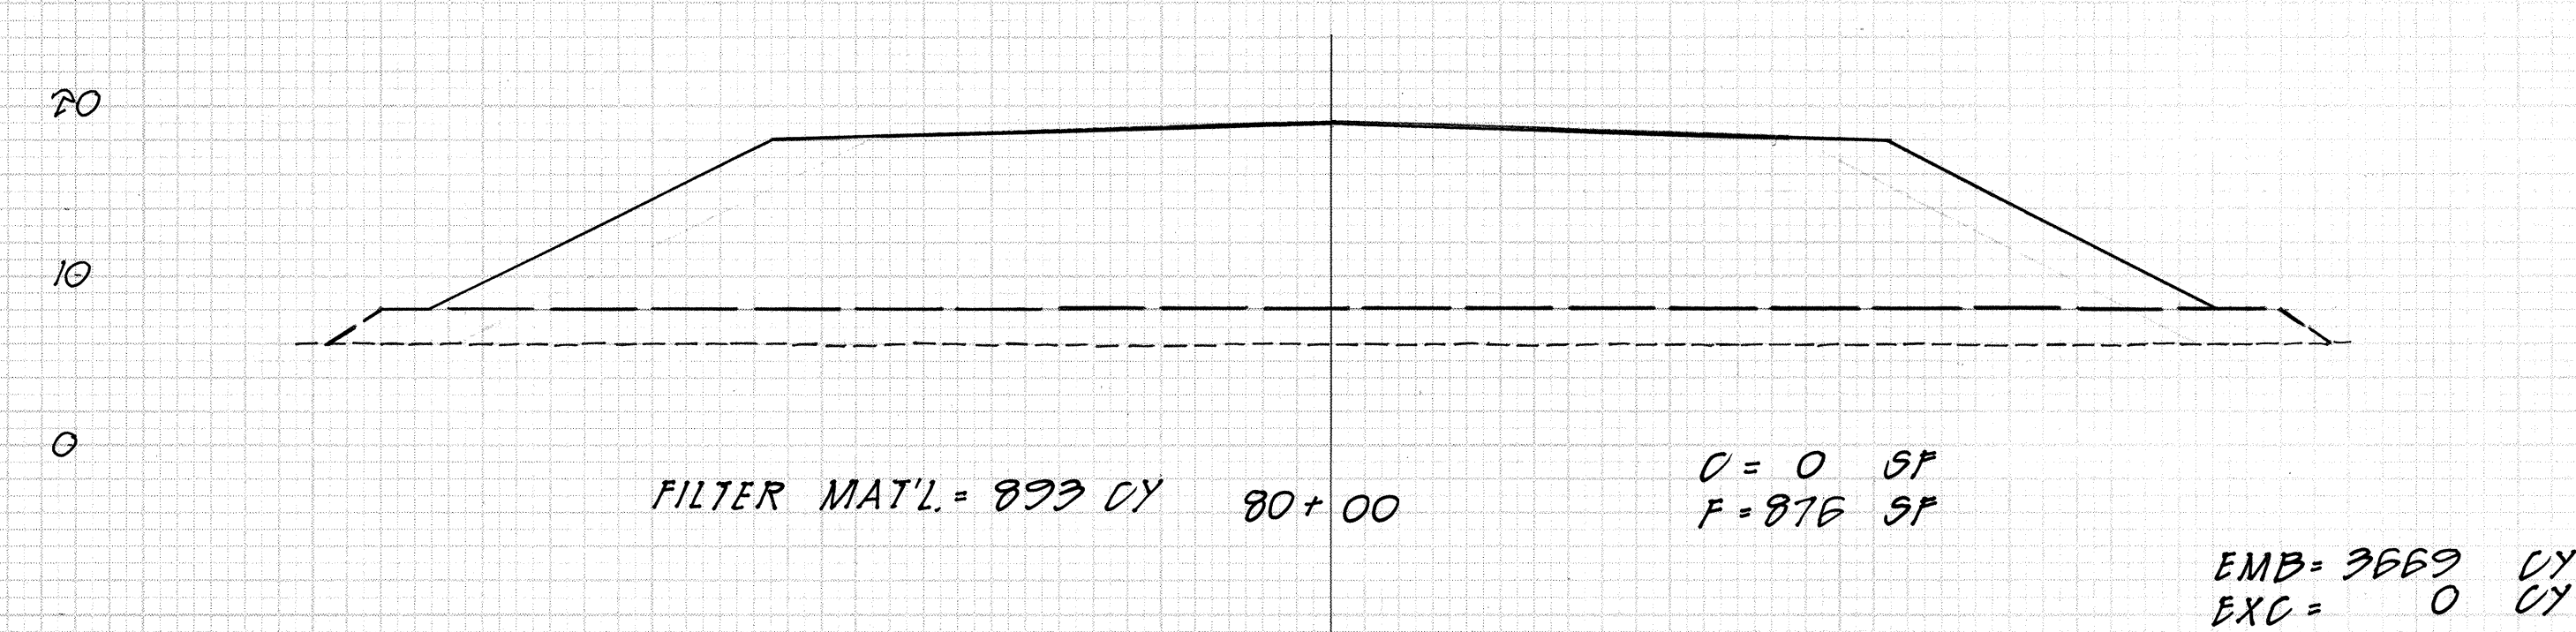


ANAHULU STREAM
ABUTMENT AREA

Scale: Horiz: 1" = 10'
Vert: 1" = 10'

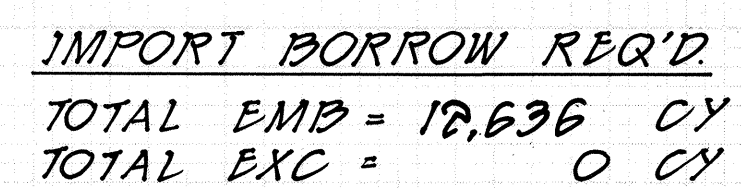

FILTER MATERIAL REQ'D.
3,412 CY

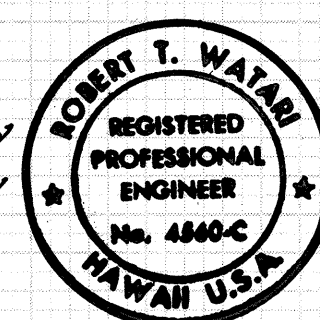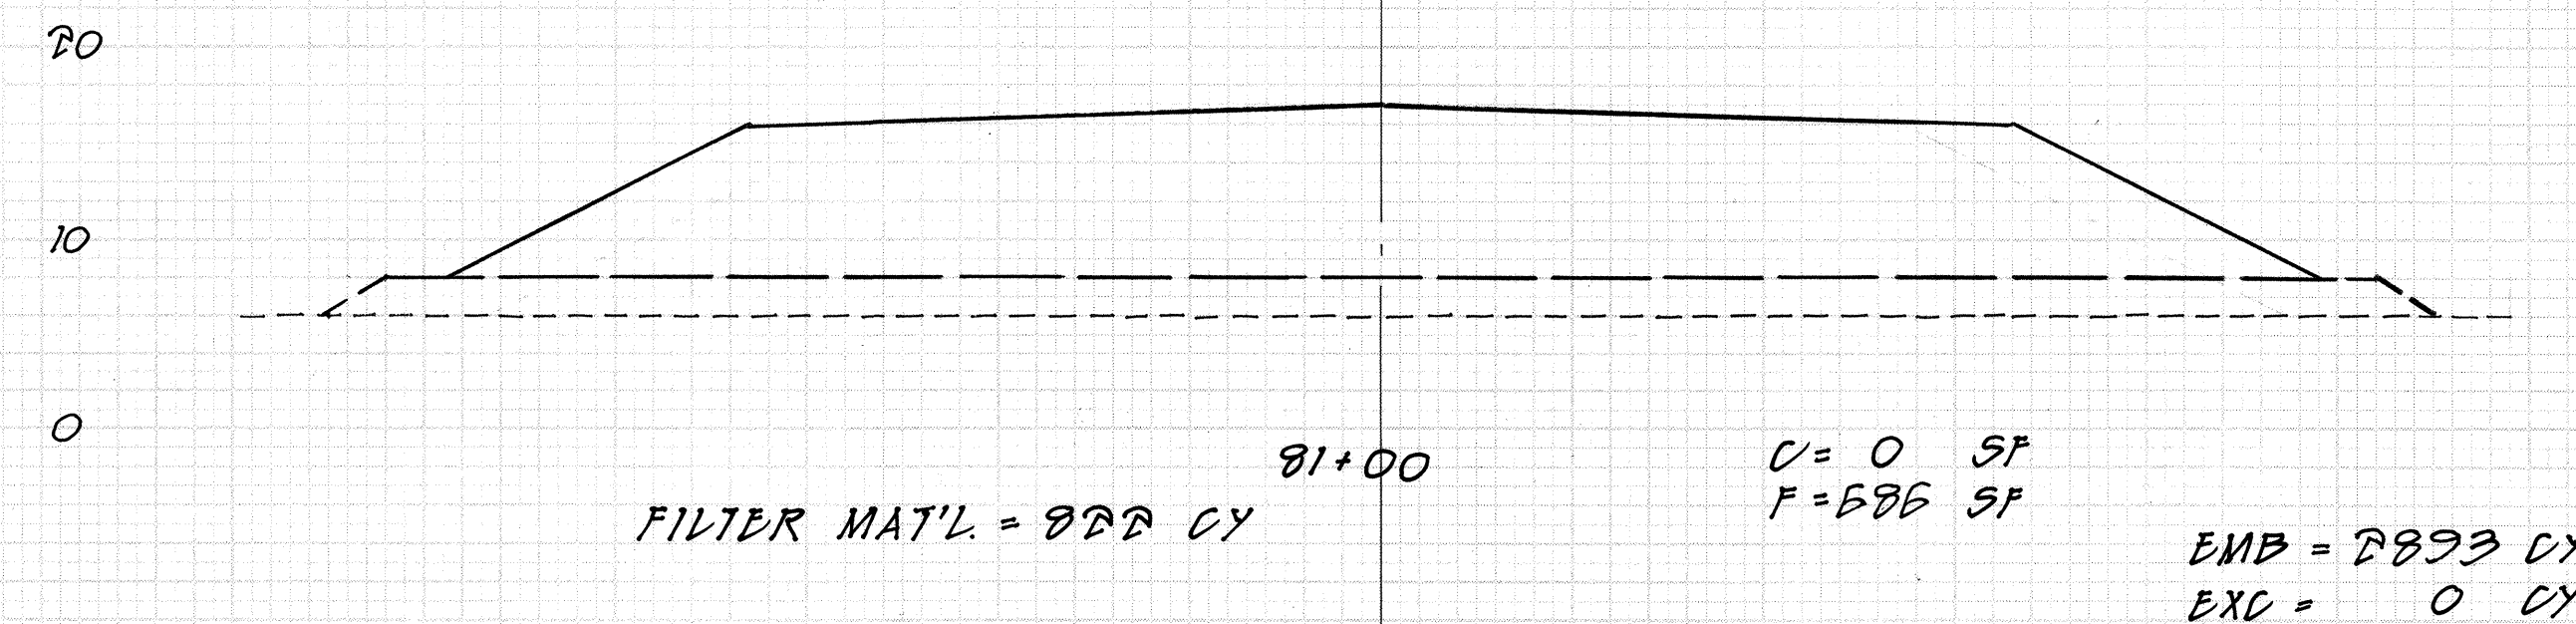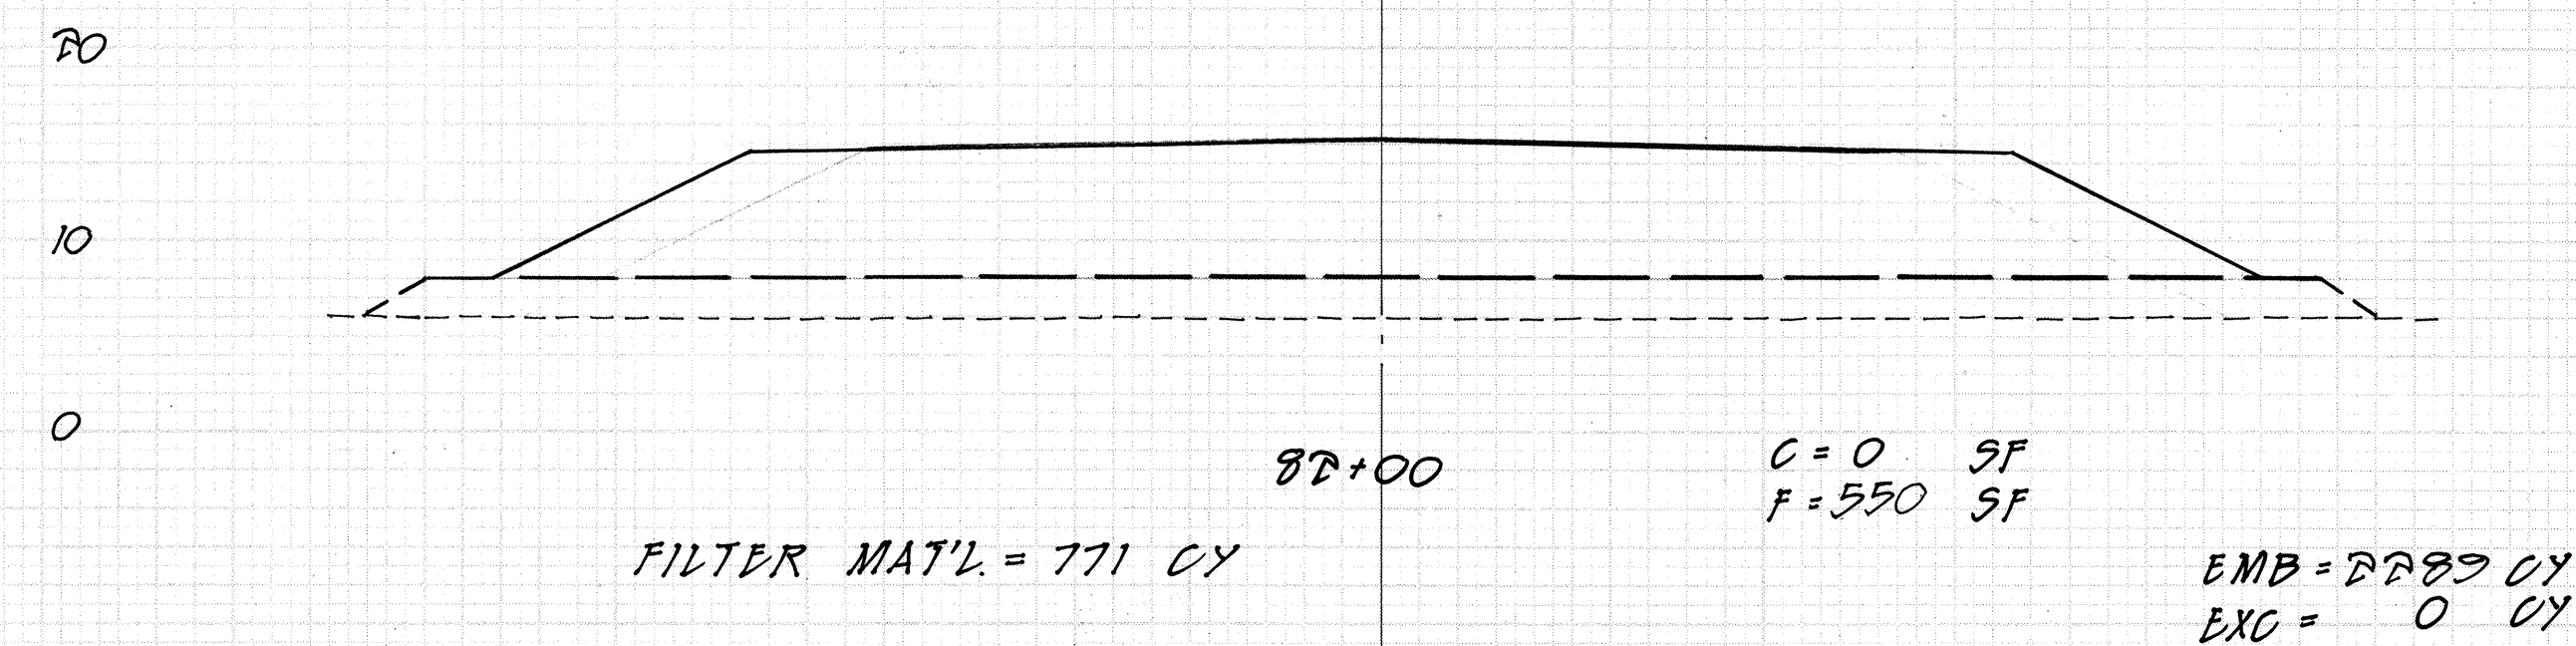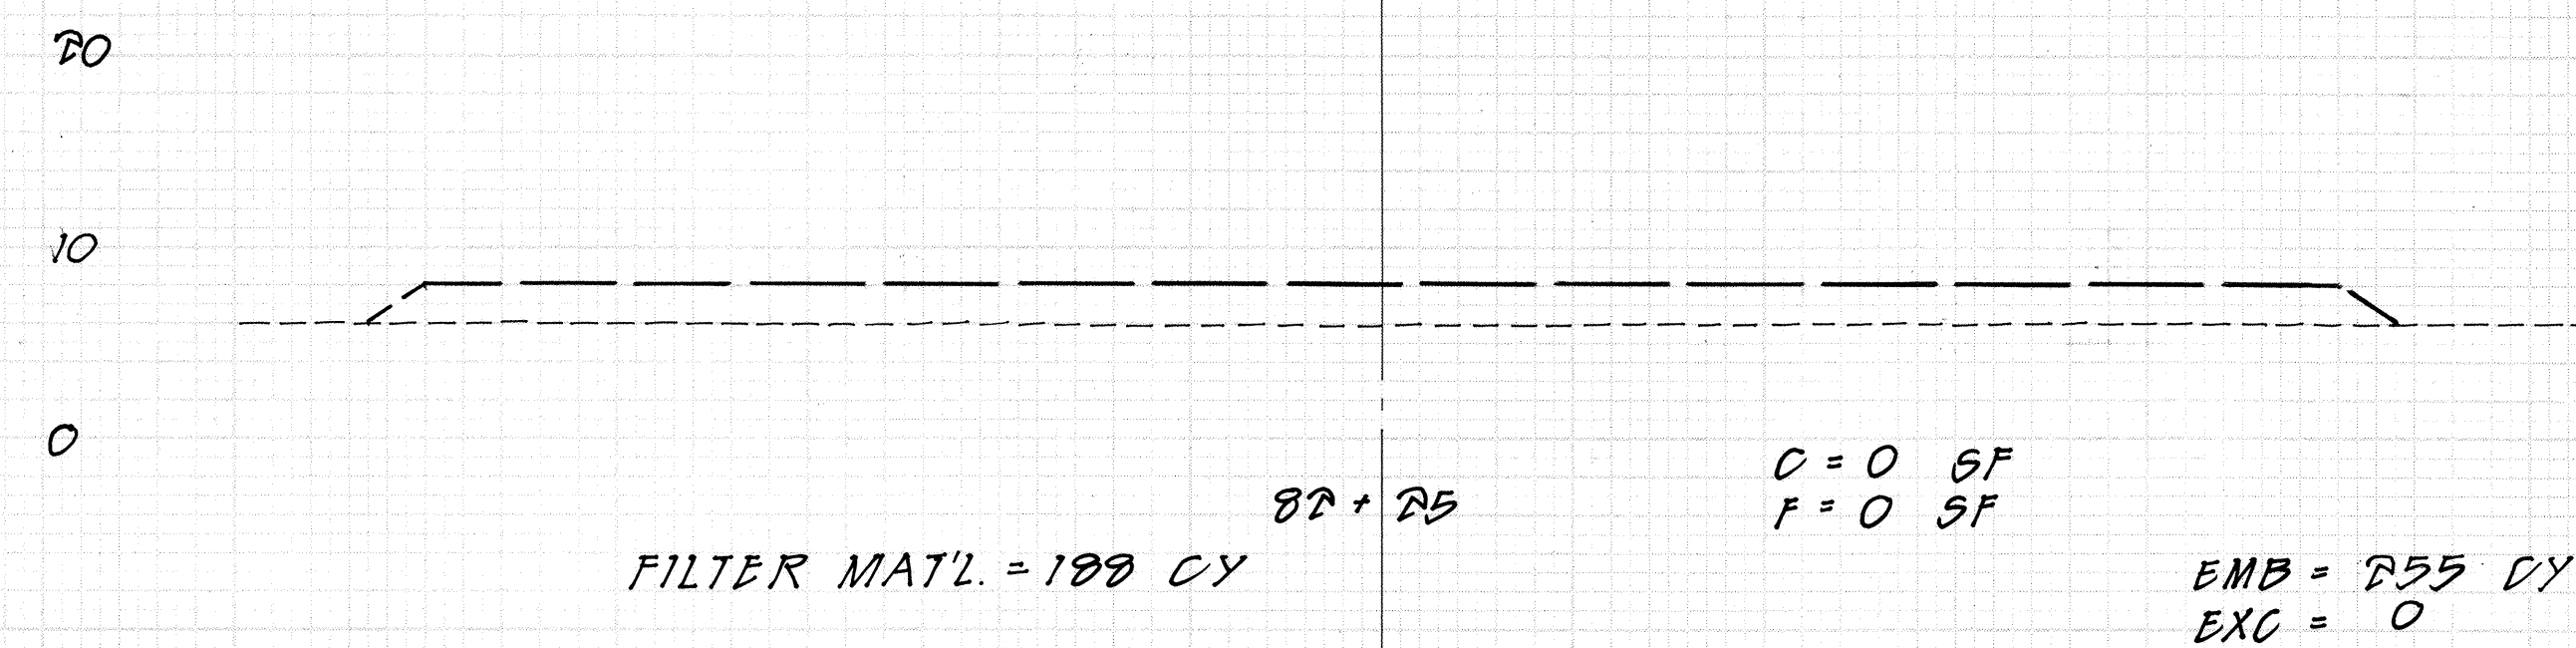

THIS WORK WAS PREPARED BY
ME OR UNDER MY SUPERVISION.

Robert T. Watson