

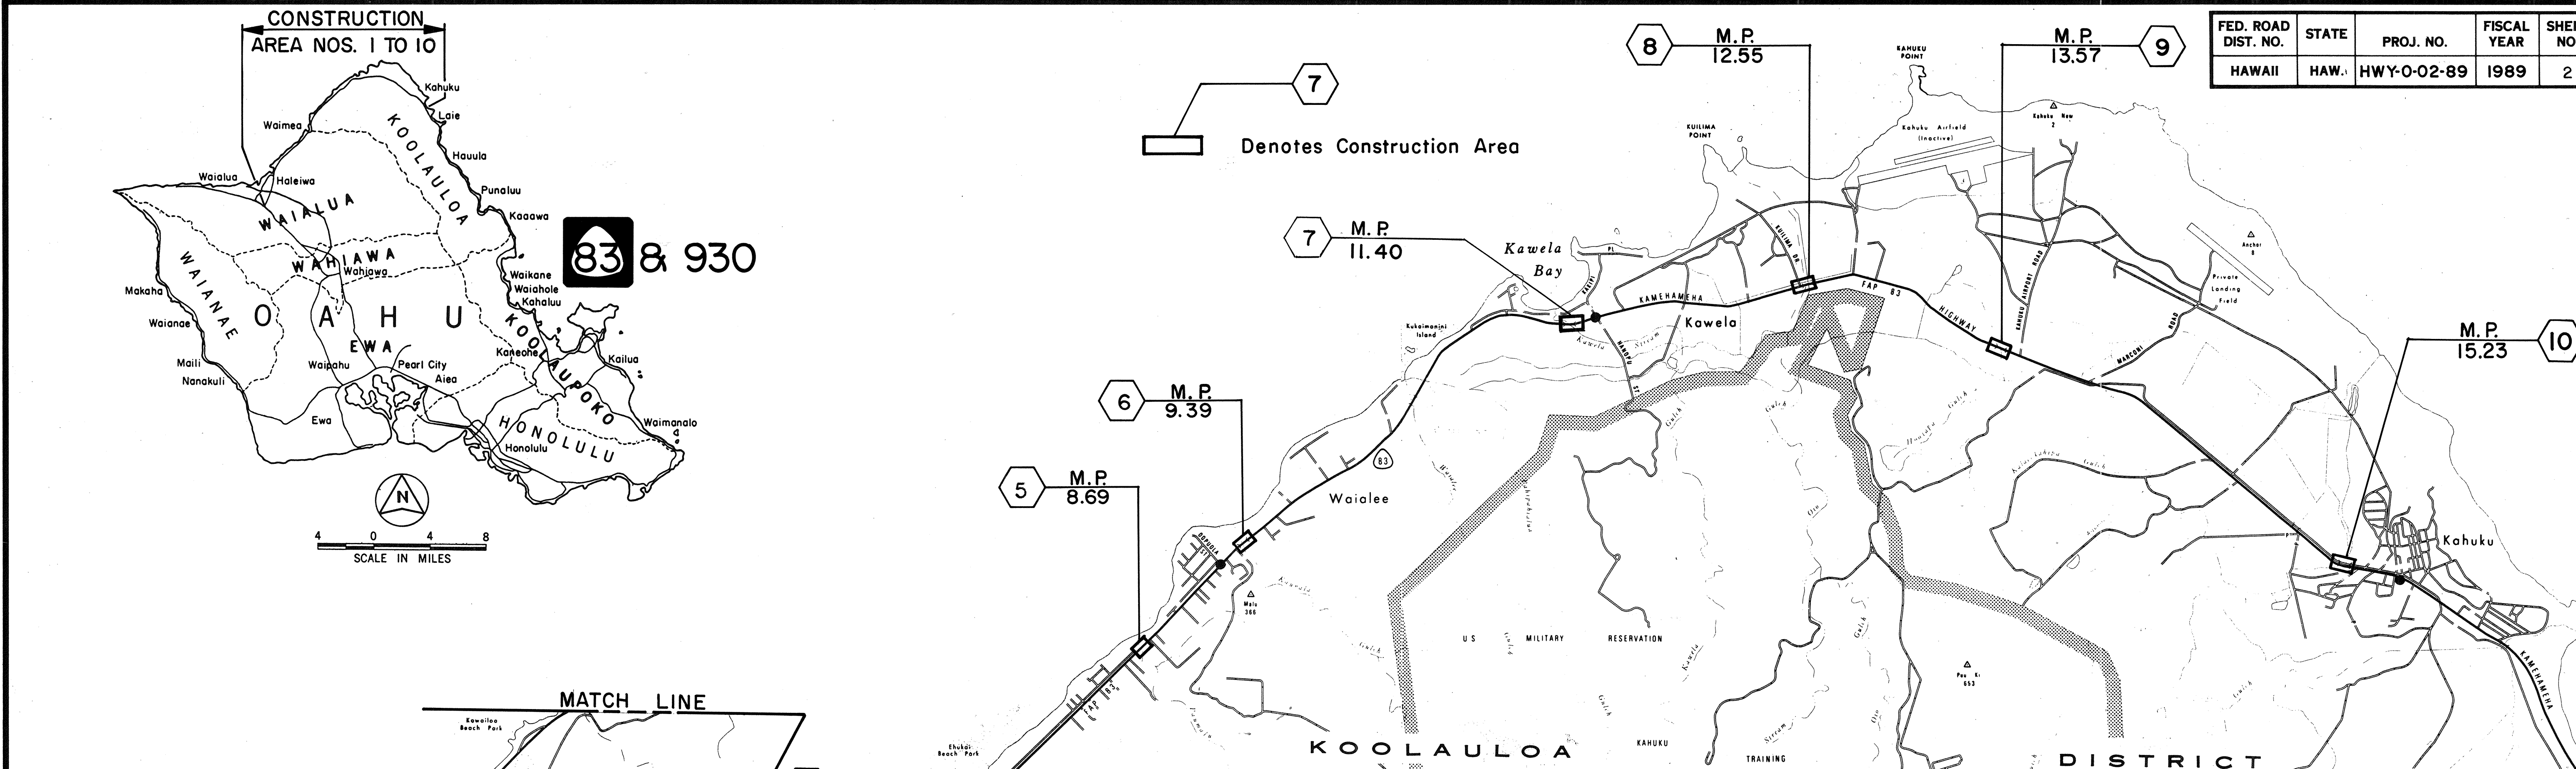


FED. ROAD DIST. NO.	STATE	PROJ. NO.	FISCAL YEAR	SHEET NO.	TOTAL SHEETS
HAWAII	HAW.	HWY-0-02-89	1989	2	23

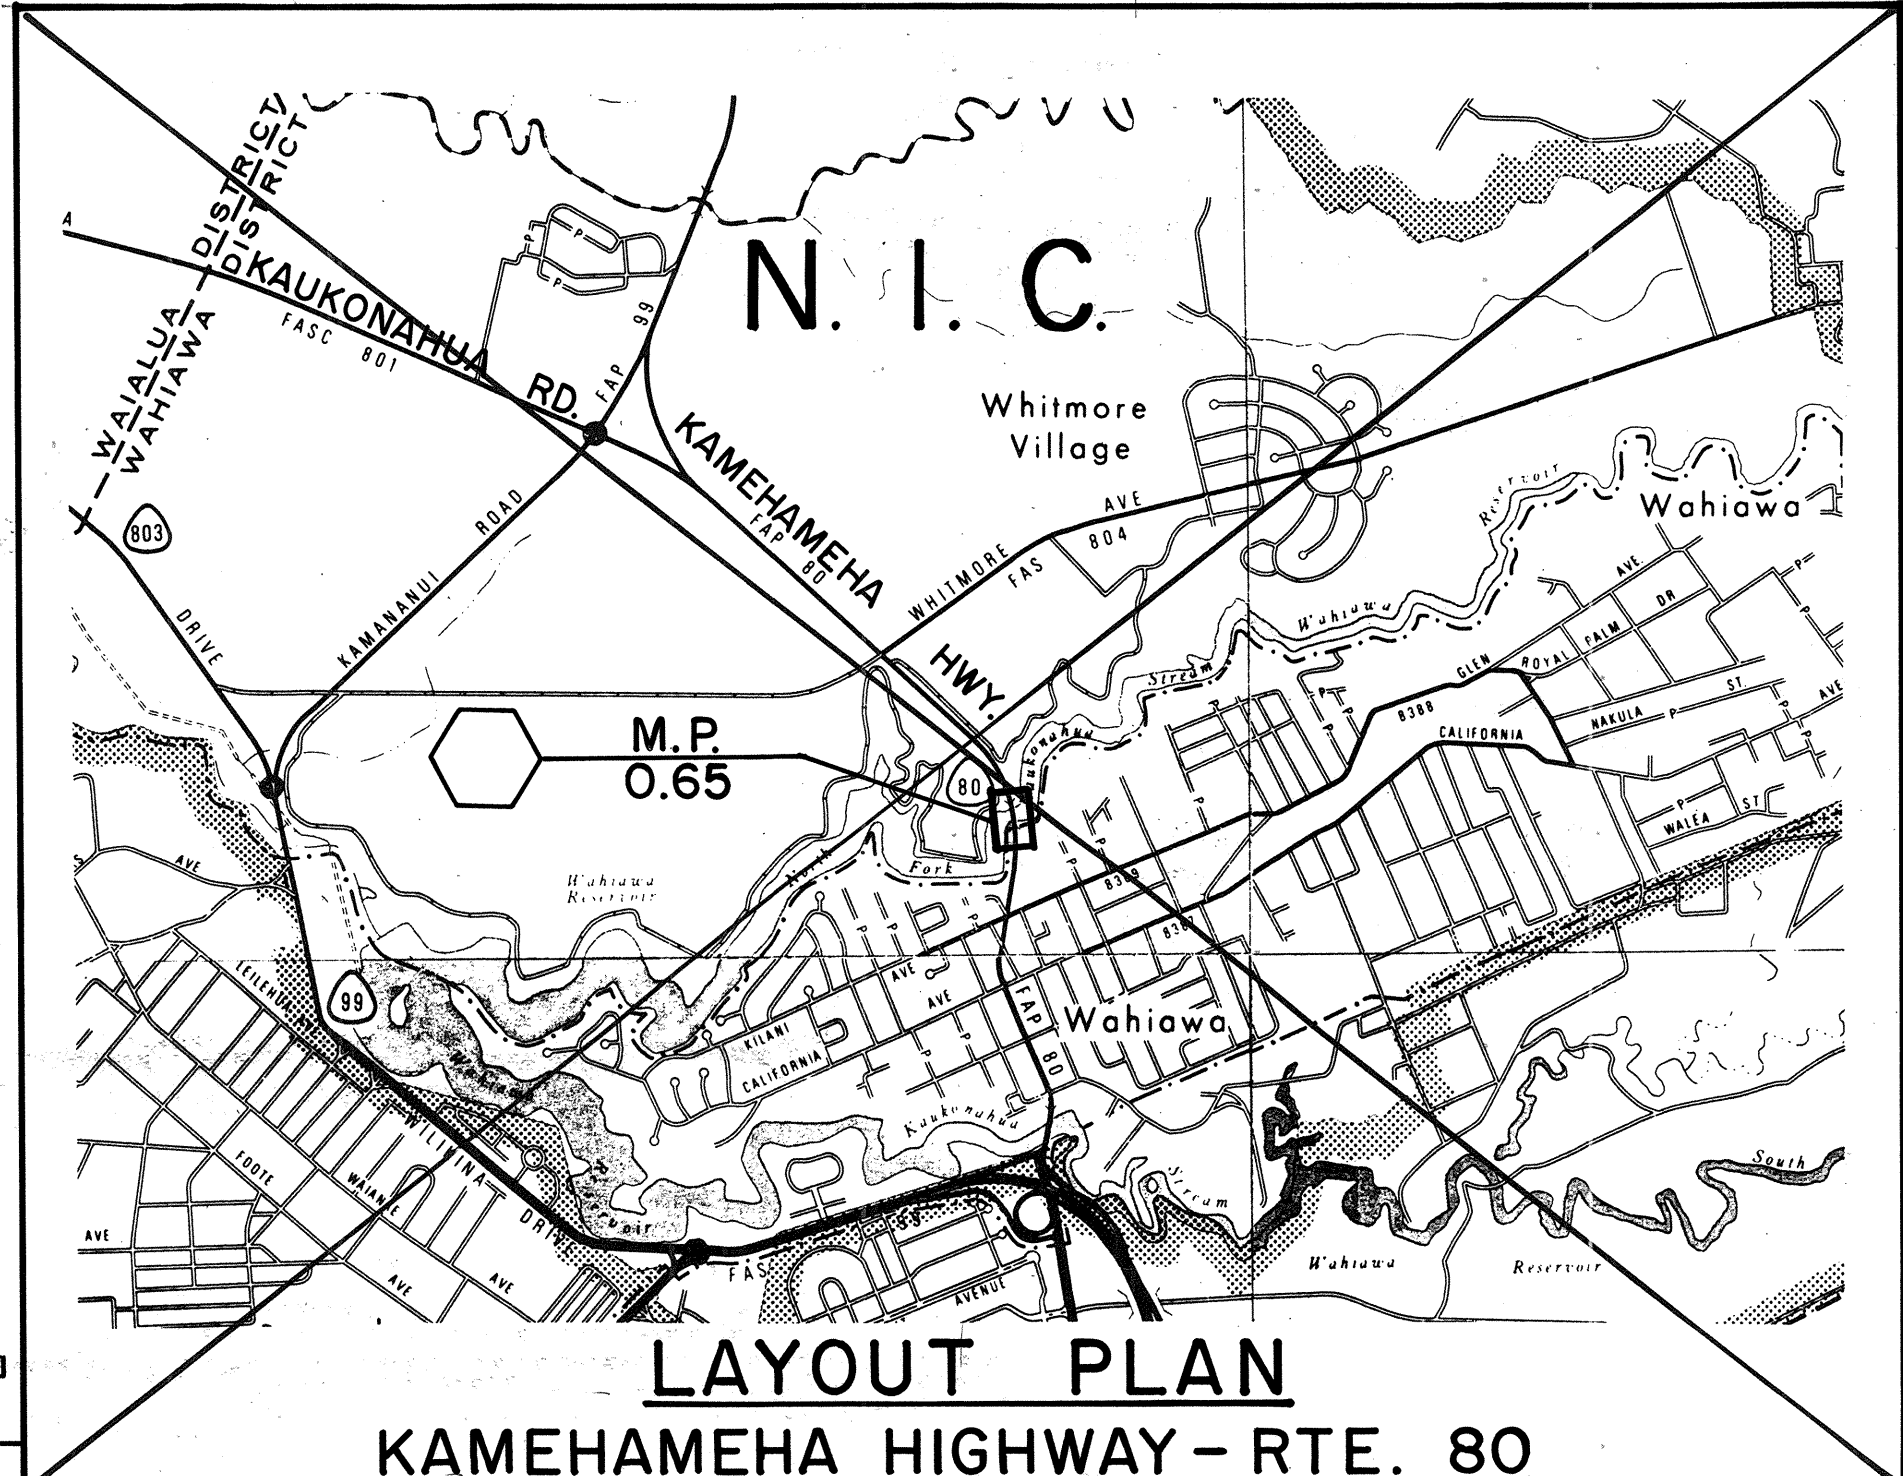

PLAN REFERENCE					
CONSTRUCTION AREA NOS.	PLAN SHEET NOS.	ROUTE NO.	CONSTRUCTION AREA NOS.	PLAN SHEET NOS.	ROUTE NO.
1	6	930	7	10	83
2	6	83	8	10	83
3	8	83	9	10	83
4	9	83	10	10	83
5	9	83			
6	9	83			

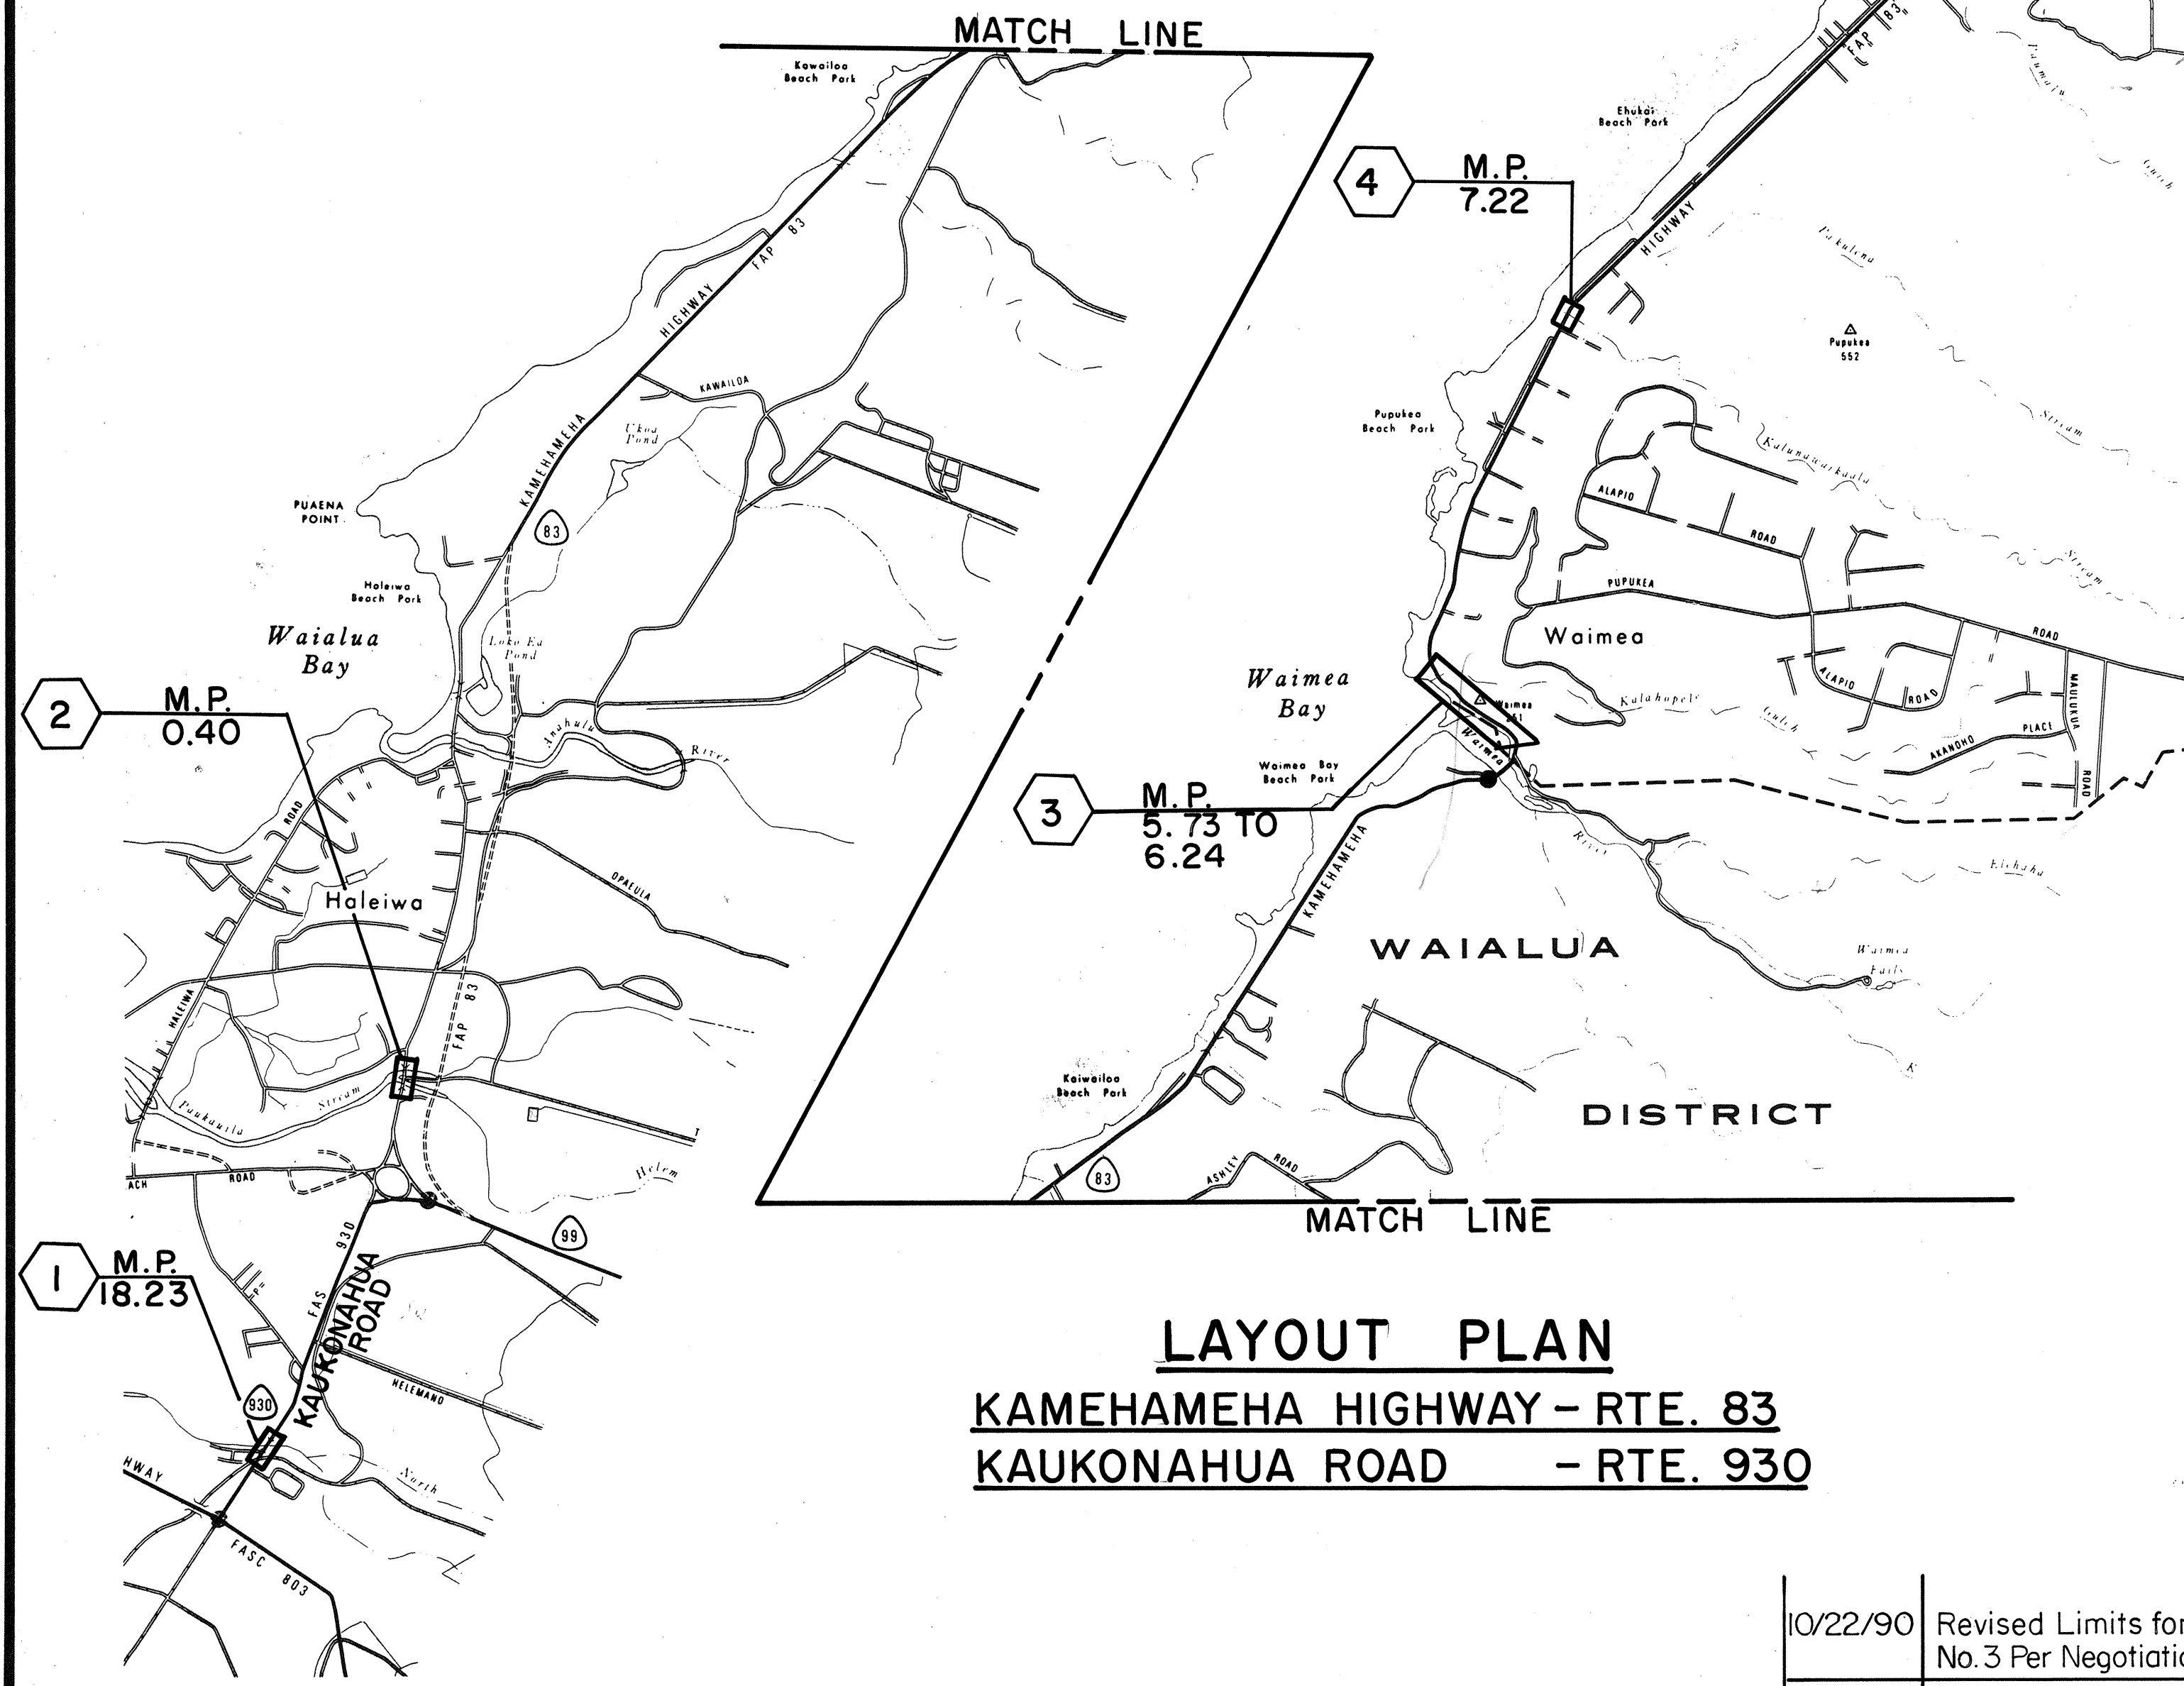

LAYOUT PLAN
KAMEHAMEHA HIGHWAY - RTE. 83
KAUKONAHUA ROAD - RTE. 930

LAYOUT PLAN
KAMEHAMEHA HIGHWAY - RTE. 80

STATE OF HAWAII
DEPARTMENT OF TRANSPORTATION
HIGHWAYS DIVISION

**LAYOUT PLAN AND
PLAN REFERENCE**

GUARDRAIL & SHOULDER IMPROV.
VARIOUS LOCATIONS ON OAHU
Proj. No. HWY-0-02-89
Scale: 1" = 2,000' Date: Feb., 1989
SHEET No. 1 OF 2 SHEETS

10/22/90	Revised Limits for Construction Area No. 3 Per Negotiation with low bidder.
DATE	REVISION

SURVEY PLOTTED BY	DATE
DRAWN BY	
DESIGNED BY	
NOTED BY	
CHECKED BY	
ORIGINAL PLAN	
NOTE BOOK	
No.	

FED. ROAD DIST. NO.	STATE	PROJ. NO.	FISCAL YEAR	SHEET NO.	TOTAL SHEETS
HAWAII	HAW.	HWY-0-02-89	19	3	23


PLAN REFERENCE		
CONSTRUCTION AREA NOS.	PLAN SHEET NOS.	ROUTE NO.
11		83
12		83
13	N/C	83
14		83
16		83
17		83
18		83
19		83
20		83
21		83
22		83
23		83
24		83
11-A		83

SURVEY PLOTTED BY	DATE
DRAWN BY	
DESIGNED BY	
CHECKED BY	
ORIGINAL PLAN	
NOTE BOOK	
NO.	

10/22/90	Deleted Construction Area No. 15 Per Negotiation with low bidder.
DATE	REVISION

LAYOUT PLAN
KAMEHAMEHA HIGHWAY - RTE. 83

STATE OF HAWAII
DEPARTMENT OF TRANSPORTATION
HIGHWAYS DIVISION
**LAYOUT PLAN AND
PLAN REFERENCE**
GUARDRAIL & SHOULDER IMPROV.
VARIOUS LOCATIONS ON OAHU
Proj. No. HWY-0-02-89
Scale: 1" = 2,000 Date: Feb., 1989
SHEET NO. 2 OF 2 SHEETS

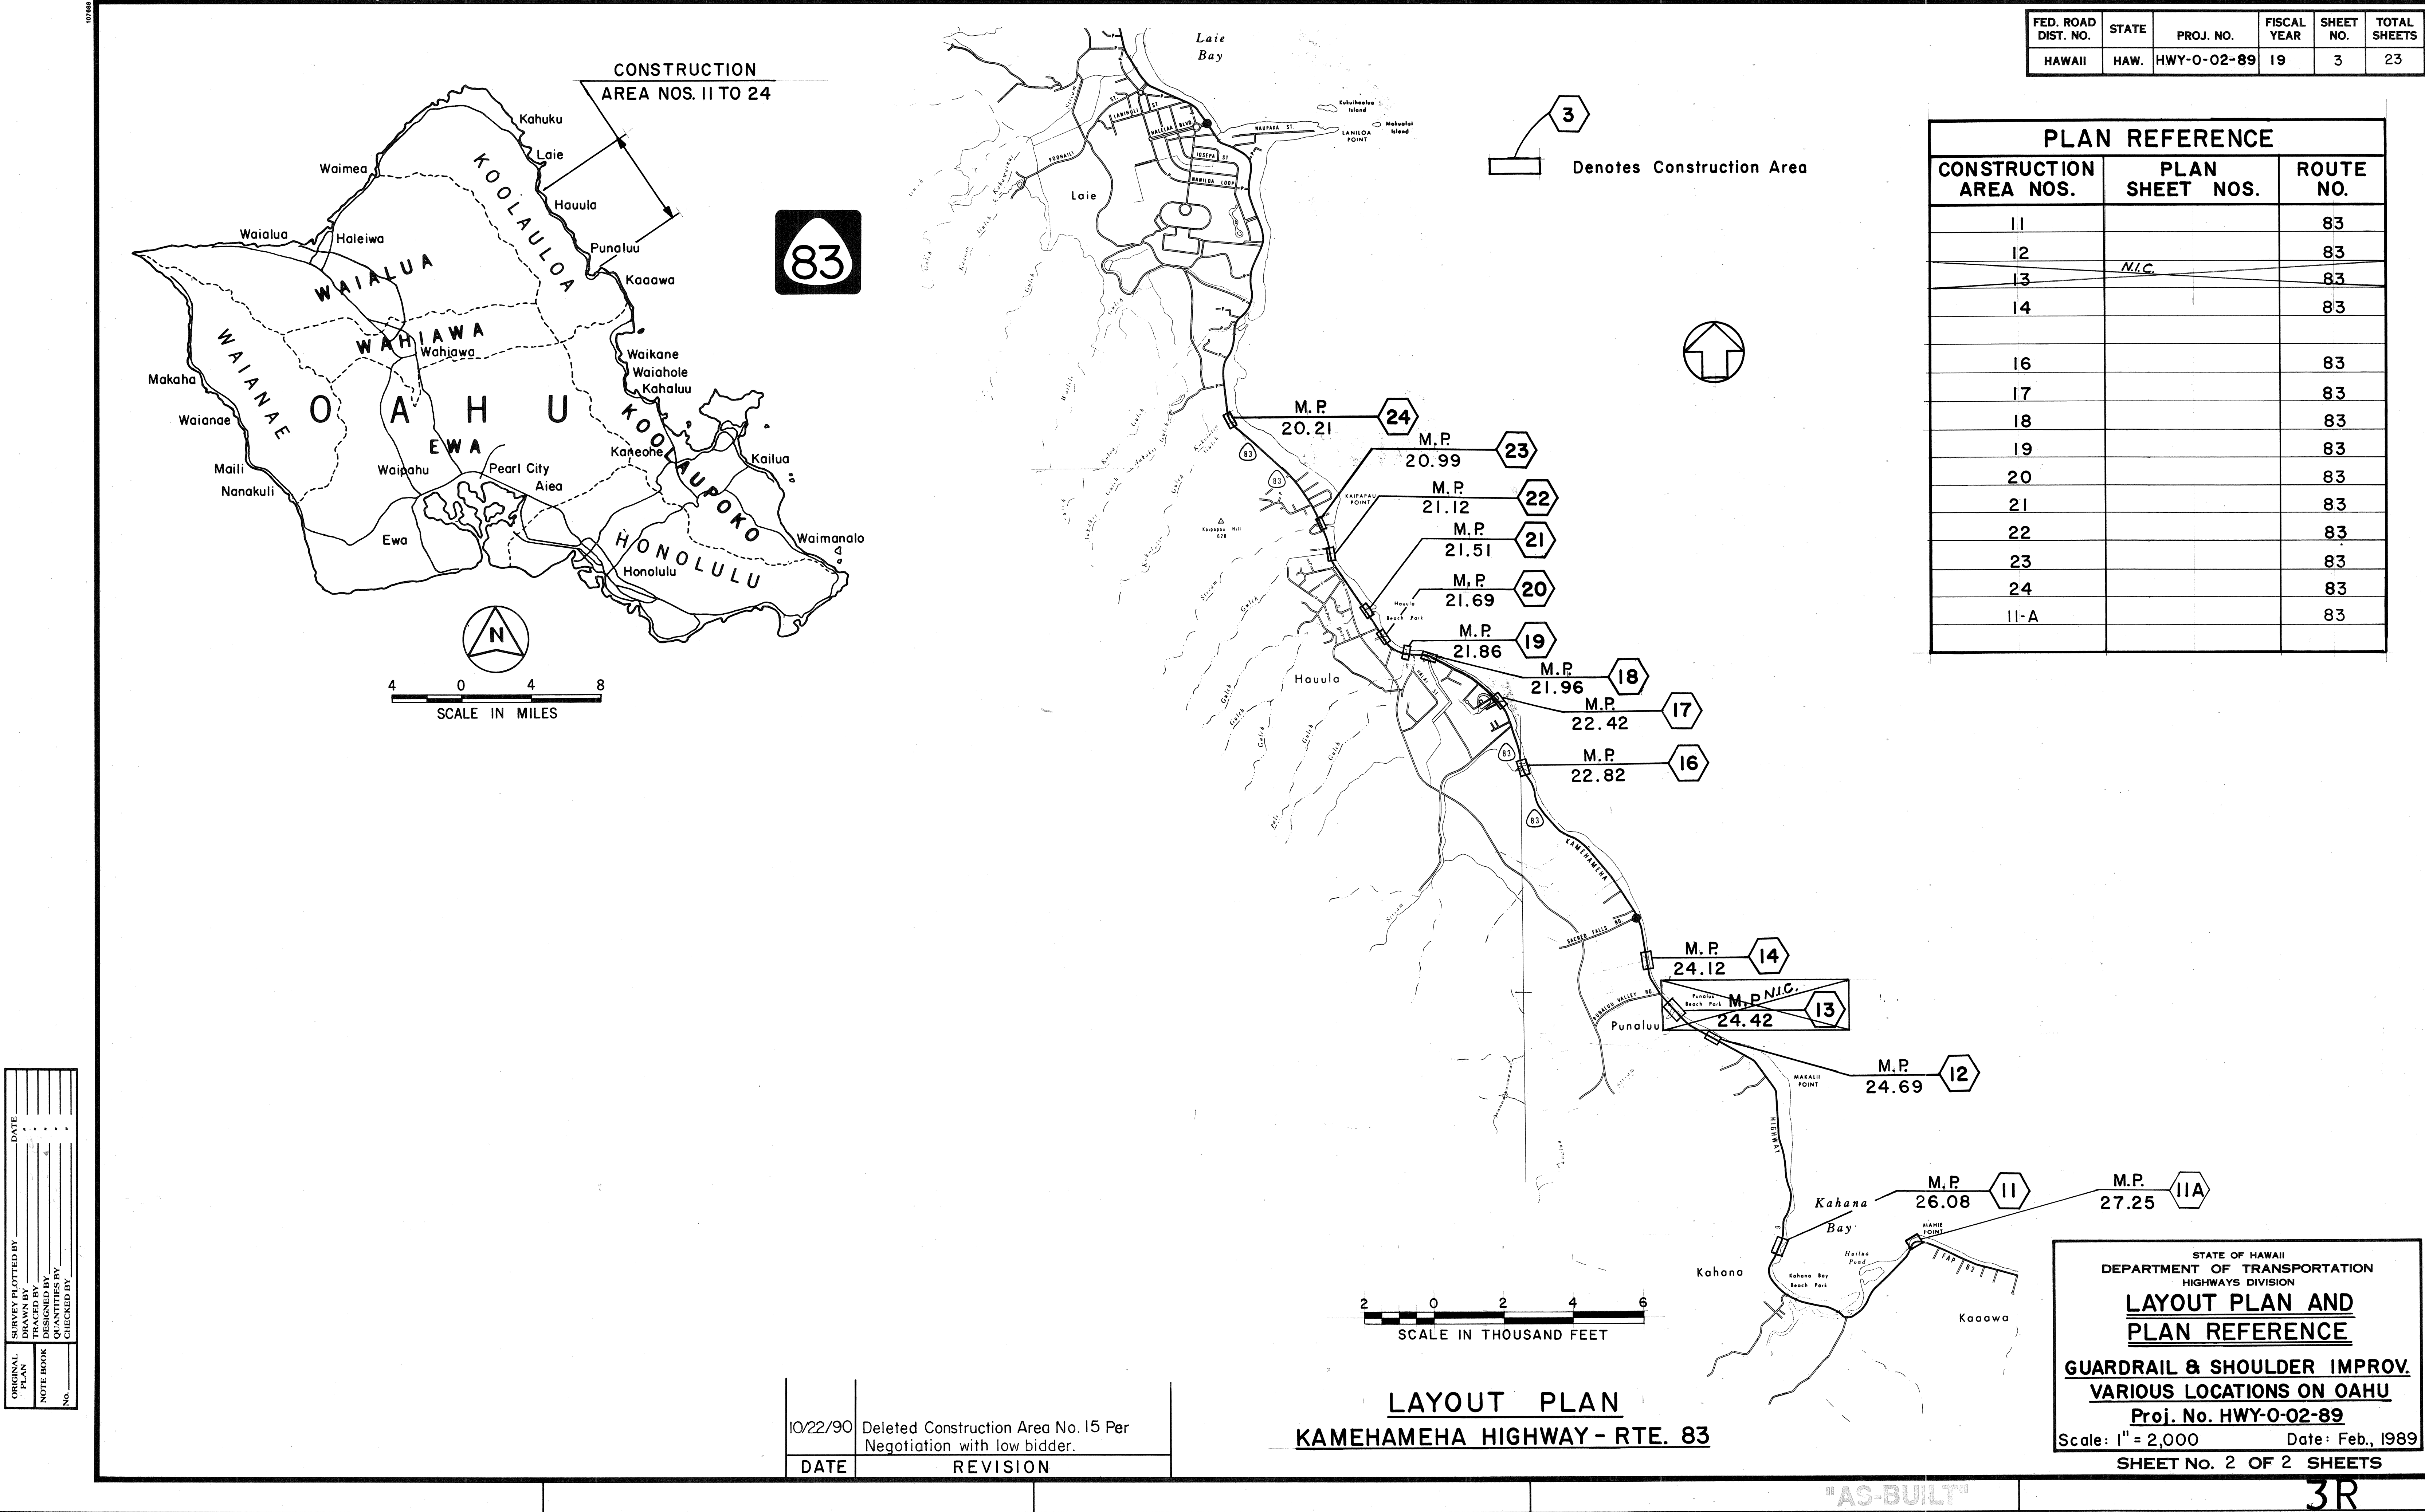

"AS-BUILT"