| | INDEX TO DRAWINGS |
|---|--------------------------|
| SHEET NO. | DESCRIPTION |
| | TITLE SHEET |
| . 2 | SUMMARY SHEET |
| 3 | GENERAL NOTES AND LEGEND |
| 4 ., | TYPICAL SECTIONS |
| 5-7 | PLAN |
| 1 | |
| | |
| | |
| | * |
| | |
| 50mm 100mm 14 marsh 100mm 1 | |
| | |
| | |
| | |
| | |
| • . | |
| | |
| | |
| | |
| | |


STATE OF HAWAII

DEPARTMENT OF TRANSPORTATION
HIGHWAYS DIVISION
HONOLULU, HAWAII
"AS BUILT"
PLANS FOR

KAMEHAMEHA HIGHWAY
SIDEWALK FROM HAUULA KAI SHOPPING CENTER TO
HAUULA ELEMENTARY SCHOOL


PROJECT NO. 83C-03-89

DISTRICT OF KOOLAULOA ISLAND OF OAHU

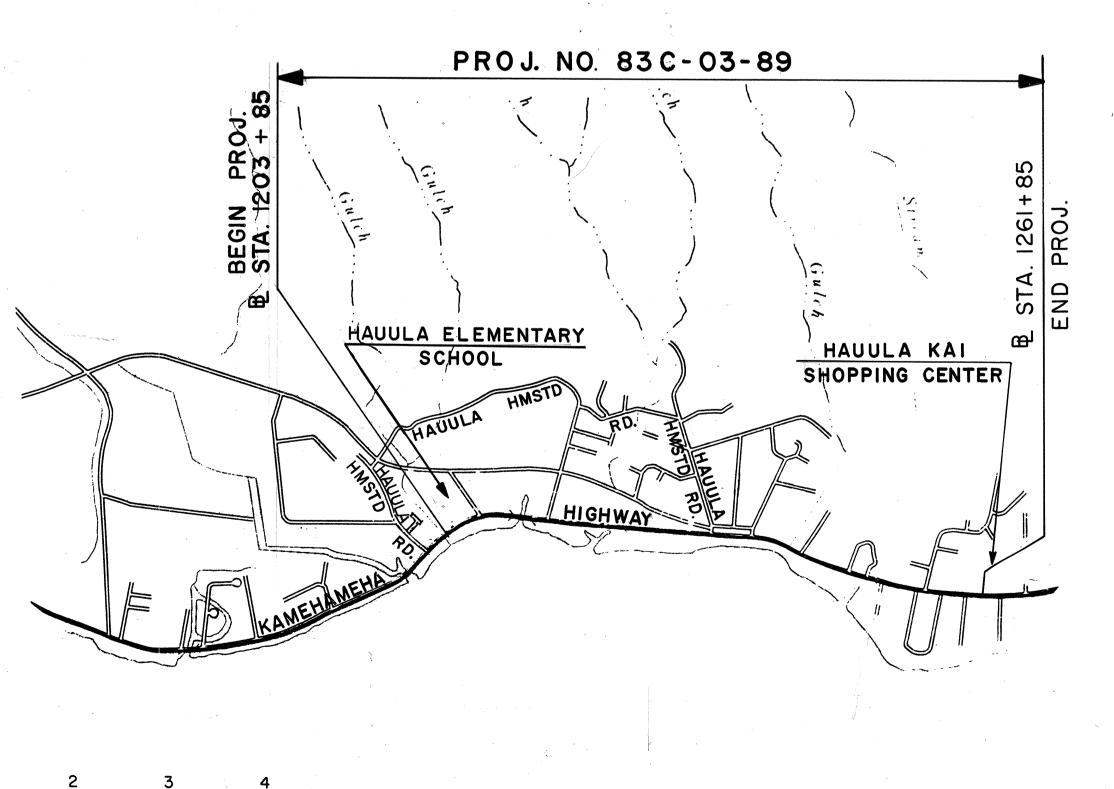

LENGTH OF PROJECT - I.I MI.

SCALE IN THOUSAND FEET

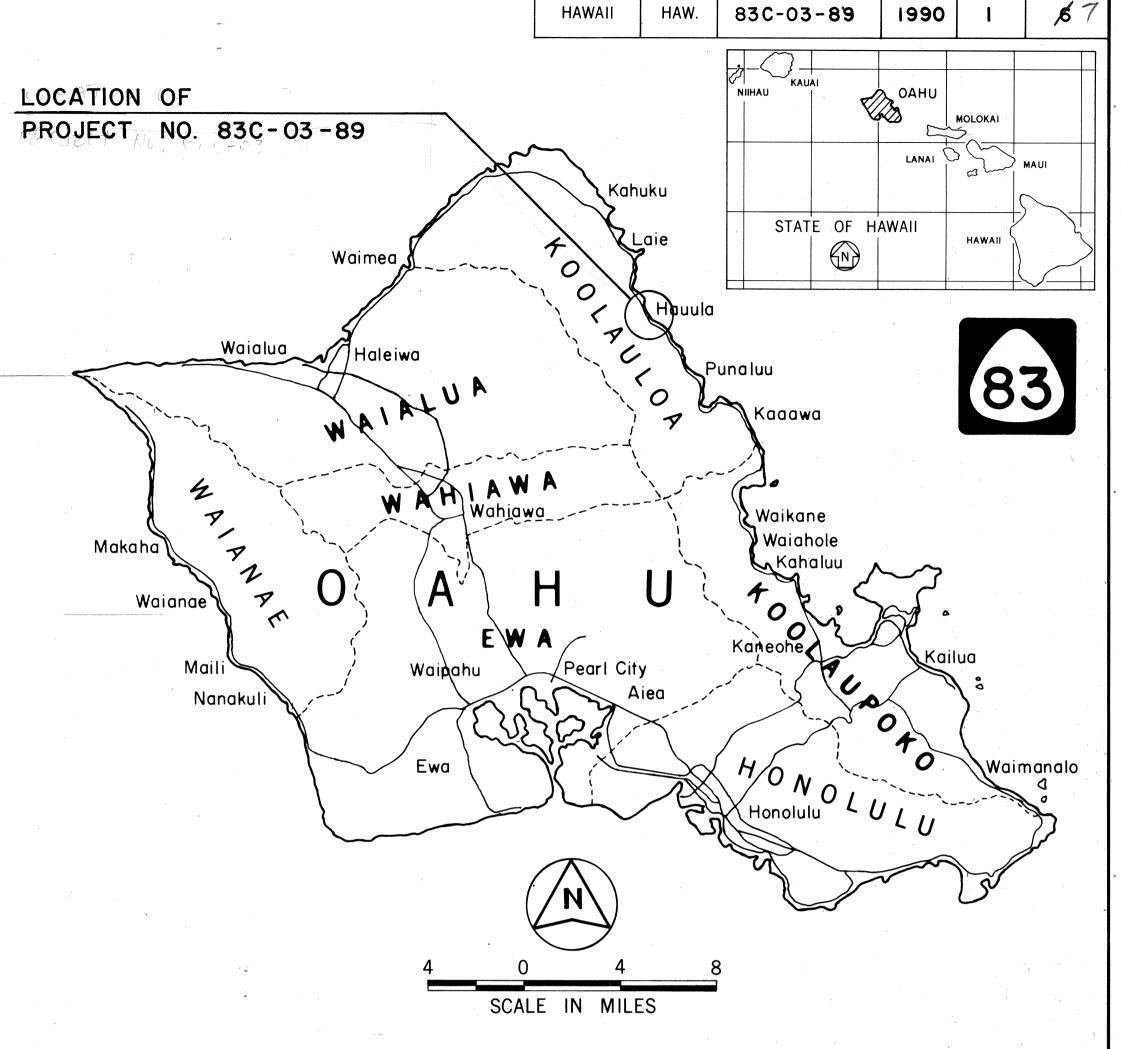

FED. ROAD DIST. NO.

MILE POST 20.74 TO MILE POST 21.84

NO SIGNIFICANT CHANGES WERE MADE DURING CONSTRUCTION ON THESE PLANS EXCEPT CHANGES IN THE ORIGINAL THEORETICAL QUANTITIES. FOR ACTUAL QUANTITIES, REFER TO PROJECT LEDGER AND/OR COMPUTATION BOOK.

RESIDENT ENGINEER

8/20/91 DATE

DEPARTMENT OF TRANSPORTATION
STATE OF HAWAII

APPROVED:

4/30/90

SHEET TOTAL NO. SHEETS

FISCAL YEAR

PROJ. NO.

)

JAN. 1990 DATE

548-4125 PHONE