




FED. ROAD DIST. NO.	STATE	PROJ. NO.	FISCAL YEAR	SHEET NO.	TOTAL SHEETS
HAWAII	HAW.	83C-03-89	1990	4	6

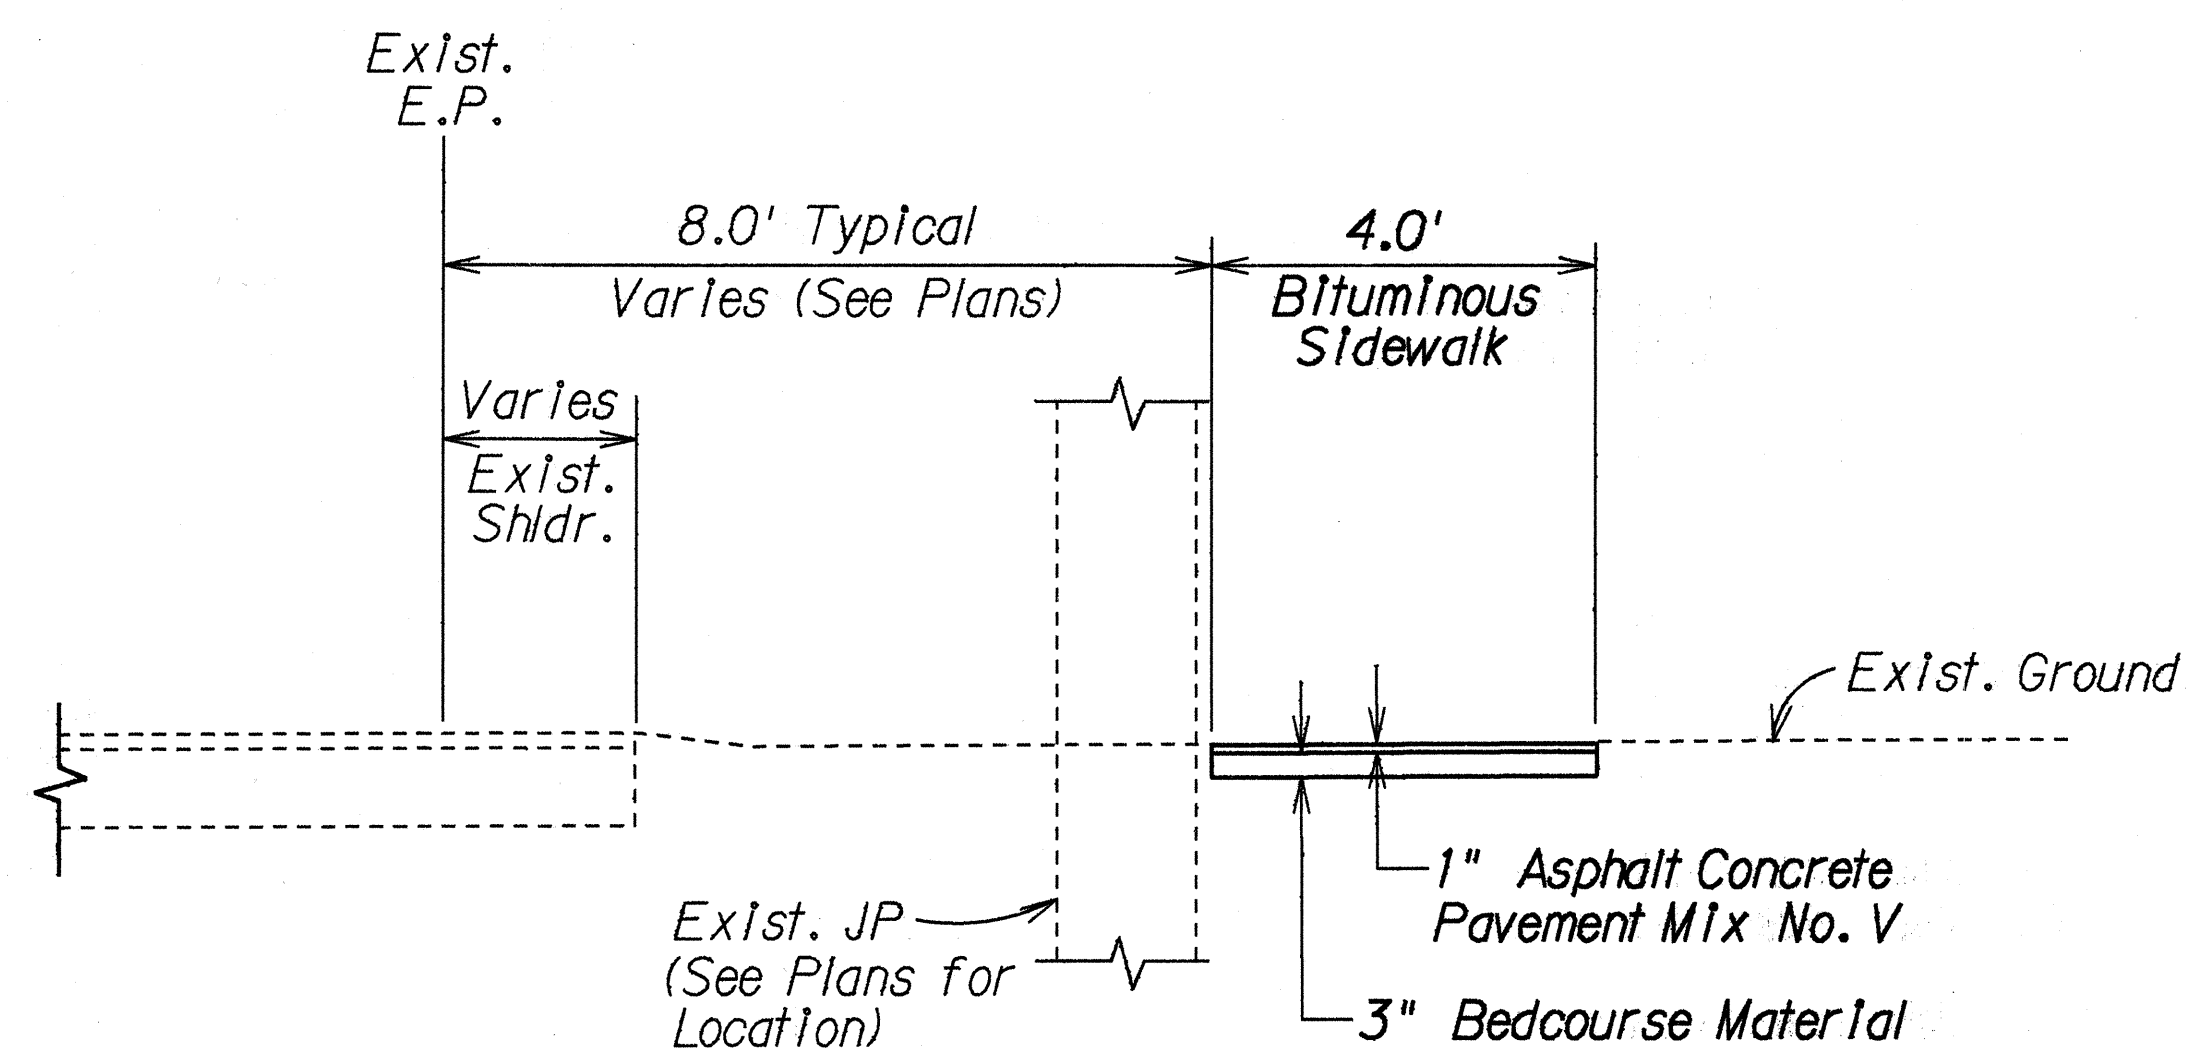


TYPICAL SECTION
Scale: 1/2" = 1'-0"

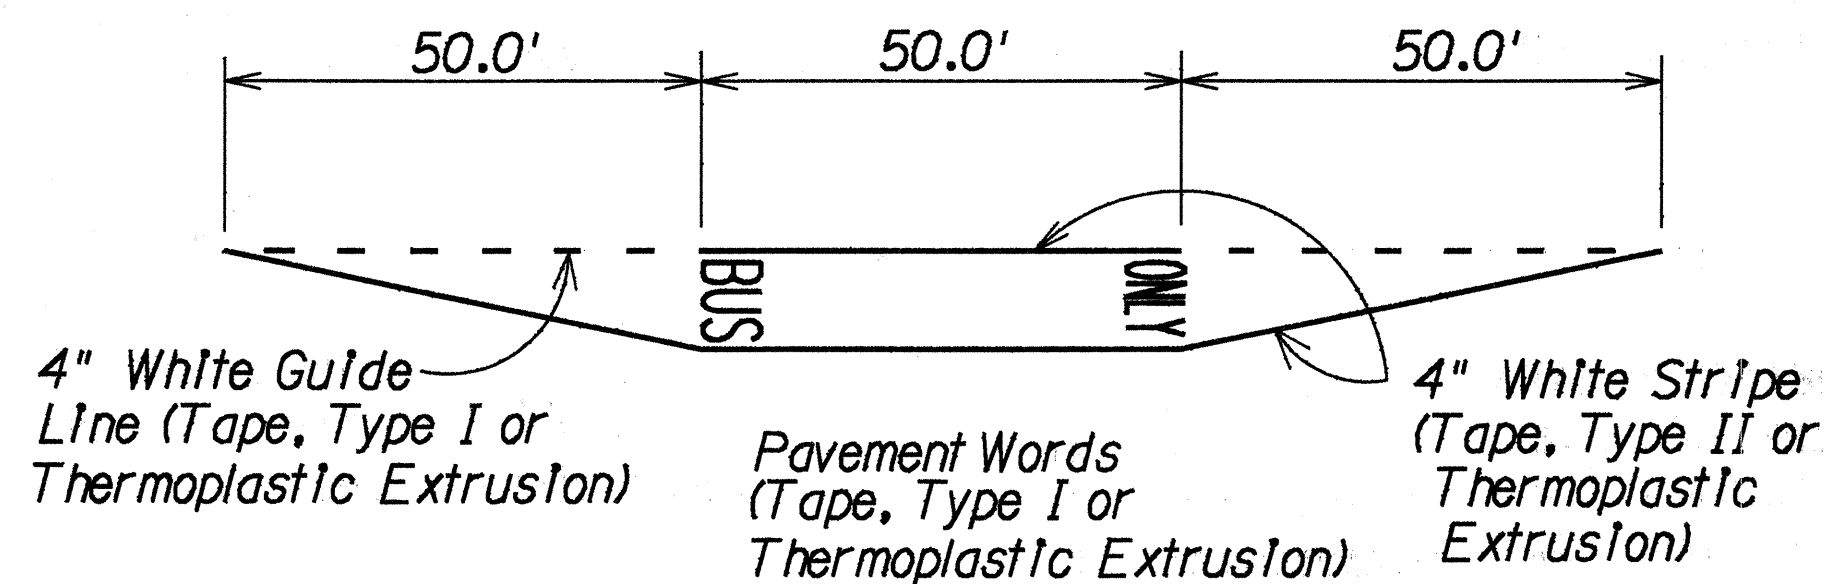

TYPICAL BUS BAY STRIPING
Not to Scale

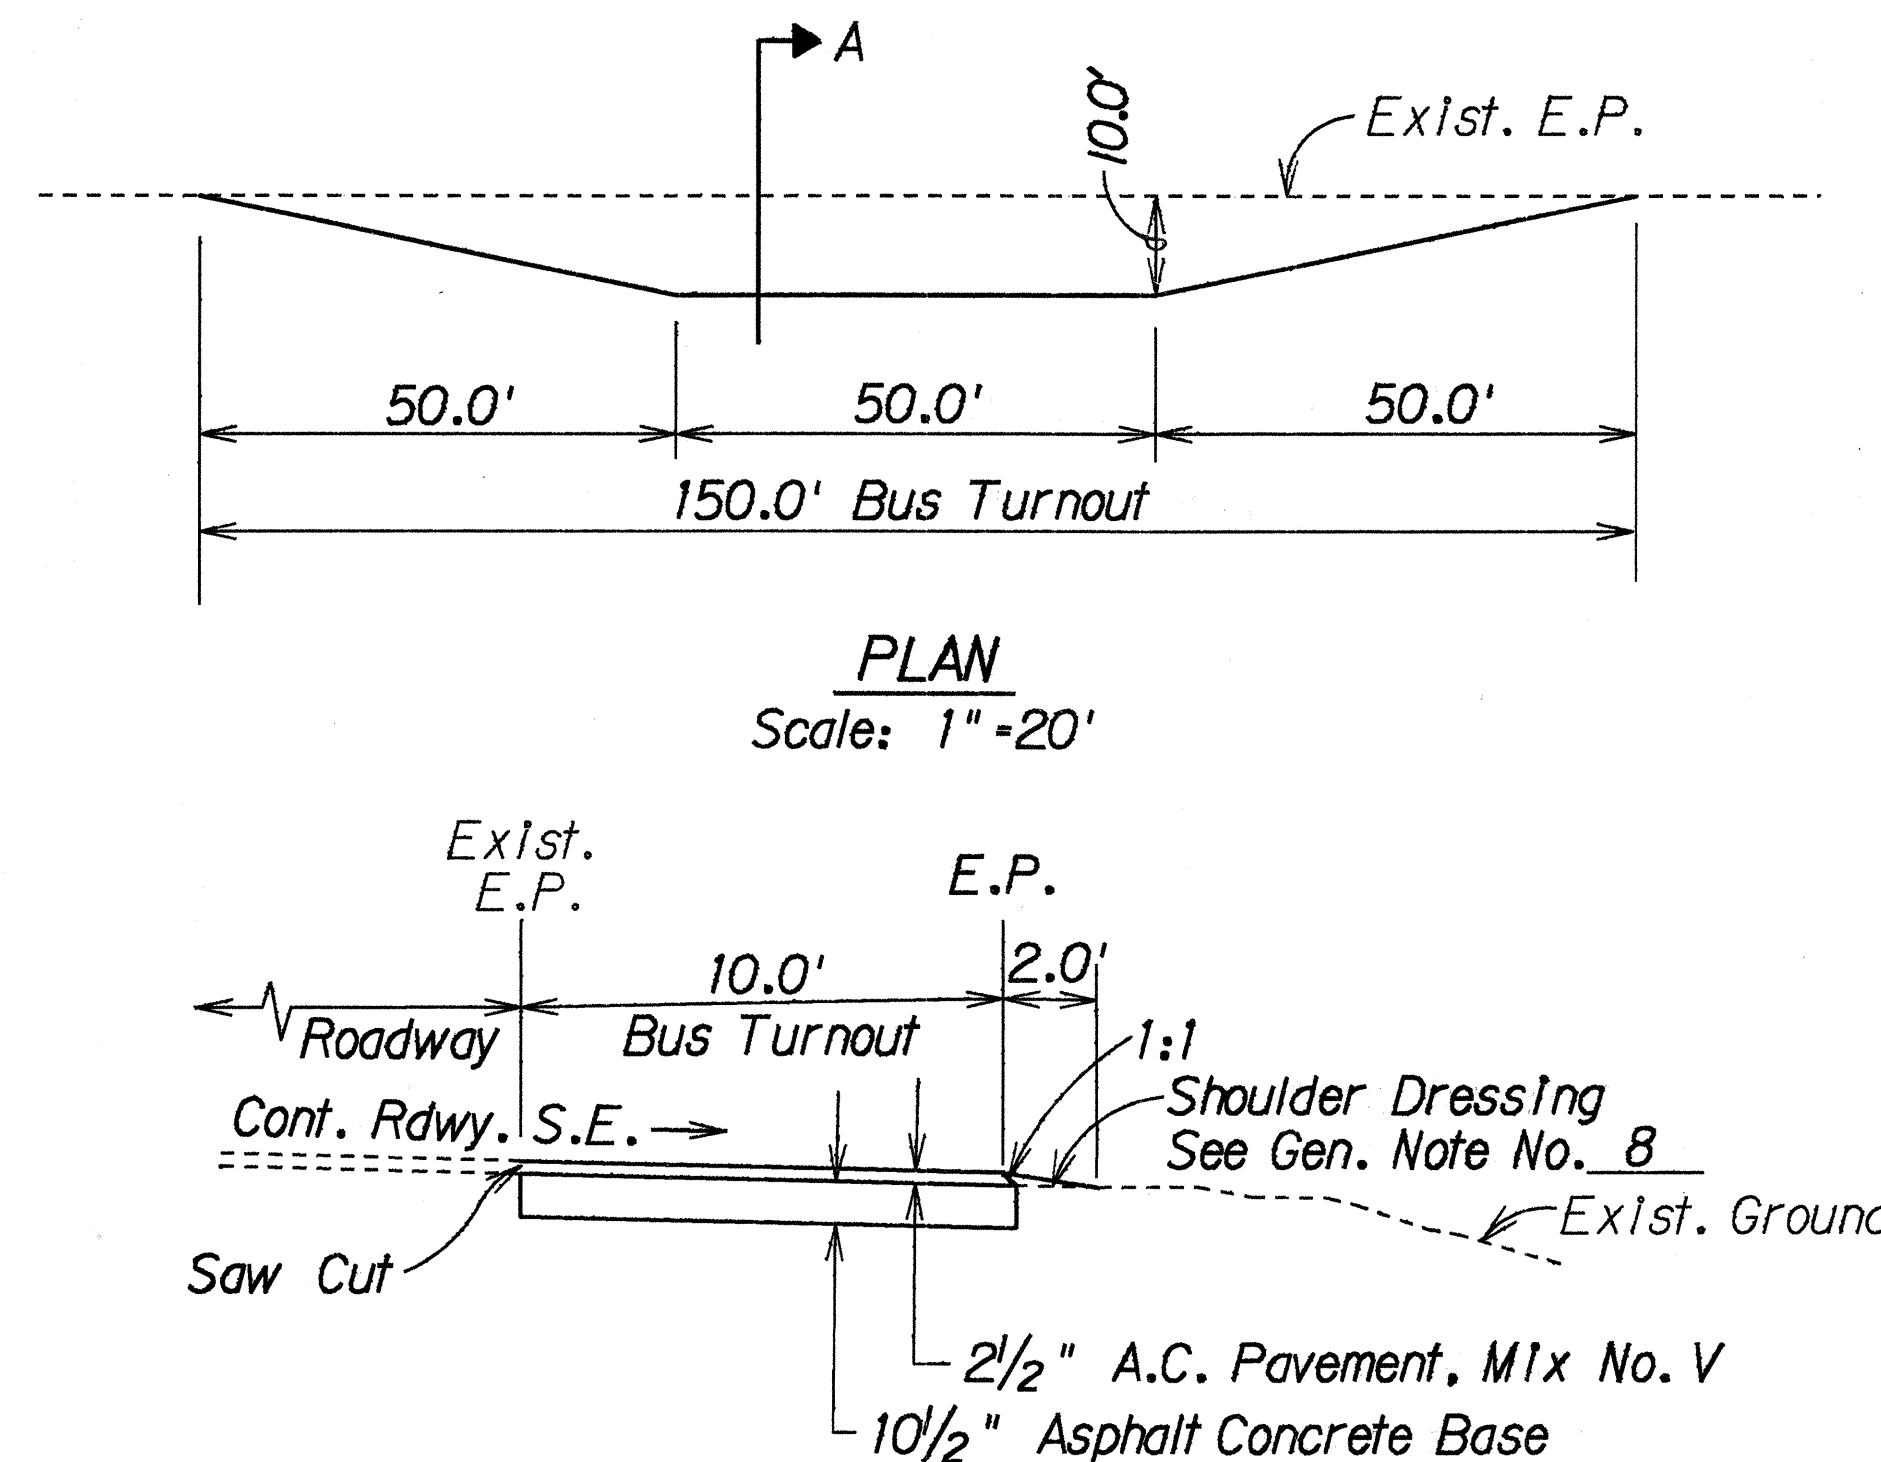


PLAN
Scale: 1" = 20'

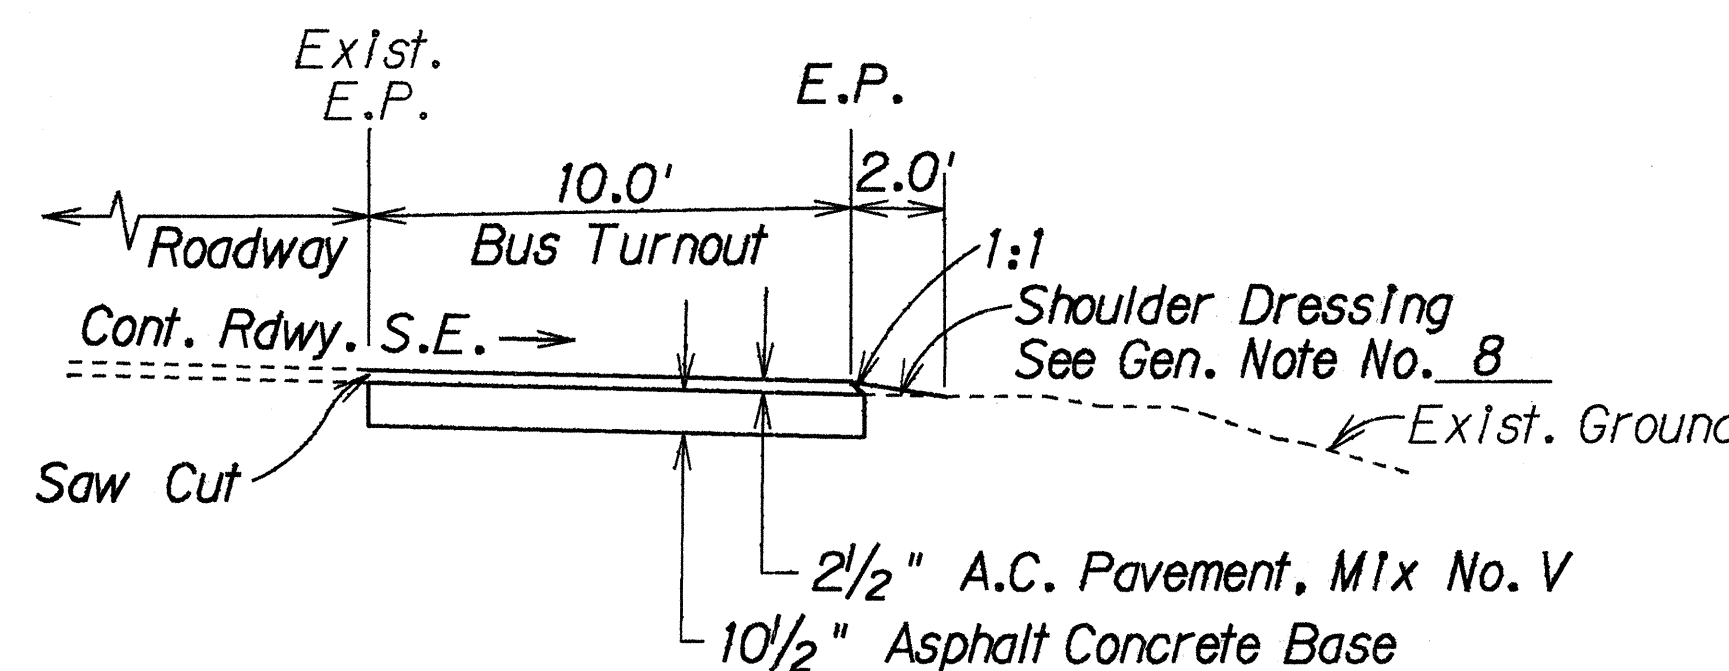


SECTION A
Scale: 1/4" = 1'-0"

BUS TURNOUT DETAIL

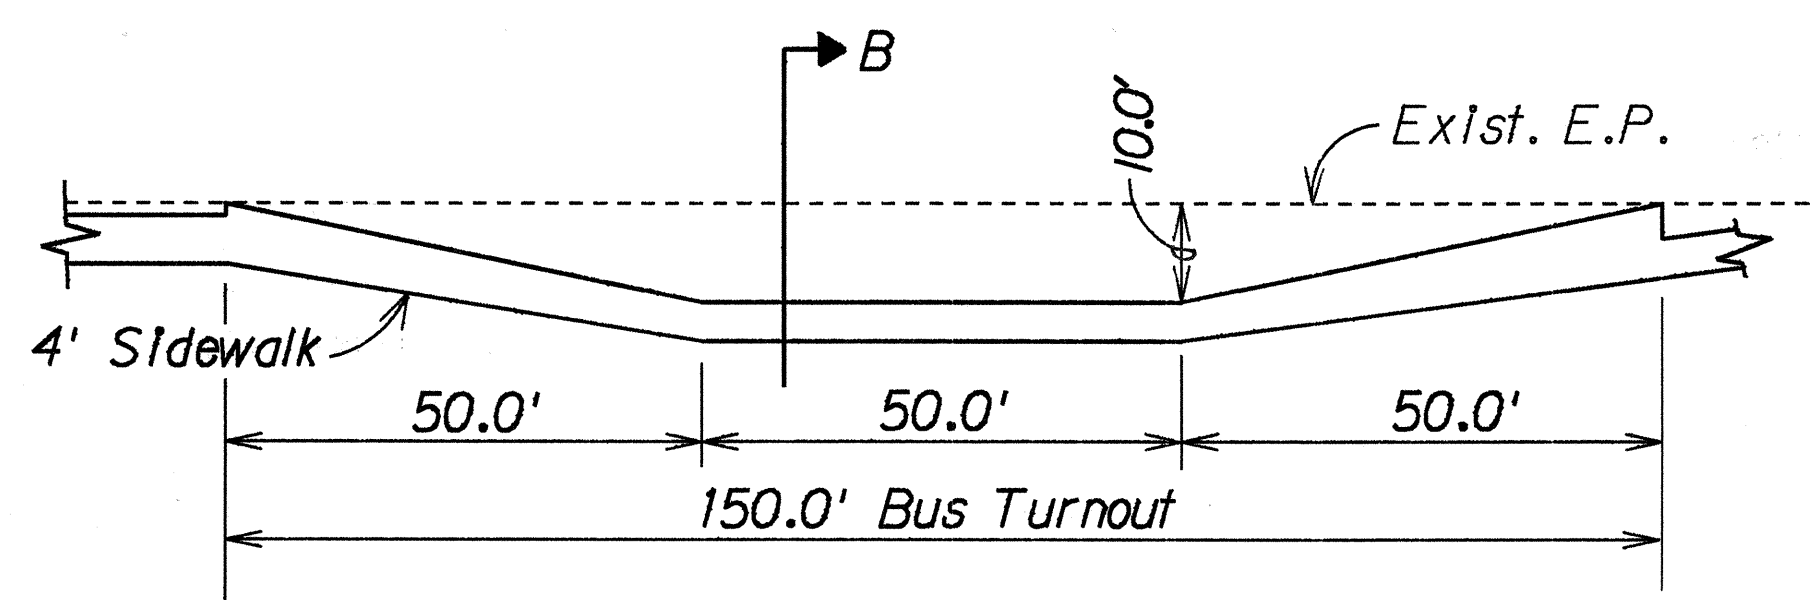

PLAN
Scale: 1" = 20'

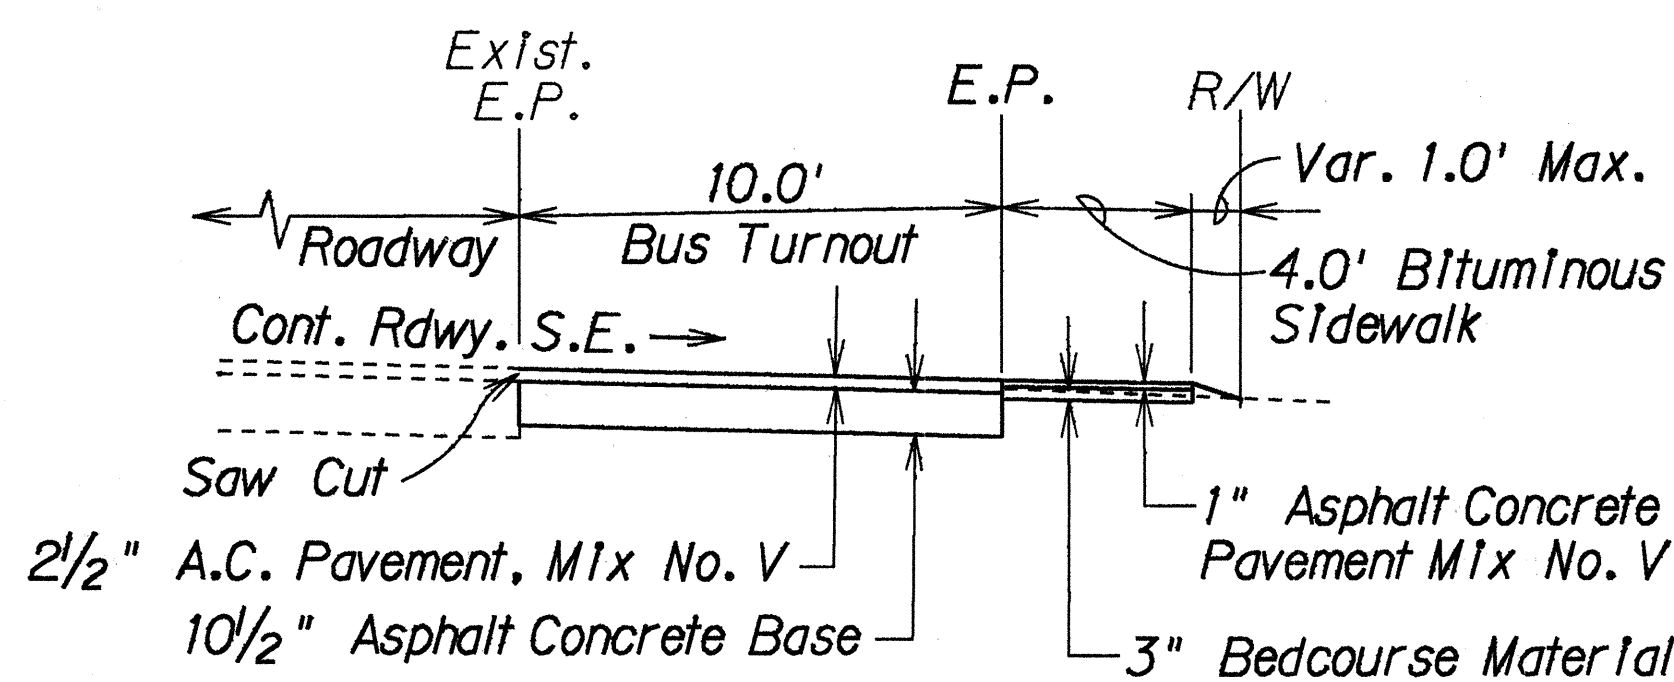

SECTION B
Scale: 1/4" = 1'-0"

BUS TURNOUT DETAIL

STATE OF HAWAII
DEPARTMENT OF TRANSPORTATION
HIGHWAYS DIVISION

TYPICAL SECTIONS
KAMEHAMEHA HIGHWAY
Sidewalk From Shopping Center to
Hauula Elementary School
PROJECT NO. 83C-03-89

Scale: As Shown Date: Jan., 1990
SHEET No. 1 OF 1 SHEETS