

STATE OF HAWAII

DEPARTMENT OF TRANSPORTATION HIGHWAYS DIVISION

HONOLULU, HAWAII

"AS-BUILT"


PLANS FOR


KAMEHAMEHA HIGHWAY STREET LIGHTS

LAIE BRIDGE

TO

MALAEKAHANA STATE PARK PROJECT NO. 83C-01-88

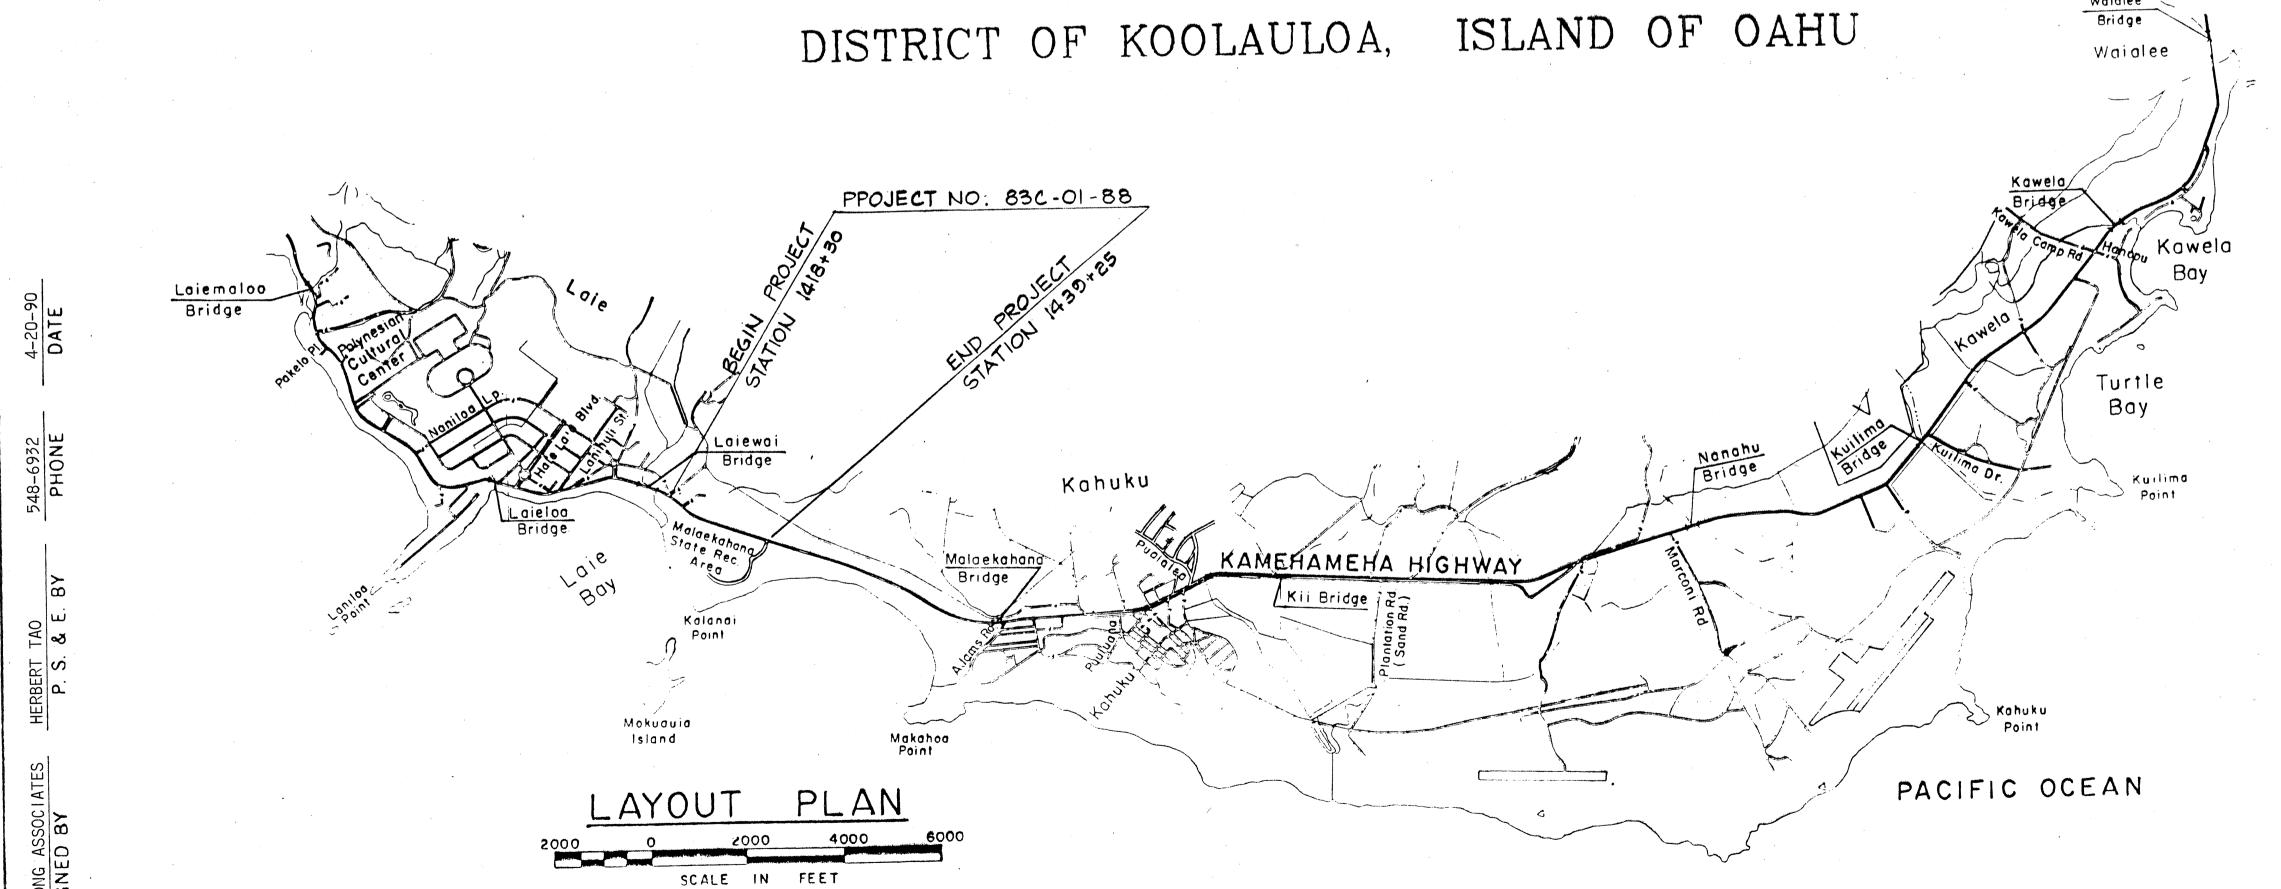

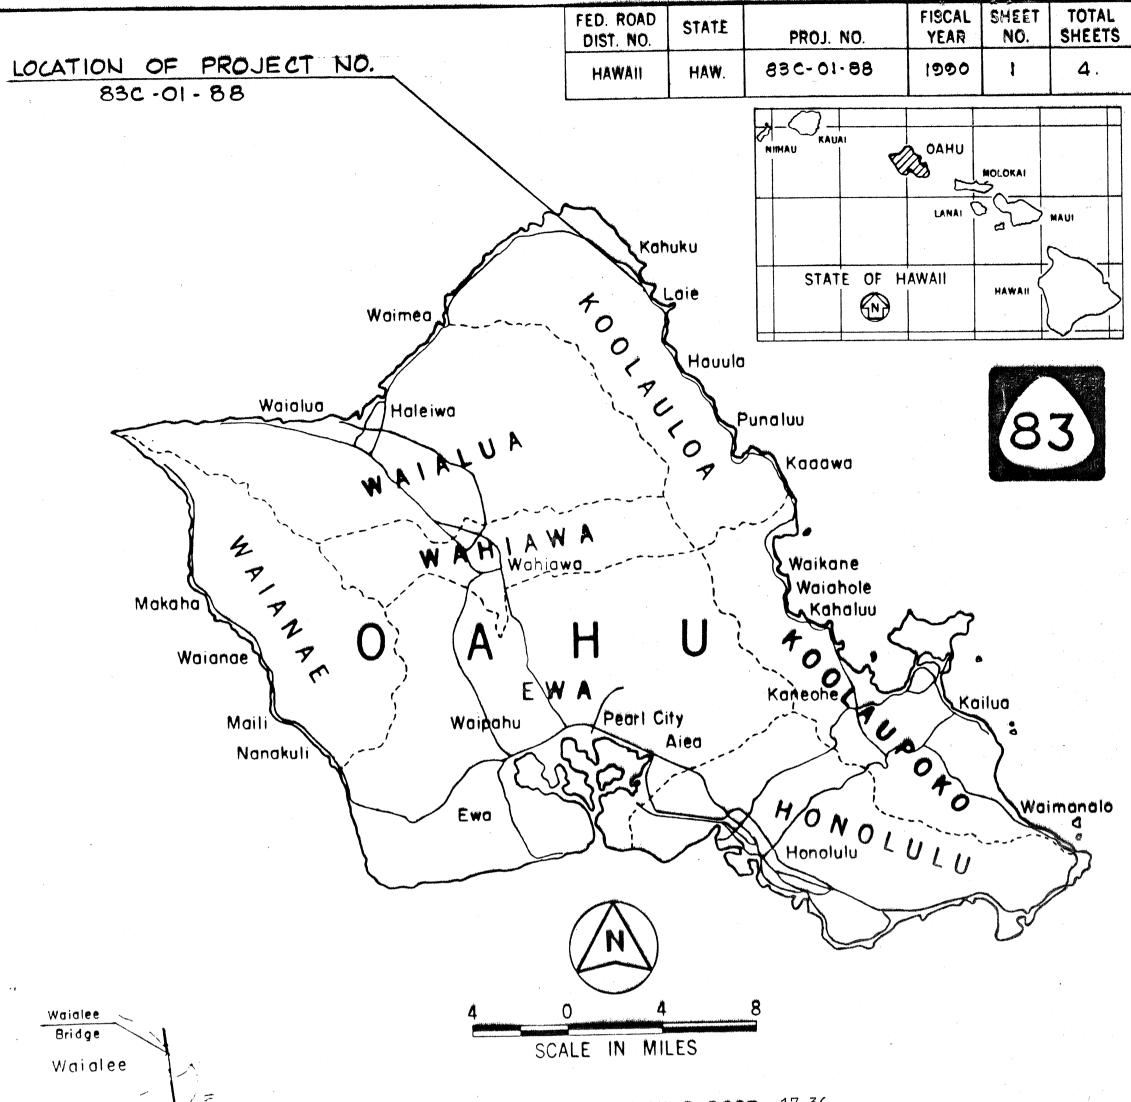

MILE POST 17.75 TO MILE POST 17.36

NOTE:

ALL CHANGES MADE DURING CONSTRUCTION HAVE BEEN NOTED IN RED ON THESE TRACINGS AND

CHECKED BY:

RESIDENT ENGINEER

DATE

DIR. OF TRANSPORTATION DATE