


FED. ROAD DIST. NO.	STATE	FED. AID PROJ. NO.	FISCAL YEAR	SHEET NO.	TOTAL SHEETS
HAWAII	HAW.	F-083-1(24)	1990	2	125

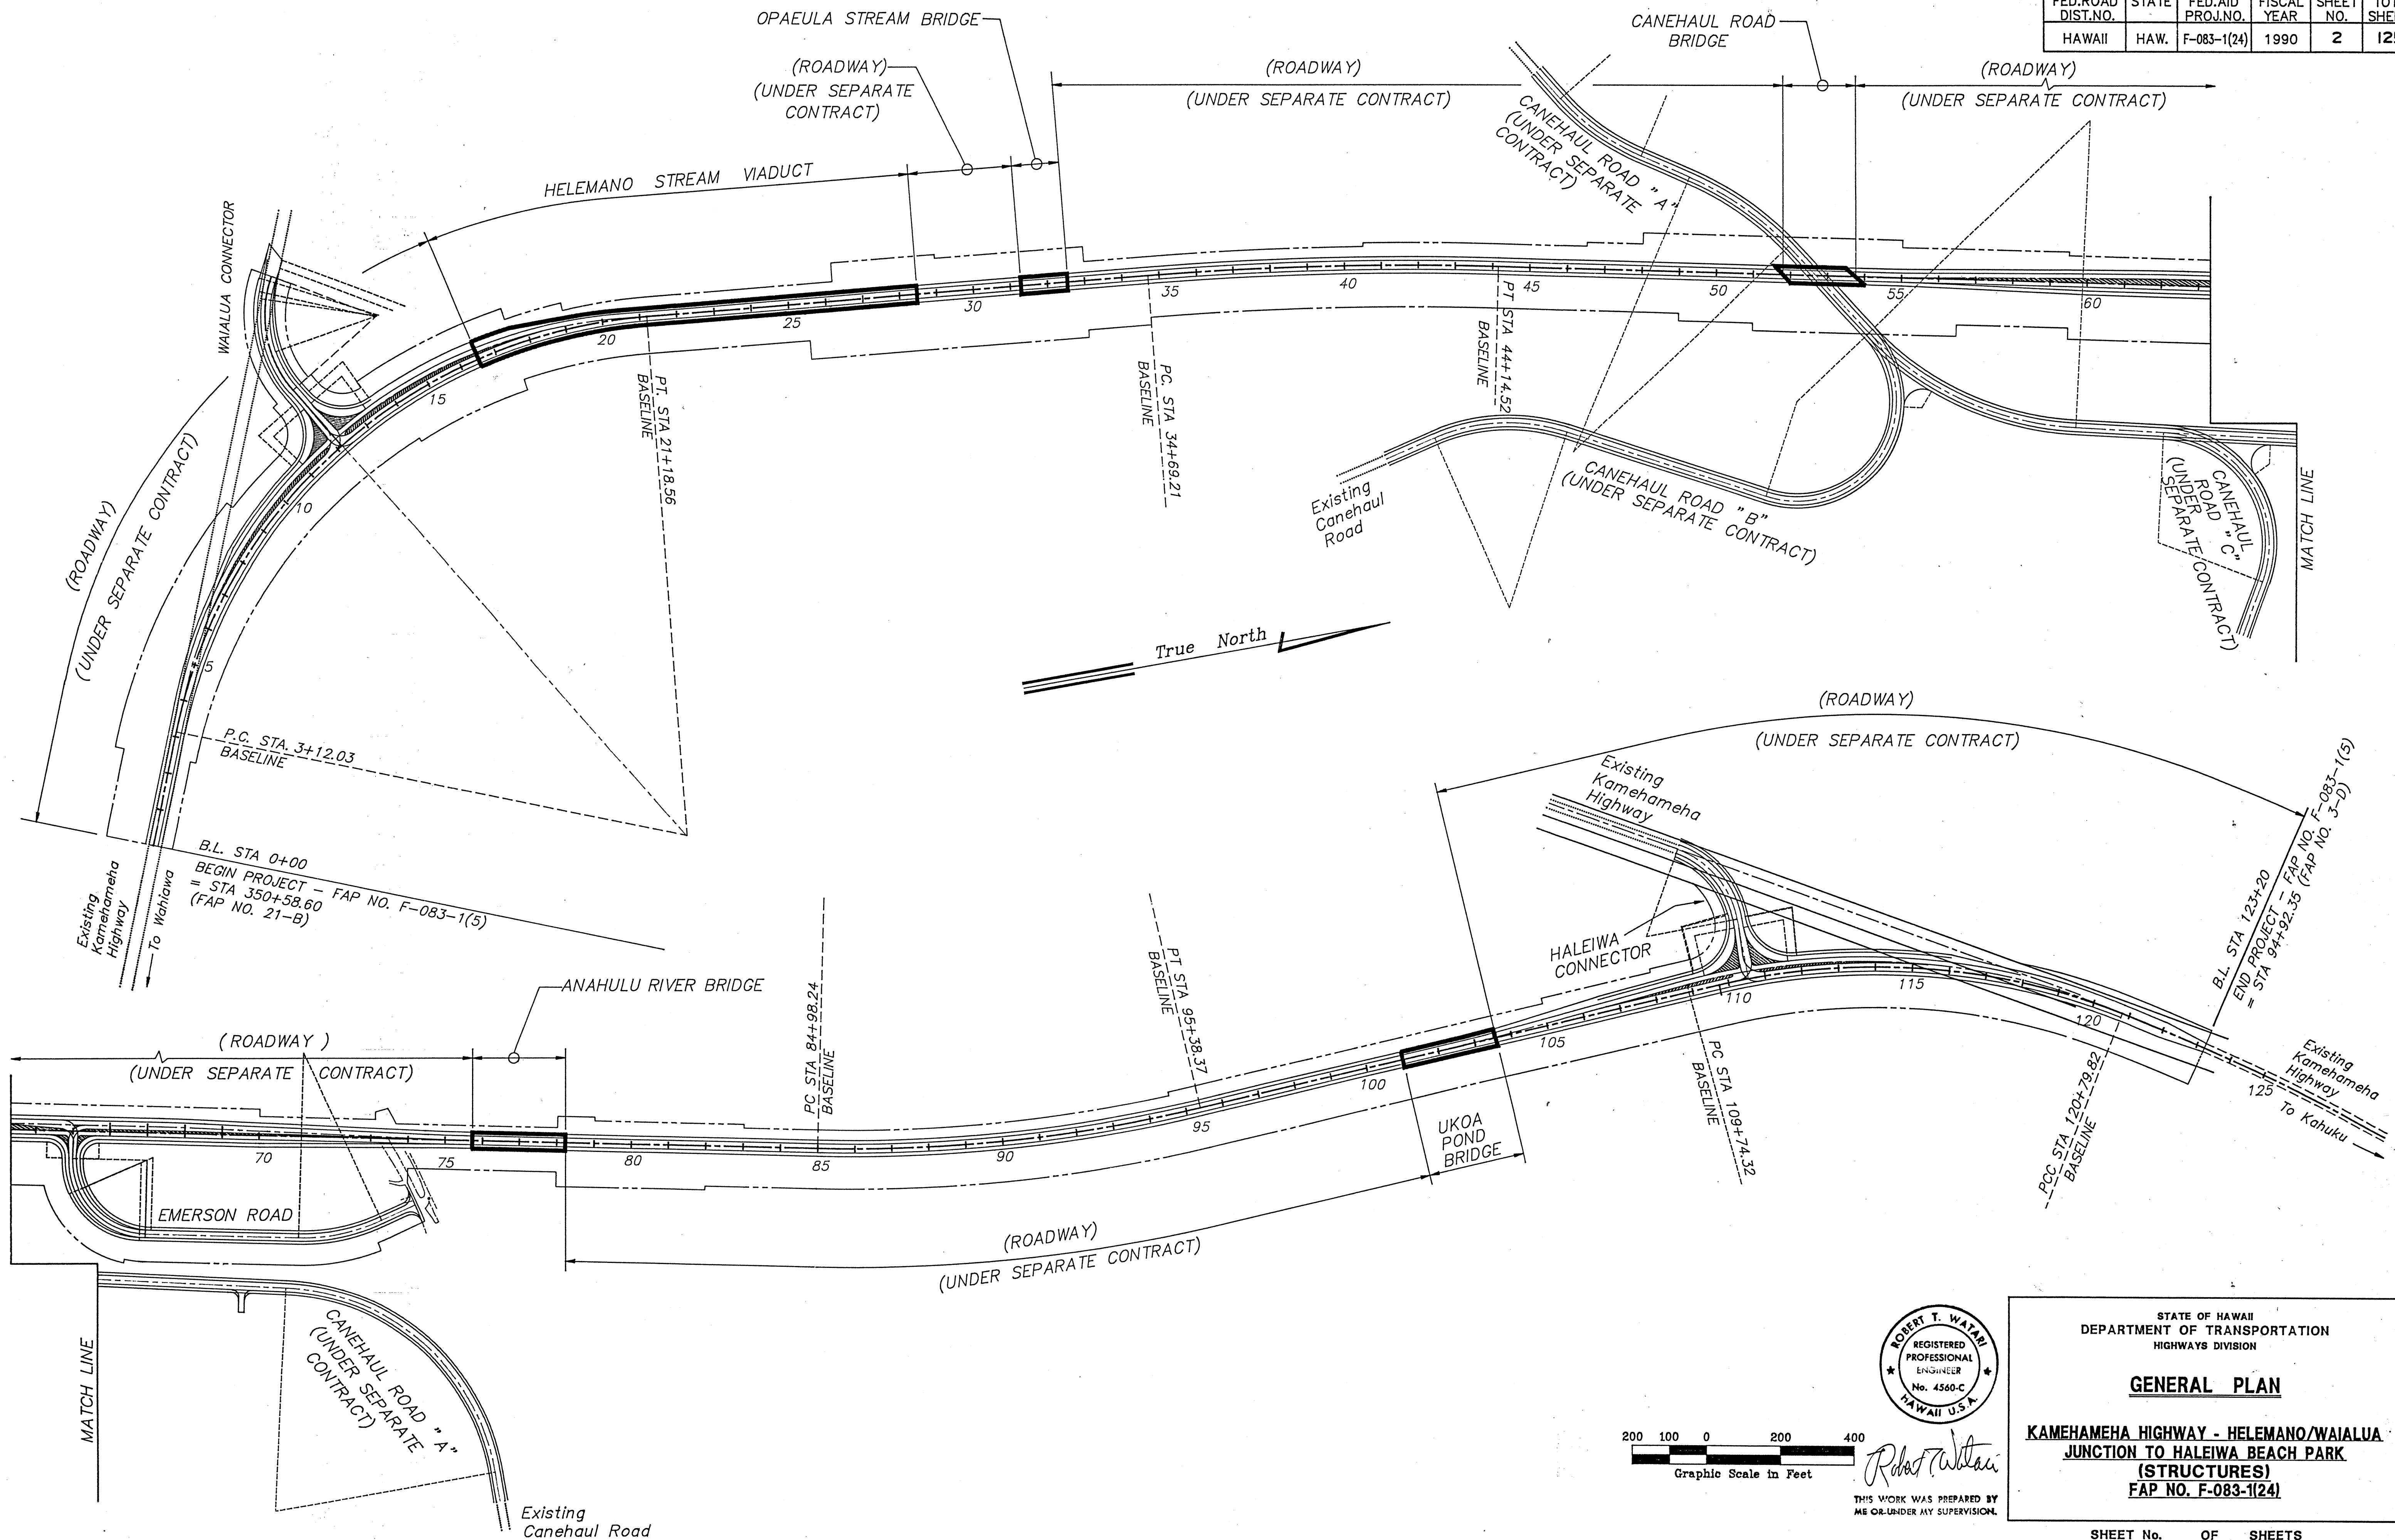

DATE	BY
DESIGNED BY	
TRACED BY	
NOTED BY	
CHECKED BY	
APPROVED BY	

88-68 File GEN-2B.DWG Disk: Haleiwa(6) 5-31-90