


INDEX TO DRAWINGS	
SHEET NO.	DESCRIPTION
1	TITLE SHEET
2	GENERAL PLAN
3	NOTES
4	BASELINE DATA SHEET
5	STANDARD PLANS SUMMARY
6-18	PLAN & PROFILE - BY-PASS ROAD
19	PLAN & PROFILE - WAIALUA CONNECTOR ROAD
20	PLAN & PROFILE - HALEIWA CONNECTOR ROAD
21	PLAN & PROFILE - EMERSON ROAD
22-25	PLAN & PROFILE - CANE HAUL ROAD A
26-27	PLAN & PROFILE - CANE HAUL ROAD B
28	PLAN & PROFILE - CANE HAUL ROAD C
29-37	GRADING PLANS
38-45	BORING LOGS
46-47	SUPER ELEVATIONS
48	INDEX TO STRUCTURAL DRAWINGS - HELEMANO STREAM VIADUCT & OPAEULA STREAM
49-82	HELEMANO STREAM VIADUCT
83-87	OPAEULA STREAM BRIDGE
88-91	DETAILS-HELEMANO BRIDGE/OPAEULA BRIDGE
92	INDEX TO STRUCTURAL DRAWINGS - CANEHAUL ROAD BRIDGE, ANAHULU RIVER BRIDGE & UKOA POND BRIDGE
93	ESTIMATED QUANTITIES
94-100	CANEHAUL ROAD BRIDGE
101-103	ANAHULU RIVER BRIDGE
104-107	UKOA POND BRIDGE
108-117	DETAILS - CANEHAUL ROAD BRIDGE, ANAHULU RIVER BRIDGE & UKOA POND BRIDGE
118-125	TYPICAL DETAILS

Plan Sheet Nos. A, C, O, 31A, C, O, 72A, C, O, 117A,
and C, O, 121S-1 are supplemental sheets to
the contract plans.
New total after "As-Built" Posting is 129.

STATE OF HAWAII
DEPARTMENT OF TRANSPORTATION
HIGHWAYS DIVISION
HONOLULU, HAWAII
"AS-BUILT"
PLANS FOR
CONSTRUCTION OF
KAMEHAMEHA HIGHWAY
HELEMANO/WAIALUA JUNCTION
TO HALEIWA BEACH PARK
(STRUCTURES)
FEDERAL AID PROJECT NO. F-083-1(24)
DISTRICT OF WAIALUA
ISLAND OF OAHU


FED. ROAD DIST. NO.	STATE	FED. AID PROJ. NO.	FISCAL YEAR	SHEET NO.	TOTAL SHEETS
HAWAII	HAW.	F-083-1(24)	1990	1	125

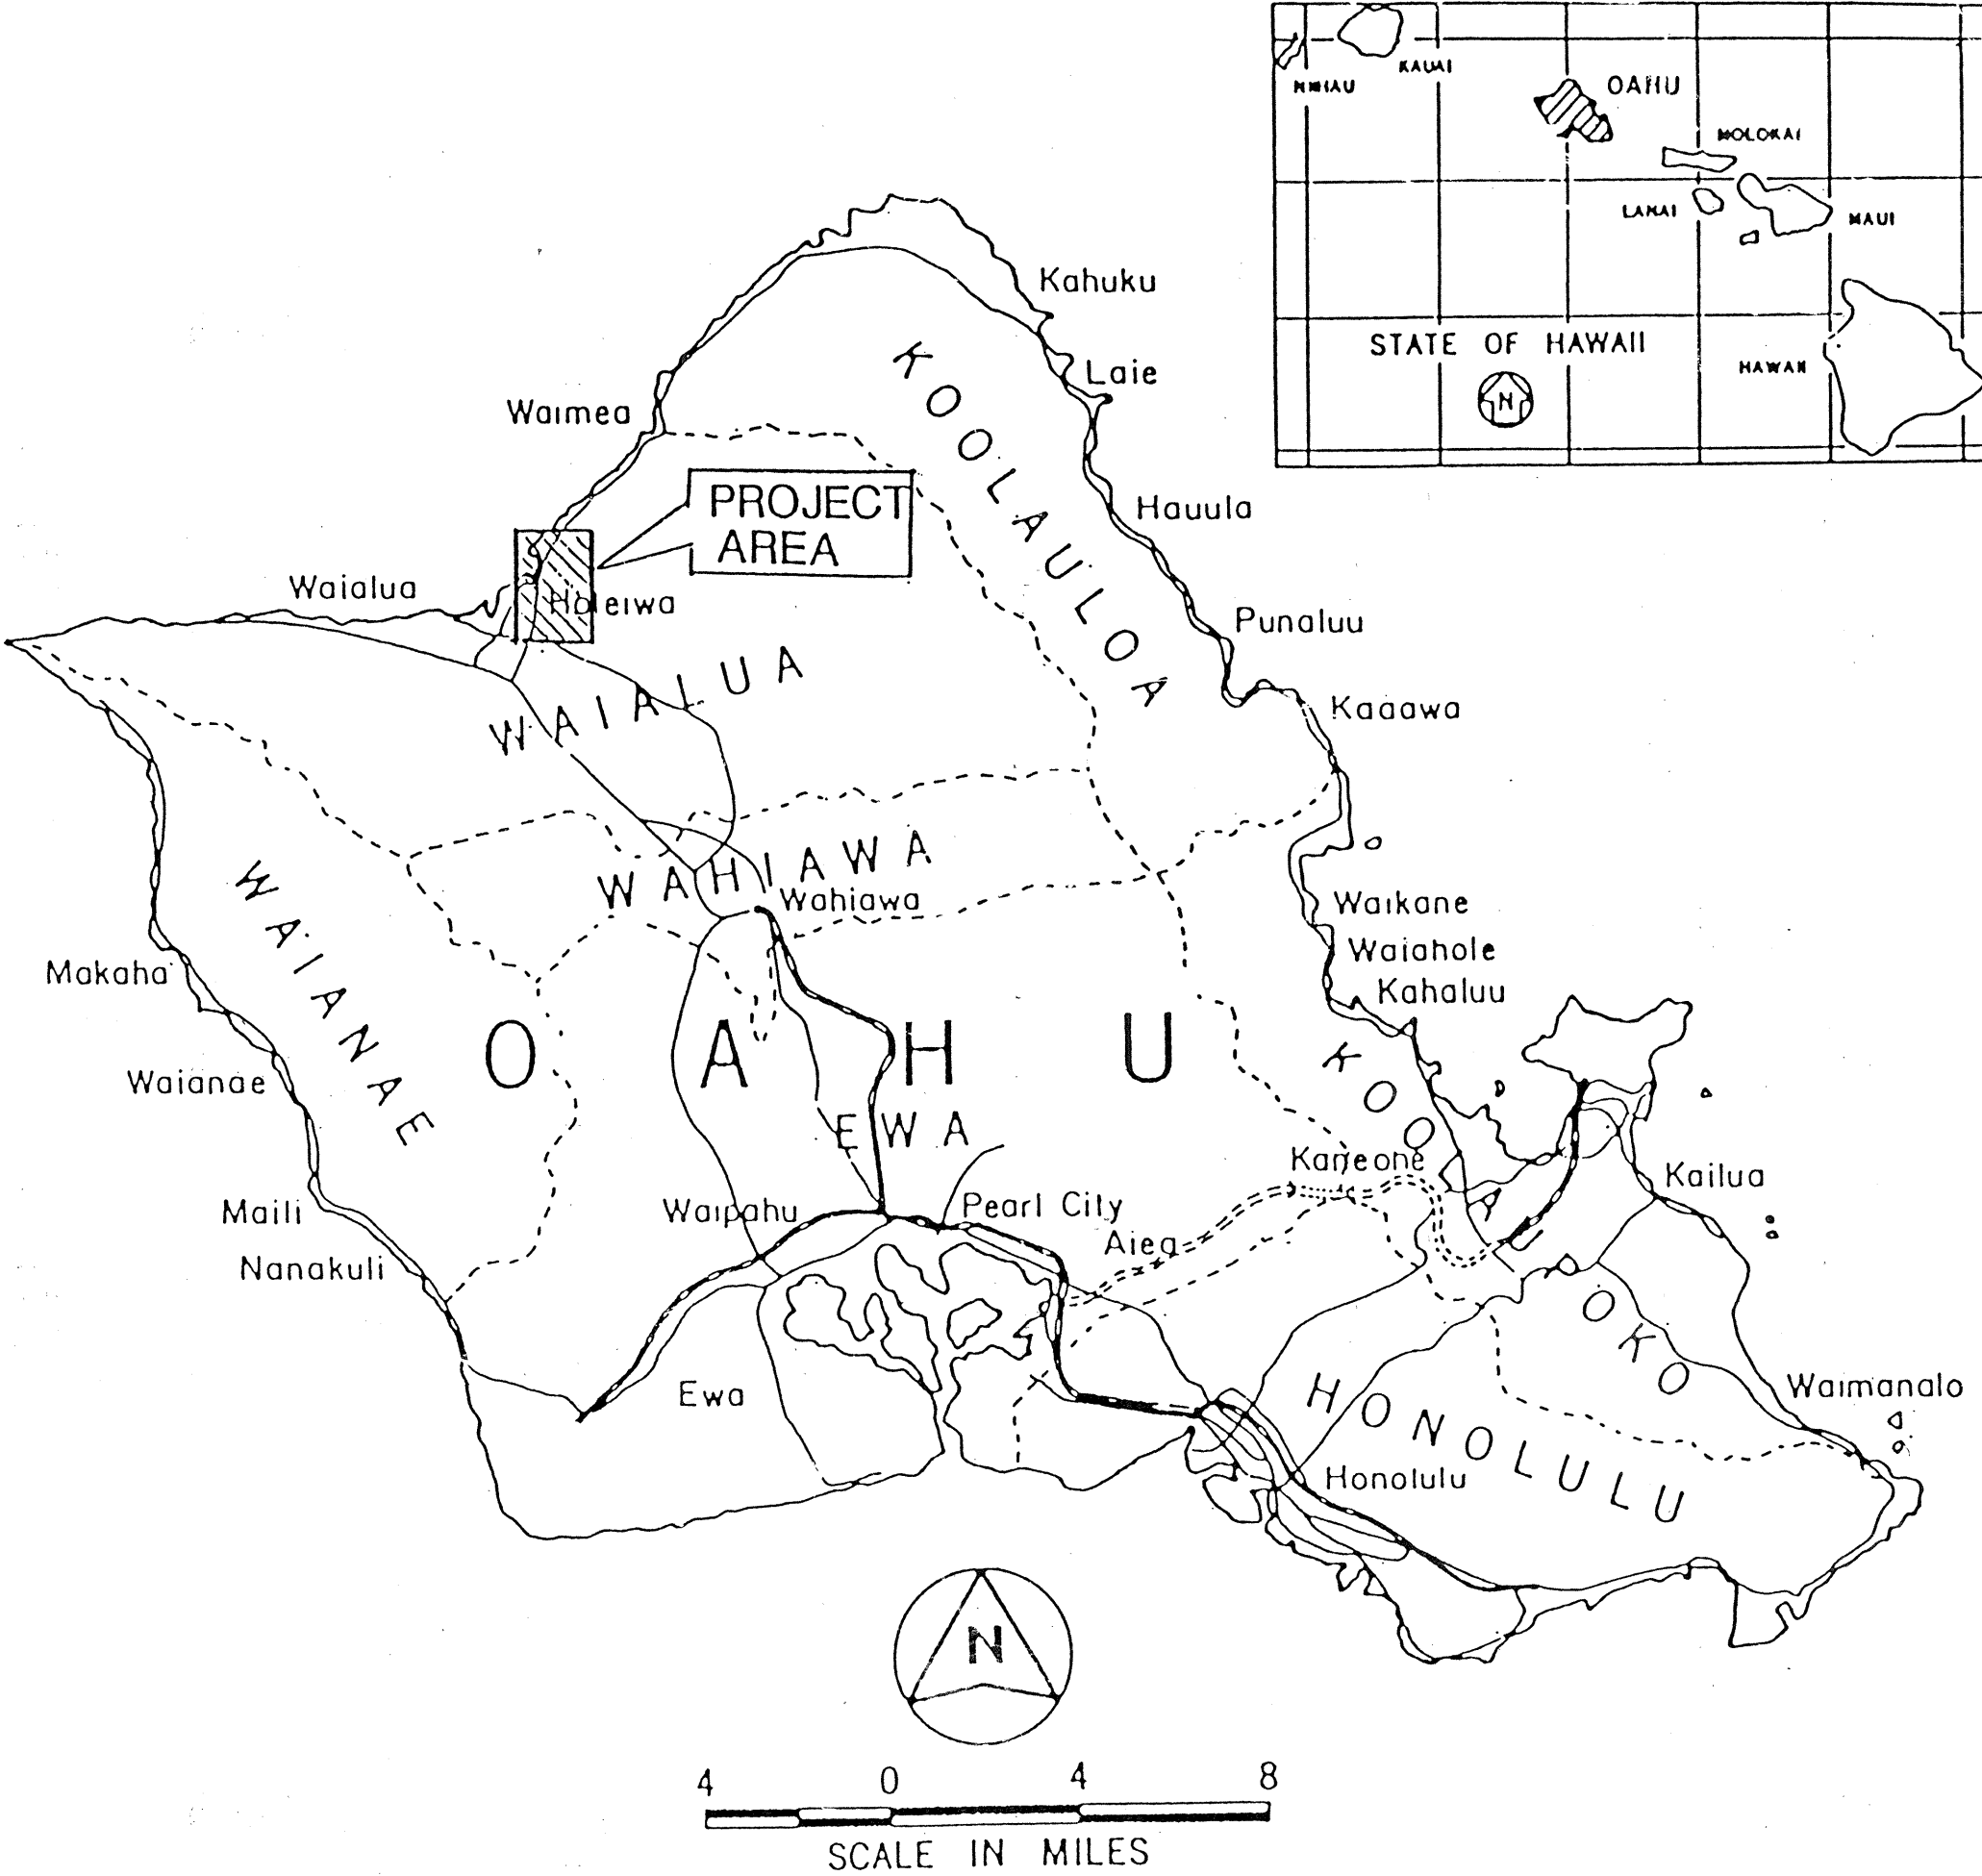

VICINITY MAP
TMK'S: 6-2-01 THRU 07, 12 AND 6-4-01

DESIGN DESIGNATION	
DESIGN ADT (2001)	23,000
DHV	1,780
D	55/40
T	3%
T ₂₄	5%
V	60 MPH

ENGINEERS
SURVEYORS HAWAII
DESIGNED BY:
H. TAO
P.S. & E BY
548-6932
JULY 1, 1990
DATE
PHONE

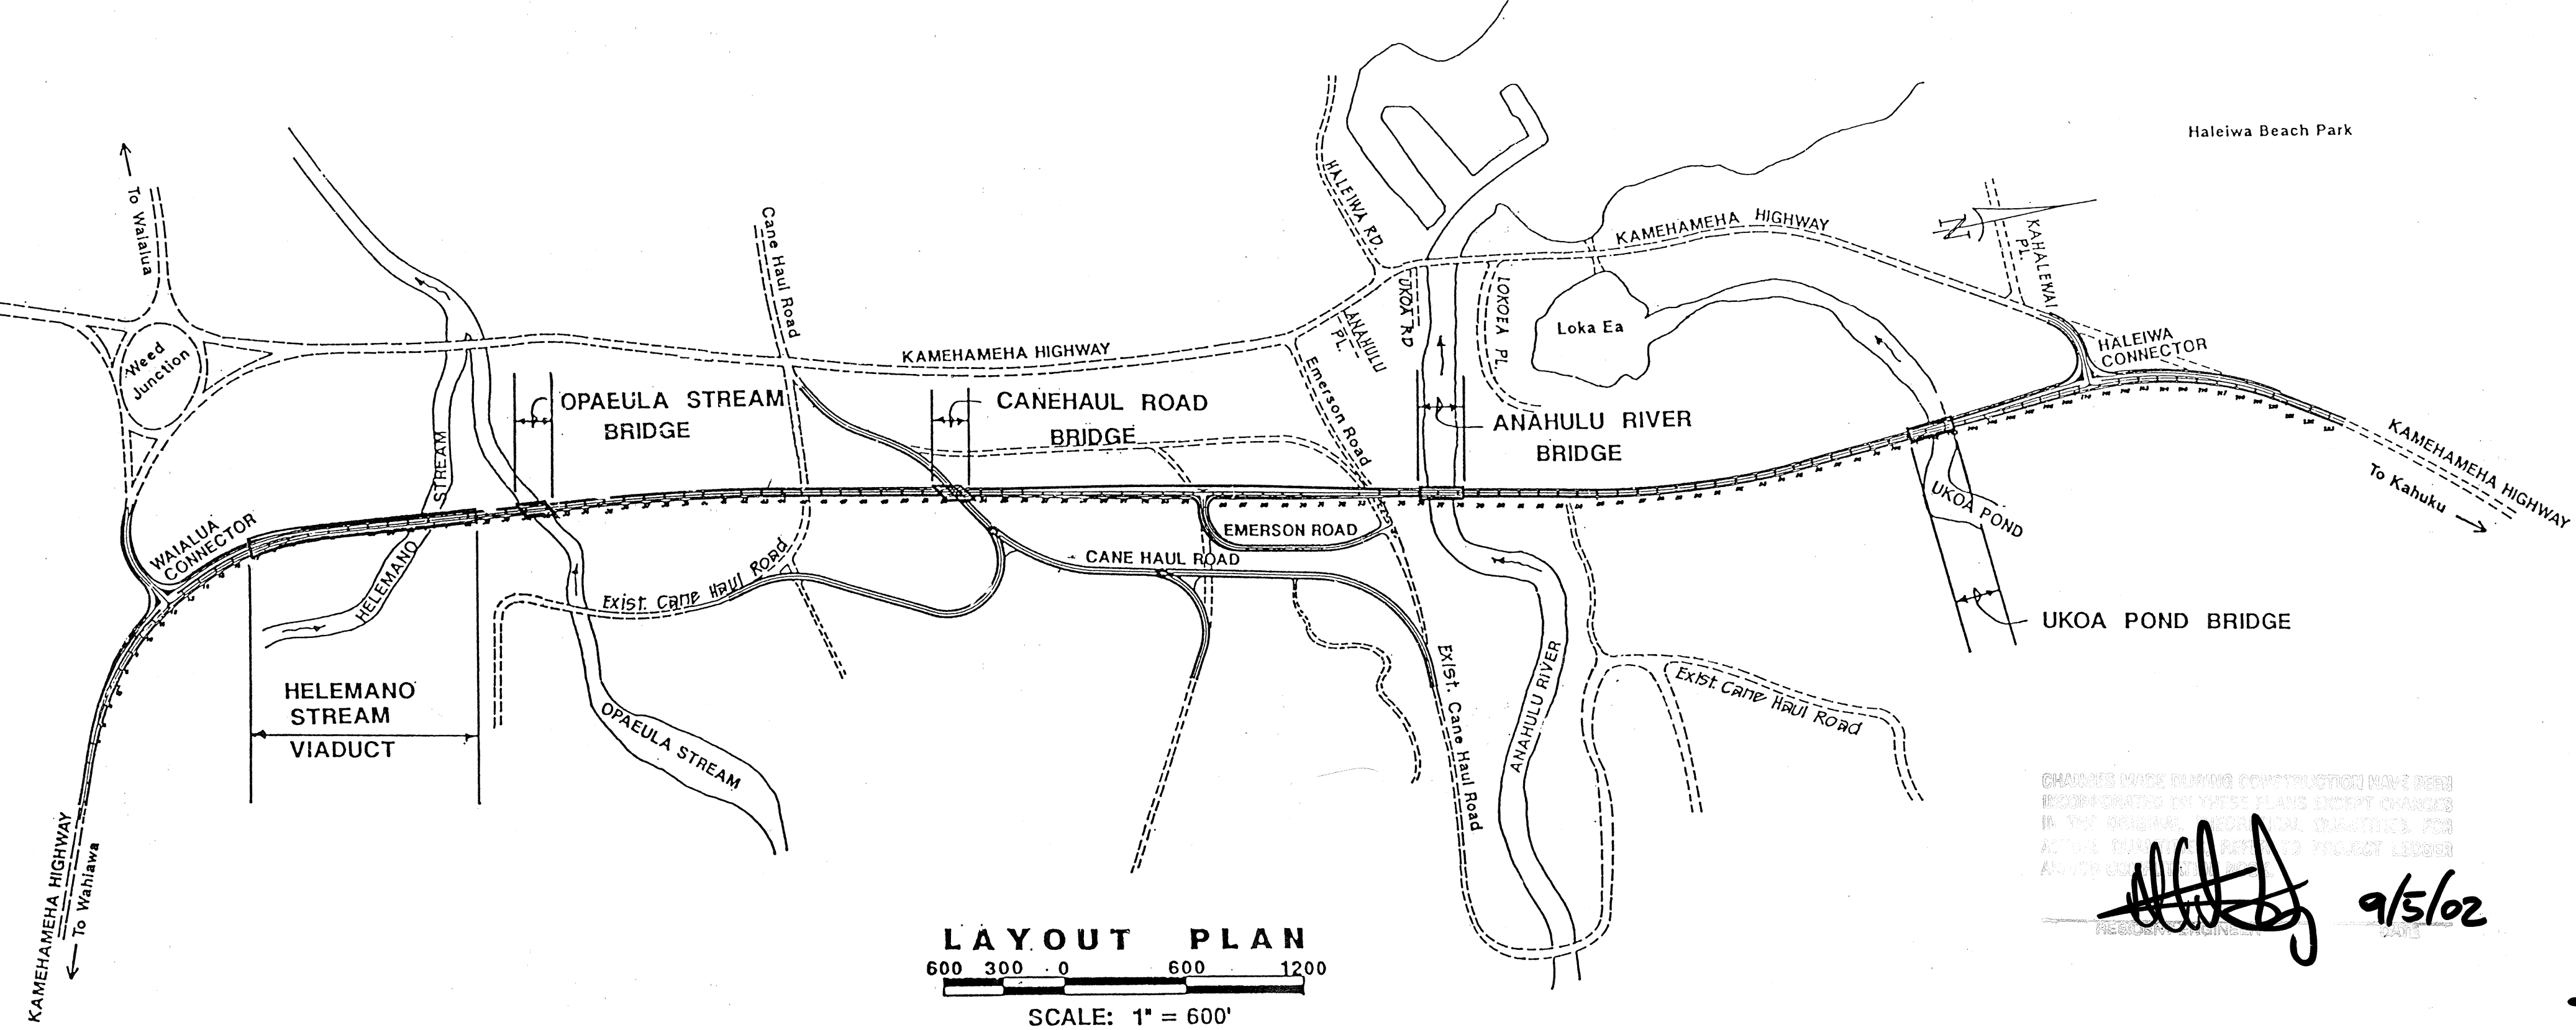

LAYOUT PLAN
600 300 0 600 1200
SCALE: 1" = 600'

CHANGES MADE DURING CONSTRUCTION HAVE BEEN
INCORPORATED IN THESE PLANS. ANY CHANGES
IN THE ORIGINAL CONTRACT DOCUMENTS FOR
THIS PROJECT SHALL BE THE RESPONSIBILITY OF THE
OWNER. THE CONTRACTOR SHALL BE RESPONSIBLE FOR
OBTAINING THE NECESSARY PERMITS AND APPROVALS
FOR THE CONSTRUCTION OF THIS PROJECT.
9/5/02

DEPARTMENT OF TRANSPORTATION
FEDERAL HIGHWAY ADMINISTRATION
APPROVED:
[Signature] 11/1/90
DIVISION ADMINISTRATOR DATE

DEPARTMENT OF TRANSPORTATION
STATE OF HAWAII
APPROVED:
[Signature] 10/24/90
DIR. OF TRANSPORTATION DATE