	INDEX TO DRAWINGS
SHEET NO.	DESCRIPTION
1	TITLE SHEET
2	STANDARD PLAN SUMMARY
3	NOTES
4	TRAFFIC SIGNAL SYSTEM PLAN
5-6	PAVEMENT STRIPING/MARKING
, °.	& SIGNING PLAN
7	MISCELLANEOUS DETAILS
8	SENSOR LOOP DETAILS
;	

STATE OF HAWAII

DEPARTMENT OF TRANSPORTATION
HIGHWAYS DIVISION
HONOLULU, HAWAII


HONOLULU, HAWAII
"AS-BUILT"
PLANS FOR

KAHEKILI HIGHWAY

TRAFFIC SIGNALS AND IMPROVEMENTS
AT AHUIMANU ROAD AND AHAOLELO ROAD

PROJECT NO. 83F-02-91

DISTRICT OF KOOLAUPOKO
ISLAND OF OAHU

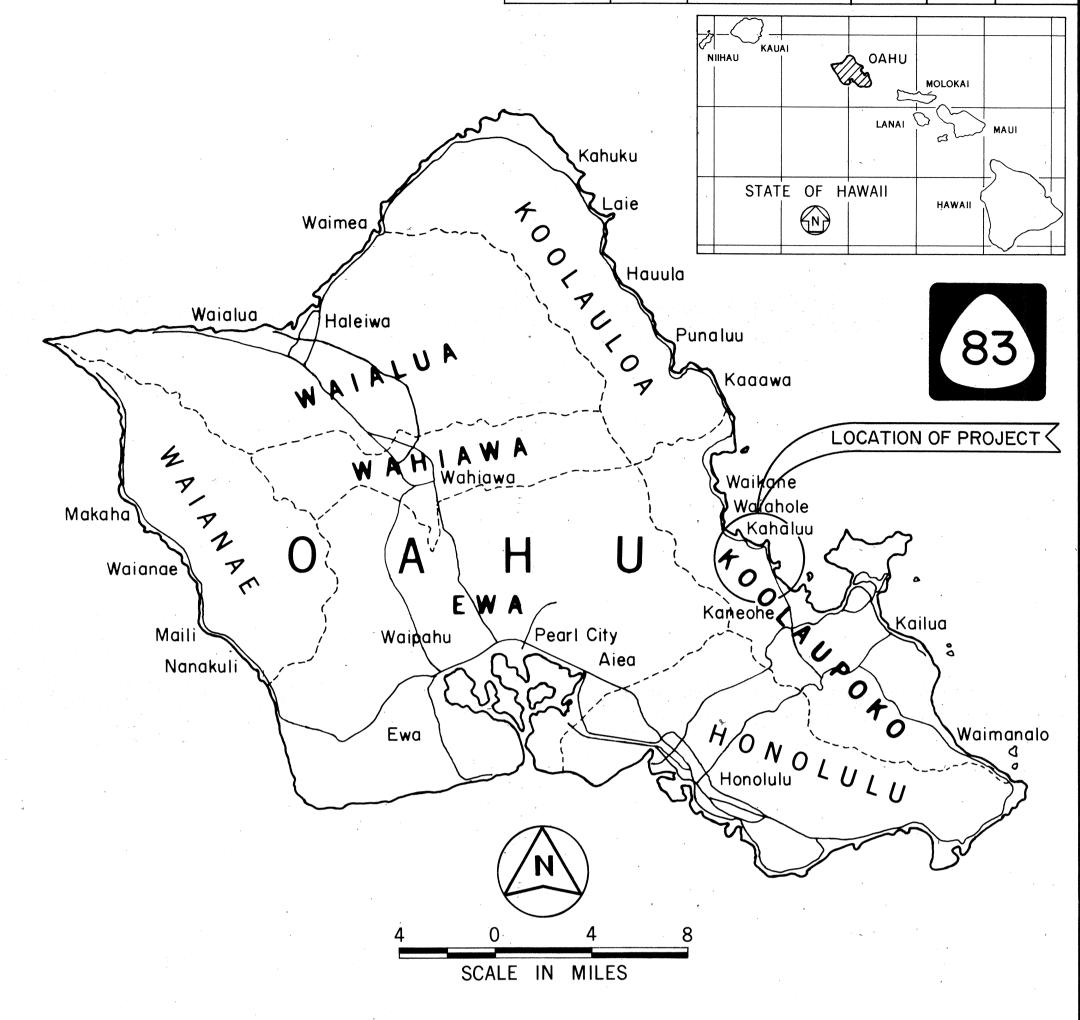

MILE POST _____ TO MILE POST _____

VALLEY OF THE TEMPLES MEM PARK MEM PARK

TMK: 4-7-02,04,25 & 37

CHANGES MADE DURING CONSTRUCTION HAVE BEEN INCORPORATED ON THESE PLANS EXCEPT CHANGES IN THE ORIGINAL THEORETICAL QUANTITIES. FOR ACTUAL QUANTITIES, REFER TO PROJECT LEDGER AND/OR COMPUTATION BOOK.

For RESIDENT ENGINEER DATE

DEPARTMENT OF TRANSPORTATION
STATE OF HAWAII

APPROVED:

JOLISTA

DIR. OF TRANSPORTATION

DATE