
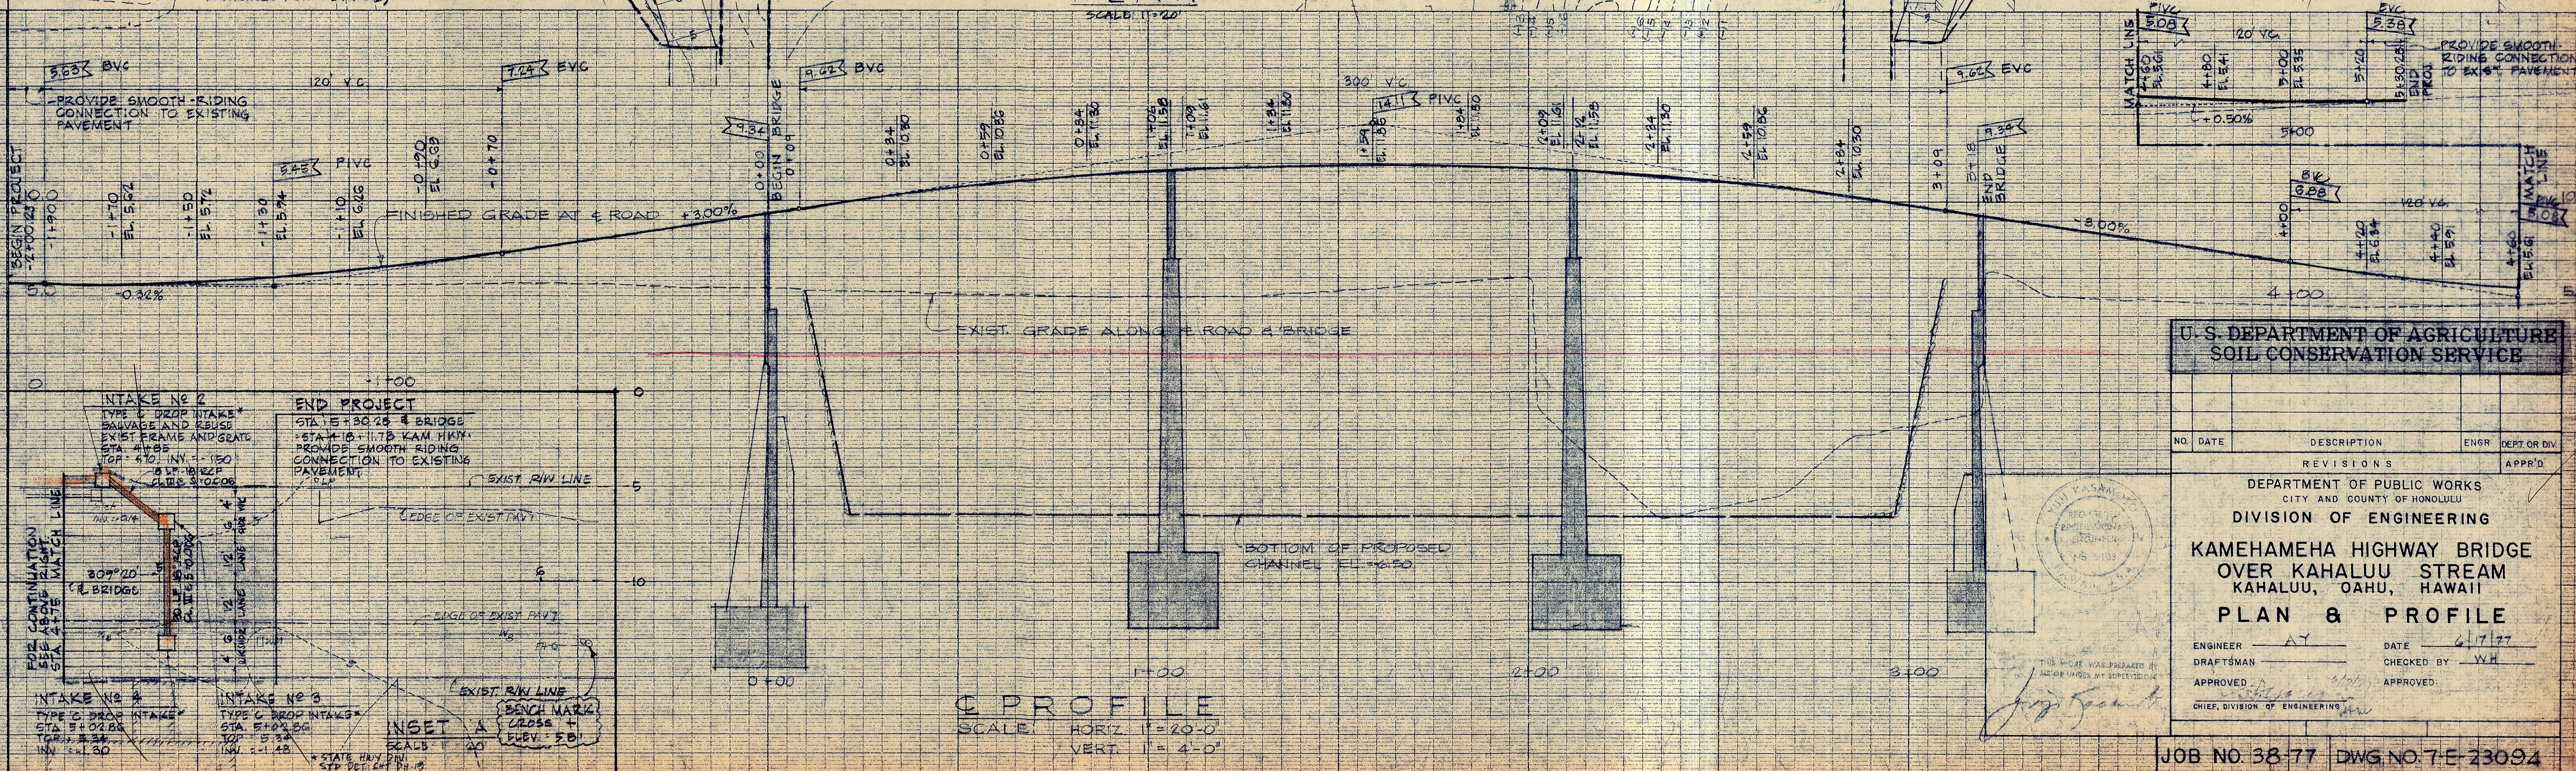


CURVE DATA				
CURVE NO.	1	2	3	4
Δ	0° 50'	110° 30'	69° 30'	
A/2	0° 25'	55° 15'	34° 45'	
R	5730.00	20.00	20.00	
T	41.67	28.83	13.87	
Ch	83.34	32.87	22.80	
L	83.34	38.57	24.26	

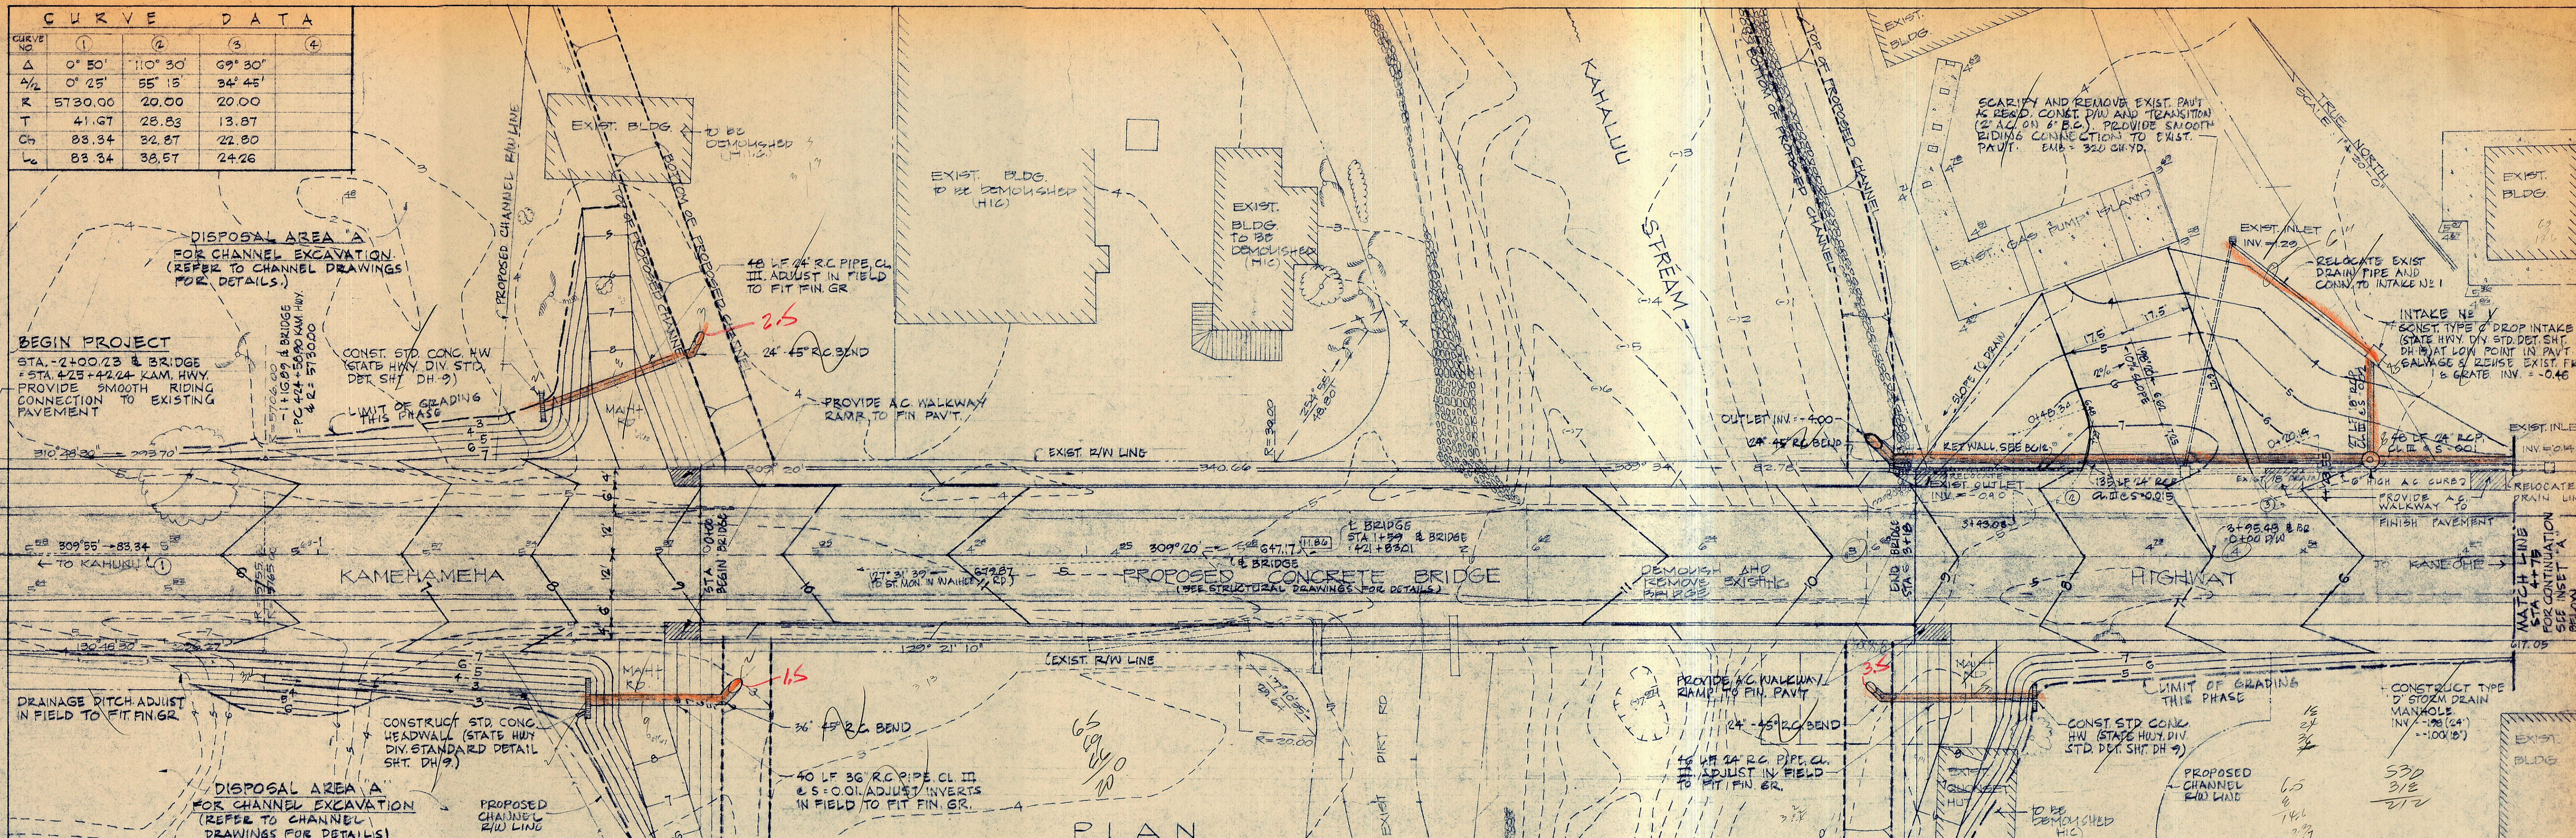

U.S. DEPARTMENT OF AGRICULTURE SOIL CONSERVATION SERVICE			
NO.	DATE	DESCRIPTION	ENGR. DEPT. OR DIV.
		REVISIONS	APPR'D.
DEPARTMENT OF PUBLIC WORKS CITY AND COUNTY OF HONOLULU DIVISION OF ENGINEERING			
KAMEHAMEHA HIGHWAY BRIDGE OVER KAHALUU STREAM KAHALU, OAHU, HAWAII			
PLAN & PROFILE			
ENGINEER	AT	DATE	6/7/77
DRAFTSMAN		CHECKED BY	YH
APPROVED		APPROVED	
CHIEF, DIVISION OF ENGINEERING			
JOB NO. 38-77 DWG. NO. 7-E-23094			