


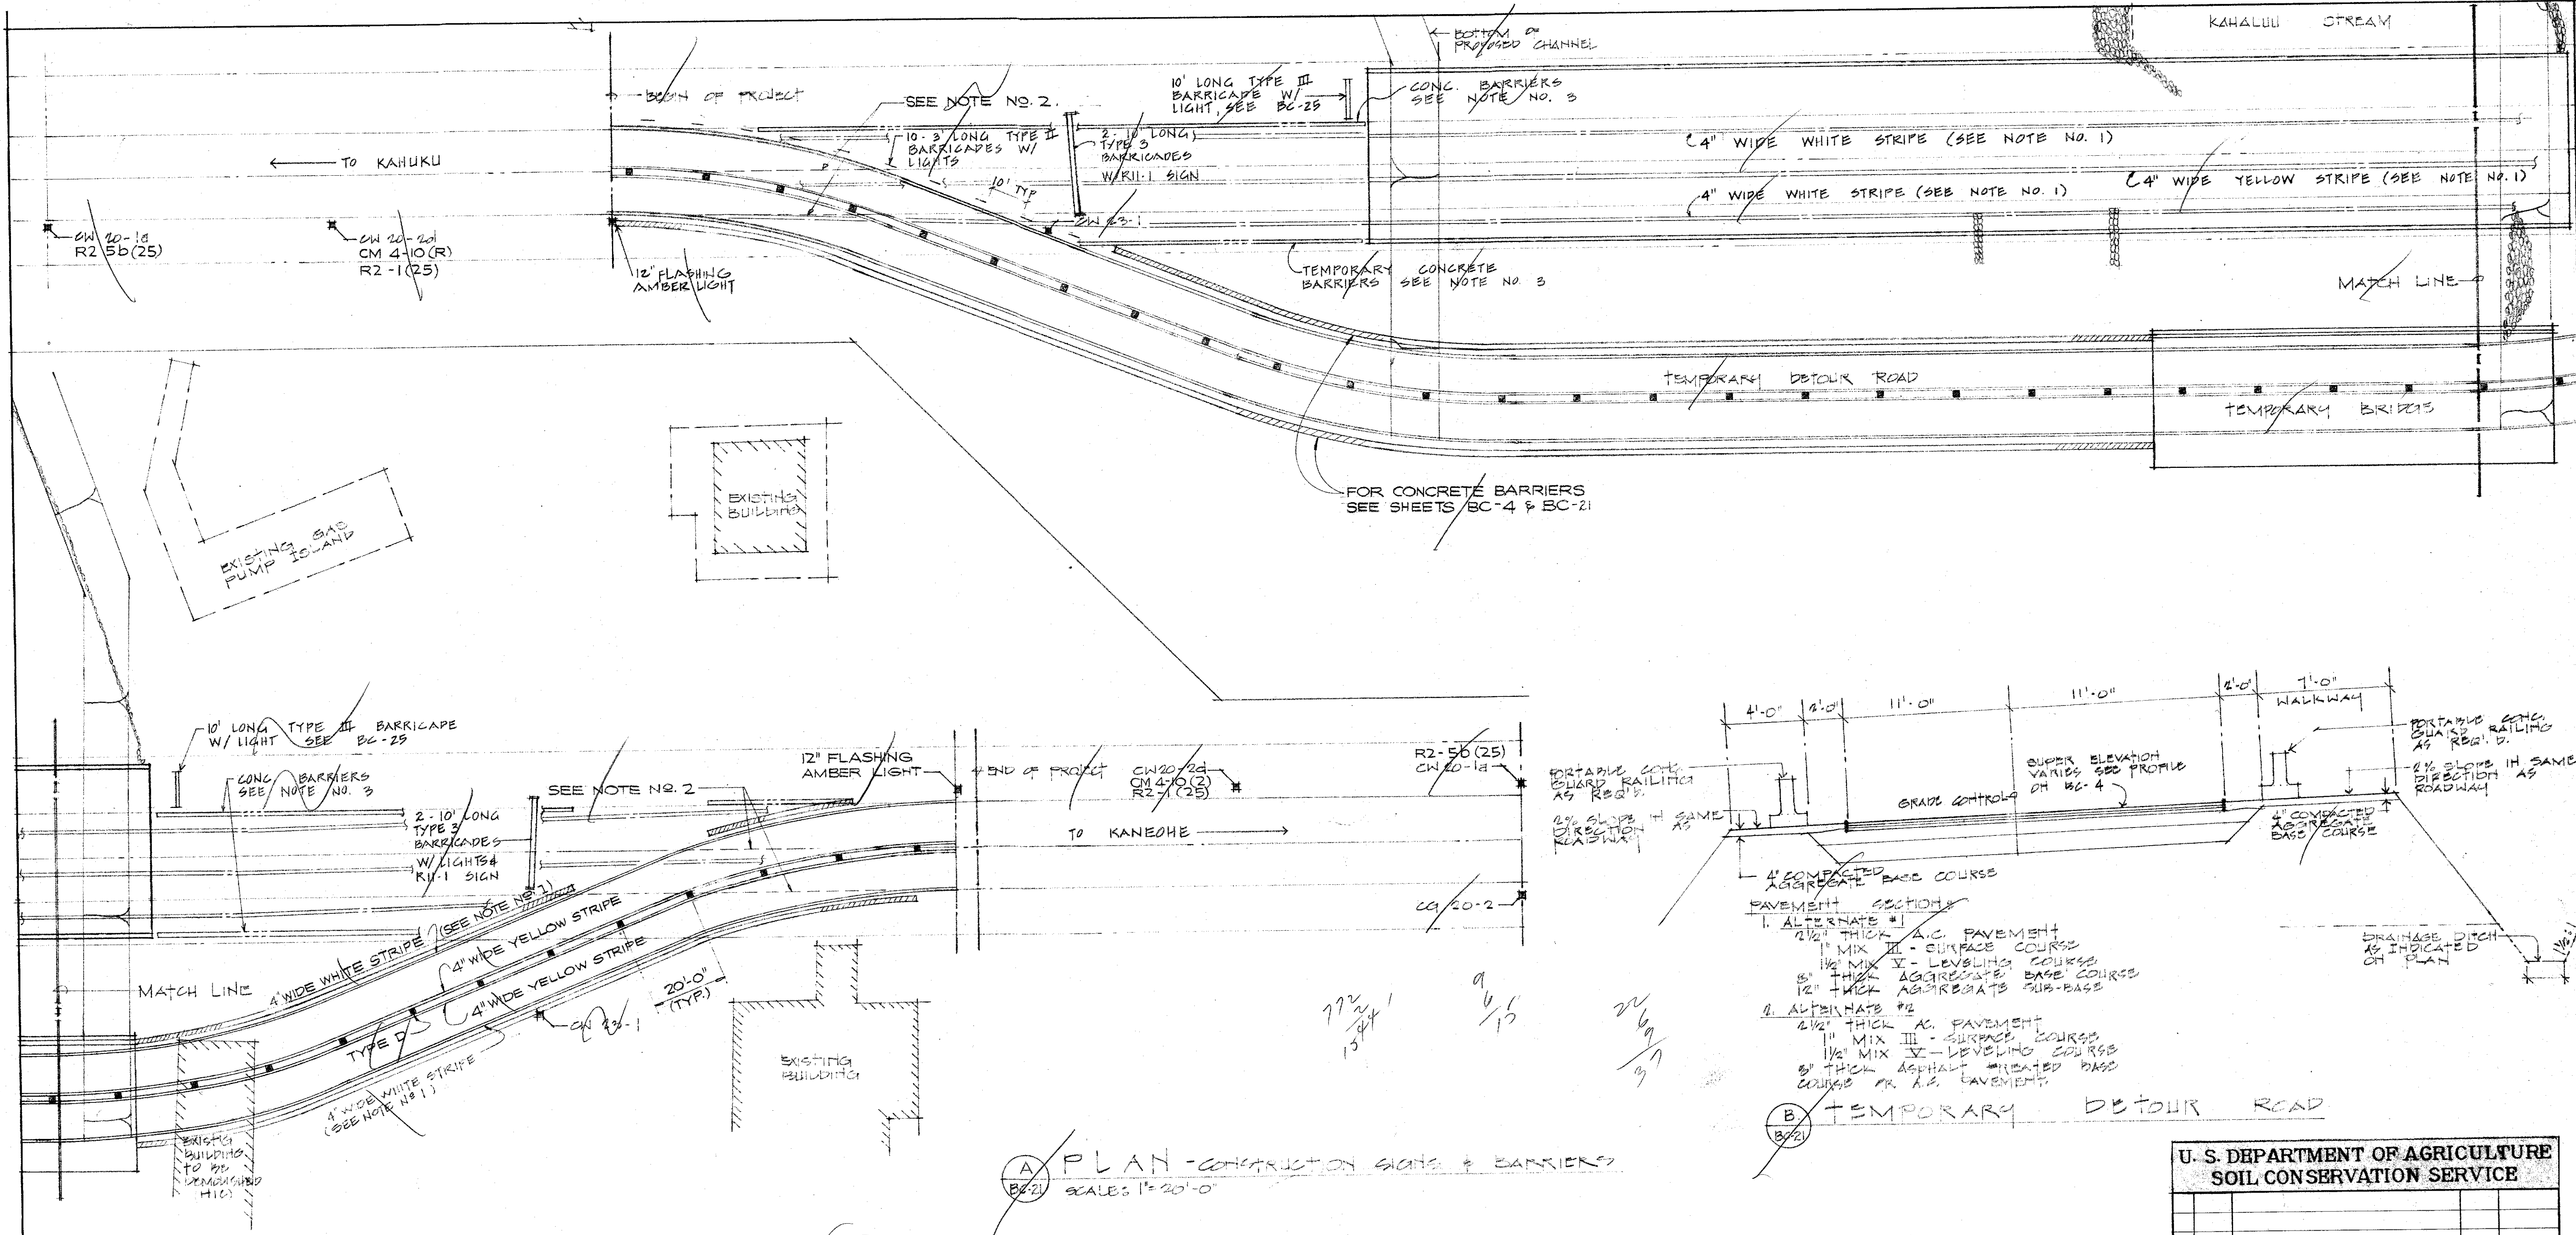

NOTES:

1. TEMPORARY PAVEMENT MARKINGS SHALL BE REFLECTORIZED MARKING TAPE, IF OVER PERMANENT PAVEMENT.
2. REMOVE EXISTING PAVEMENT MARKINGS BY REPAVING, SAND BLASTING OR GRINDING. DO NOT PAINT OVER.
3. CONCRETE BARRIERS SHALL BE RELOCATED TO LOCATIONS SHOWN. BARRIERS SHALL REMAIN UNTIL GUARD RAILS ARE INSTALLED.

LEGEND

- | | |
|--|---|
| | PAVEMENT STRIPING DURING CONSTRUCTION PHASE 2 |
| | CONCRETE BARRIERS DURING CONSTRUCTION PHASE 2 |
| | PAVEMENT STRIPING DURING CONSTRUCTION PHASE 3 |
| | CONCRETE BARRIERS DURING CONSTRUCTION PHASE 3 |

- PAVEMENT SECTION
1. ALTERNATE #1
 - 2 1/2" THICK A.C. PAVEMENT
 - 1" MIX III - SURFACE COURSE
 - 1 1/2" MIX V - LEVELING COURSE
 - 8" THICK AGGREGATE BASE COURSE
 - 12" THICK AGGREGATE SUB-BASE
 2. ALTERNATE #2
 - 2 1/2" THICK A.C. PAVEMENT
 - 1" MIX III - SURFACE COURSE
 - 1 1/2" MIX V - LEVELING COURSE
 - 8" THICK ASPHALT TREATED BASE COURSE OR A.C. PAVEMENT

B TEMPORARY DETOUR ROAD

U. S. DEPARTMENT OF AGRICULTURE SOIL CONSERVATION SERVICE

NO.	DATE	DESCRIPTION	ENGR.	DEPT. OR DIV.
REVISIONS				
APPROVED				
DEPARTMENT OF PUBLIC WORKS CITY AND COUNTY OF HONOLULU				
DIVISION OF ENGINEERING				
KAMEHAMEHA HIGHWAY BRIDGE OVER KAHALUU STREAM				
KAHALUU, OAHU, HAWAII				
TEMPORARY ROAD, PAVEMENT STRIPING, SIGNS & CROSS SECTION				
ENGINEER	DATE	CHECKED BY		
DRAFTSMAN	DATE	CHECKED BY		
APPROVED				
CHIEF, DIVISION OF ENGINEERING				

JOB NO. 38-77 DWG. NO. 7-E-23094