
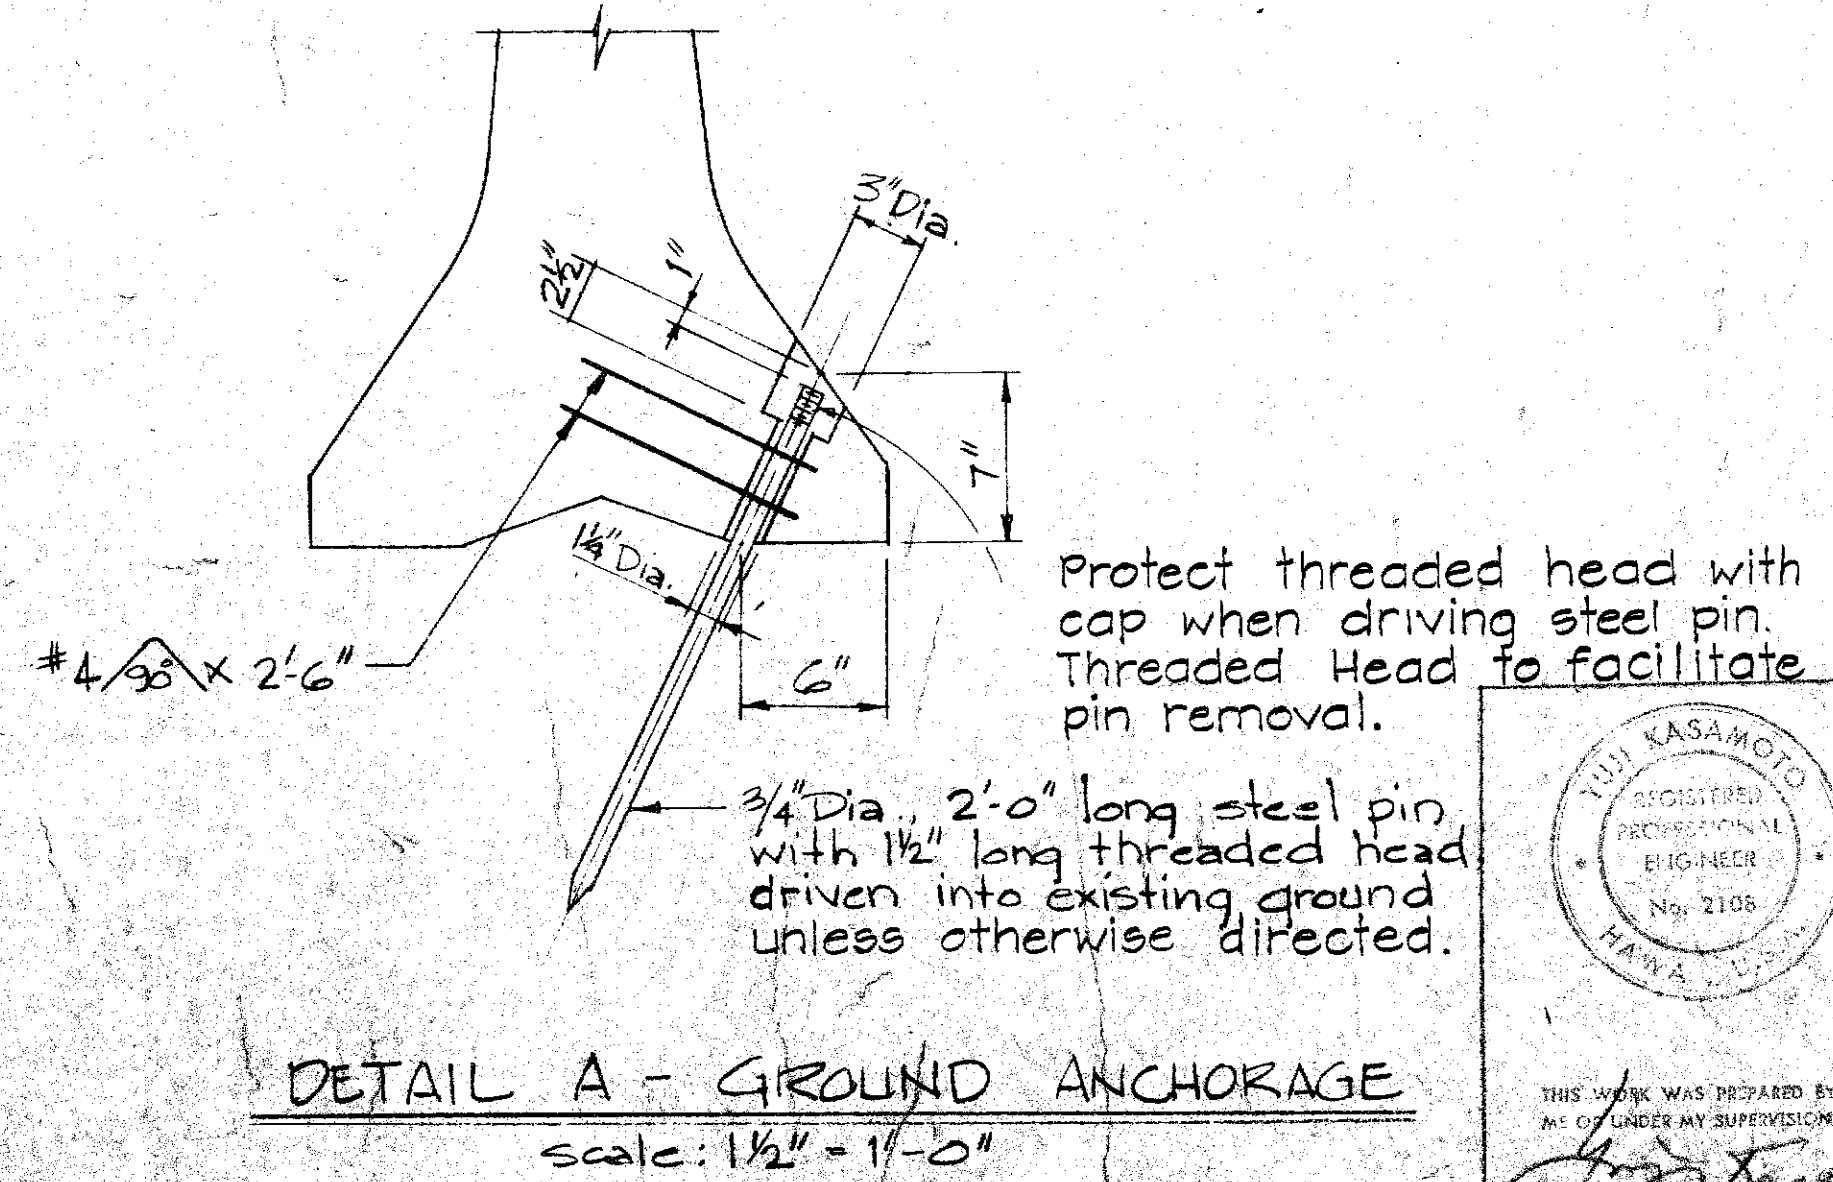
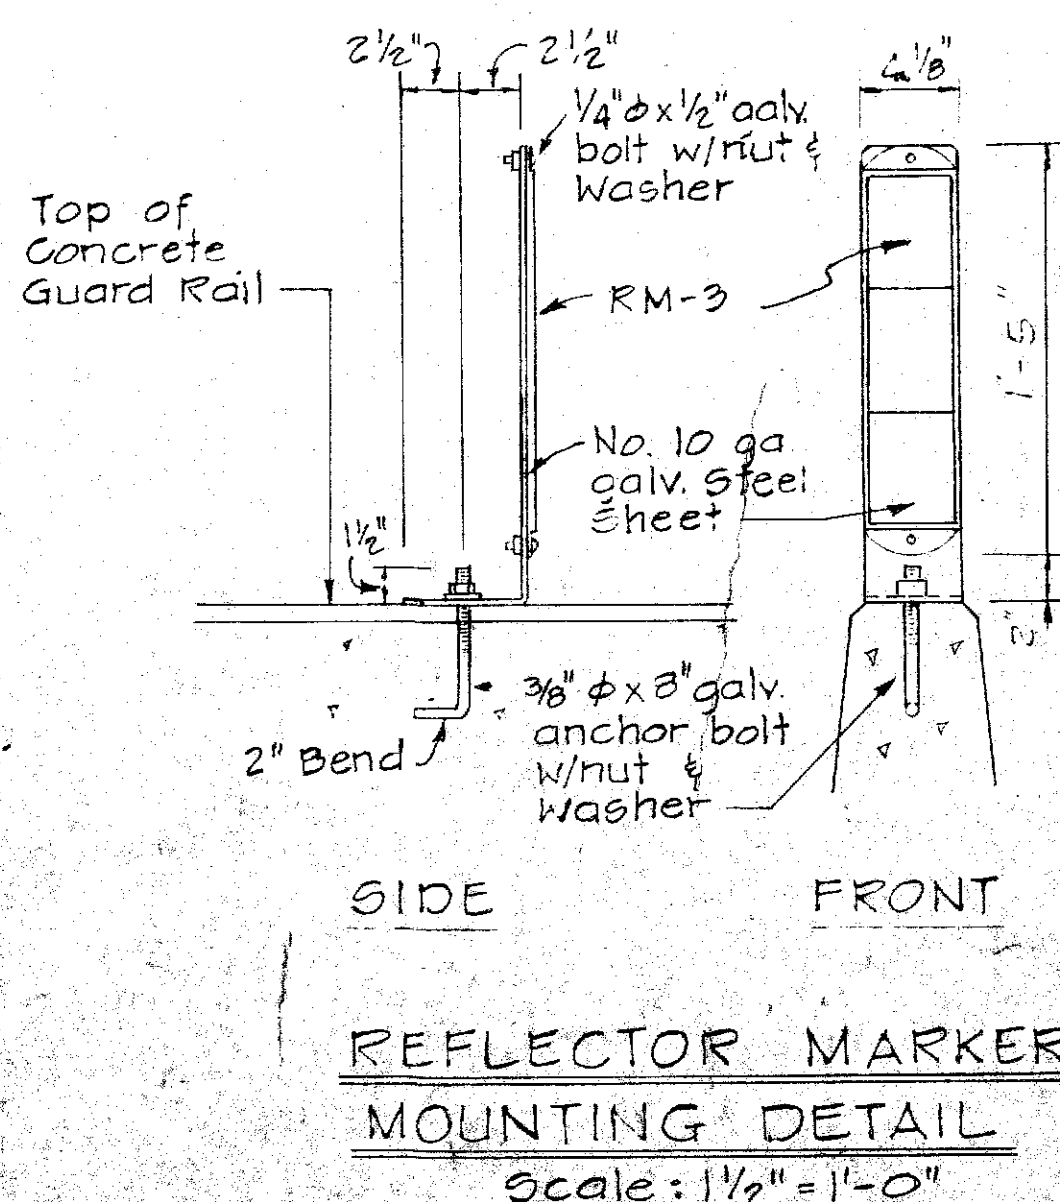
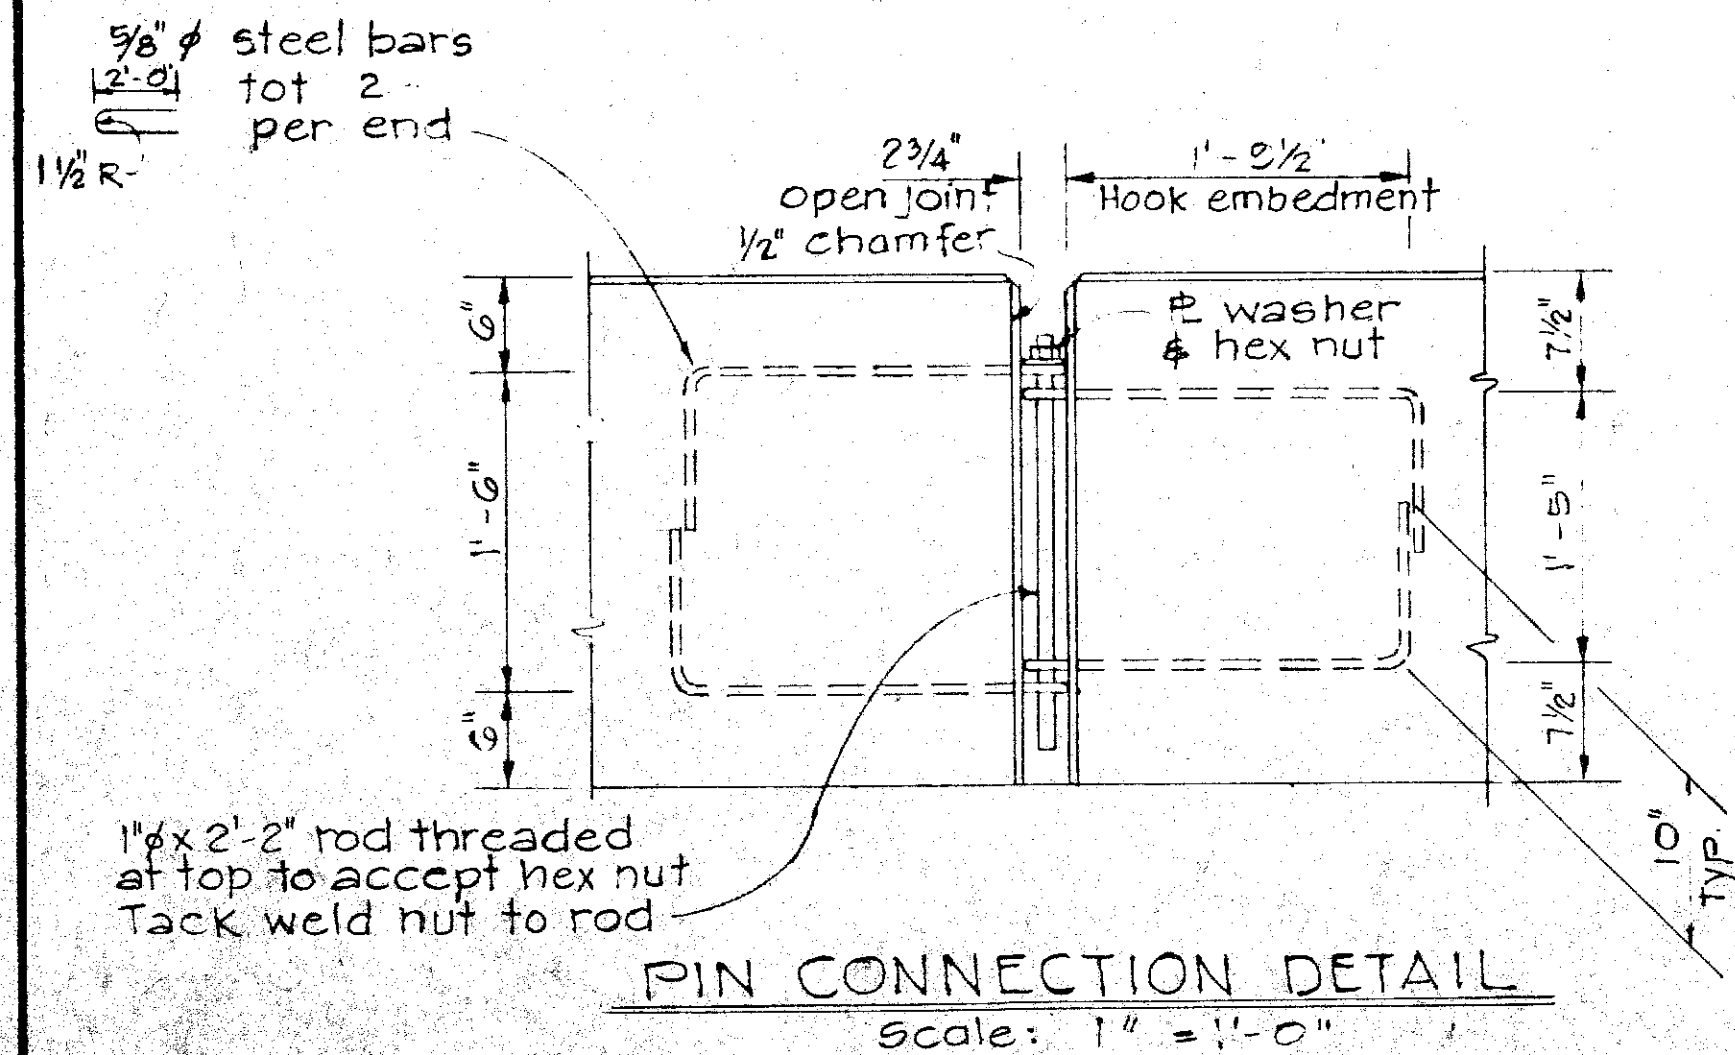
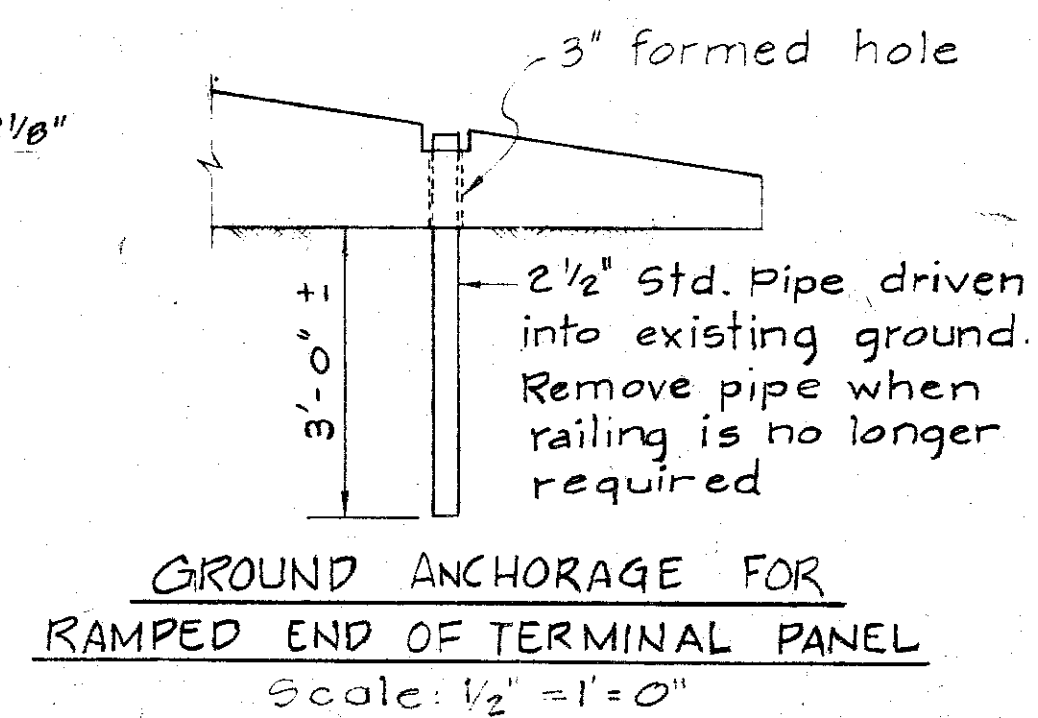
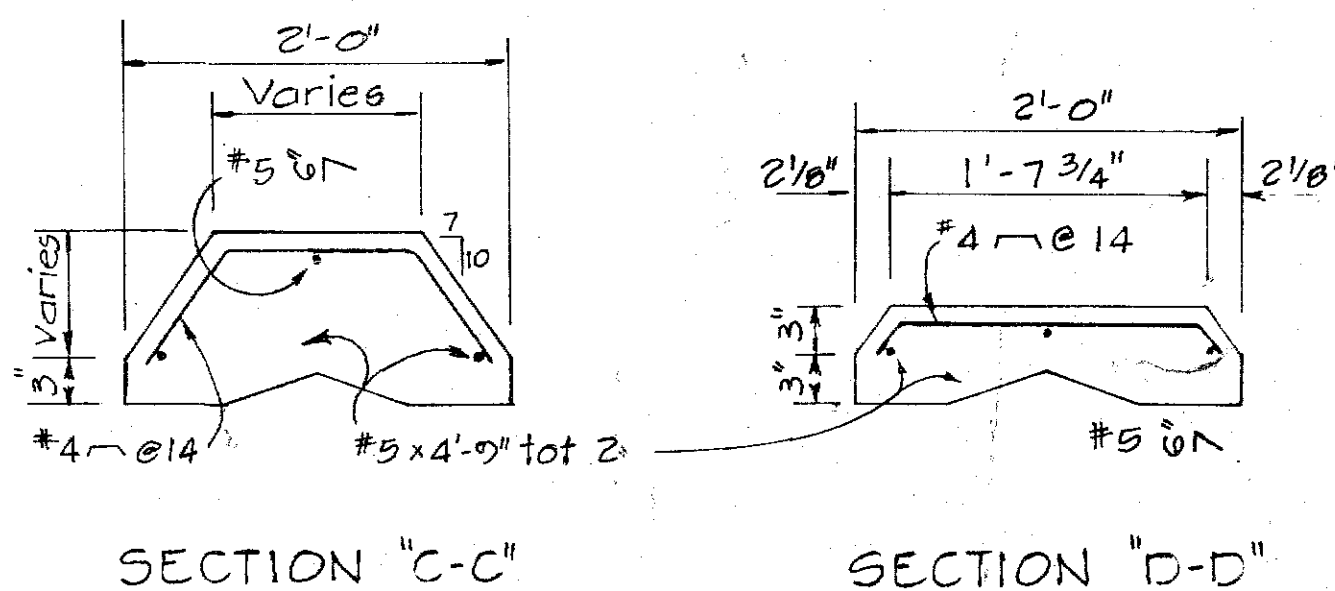
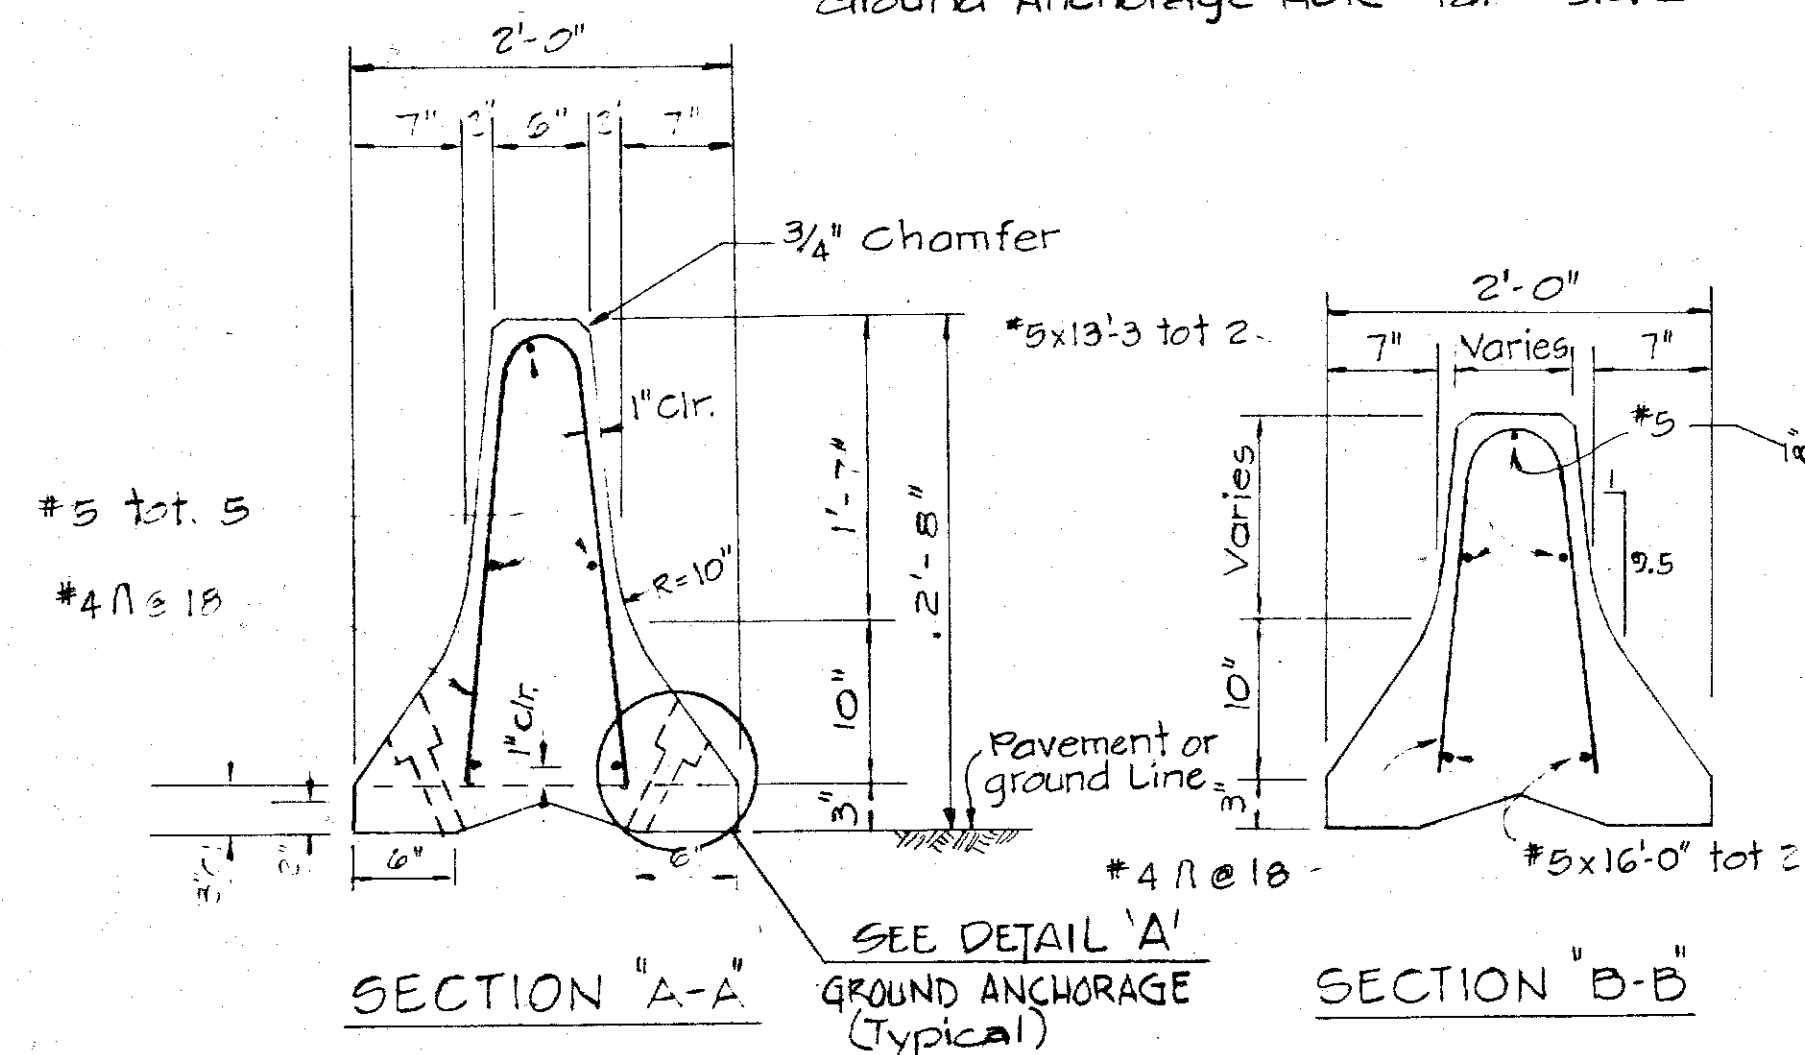


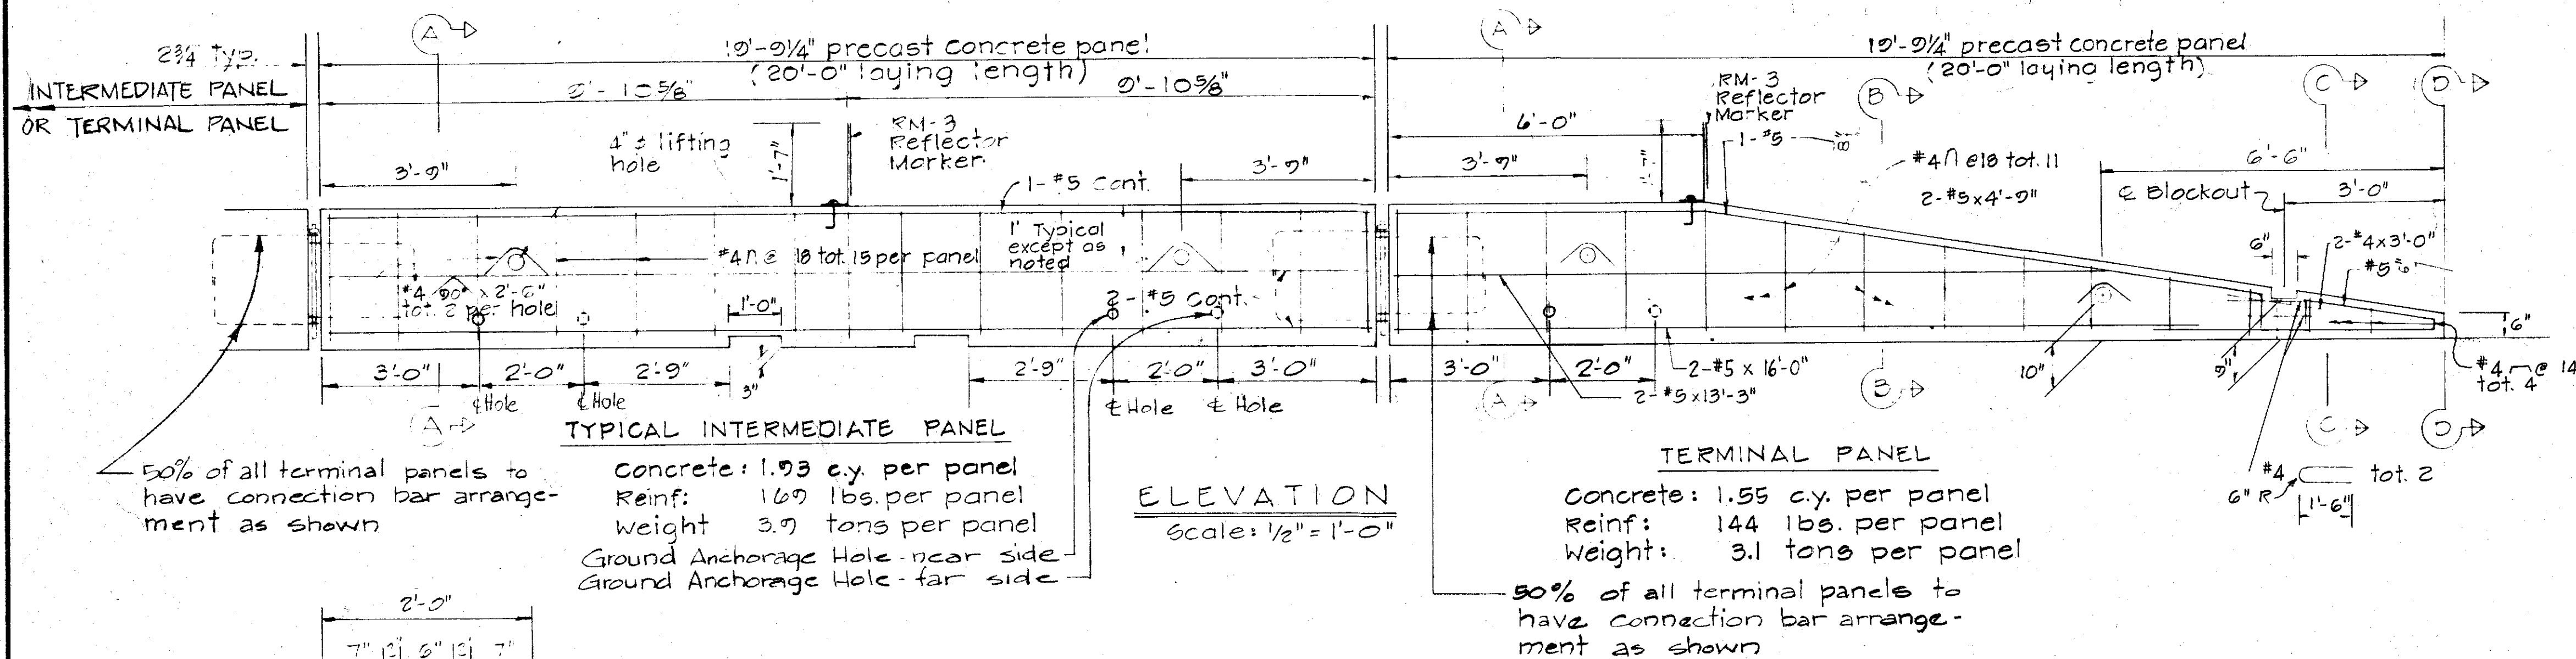

NOTES

- For details not shown in Sections BB, C-C, & D-D, see Section A-A
- Reflector Marker shall not be paid for separately but shall be considered incidental to "Portable Concrete Guard Rail."
- Concrete shall be Class "A".
- All bolts to have cut washers unless otherwise noted.
- Panels shall be salvaged and delivered to the nearest City and County maintenance yard.

DATE	
SURVEY PLOTTED BY	
DRAWN BY	
CHECKED BY	
ORIGINAL PLAN	
NOTE BOOK	

U. S. DEPARTMENT OF AGRICULTURE SOIL CONSERVATION SERVICE			
NO.	DATE	DESCRIPTION	REVISIONS
DEPARTMENT OF PUBLIC WORKS			
DIVISION OF ENGINEERING			
KAMEHAMEHA HIGHWAY BRIDGE OVER KAHALUU STREAM KAHALUU, OAHU, HAWAII			
TEMPORARY CONC. GUARDRAIL			
ENGINEER	MT	DATE	6/17/77
CHECKED	SR	DATE	
JOB NO. 38-77 DWG. NO. 7-E-23094			