


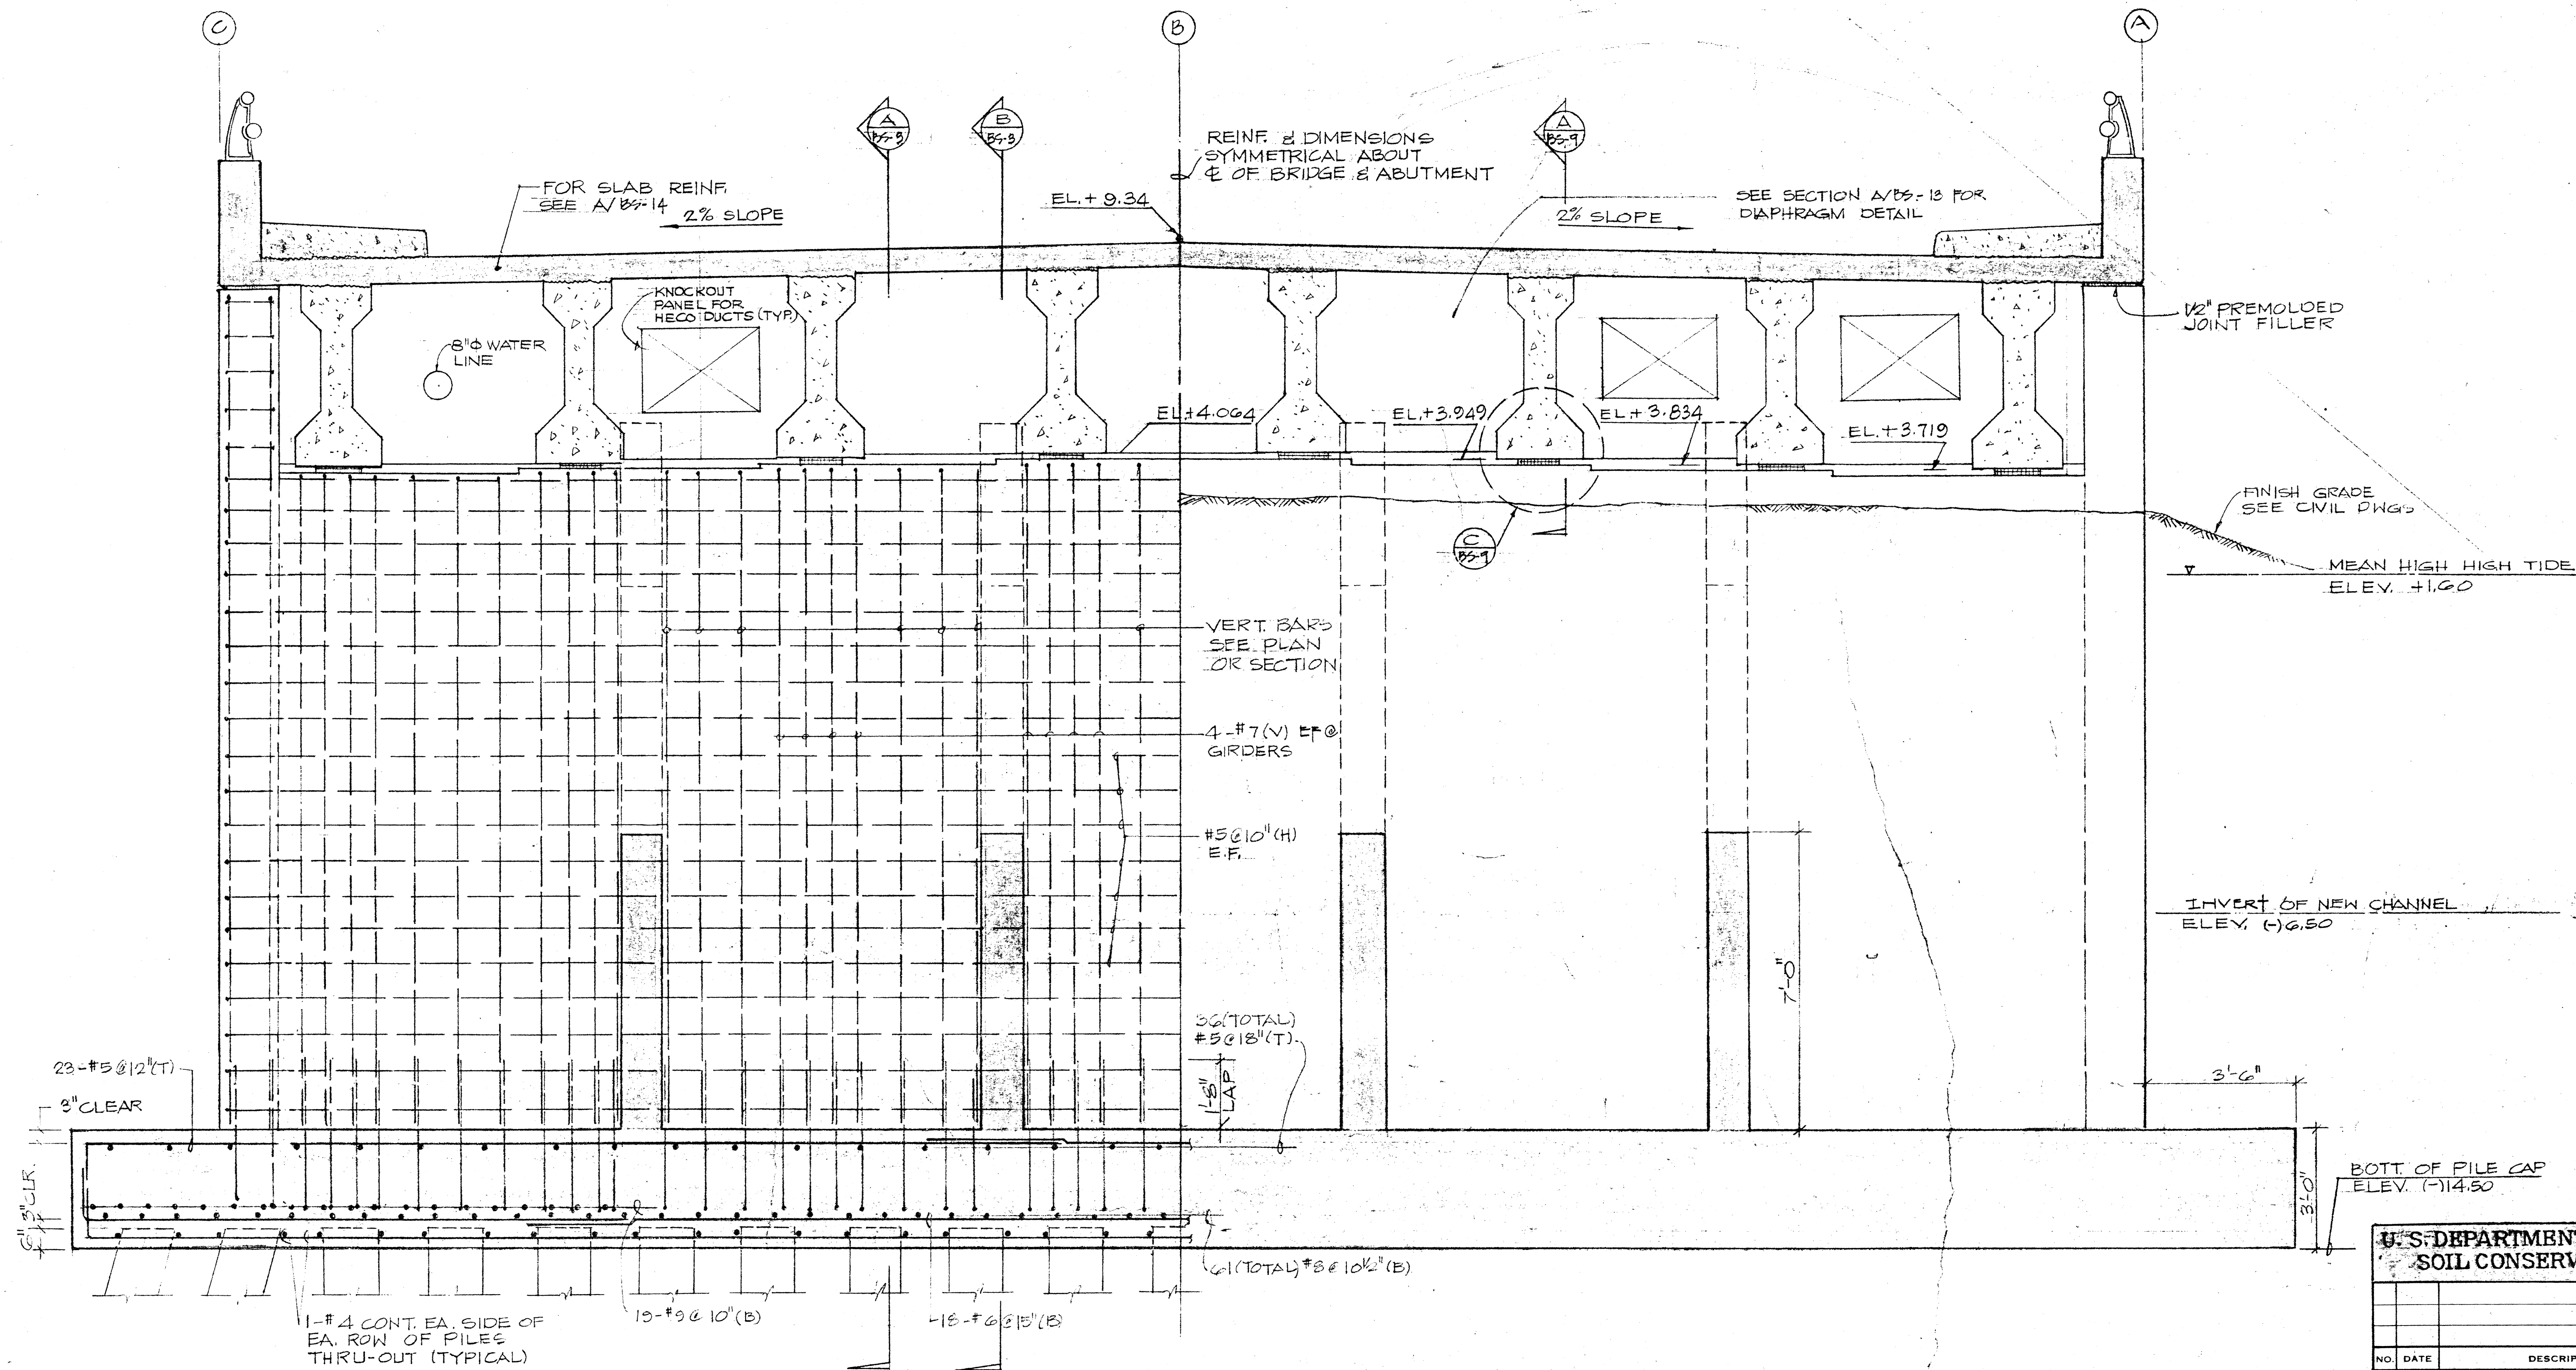

(A) KAHUKU ABUTMENT ELEVATION
 BS-2 SCALE: 1/2" = 1'-0"

U.S. DEPARTMENT OF AGRICULTURE
 SOIL CONSERVATION SERVICE

NO.	DATE	DESCRIPTION	ENGR.	DEPT. OR DIV.

DEPARTMENT OF PUBLIC WORKS CITY AND COUNTY OF HONOLULU DIVISION OF ENGINEERING KAMEHAMEHA HIGHWAY BRIDGE OVER KAHALUU STREAM KAHALUU, OAHU, HAWAII ABUTMENT DETAIL	
ENGINEER: <i>MY</i> DRAFTSMAN: <i>JCL</i> APPROVED: <i>[Signature]</i> CHIEF DIVISION OF ENGINEERING	DATE: 6/17/77 CHECKED BY: <i>[Signature]</i>

DD-083-01-90

JOB NO. 38-77 DWG. NO. 7-E-23094