



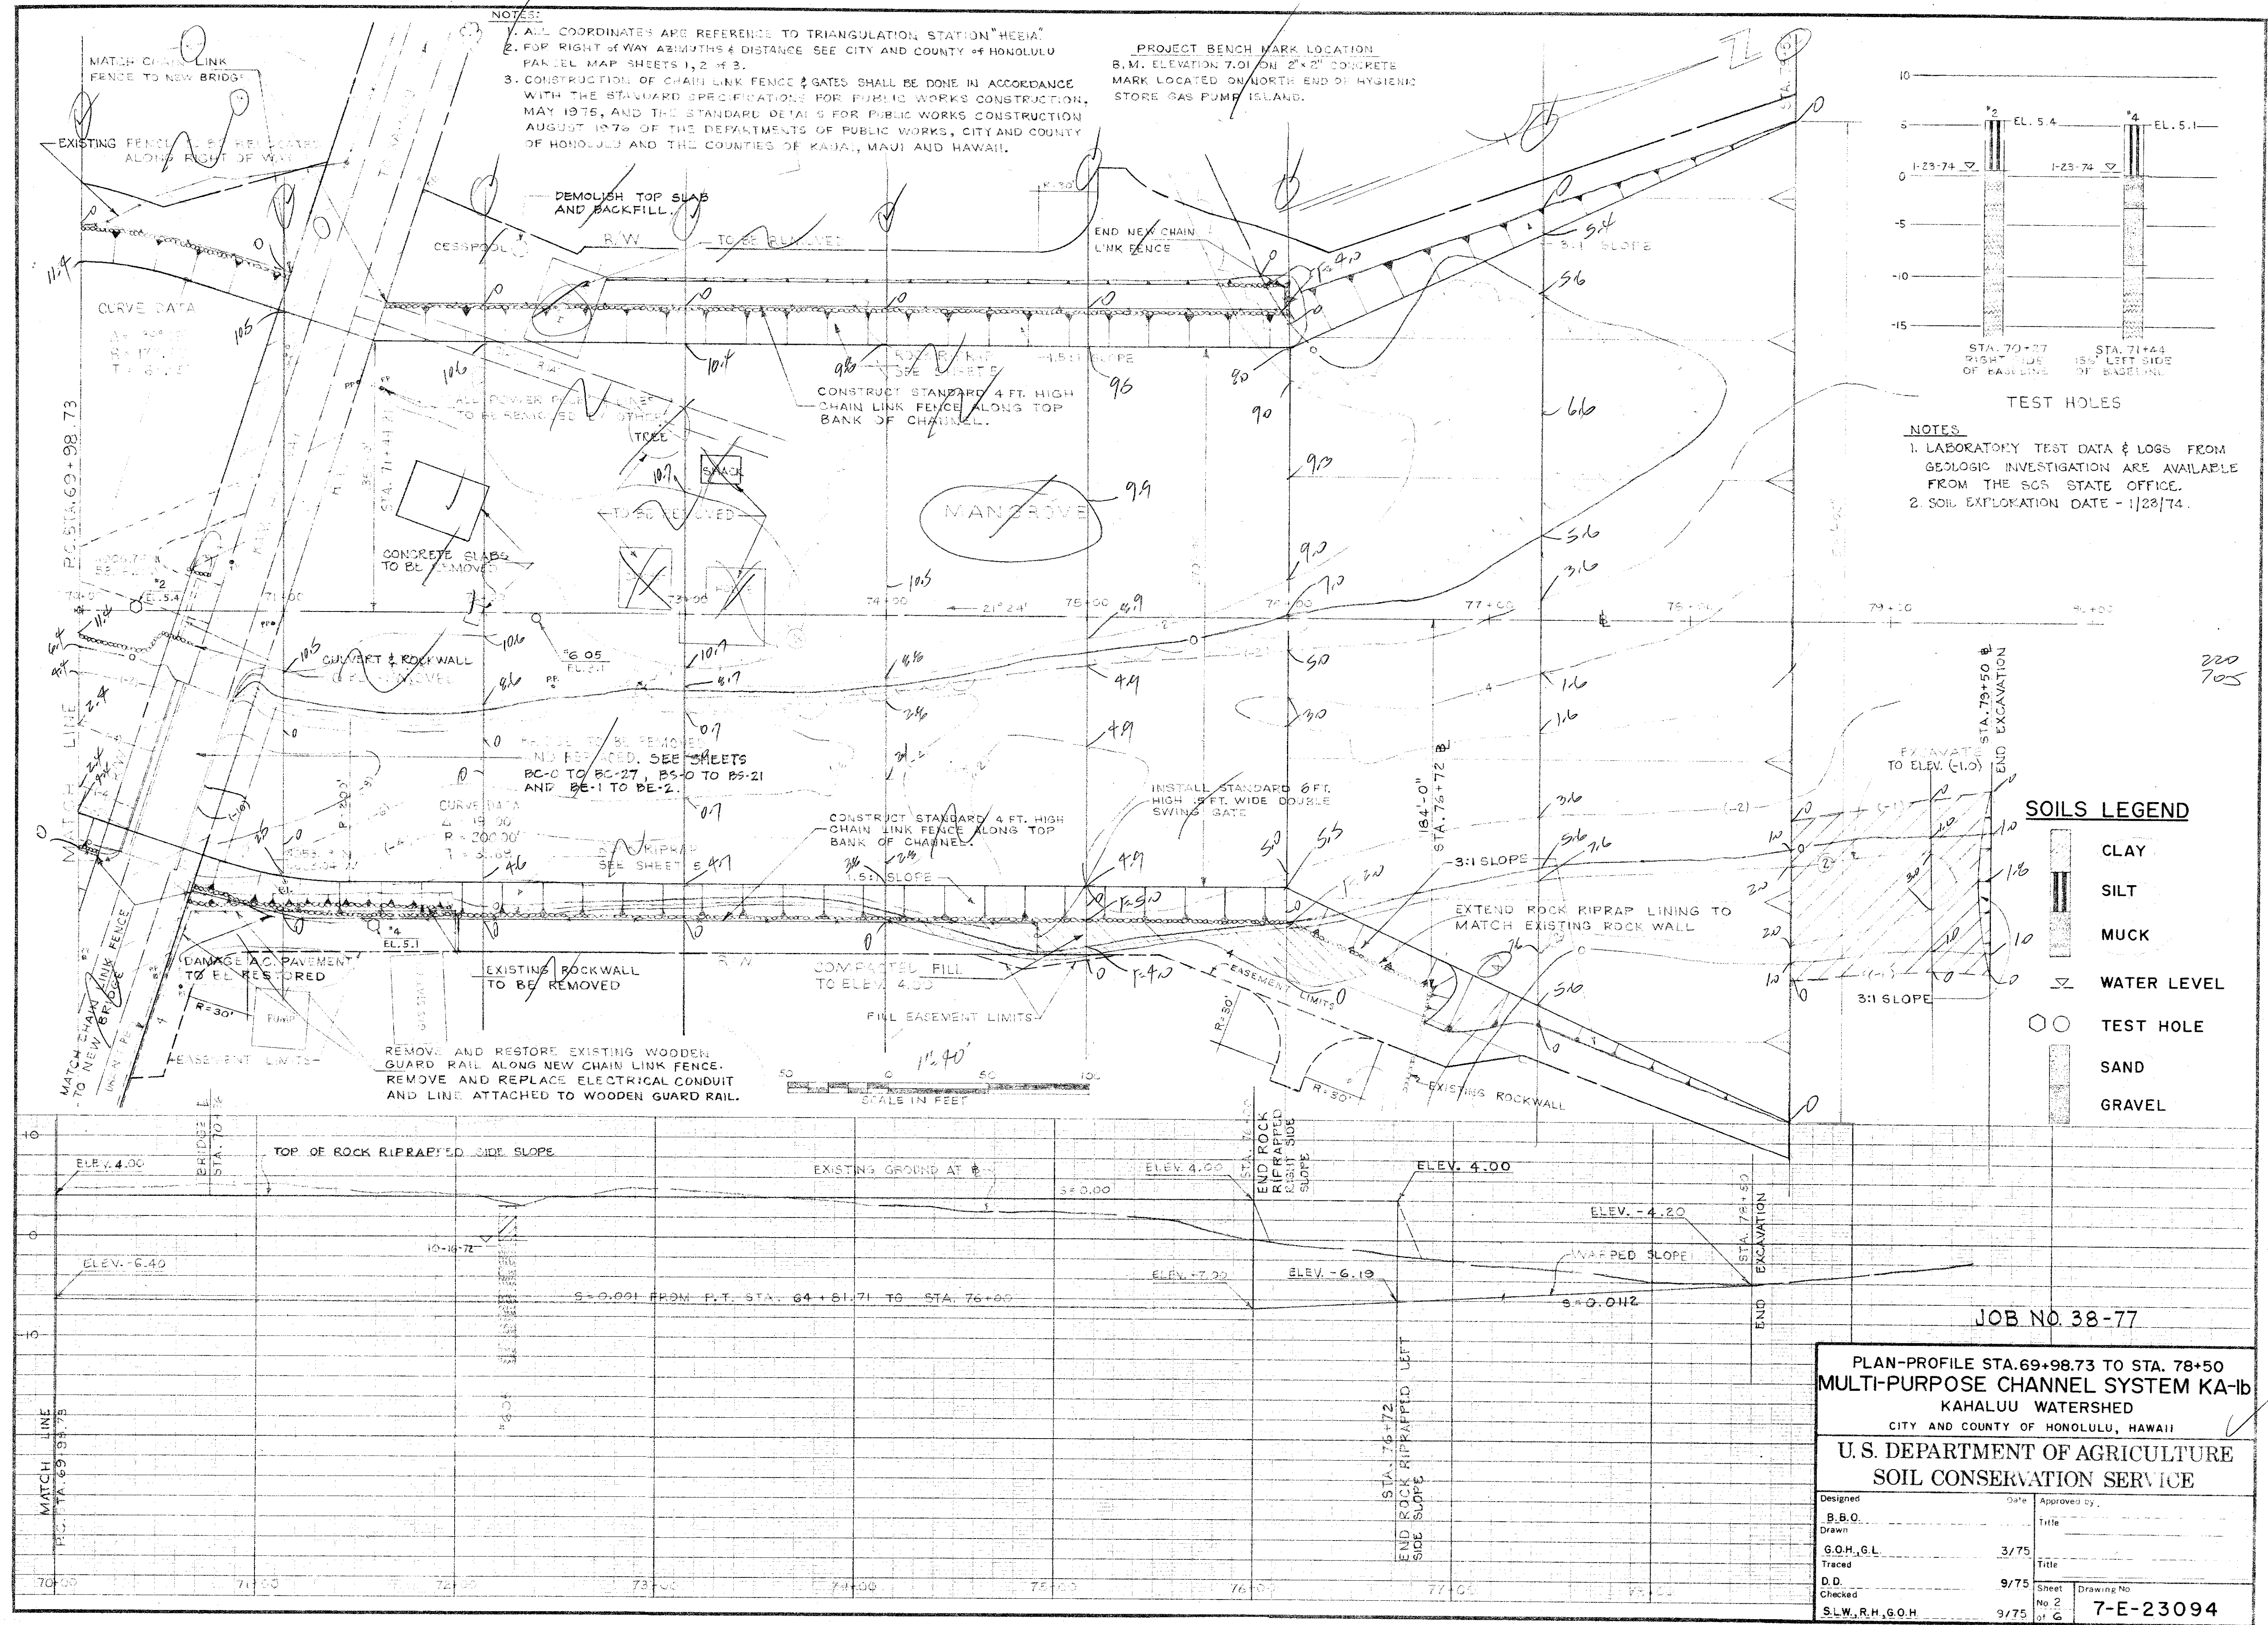

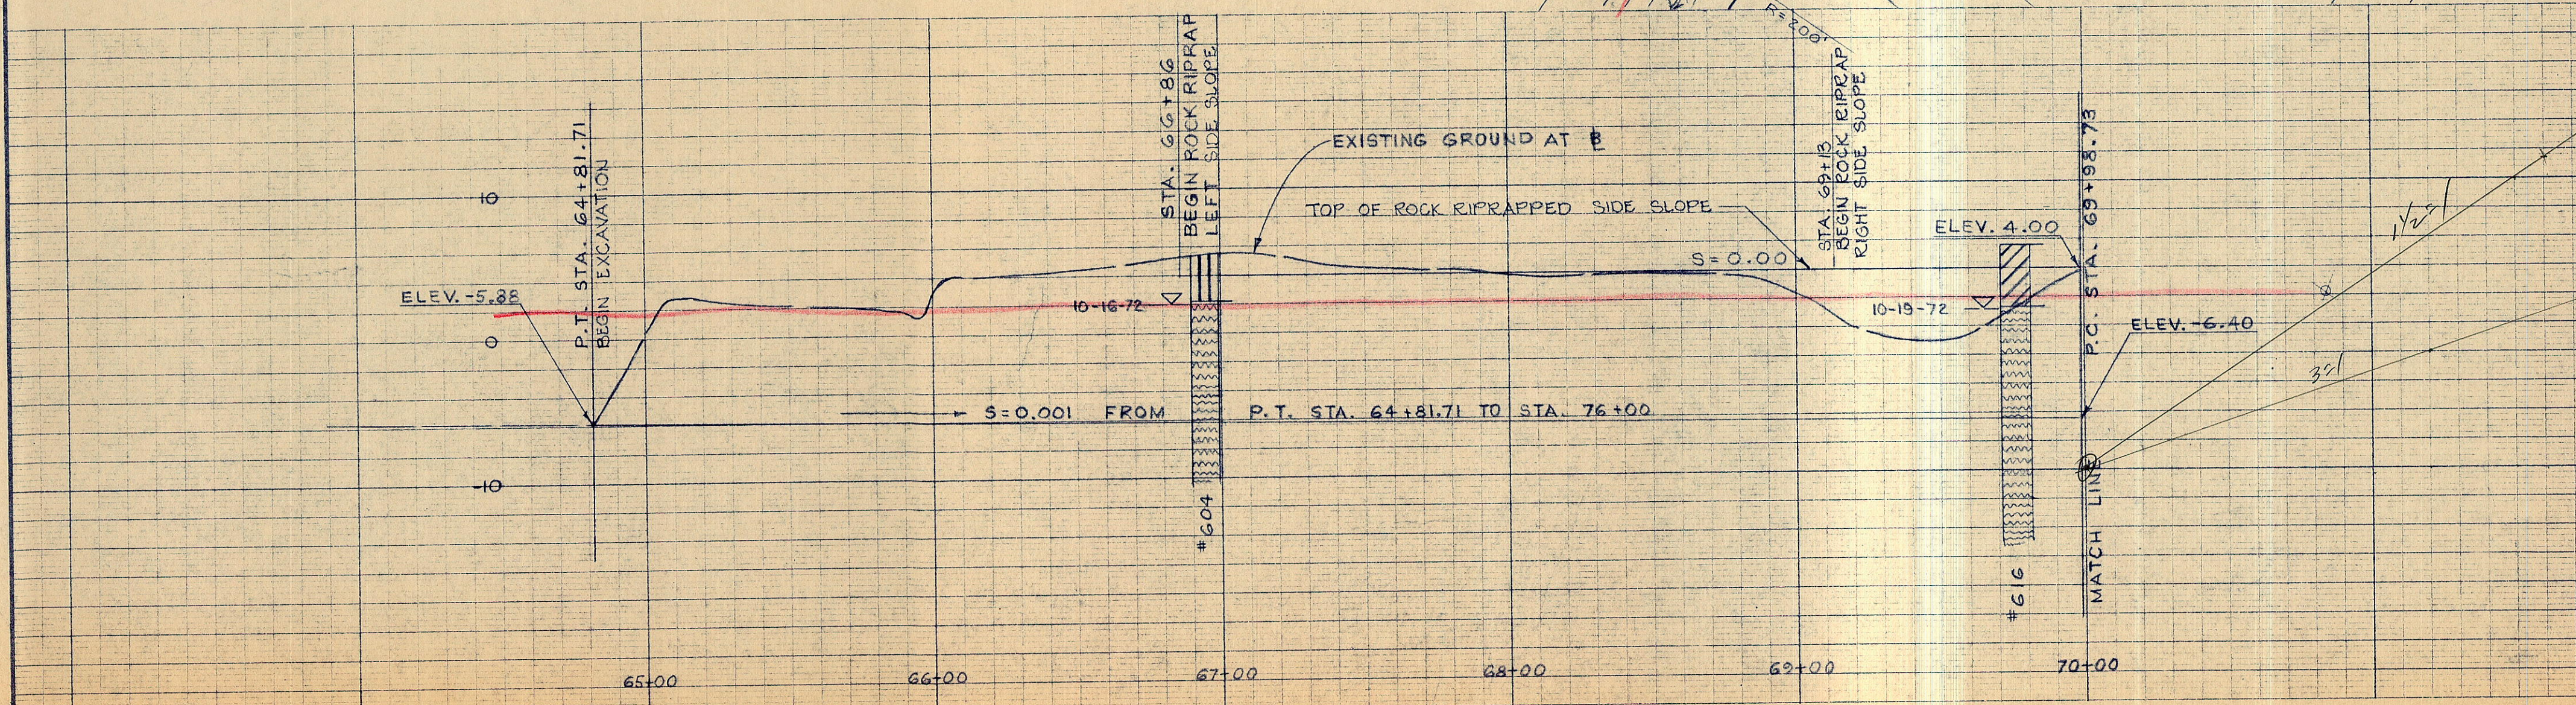

Designed	Date	Approved by
EBB		
Drawn	Title	
GOH, GL	3/75	
Traced	Title	
DE		
Checked	Sheet	Drawing No
SAAG, S. H. GOH	No 3	7-E-23094

FILE	POCKET	FOLDER	NO.
21	2	1	3

Form SCS-318 (November 1955)