
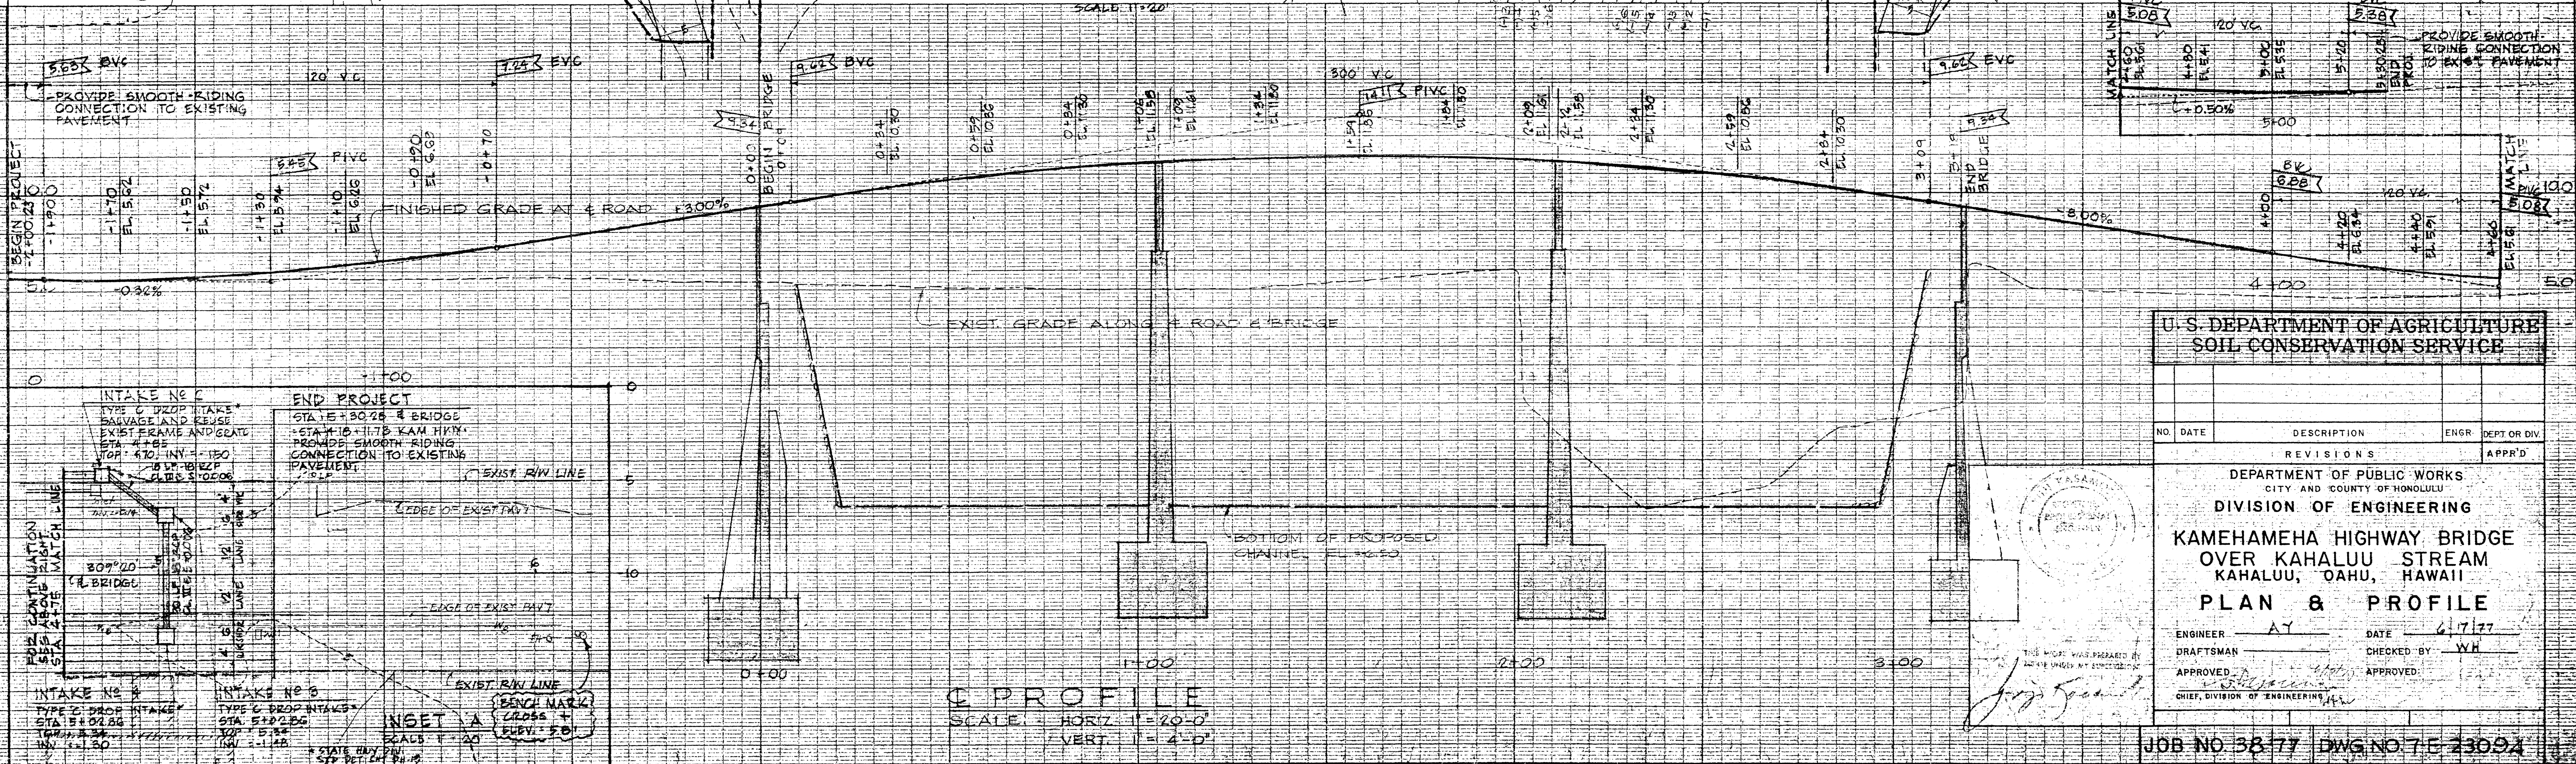


CURVE DATA				
CURVE NO.	1	2	3	4
Δ	0° 50'	10° 30'	69° 30'	
α/ε	0° 25'	55° 15'	34° 45'	
R	5730.00	20.00	20.00	
T	41.67	28.83	13.87	
C ₁	88.34	32.87	22.80	
L ₂	83.94	38.57	24.26	

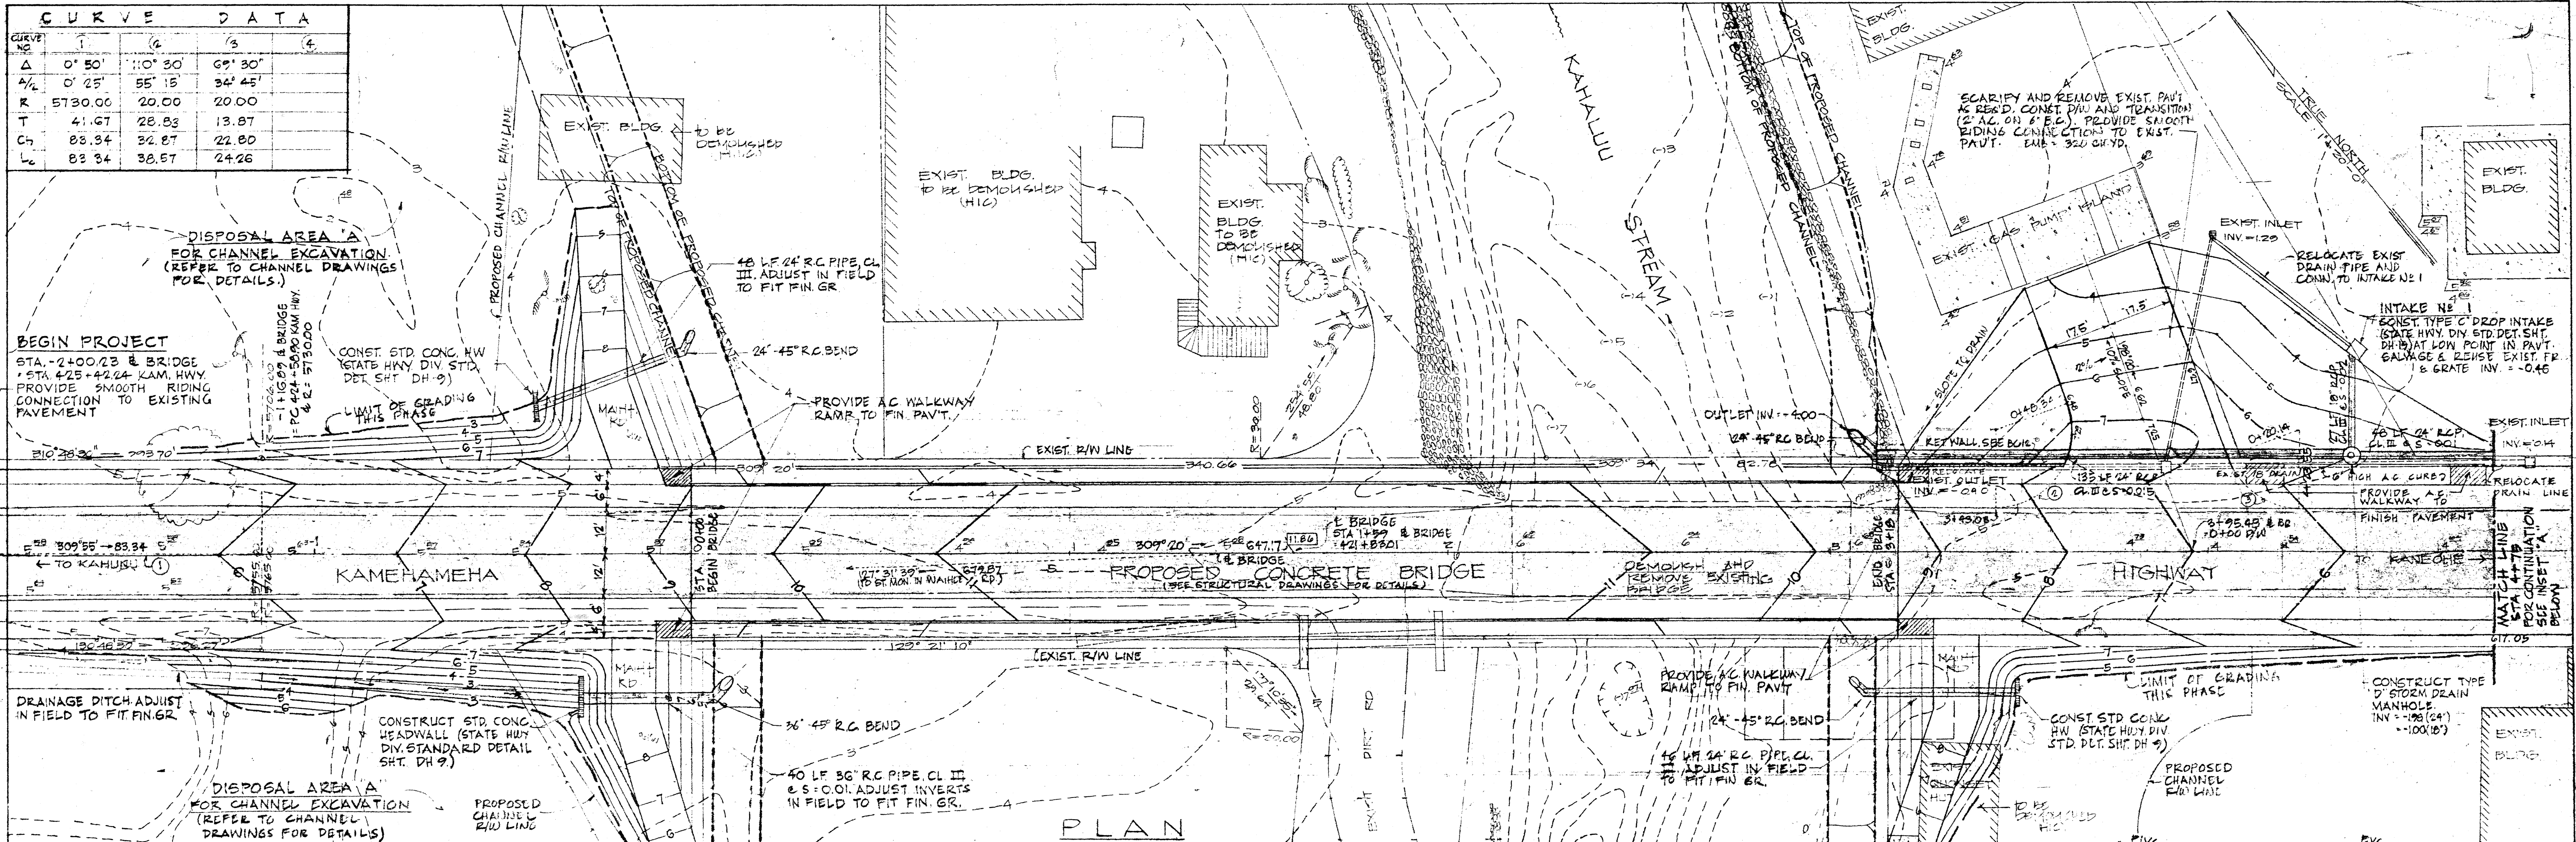

U. S. DEPARTMENT OF AGRICULTURE
SOIL CONSERVATION SERVICE

NO.	DATE	DESCRIPTION	ENGR.	DEPT OR DIV.
REVISIONS				APPR'D
DEPARTMENT OF PUBLIC WORKS CITY AND COUNTY OF HONOLULU DIVISION OF ENGINEERING KAMEHAMEHA HIGHWAY BRIDGE OVER KAHALUU STREAM KAHALUU, OAHU, HAWAII PLAN & PROFILE ENGINEER <u>AY</u> DATE <u>6/7/77</u> DRAFTSMAN _____ CHECKED BY <u>WH</u> APPROVED <u>[Signature]</u> APPROVED _____ CHIEF, DIVISION OF ENGINEERING				

JOB NO. 38-77 DWG NO. 7-E-23094

DD-083-01-90

2

Sheet BC-2 of 52

FILE	POCKET	FOLDER	NO.
7	7	7	7

FILE: DD-J-15