


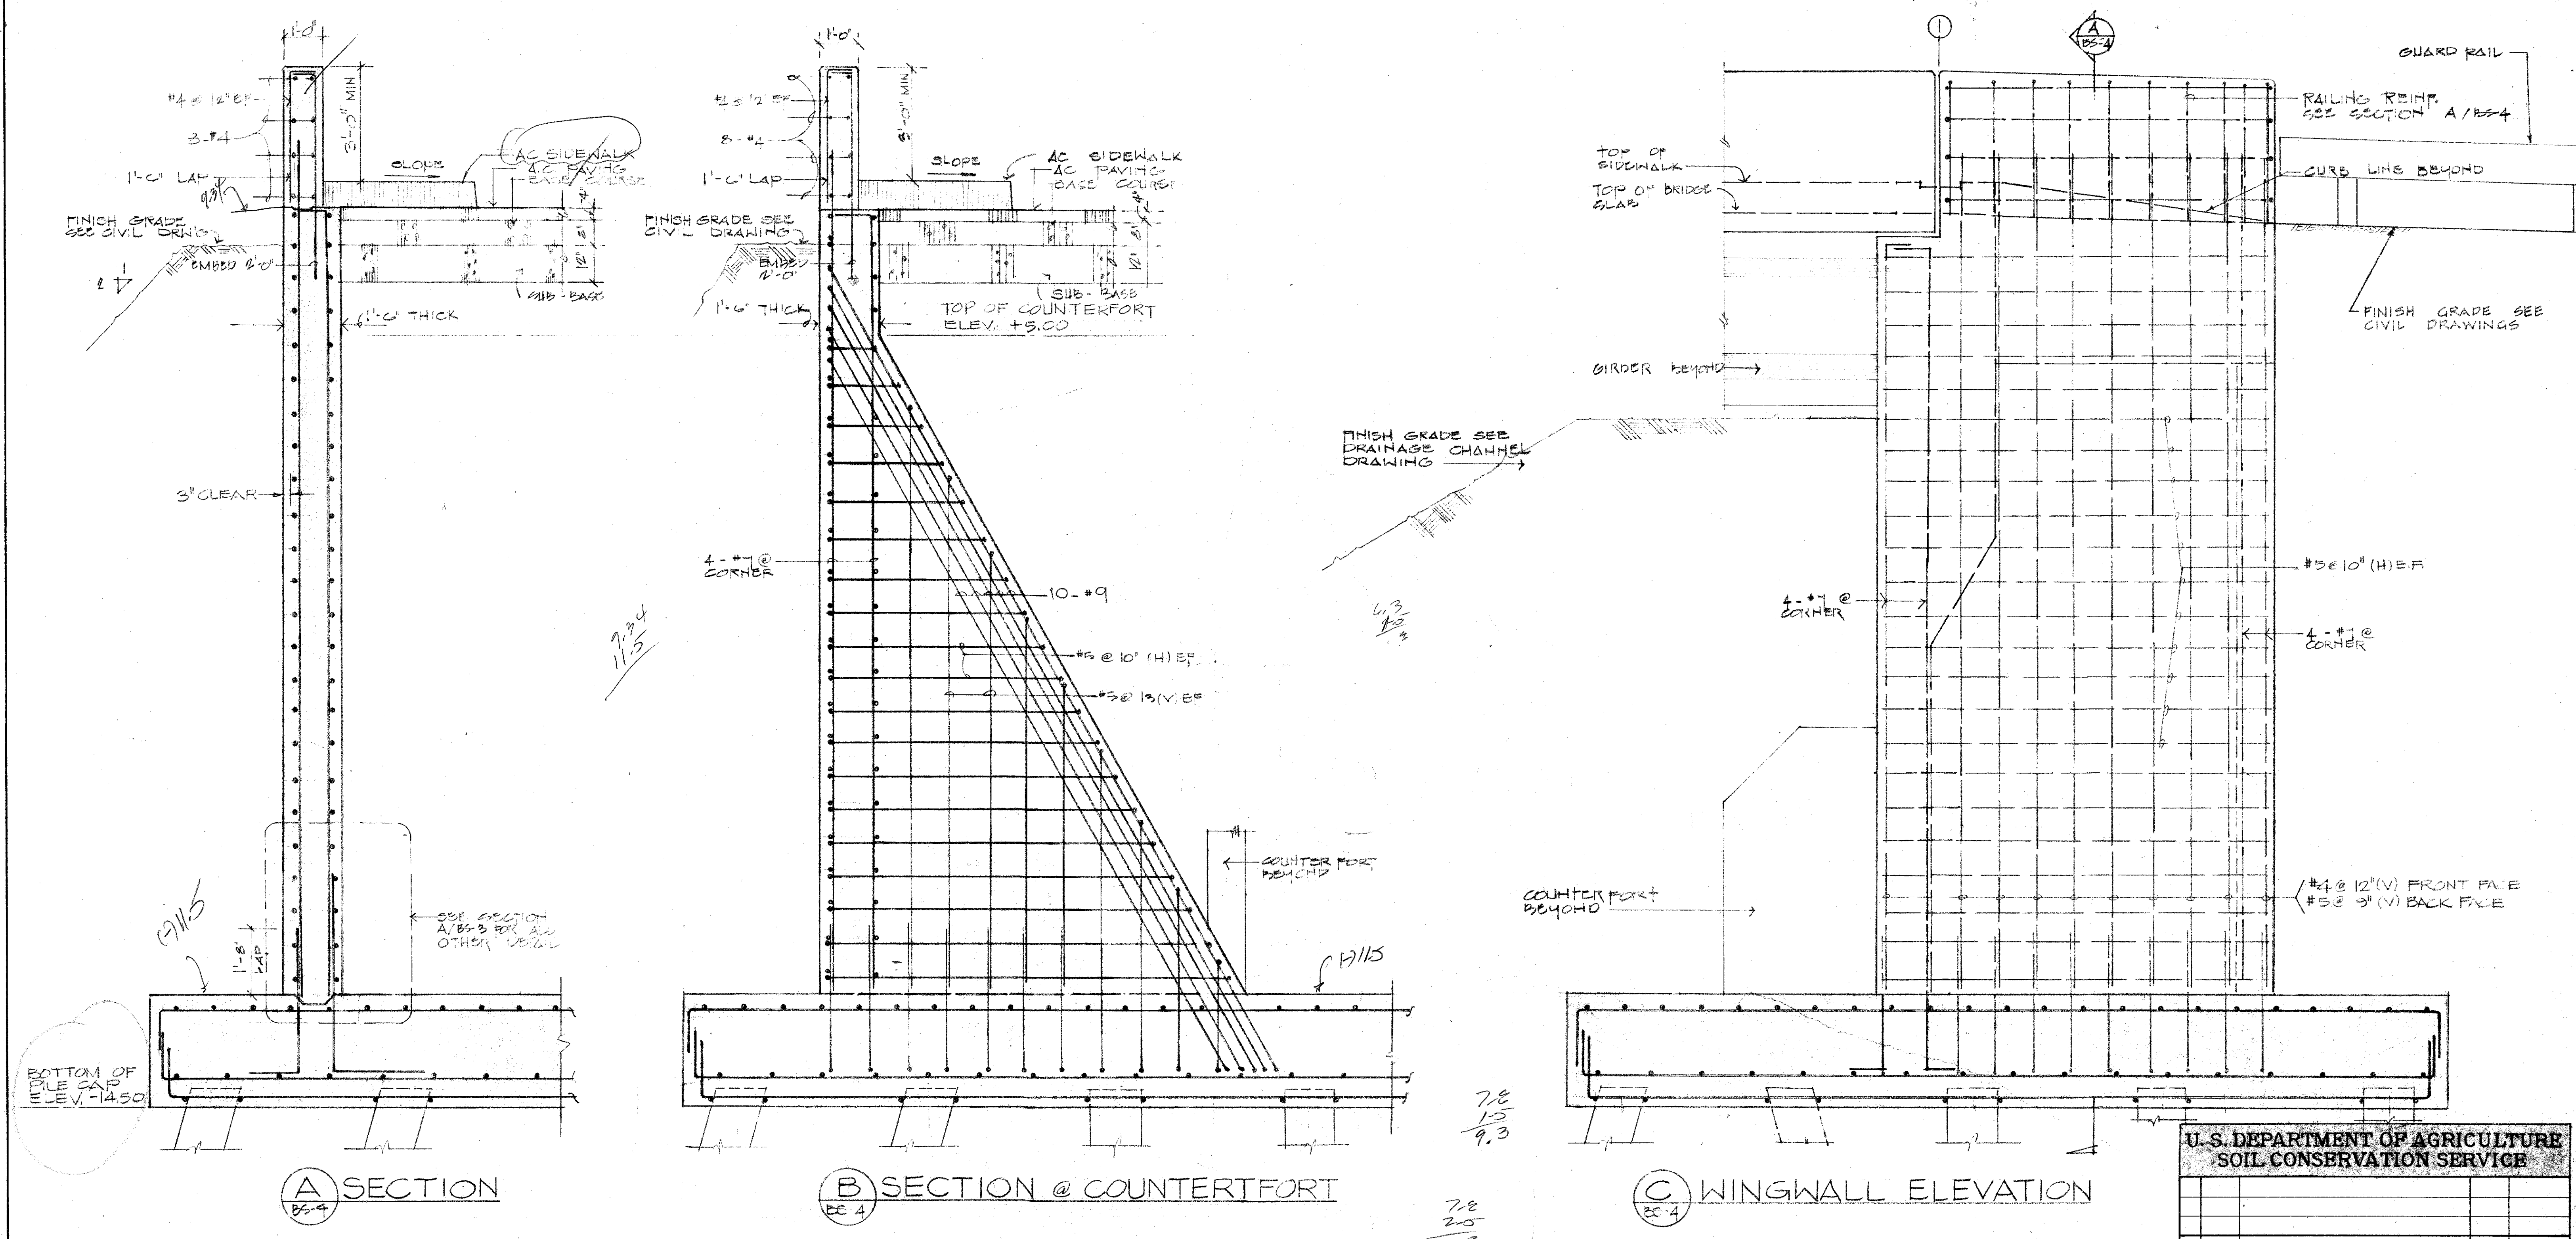

KAHUKU WINGWALL DETAILS
 SCALE: 1/2" = 1'-0"

U.S. DEPARTMENT OF AGRICULTURE SOIL CONSERVATION SERVICE			
NO.	DATE	DESCRIPTION	ENGR. DEPT. OR DIV.
REVISIONS		APPR'D	
DEPARTMENT OF PUBLIC WORKS CITY AND COUNTY OF HONOLULU DIVISION OF ENGINEERING KAMEHAMEHA HIGHWAY BRIDGE OVER KAHALUU STREAM KAHALUU, OAHU, HAWAII WINGWALL DETAIL			
ENGINEER	M.T.	DATE	6/17/77
DRAFTSMAN	JCL	CHECKED BY	
APPROVED		CHIEF, DIVISION OF ENGINEERING	