


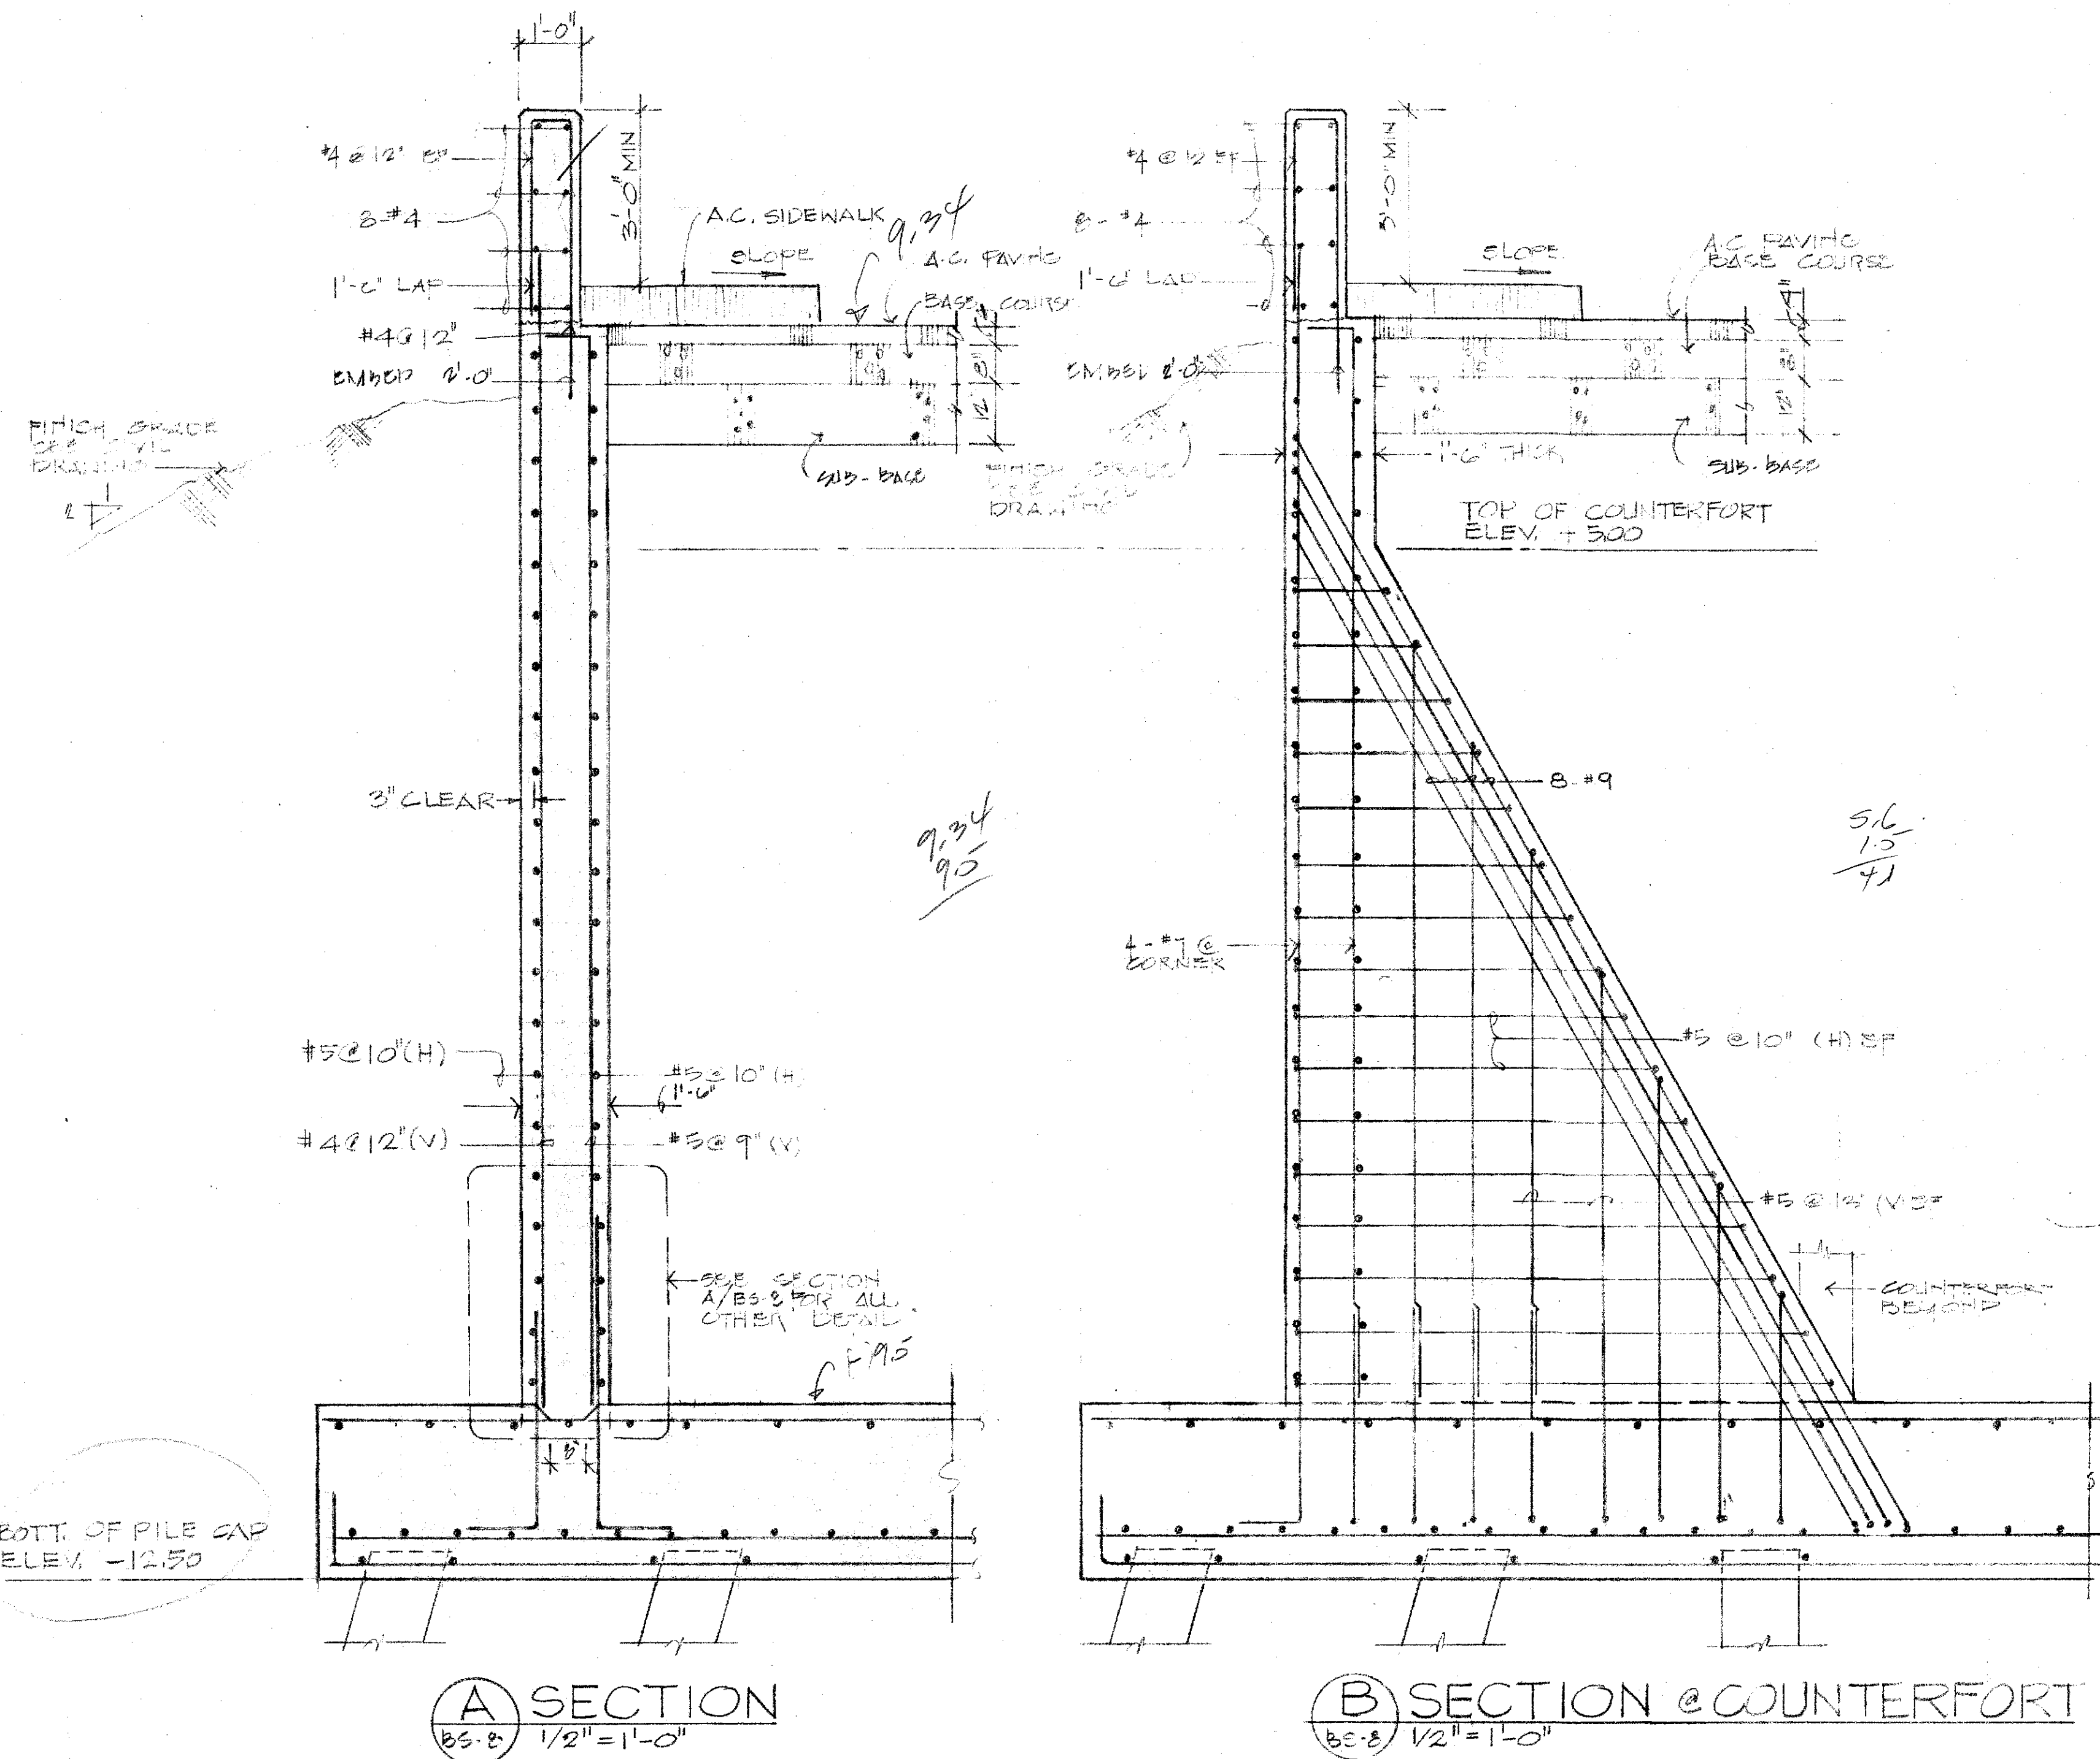

U. S. DEPARTMENT OF AGRICULTURE
SOIL CONSERVATION SERVICE

NO.	DATE	DESCRIPTION	ENGR.	DEPT. OR DIV.

REVISIONS

DEPARTMENT OF PUBLIC WORKS
CITY AND COUNTY OF HONOLULU

DIVISION OF ENGINEERING
**KAMEHAMEHA HIGHWAY BRIDGE
OVER KAHALUU STREAM
KAHALUU, OAHU, HAWAII**

WINGWALL DETAIL
ENGINEER: MT DATE: 6/17/77
DRAFTSMAN: JGL CHECKED BY:
APPROVED:
CHIEF, DIVISION OF ENGINEERING:

F. B.

JOB NO. 38-77

DWG. NO. 7-E-23094