




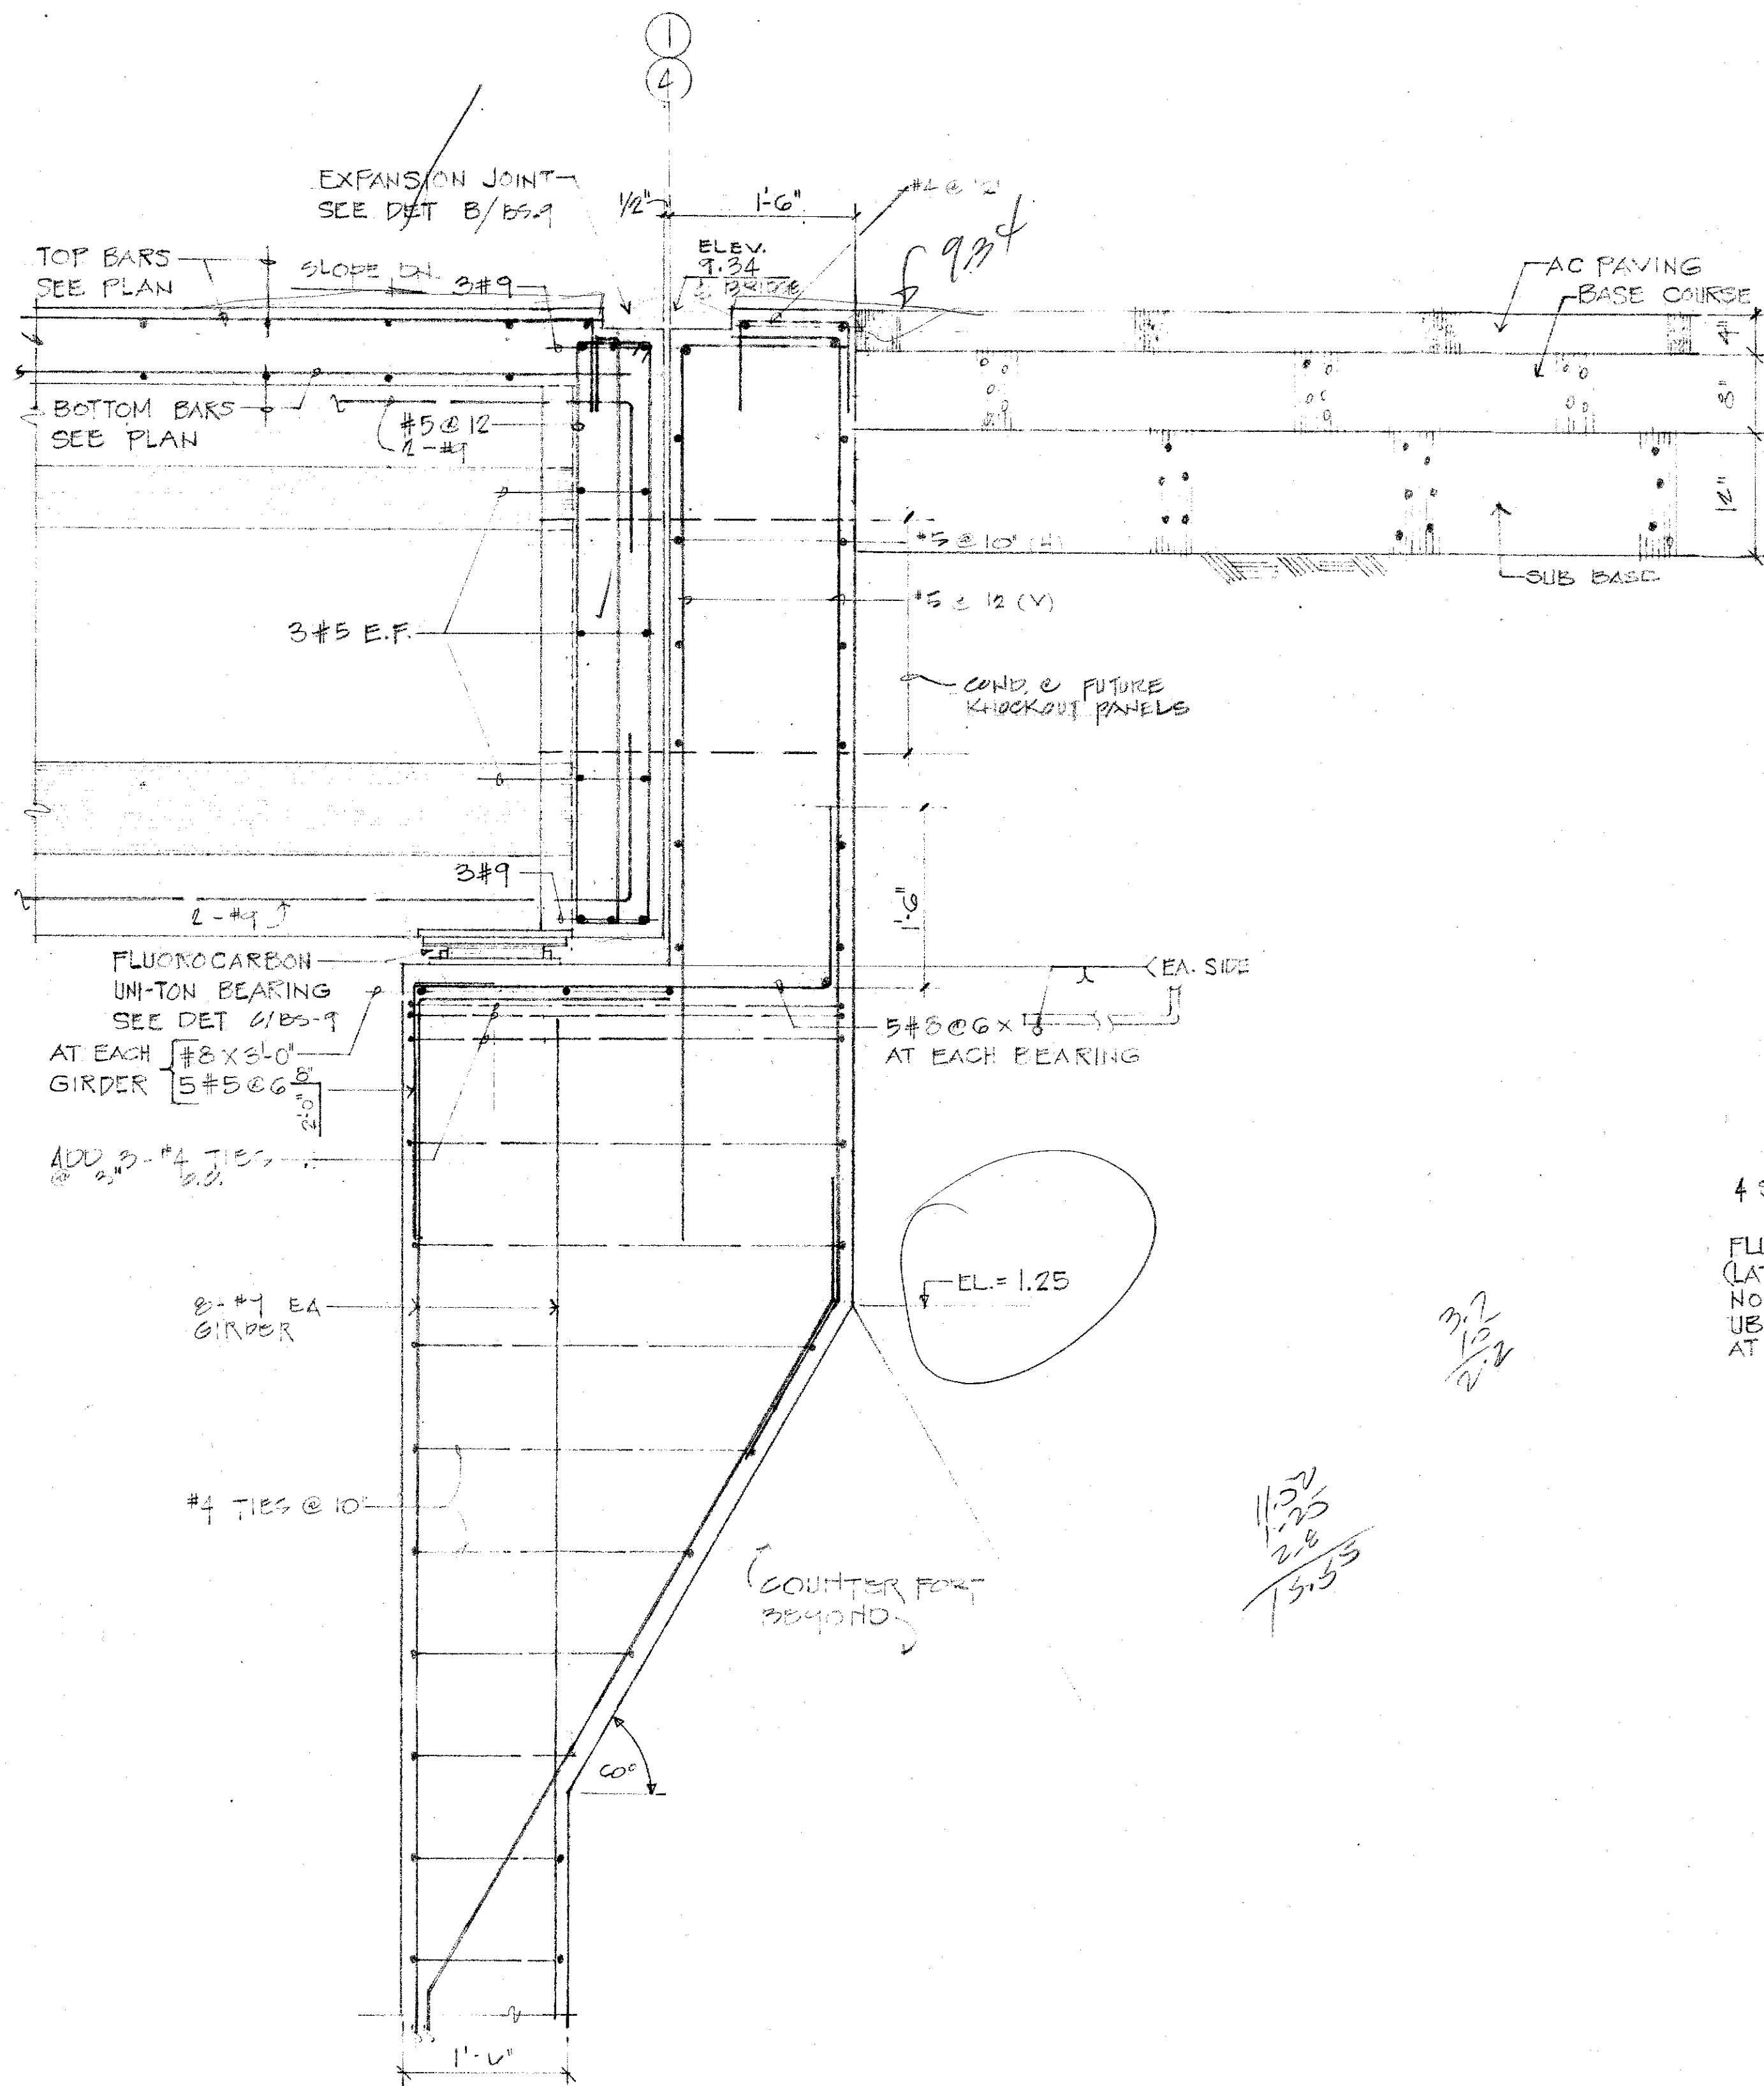


A SECTION THRU ABUTMENT & APPROACH SLAB
1" = 1'-0"

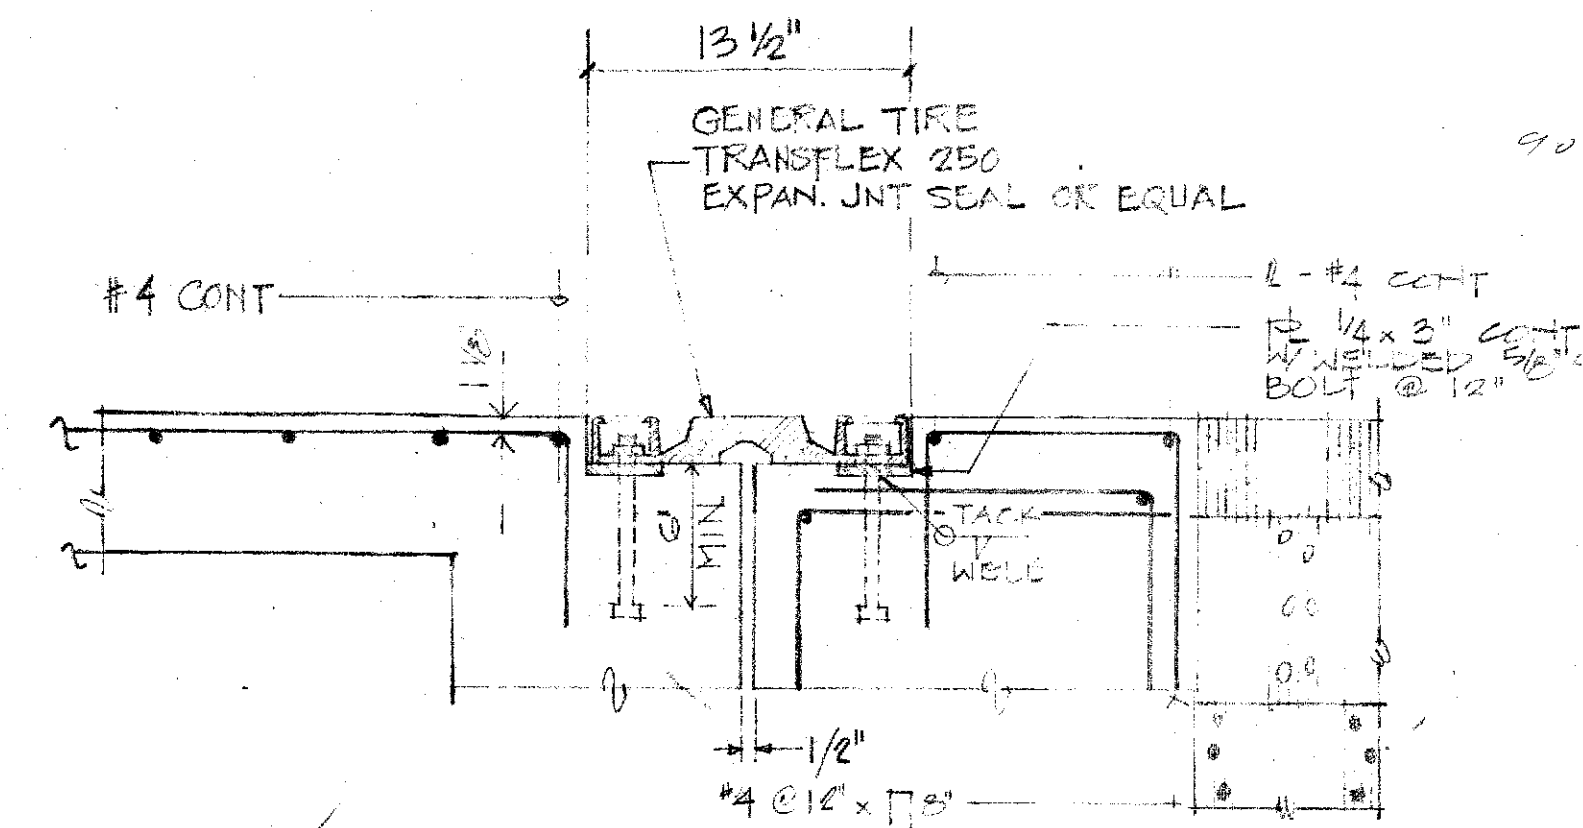


B EXPANSION JOINT DETAIL
1 1/2" = 1'-0"

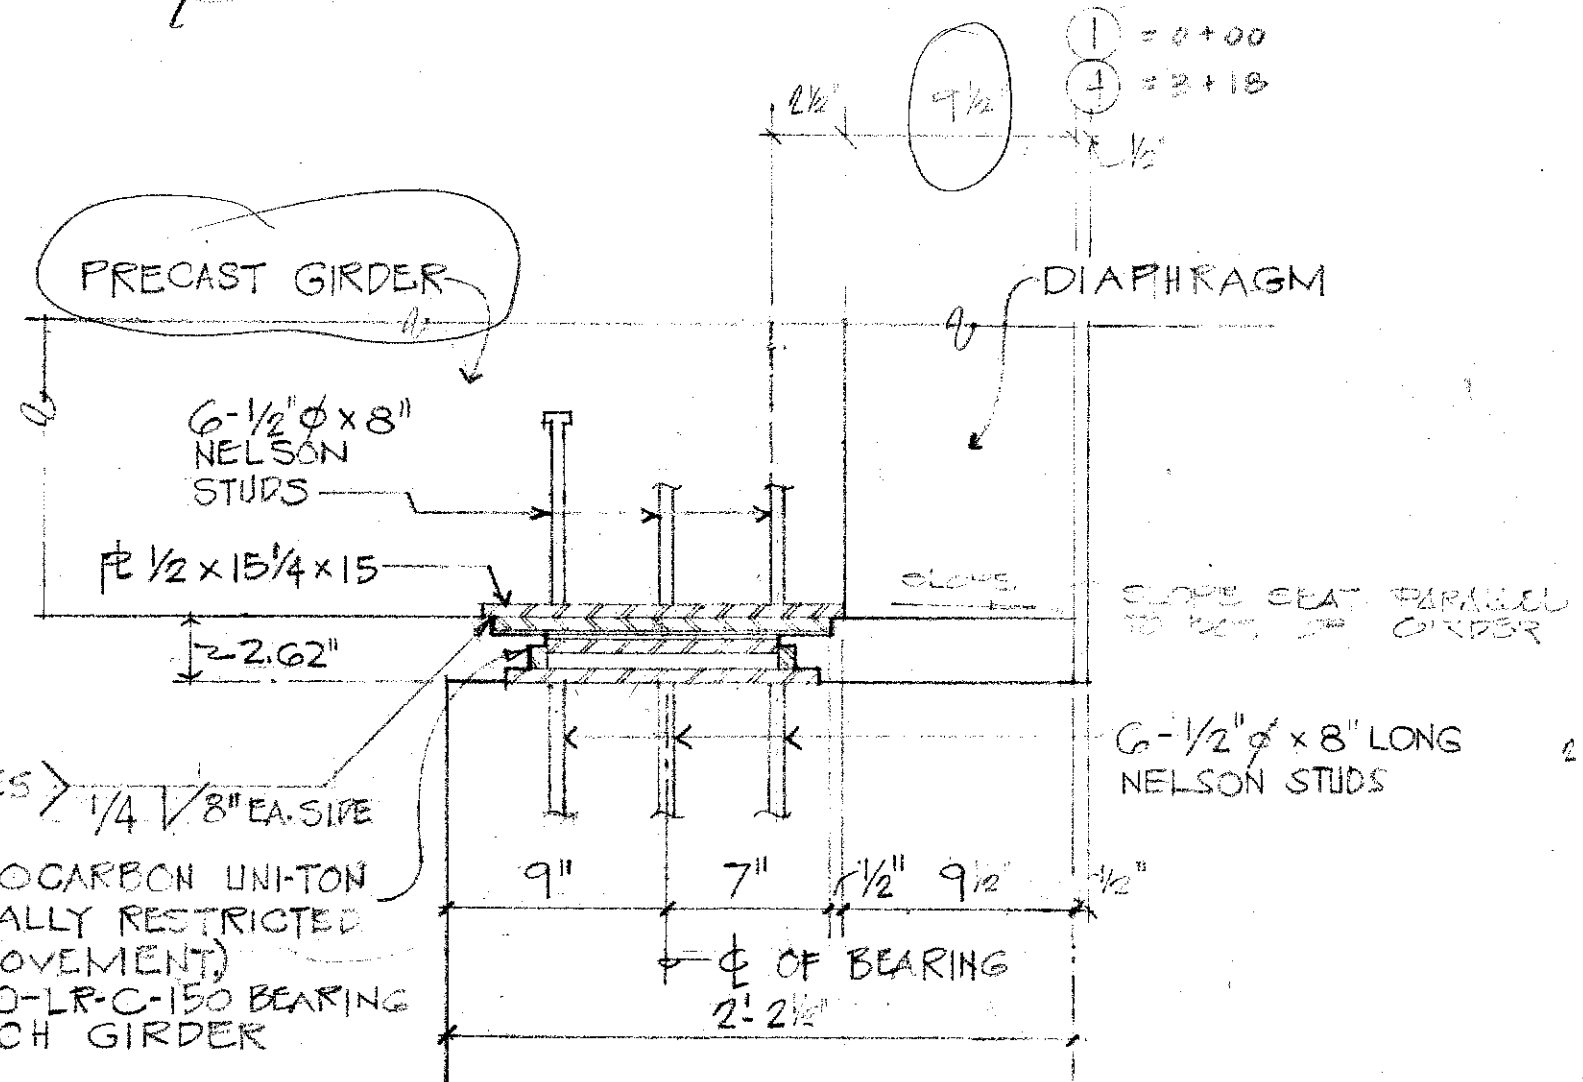

C BEARING DETAIL
1 1/2" = 1'-0"

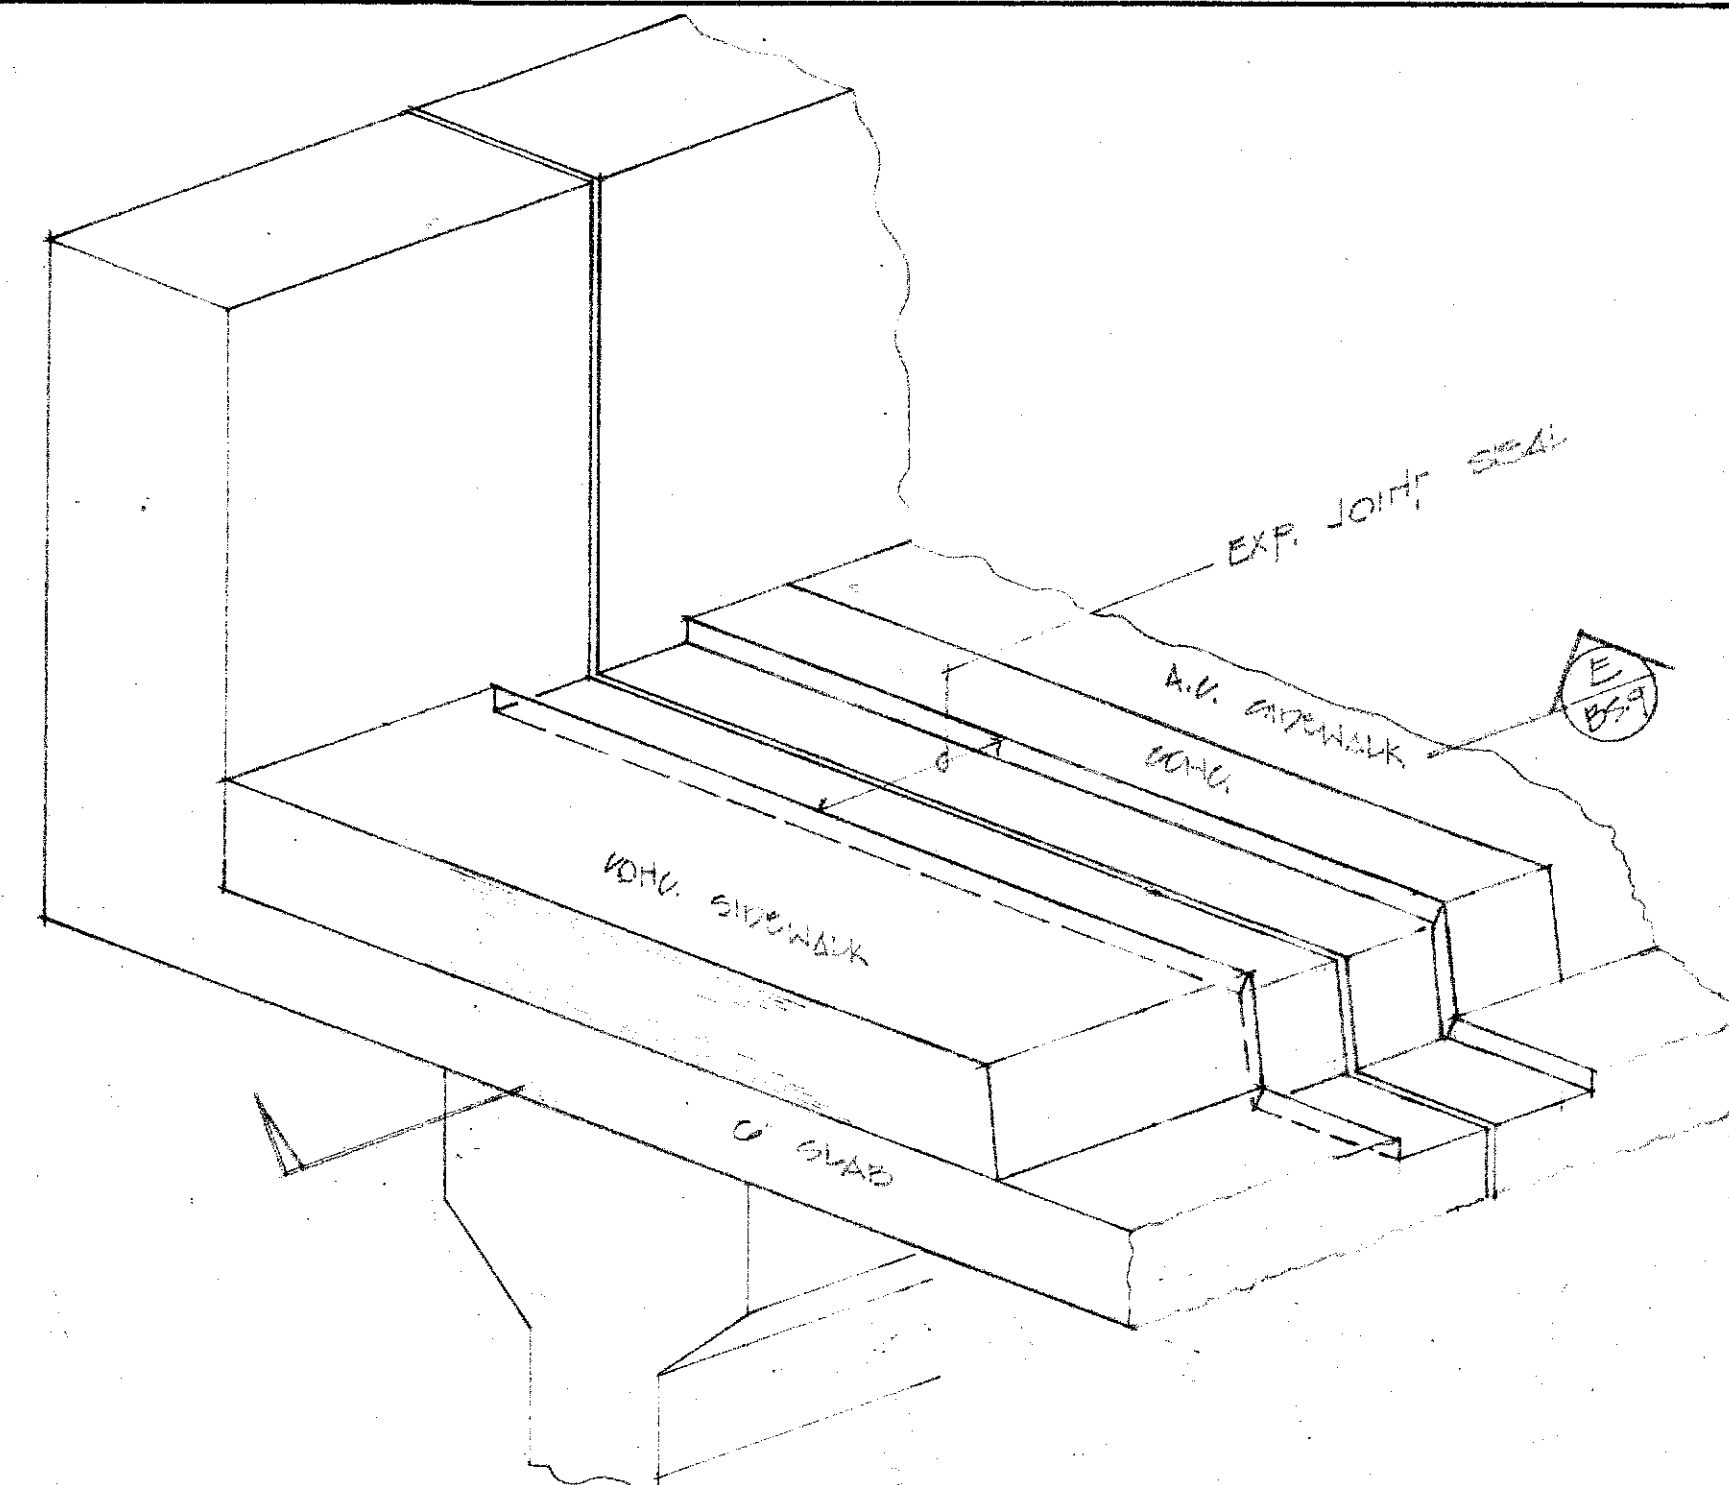

D EXP. JOINT @ SIDEWALK
1 1/2" = 1'-0"

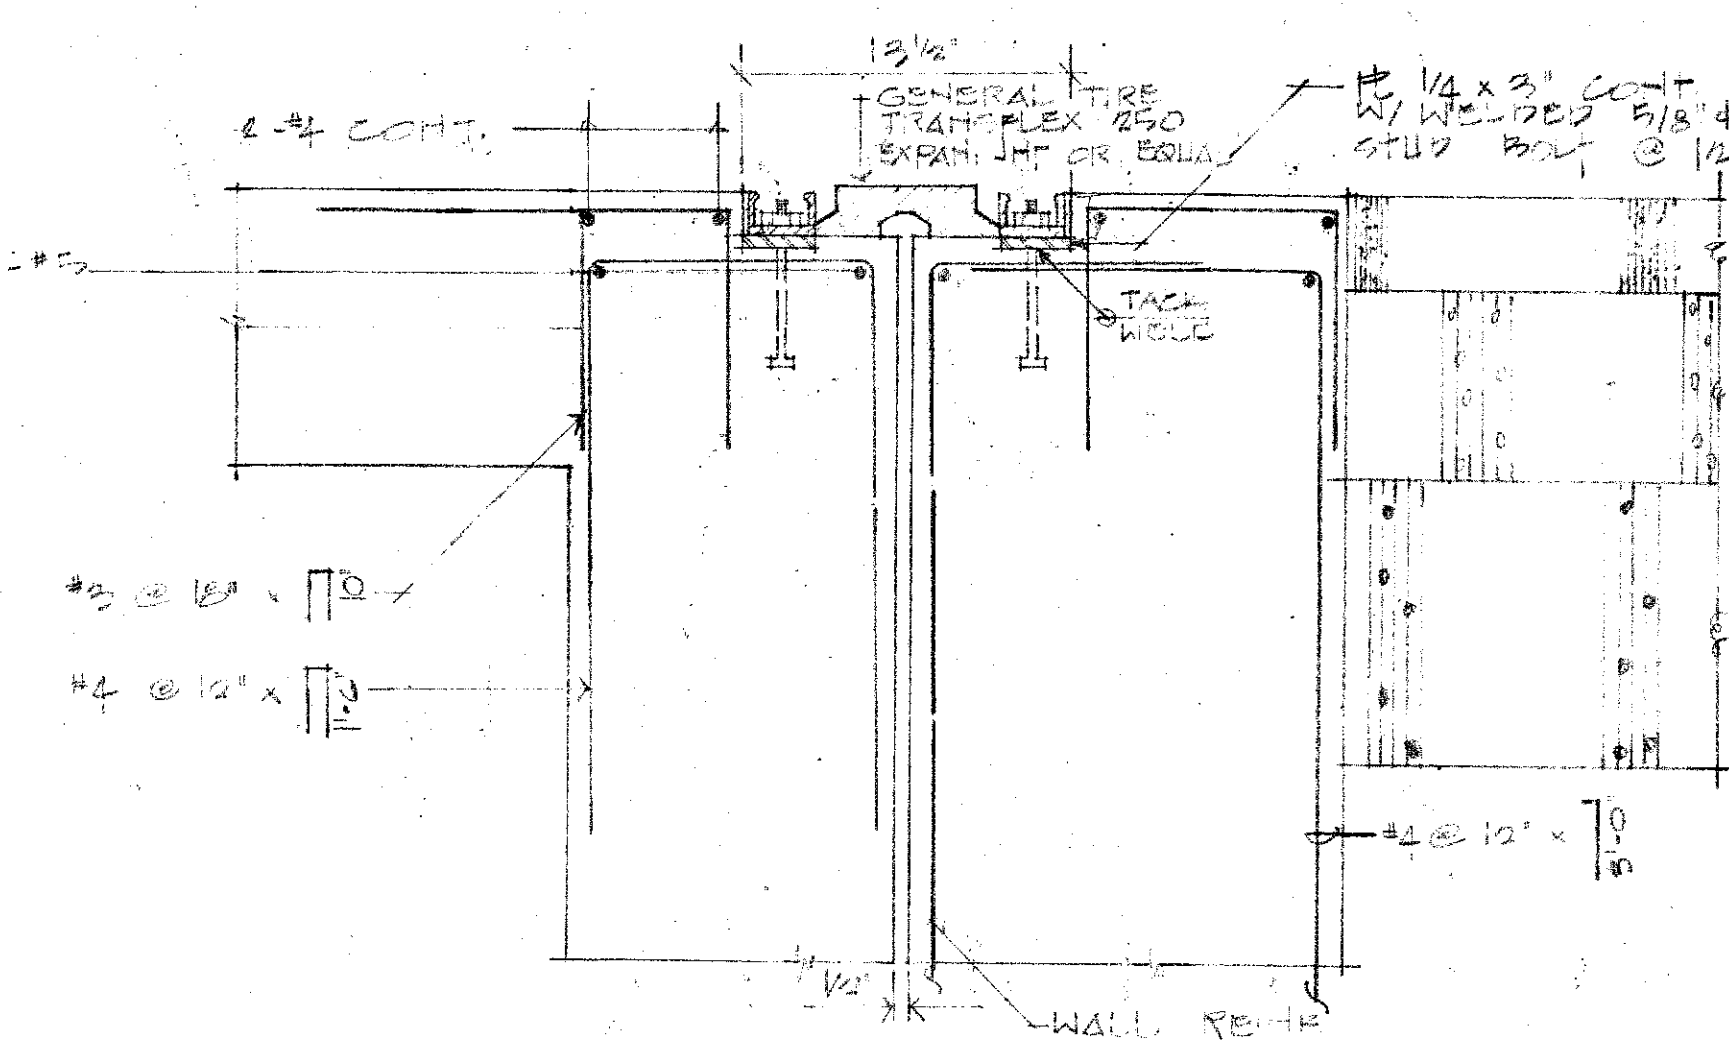

E SECTION @ COLUMN
1 1/2" = 1'-0"

U. S. DEPARTMENT OF AGRICULTURE
SOIL CONSERVATION SERVICE

NO.	DATE	DESCRIPTION	ENGR.	DEPT. OR DIV.

REVISIONS

APPR'D

DEPARTMENT OF PUBLIC WORKS

CITY AND COUNTY OF HONOLULU

DIVISION OF ENGINEERING

KAMEHAMEHA HIGHWAY BRIDGE

OVER KAHALUU STREAM

KAHALUU, OAHU, HAWAII

DETAILS

ENGINEER: M.S. DATE: 6/17/77

DRAFTSMAN: J.S. CHECKED BY:

APPROVED: J.S. 6/17/77

CHIEF, DIVISION OF ENGINEERING

J.B.

JOB NO. 38-77 DWG. NO. 7-E-23094