




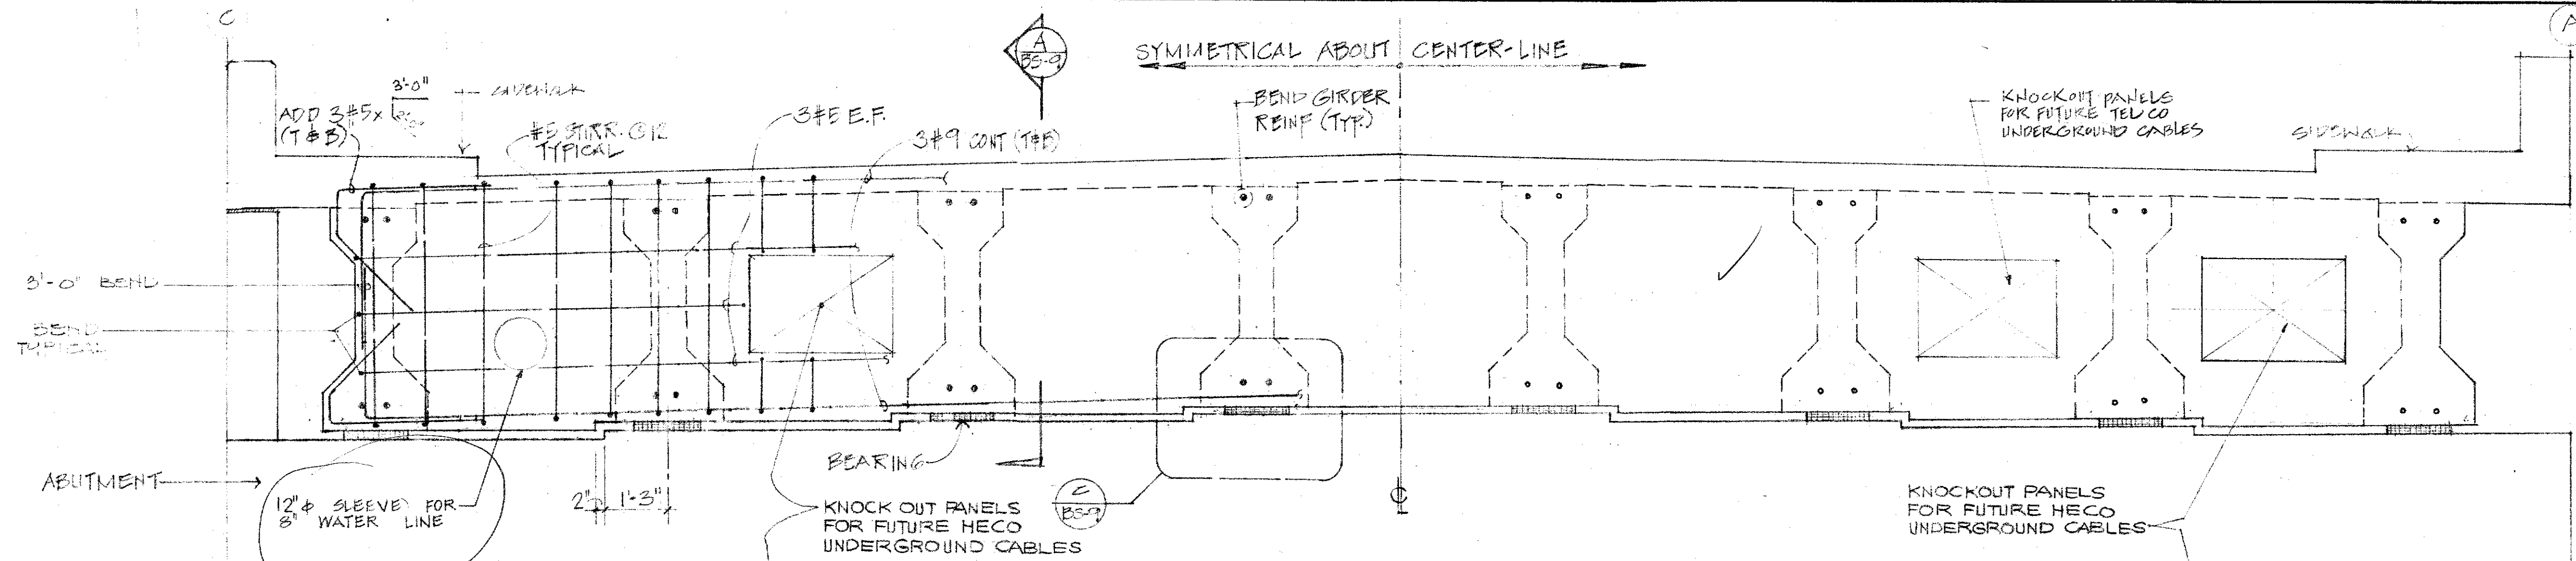


A SECTION THRU ABUTMENT DIAPHRAGM
 BS-13 SCALE: 1/2" = 1'-0"

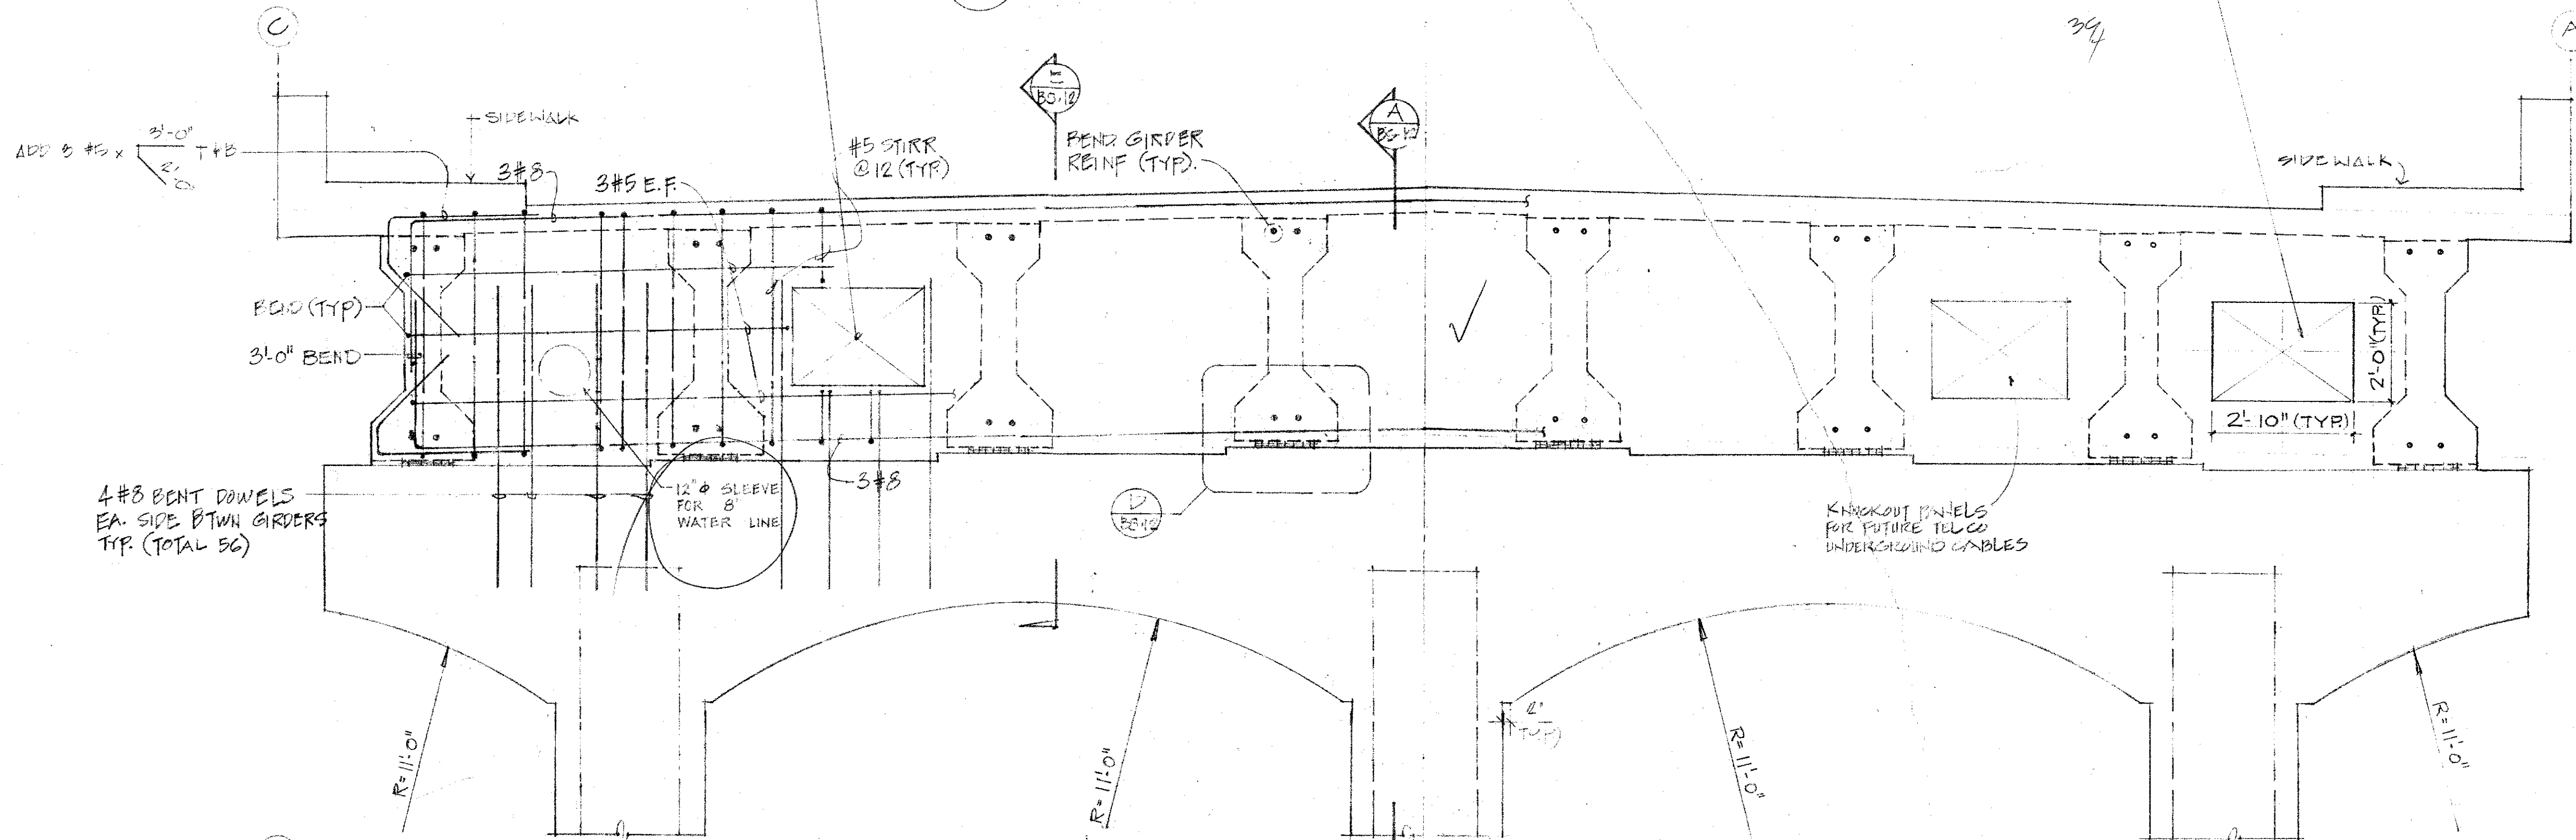

B SECTION THRU PIER CAP DIAPHRAGM
 BS-13 SCALE: 1/2" = 1'-0"

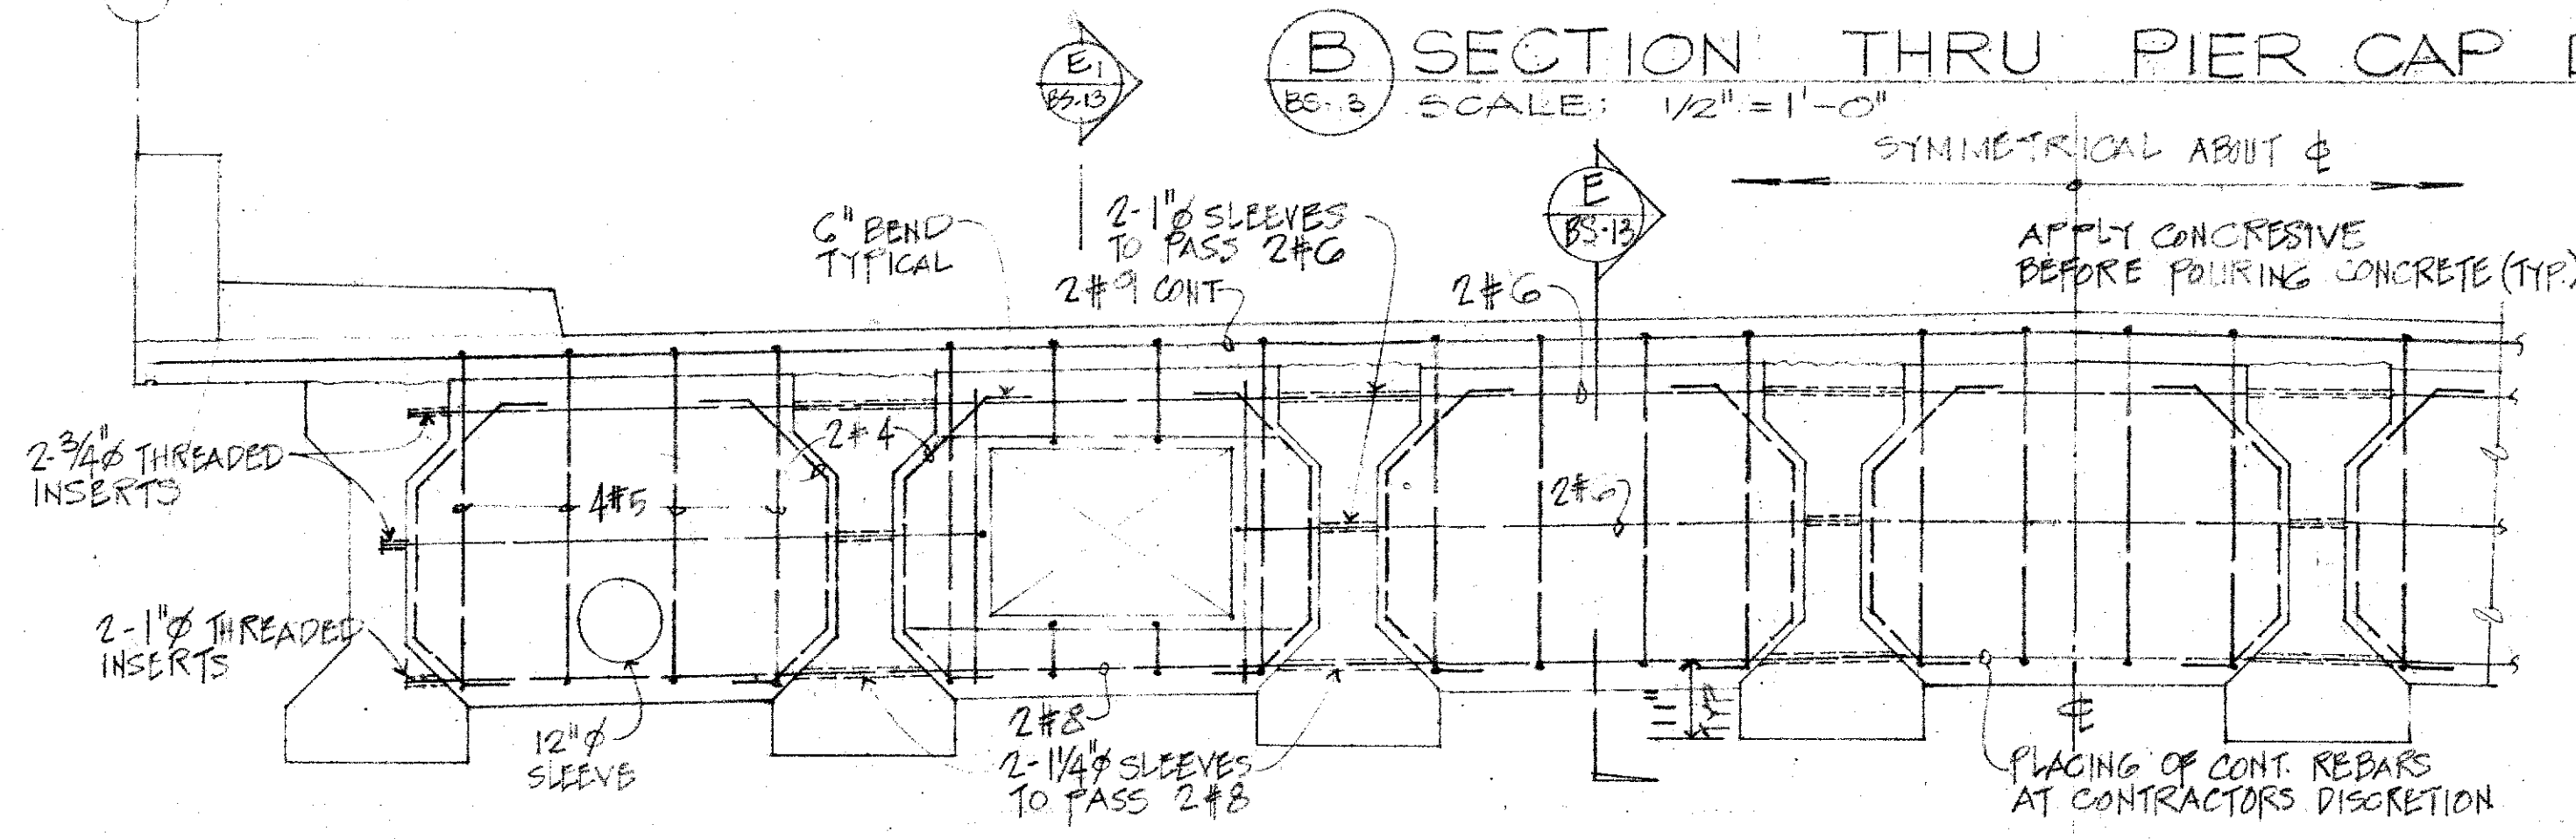


C INTERMEDIATE DIAPHRAGM ELEV.
 BS-13 1/2" = 1'-0"

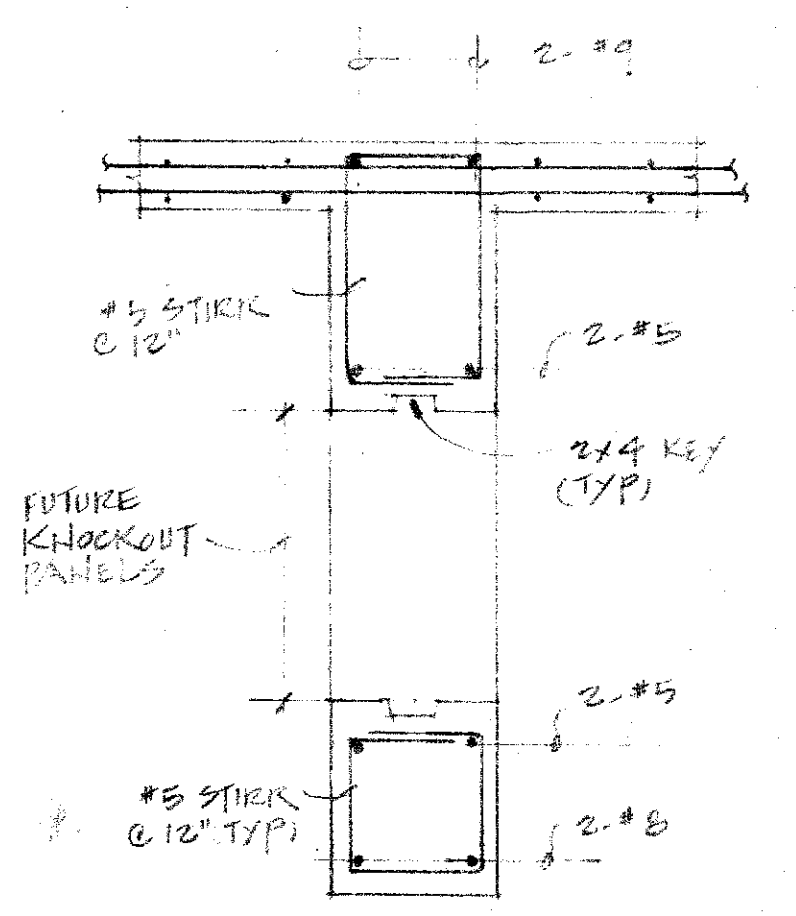

E1 SECTION
 BS-13 3/4" = 1'-0"

D DELETED
 BS-13

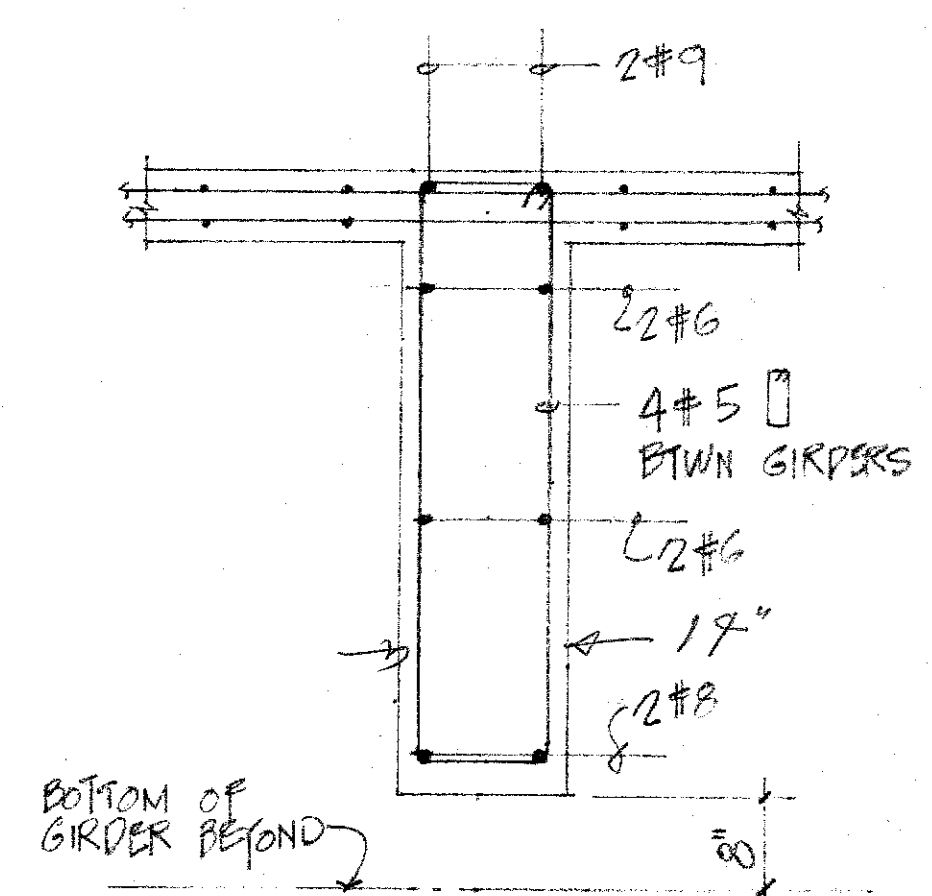

E SECTION
 BS-13 3/4" = 1'-0"

**U. S. DEPARTMENT OF AGRICULTURE
 SOIL CONSERVATION SERVICE**

NO.	DATE	DESCRIPTION	ENGR.	DEPT. OR DIV.
REVISIONS			APPR'D	

DEPARTMENT OF PUBLIC WORKS
 CITY AND COUNTY OF HONOLULU
DIVISION OF ENGINEERING
KAMEHAMEHA HIGHWAY BRIDGE
OVER KAHALUU STREAM
KAHALUU, OAHU, HAWAII
DIAPHRAGM DETAILS
 ENGINEER: M.T. DATE: 6/17/77
 DRAFTSMAN: JGL, JRL CHECKED BY: 6/17/77
 APPROVED: [Signature] CHIEF, DIVISION OF ENGINEERING

JOB NO. 38-77 DWG. NO. 7-E-23094