



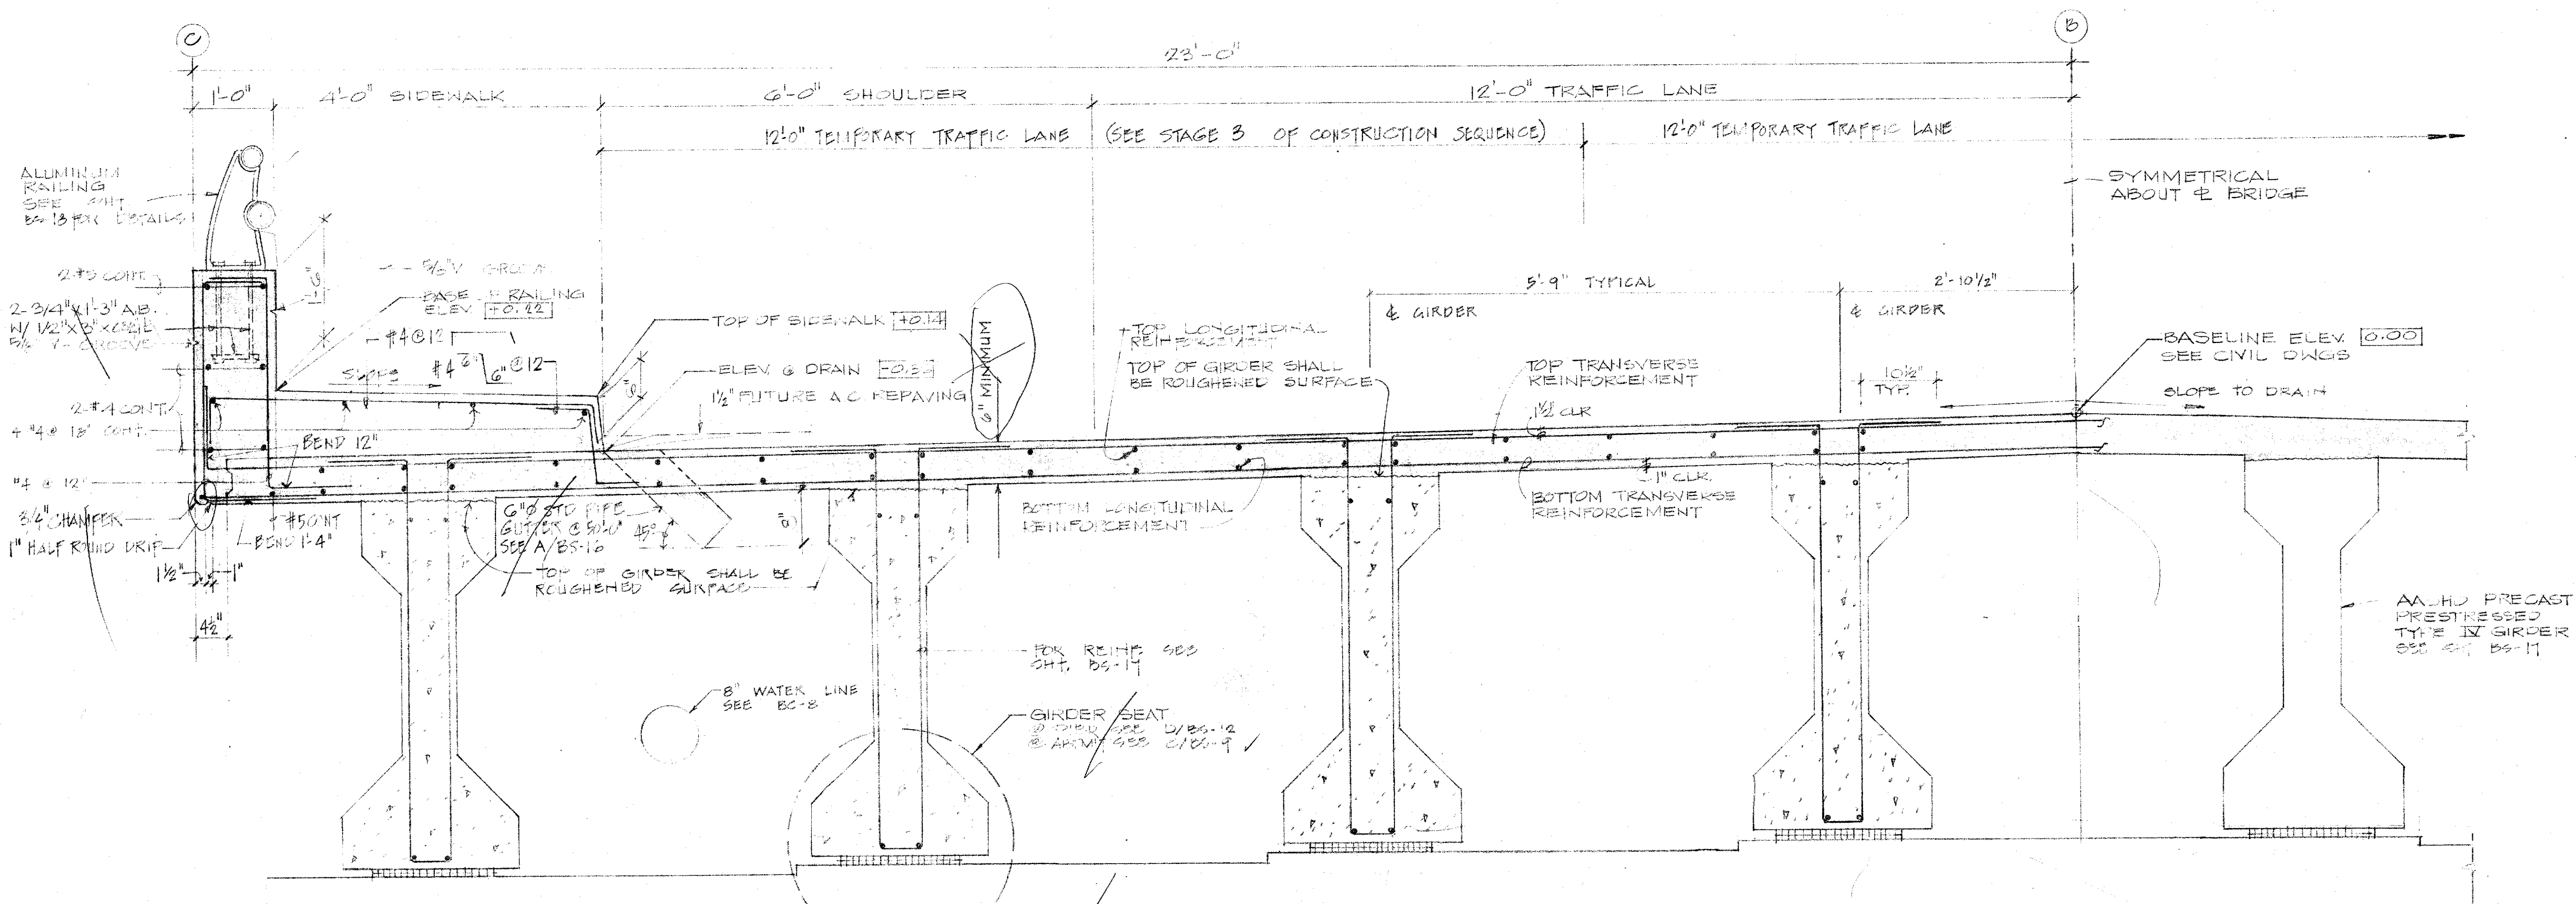

A TYPICAL SLAB SECTION
BS-14 1" = 1'-0"

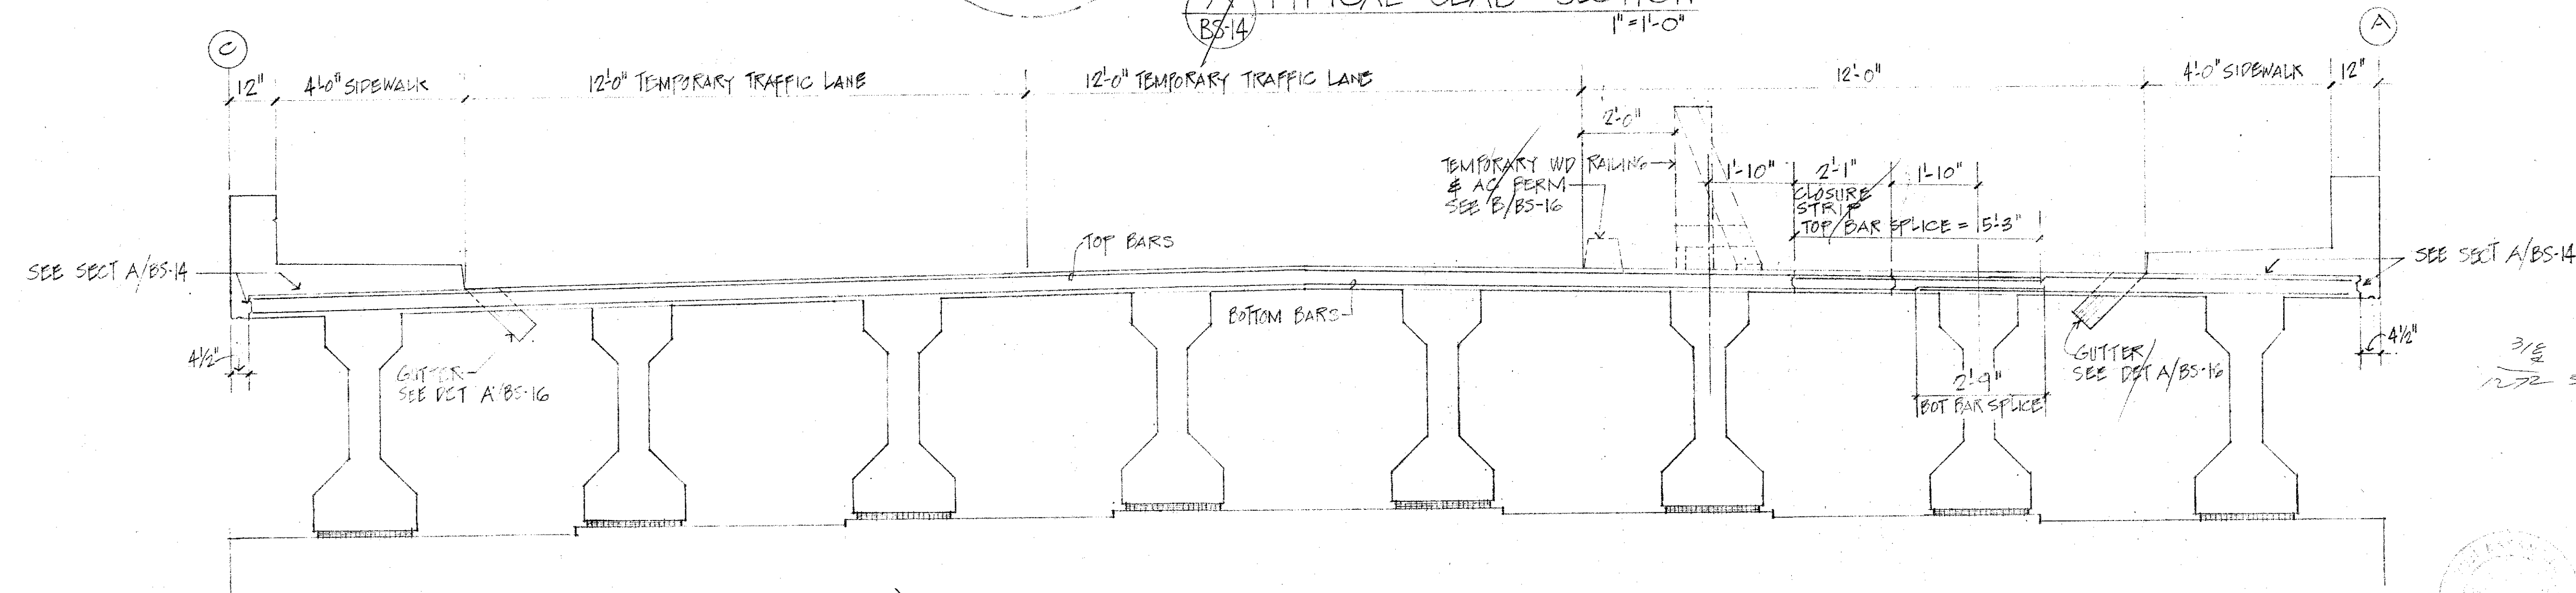

B TYP X-SECTION - 3RD STAGE CONSTRUCTION SEQUENCE
BS-14 1/2" = 1'-0"

U. S. DEPARTMENT OF AGRICULTURE
SOIL CONSERVATION SERVICE

NO.	DATE	DESCRIPTION	ENGR.	DEPT. OR DIV.
REVISIONS				
APPROVED				
DEPARTMENT OF PUBLIC WORKS CITY AND COUNTY OF HONOLULU				
DIVISION OF ENGINEERING				
KAMEHAMEHA HIGHWAY BRIDGE OVER KAHALUU STREAM KAHALUU, OAHU, HAWAII				
DETAILS				
ENGINEER	M. J.	DATE	6/17/77	
DRAFTSMAN	J. L.	CHECKED BY		
APPROVED				
CHIEF, DIVISION OF ENGINEERING				

JOB NO. 38-77 DWG. NO. 7-E-230 94