
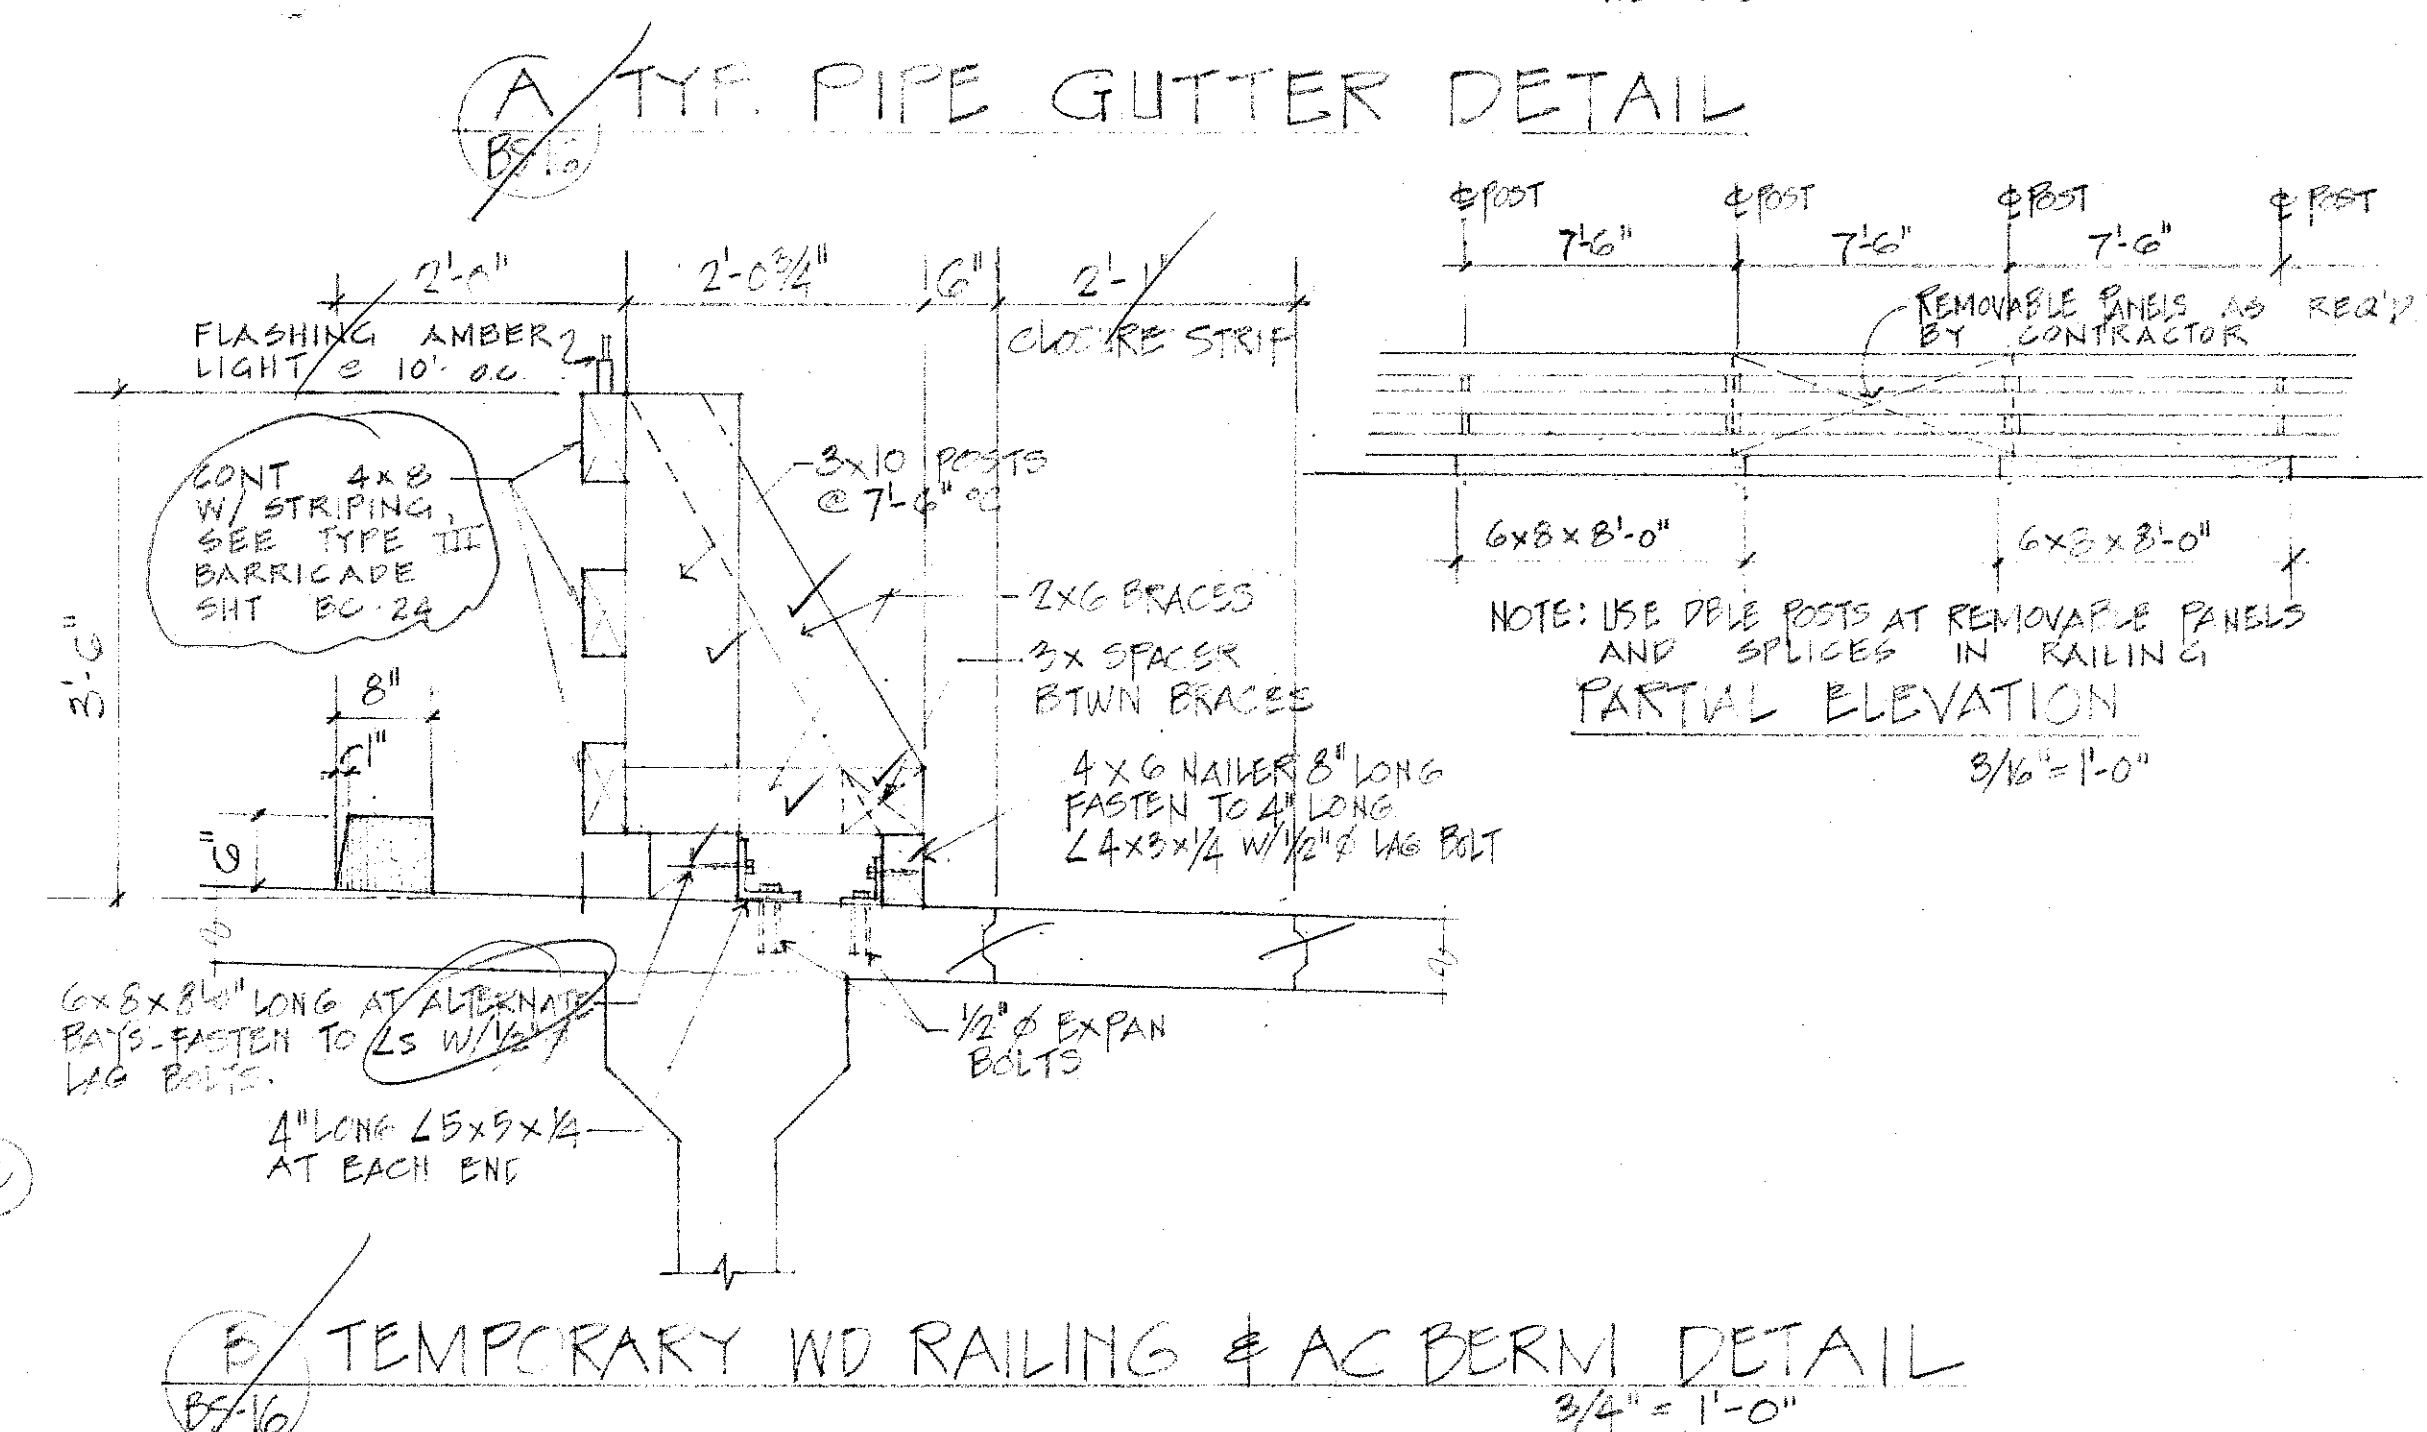
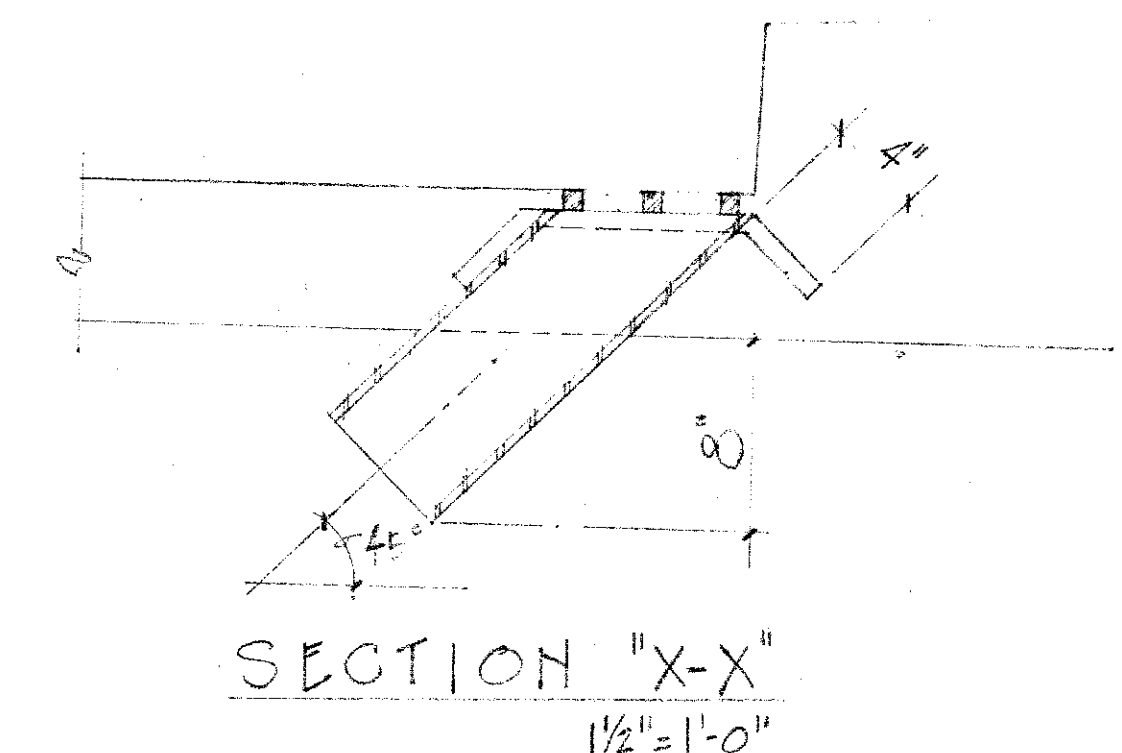


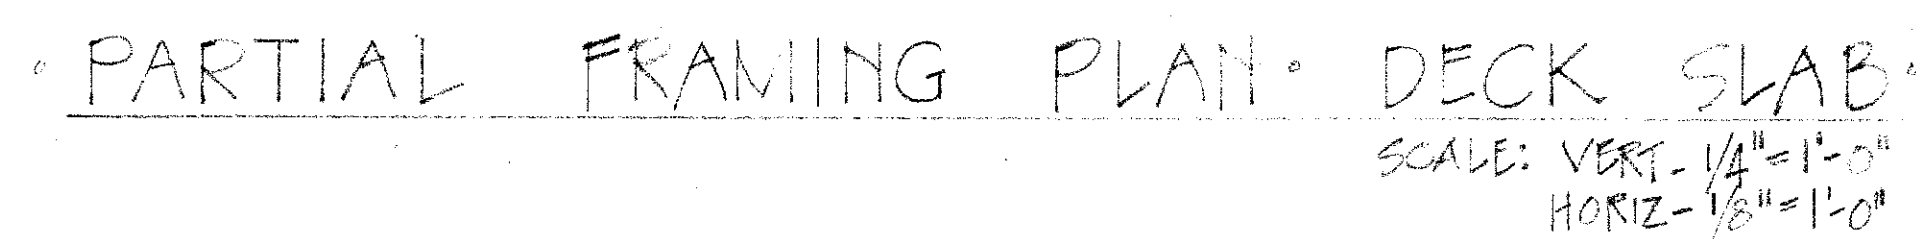

U. S. DEPARTMENT OF AGRICULTURE									
SOIL CONSERVATION SERVICE									
NO.		DATE		DESCRIPTION				ENGR. DEPT. OR DIV.	
REVISIONS								APPR'D	
DEPARTMENT OF PUBLIC WORKS CITY AND COUNTY OF HONOLULU DIVISION OF ENGINEERING KAMEHAMEHA HIGHWAY BRIDGE OVER KAHALUU STREAM KAHALUU, OAHU, HAWAII DECK SLAB DETAIL ENGINEER <u>M.T.</u> DATE <u>2/1/77</u> DRAFTSMAN <u>J.R.</u> CHECKED BY _____ APPROVED: <u>[Signature]</u> CHIEF DIVISION OF ENGINEERING <u>[Signature]</u>									
F B									
JOB NO. 38-77					DWG. NO. 7-E-23094				