


FED. ROAD DIST. NO.	STATE	FED. AID PROJ. NO.	FISCAL YEAR	SHEET NO.	TOTAL SHEETS
HAWAII	HAW.	STP-083-1(30)	1994	4	11

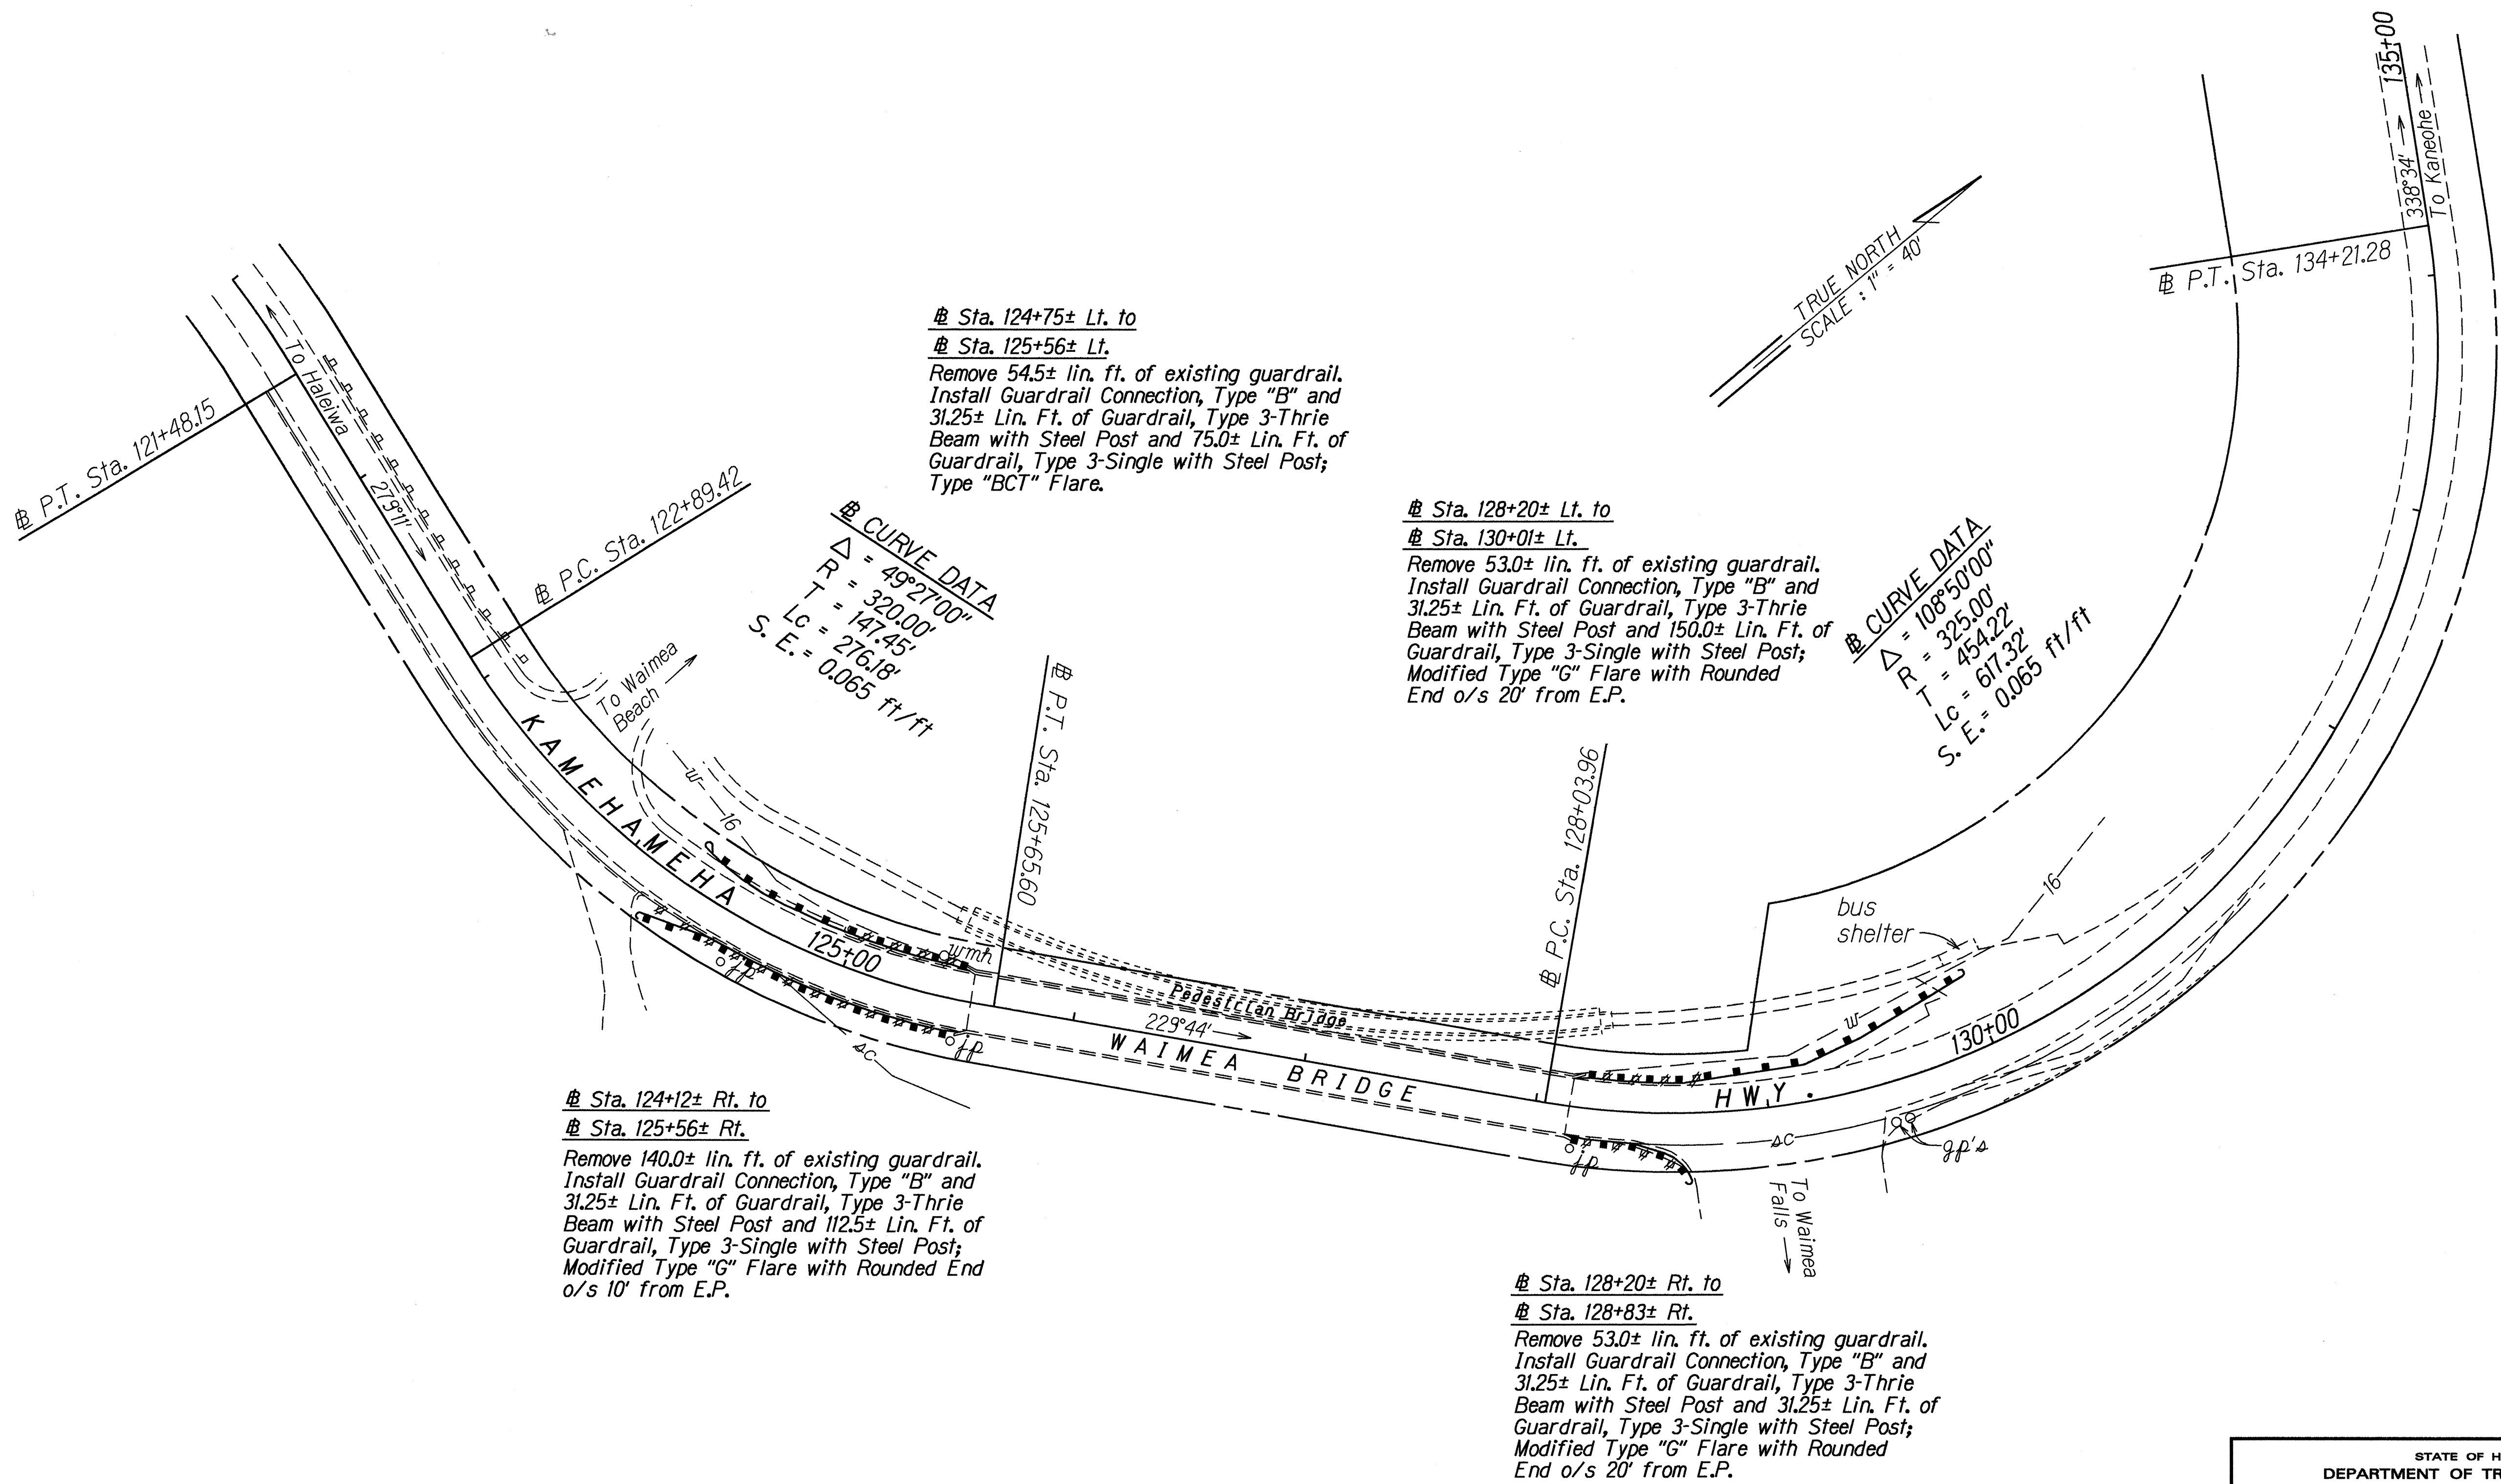

SURVEY PLOTTED BY	DATE
DESIGNED BY	5-18-94
TRACED BY	
NOTED BY	
QUANTITIES BY	
CHECKED BY	

STATE OF HAWAII
DEPARTMENT OF TRANSPORTATION
HIGHWAYS DIVISION

PLAN

KAMEHAMEHA HIGHWAY
Repair of Waimea & Paumalu Bridges
Fed. Aid Project No. STP-083-1(30)

Scale: 1" = 40'-0" Date: April 1994

SHEET No. 1 OF 1 SHEETS

6/10/94	Revised Guardrail Construction Notes.
DATE	REVISION