

INDEX TO DRAWINGS	
SHEET NO.	DESCRIPTION
1	TITLE SHEET
2	STANDARD PLAN SUMMARY
3 - 4	GENERAL NOTES AND LEGEND & HECO NOTES AND WATER NOTES
5 - 8	TYPICAL SECTIONS AND DETAILS
9 - 20	ROADWAY PLANS
21	GUARDRAIL DETAILS
22 - 24	M.E.L.T. DETAILS
25	TRAFFIC LEGEND, DETAILS & NOTES
26 - 37	PAVEMENT MARKING & SIGNING PLANS
38	TRAFFIC DETAILS
39	MISCELLANEOUS TRAFFIC SUMMARIES

STATE OF HAWAII

DEPARTMENT OF TRANSPORTATION

HIGHWAYS DIVISION

HONOLULU, HAWAII

"AS-BUILT"

PLANS FOR

KAMEHAMEHA HIGHWAY RESURFACING

MAKAO ROAD TO NANILOA LOOP AND





KAWELA CAMP ROAD TO VICINITY OF KUILIMA DRIVE

FEDERAL AID PROJECT NO. NH-083-1(31)

DISTRICT OF KOOLAULOA

ISLAND OF OAHU

FED. ROAD DIST. NO.	STATE	FED. AID PROJ. NO.	FISCAL YEAR	SHEET NO.	TOTAL SHEETS
HAWAII	HAW.	NH-083-1(31)	1995	1	39

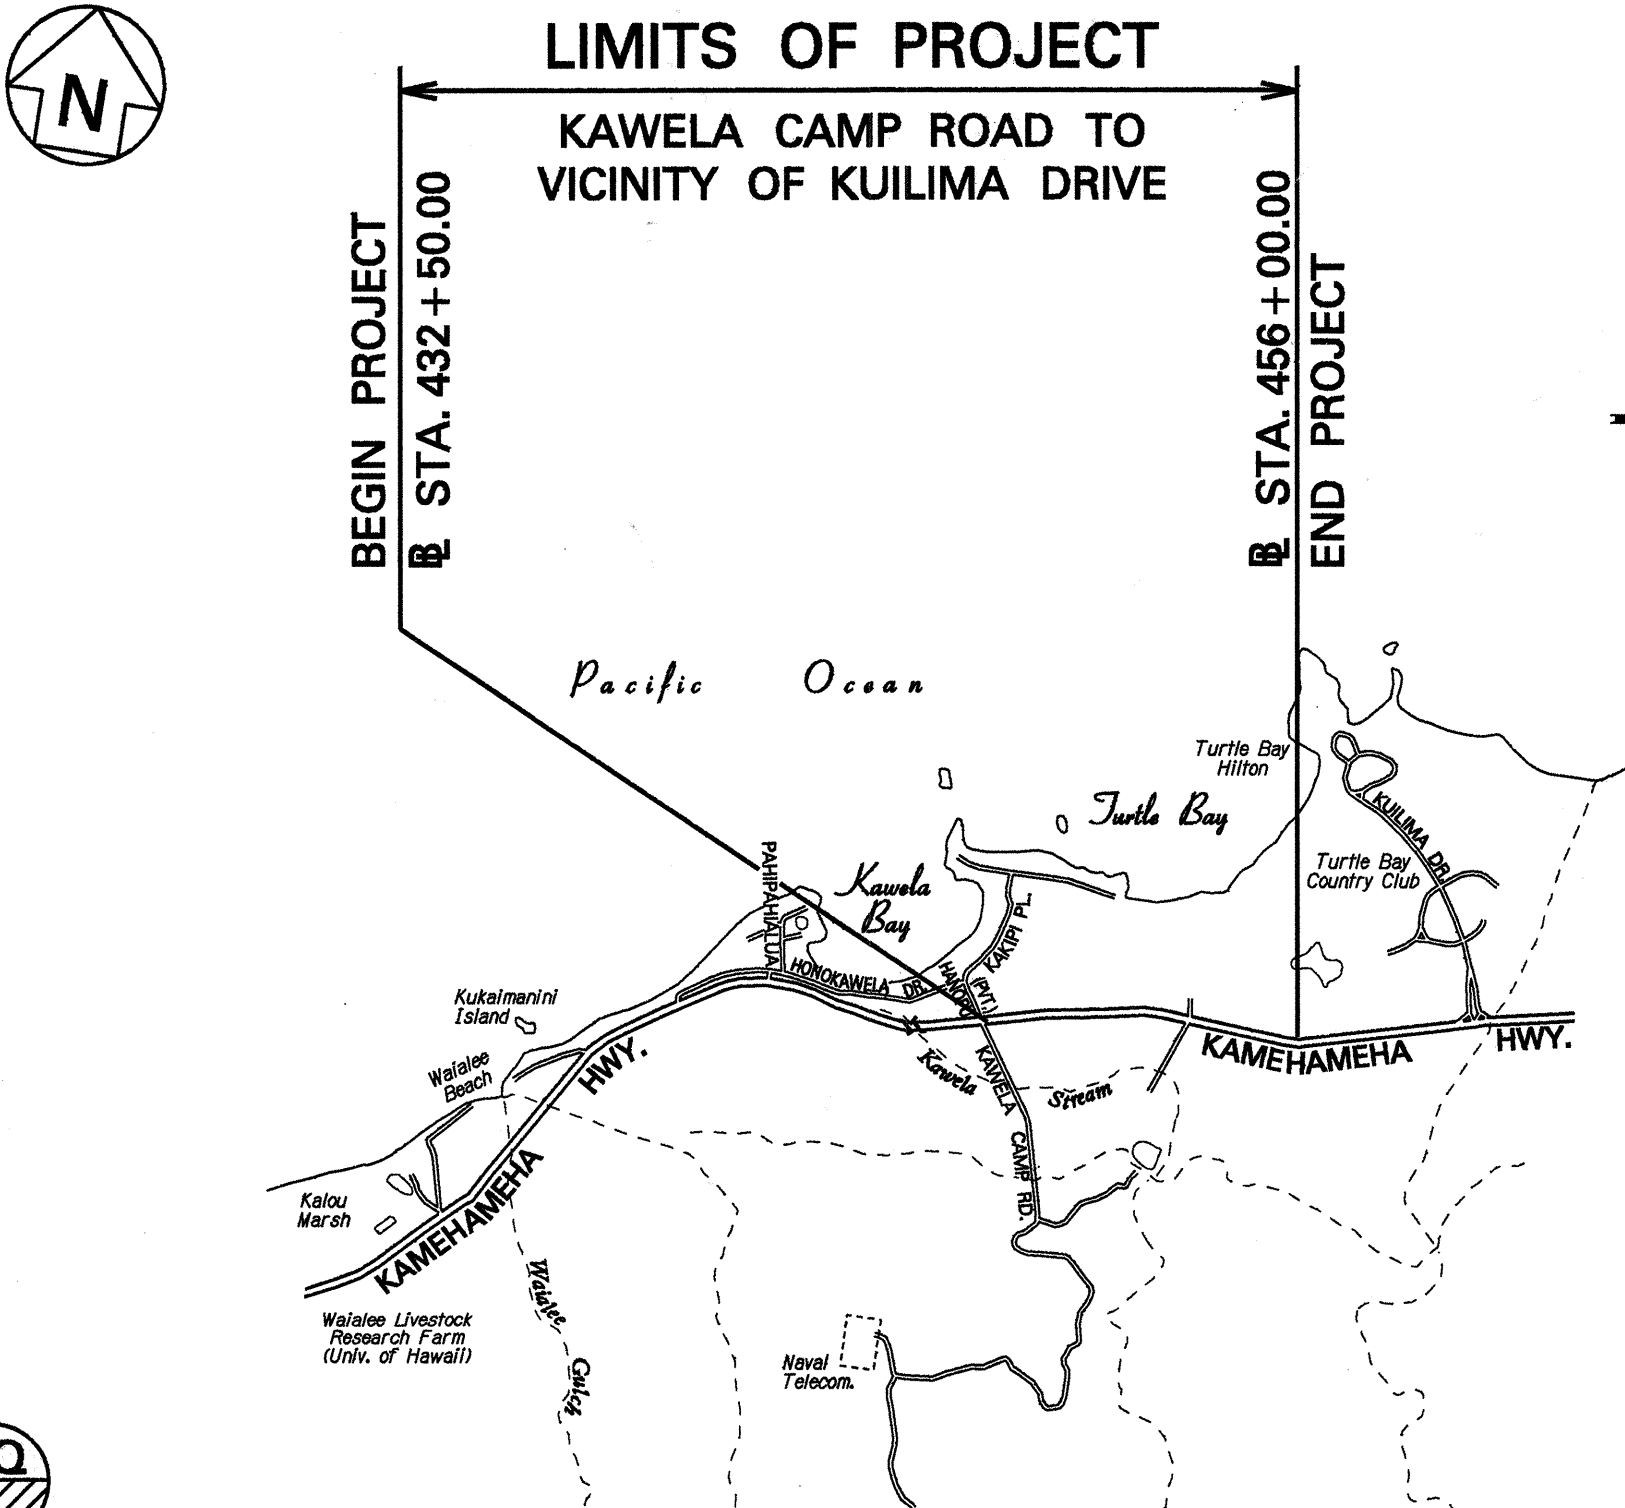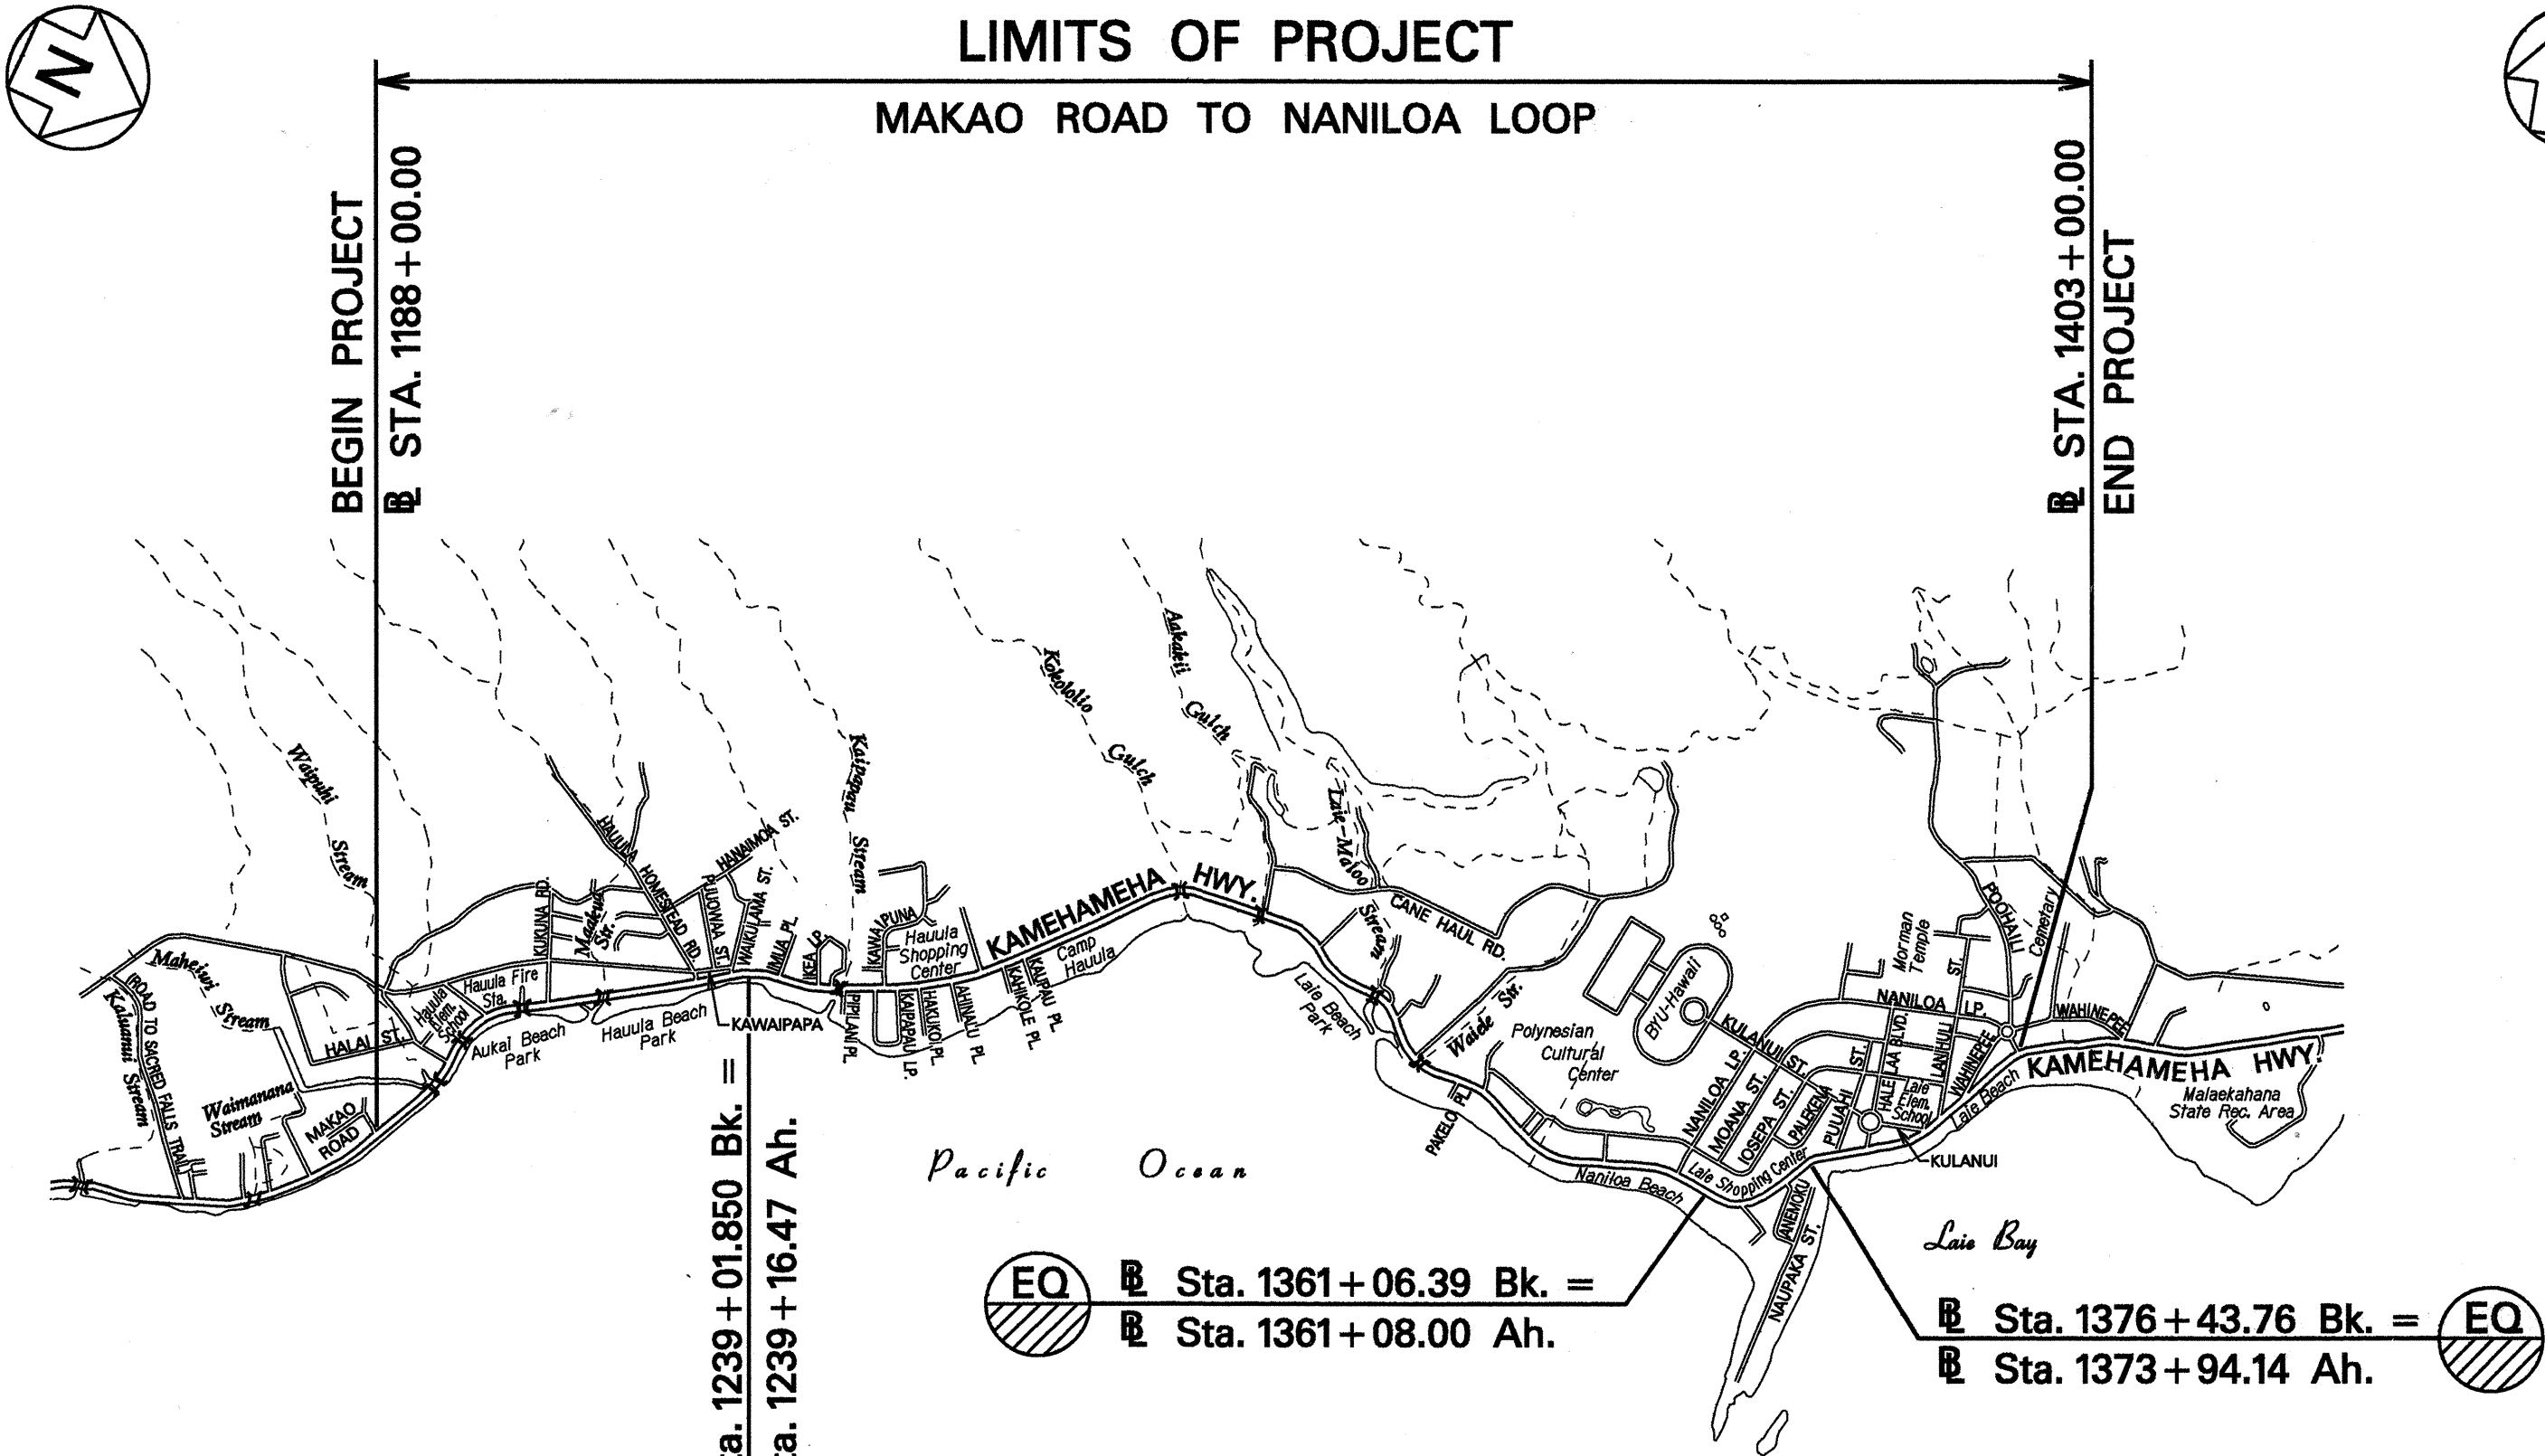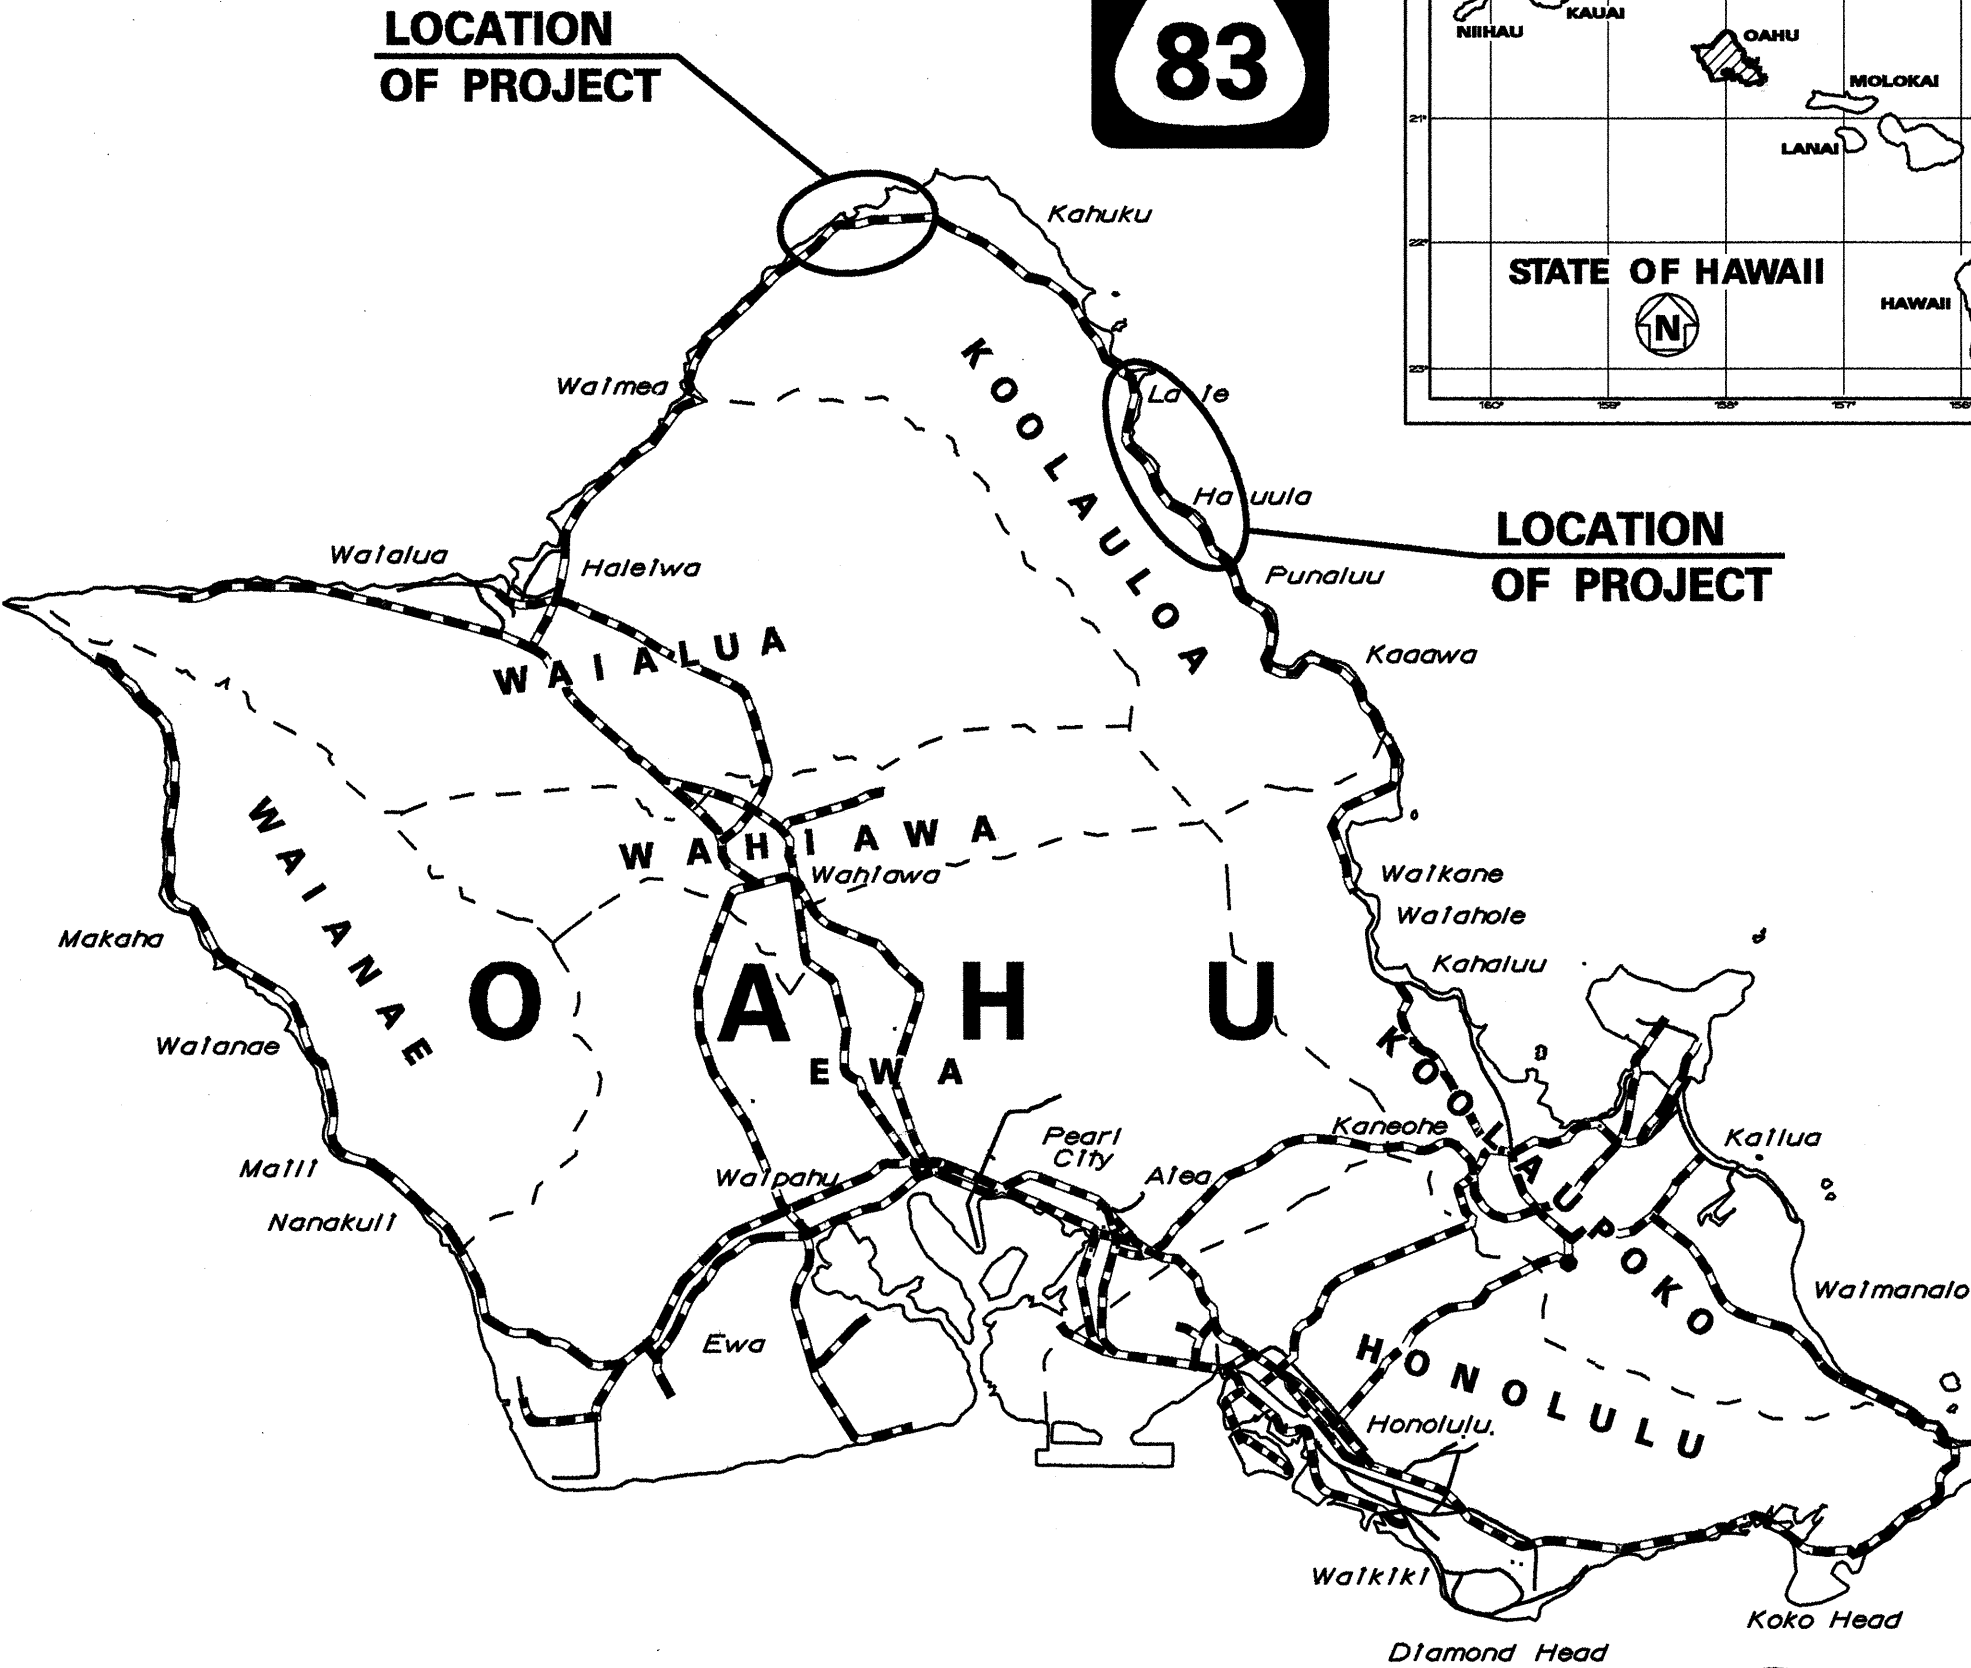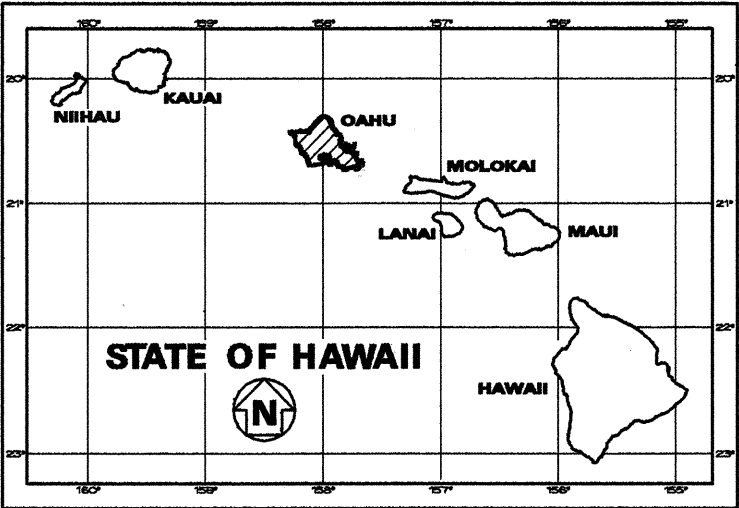

FEDERAL AID PROJECTS PREVIOUSLY CONSTRUCTED OR UNDER CONSTRUCTION

MILE POST 22.140 TO MILE POST 18.020

AND

MILE POST 11.400 TO MILE POST 11.960

DESIGN DESIGNATION

ADT (1994)	14,050
ADT (2004)	20,900
DHV	2,200
D	55/45
T	2.0%
V	25 M.P.H.

CHANGES MADE DURING CONSTRUCTION HAVE BEEN NOTED ON THESE PLANS AND CHECKED BY:

Yield Pamy

RESIDENT ENGINEER

10/29/98

DATE

DEPARTMENT OF TRANSPORTATION

STATE OF HAWAII

APPROVED:

Kayn Kuyukile

DIR. OF TRANSPORTATION

DATE

DESIGN UNIT "C"

DESIGNED BY

R. HIRONAKA

P.S. & E. BY

587-2250

PHONE

JUNE, 1994

DATE

LOCATION PLAN

GROSS LENGTH OF PROJECT..... 4.68 MILES

NET LENGTH OF PROJECT..... 4.68 MILES

