	INDEX TO DRAWINGS
SHEET NO.	DESCRIPTION
1	TITLE SHEET
2	STANDARD PLANS SUMMARY
3	TRAFFIC LEGEND & NOTES
4	PAVEMENT MARKING & SIGNING PLAN
5	TRAFFIC SIGNAL LEGEND & NOTES
6 – 7	TRAFFIC SIGNAL DETAILS
8()	TRAFFIC SIGNAL PLAN
9	SWING SIGN BRACKET DETAIL
10	CITY & COUNTY OF HONOLULU STREET NAME SIGN DETAIL
11	LOOP DETECTOR DETAILS

Sheet Nos. 1851-3 are supplementary sheets to this project. Total sheet count after "As-Built" posting is 14 sheets.

STATE OF HAWAII

## DEPARTMENT OF TRANSPORTATION

HIGHWAYS DIVISION HONOLULU, HAWAII

"AS-BUJU"


## PLANS FOR

# KAHEKILI HIGHWAY

TRAFFIC SIGNALS AT HUI IWA STREET (EAST)
FEDERAL AID PROJECT NO. STP-083-1(29)

DISTRICT OF KOOLAUPOKO ISLAND OF OAHU

### PROJECT LOCATION

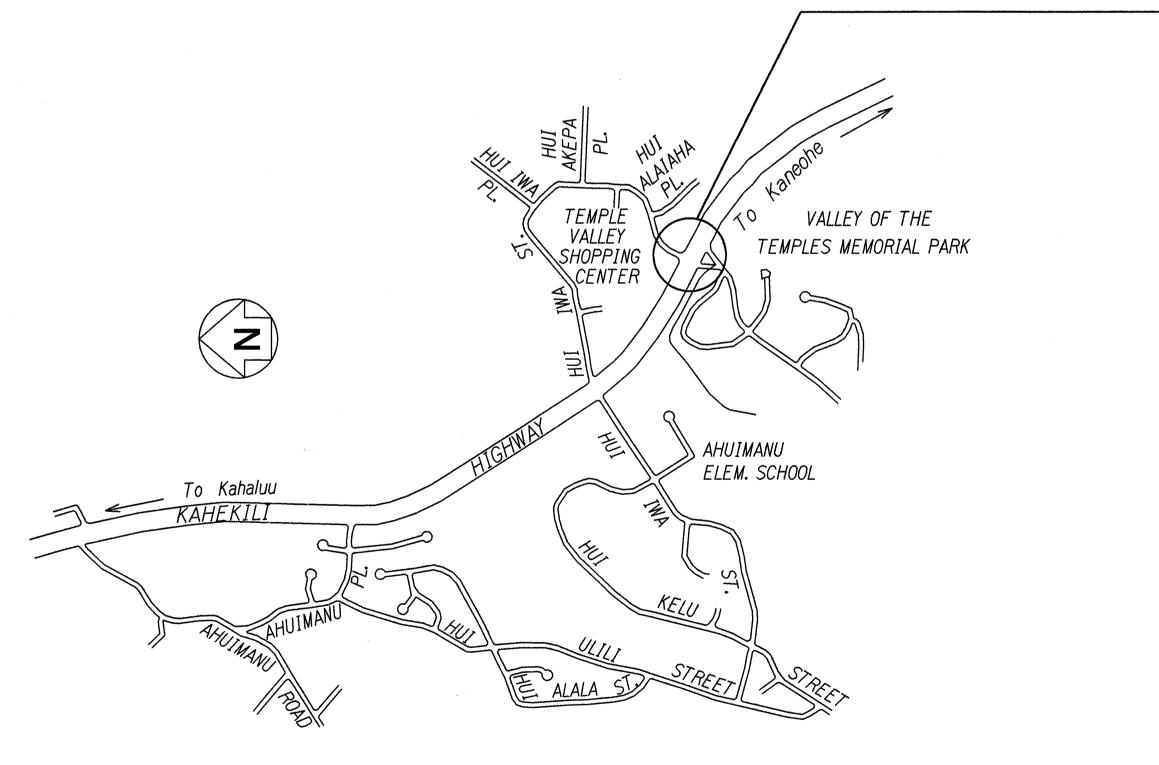

LAYOUT PLAN
0 0 800 1600 2400

SCALE IN HUNDRED FEET

Walance

FED. ROAD DIST. NO. FISCAL SHEET YEAR NO.

HAW. STP-083-1(29) 1995

OR UNDER CONSTRUCTION

MILE POST 38.15 TO MILE POST 38.35

#### DESIGN DESIGNATION

-		
ADT	(1994)	29,219
ADT	(2014)	43,829
DHV	<b>,</b>	3,379
<b>D</b> .		52/48
Τ.		2.0 %
24 ·		3.0 %
<b>V</b> .		45 M.P.H.

NO SIGNIFICANT CHANGES WERE MADE DURING CONSTRUCTION ON THESE PLANS EXCEPT CHARGES IN THE ORIGINAL THEORETICAL QUANTITIES, POS ACTUAL QUANTITIES, REFER TO PROJECT LIDER AND/OR COMPUTATION BOOK.

JUNE 11/3/97
RESIDENT ENGINEER

DATE

DEPARTMENT OF TRANSPORTATION STATE OF HAWAII		
APPROVED:		
tagn Harjachich	5/1/95	
DIR. OF TRANSPORTATION	DATE	

S. & E. BY PHONE DATE

HWY-TD

SCALE IN MILES