| INDEX TO DRAWINGS |  |
|-------------------|--|
| SHEET NO.         | DESCRIPTION  |
| 1                 | TITLE SHEET  |
| 2                 | STANDARD PLAN SUMMARY                              |
| 3                 | GENERAL NOTES & LEGEND                             |
| 4 – 5             | KALUANUI STREAM BRIDGE<br>REPAIR PILES & PIER CAPS |
|                   |  |
|                   |  |
|                   |  |
|                   |  |
| #                 |  |
|                   |  |
|                   |  |
SCALE IN HUNDRED FEET

STATE OF HAWAII


## DEPARTMENT OF TRANSPORTATION

HIGHWAYS DIVISION HONOLULU, HAWAII "AS-BUILT"

PLANS FOR

## KAMEHAMEHA HIGHWAY REPAIR OF KALUANUI BRIDGE FEDERAL AID PROJ. NO. NH-083-1(32)

DISTRICT OF KOOLAULOA ISLAND OF OAHU

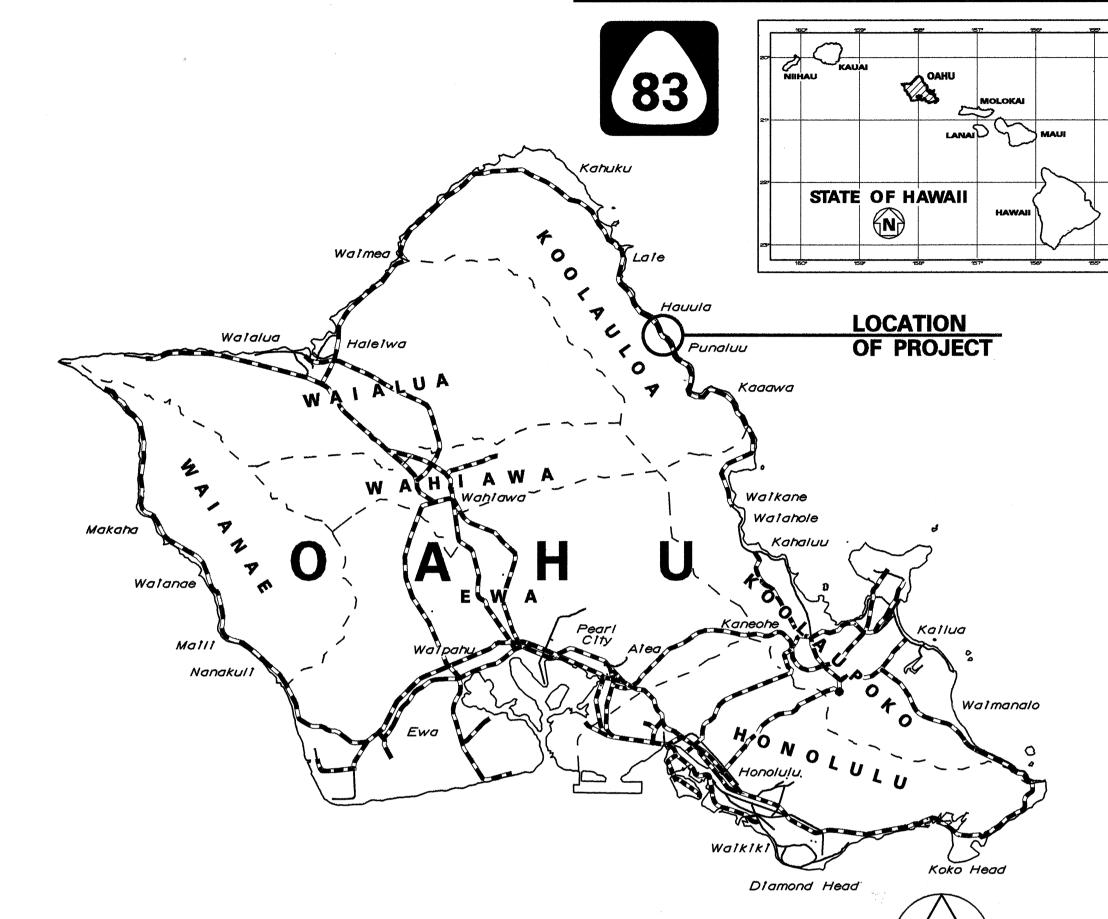

FED. ROAD DIST. NO.

FED. AID PROJ. NO.

NH-083-1(32)

