INDEX TO DRAWINGS
DESCRIPTION
TITLE SHEET
STANDARD PLANS SUMMARY SHEET
NOTES & LEGEND
TRAFFIC SIGNAL SYSTEM PLAN
PAVEMENT STRIPING/MARKING &
SIGNING PLAN
MISCELLANEOUS DETAILS
LOOP DETECTOR DETAILS

STATE OF HAWAII


DEPARTMENT OF TRANSPORTATION


HIGHWAYS DIVISION
HONOLULU, HAWAII
"AS-BUILT"

PLANS FOR

KAHEKILI HIGHWAY TRAFFIC SIGNALS
AND INTERCONNECTION AT
AHUIMANU PLACE AND HUI IWA STREET (WEST)
PROJECT NO. 83F-02-90

DISTRICT OF KOOLAUPOKO ISLAND OF OAHU

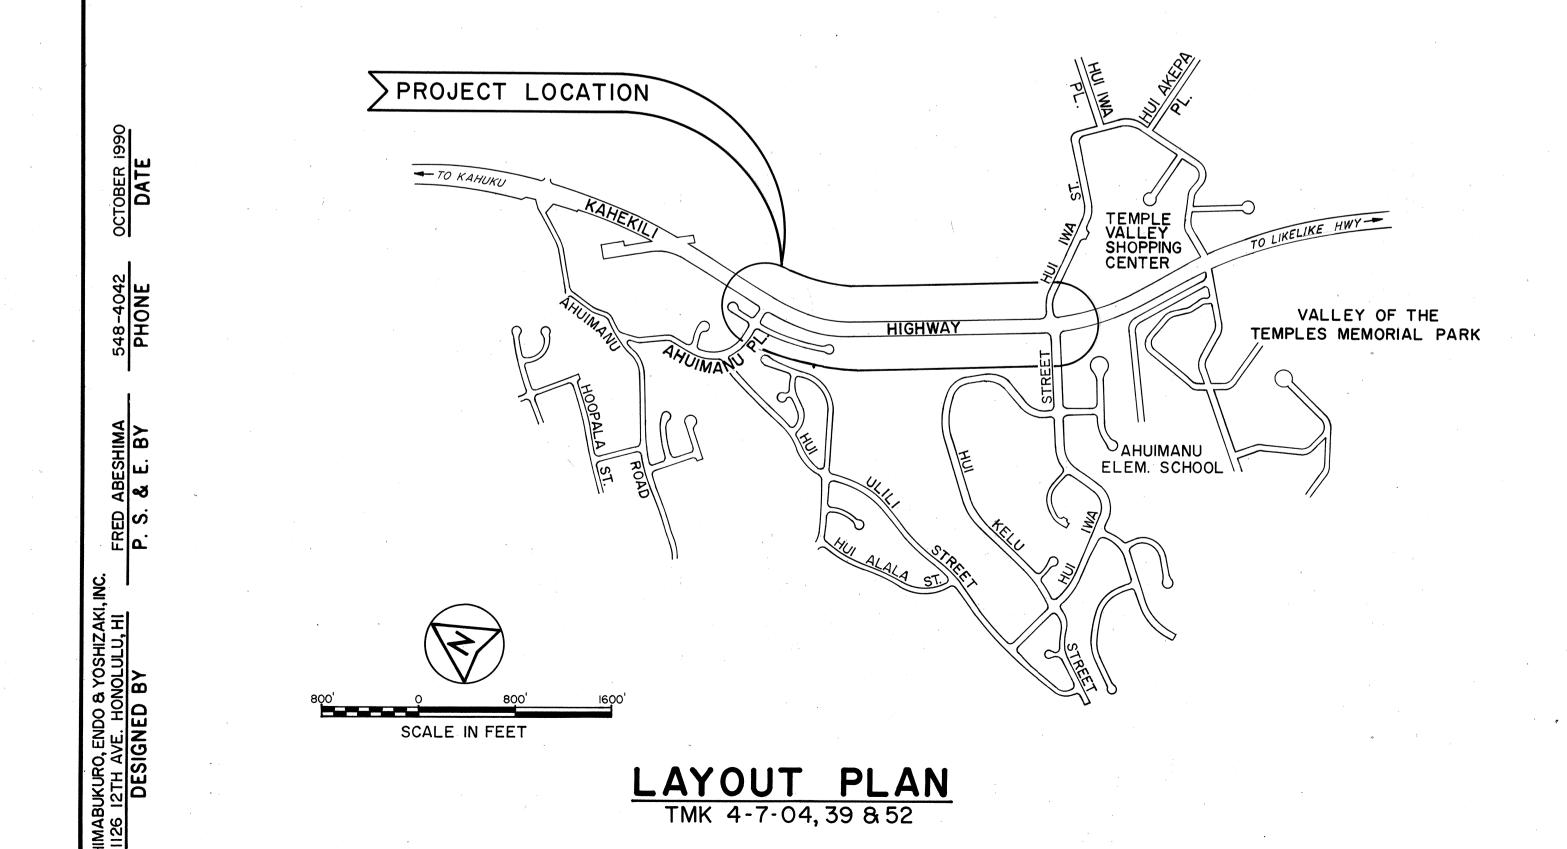

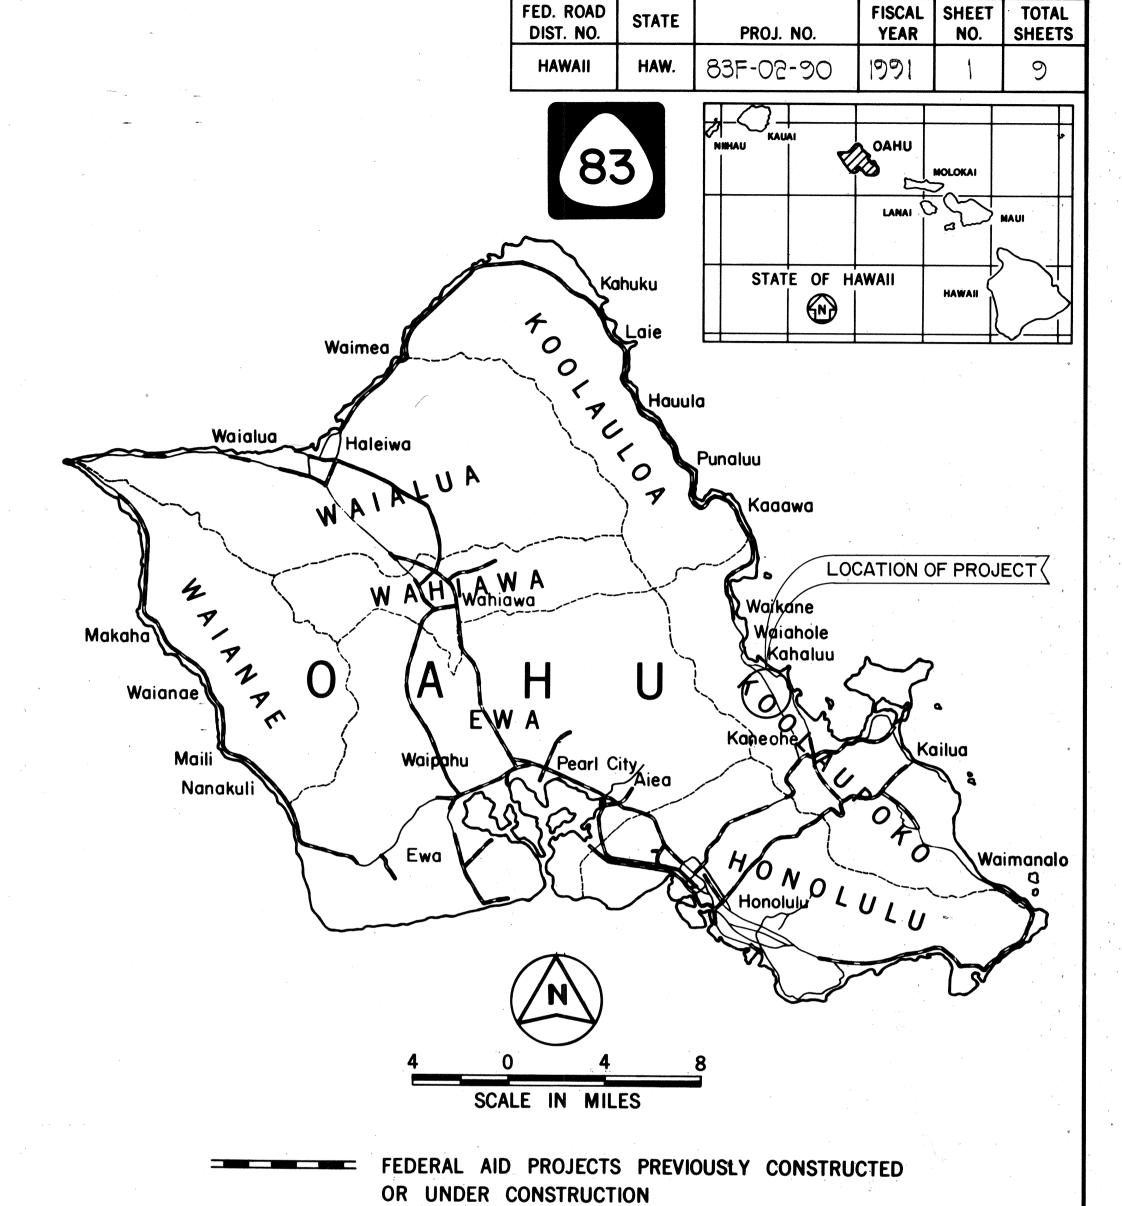

CHANGES MADE DURING CONSTRUCTION HAVE BEEN INCORPORATED ON THESE PLANS EXCEPT CHANGES IN THE ORIGINAL THEORETICAL QUANTITIES, REFER TO PROJECT LEDGER AND/OR COMPUTATION BOOK.

RESIDENT ENGINEER

11/22/9/ DATE

DEPARTMENT OF TRANSPORTATION
STATE OF HAWAII

APPROVED:

Lange 11/5/90
DIR. OF TRANSPORTATION DATE