

SHEET NO. 045-1 IS A SUPPLEMENTARY SHEET TO THIS PROJECT. TOTAL SHEET COUNT AFTER AS-BUILT POSTING 5 SHTS. STATE OF HAWAII

DEPARTMENT OF TRANSPORTATION

HIGHWAYS DIVISION HONOLULU, HAWAII

"AS-BUILT"


PLANS FOR

KAMEHAMEHA HIGHWAY

SOUTH PUNALUU BRIDGE REPAIR

PROJECT NO. 83D-01-90M

DISTRICT OF KOOLAULOA
ISLAND OF OAHU

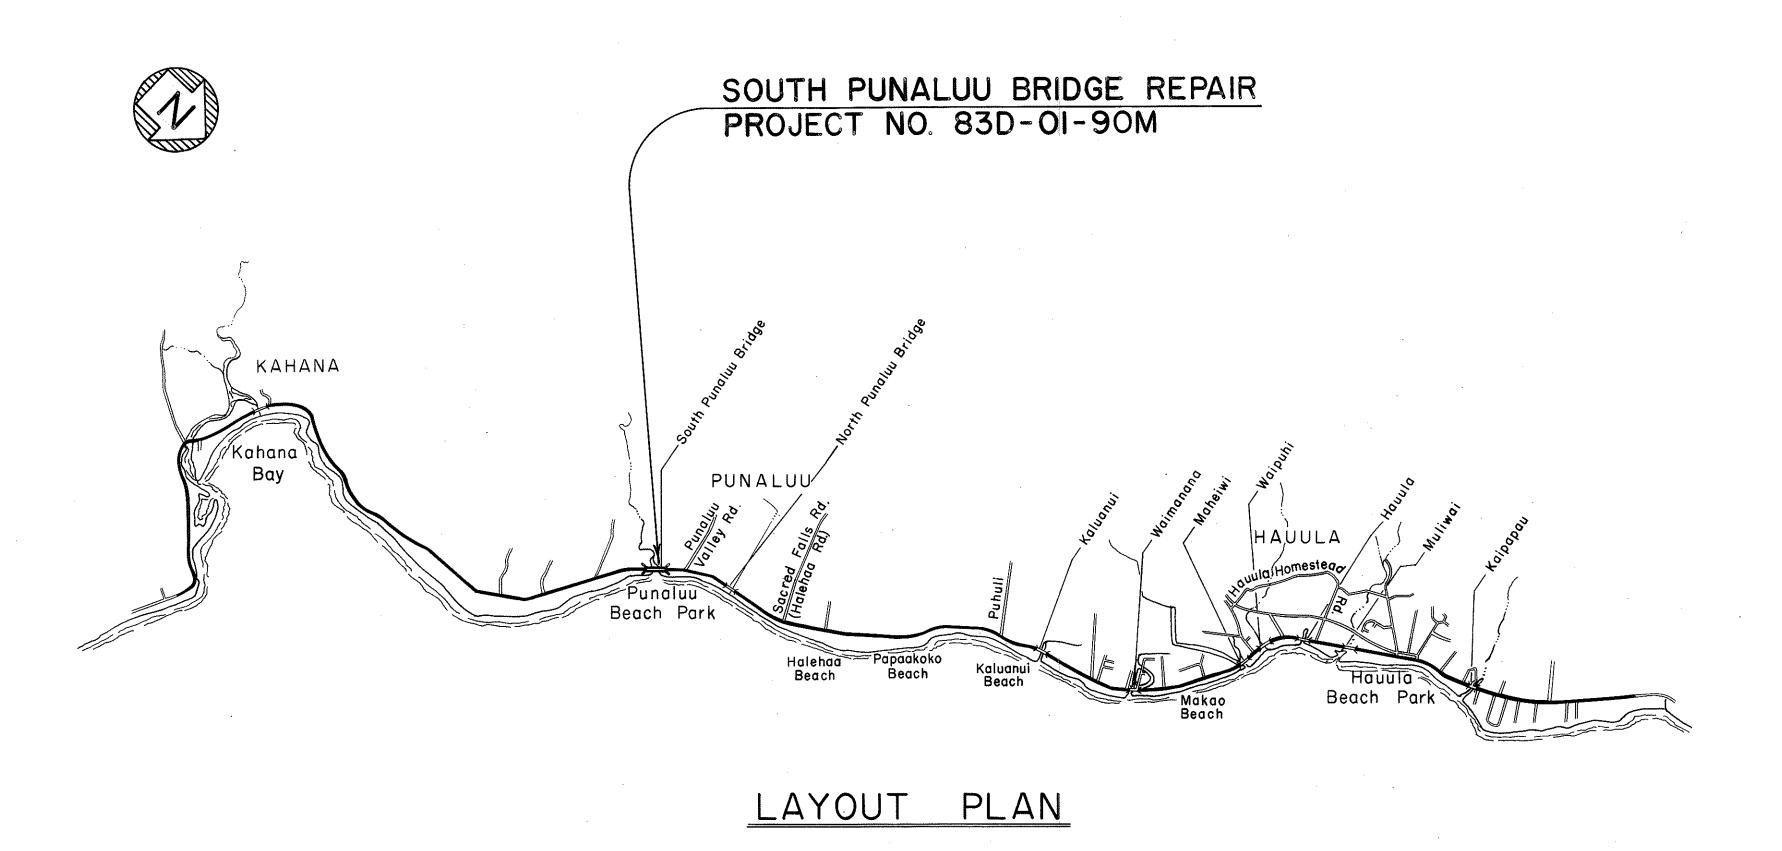

SCALE IN THOUSAND FEET

Wainana Wainana Pearl City

Wainana Pearl City

Aiea

SCALE IN MILES

FED. ROAD DIST. NO.

PROJ. NO.

83D-01-90M

MILE POST 24.42 TO MILE POST 24.42

CHANGES MADE DURING CONSTRUCTION HAVE BEEN INCORPORATED ON THESE PLANS EXCEPT CHANGES IN THE ORIGINAL THEORETICAL QUANTITIES. FOR ACTUAL QUANTITIES, REFER TO PROJECT LEDGER AND/OR COMPUTATION BOOK.

RESIDENT ENGINEER

DATE

11/26/01

DEPARTMENT OF TRANSPORTATION STATE OF HAWAII APPROVED:

DIR. OF TRANSPORTATION DATE

2-8-0-00

A. YAMAGUCHI P. S. & E. BY

HWY - DB DESIGNED BY