
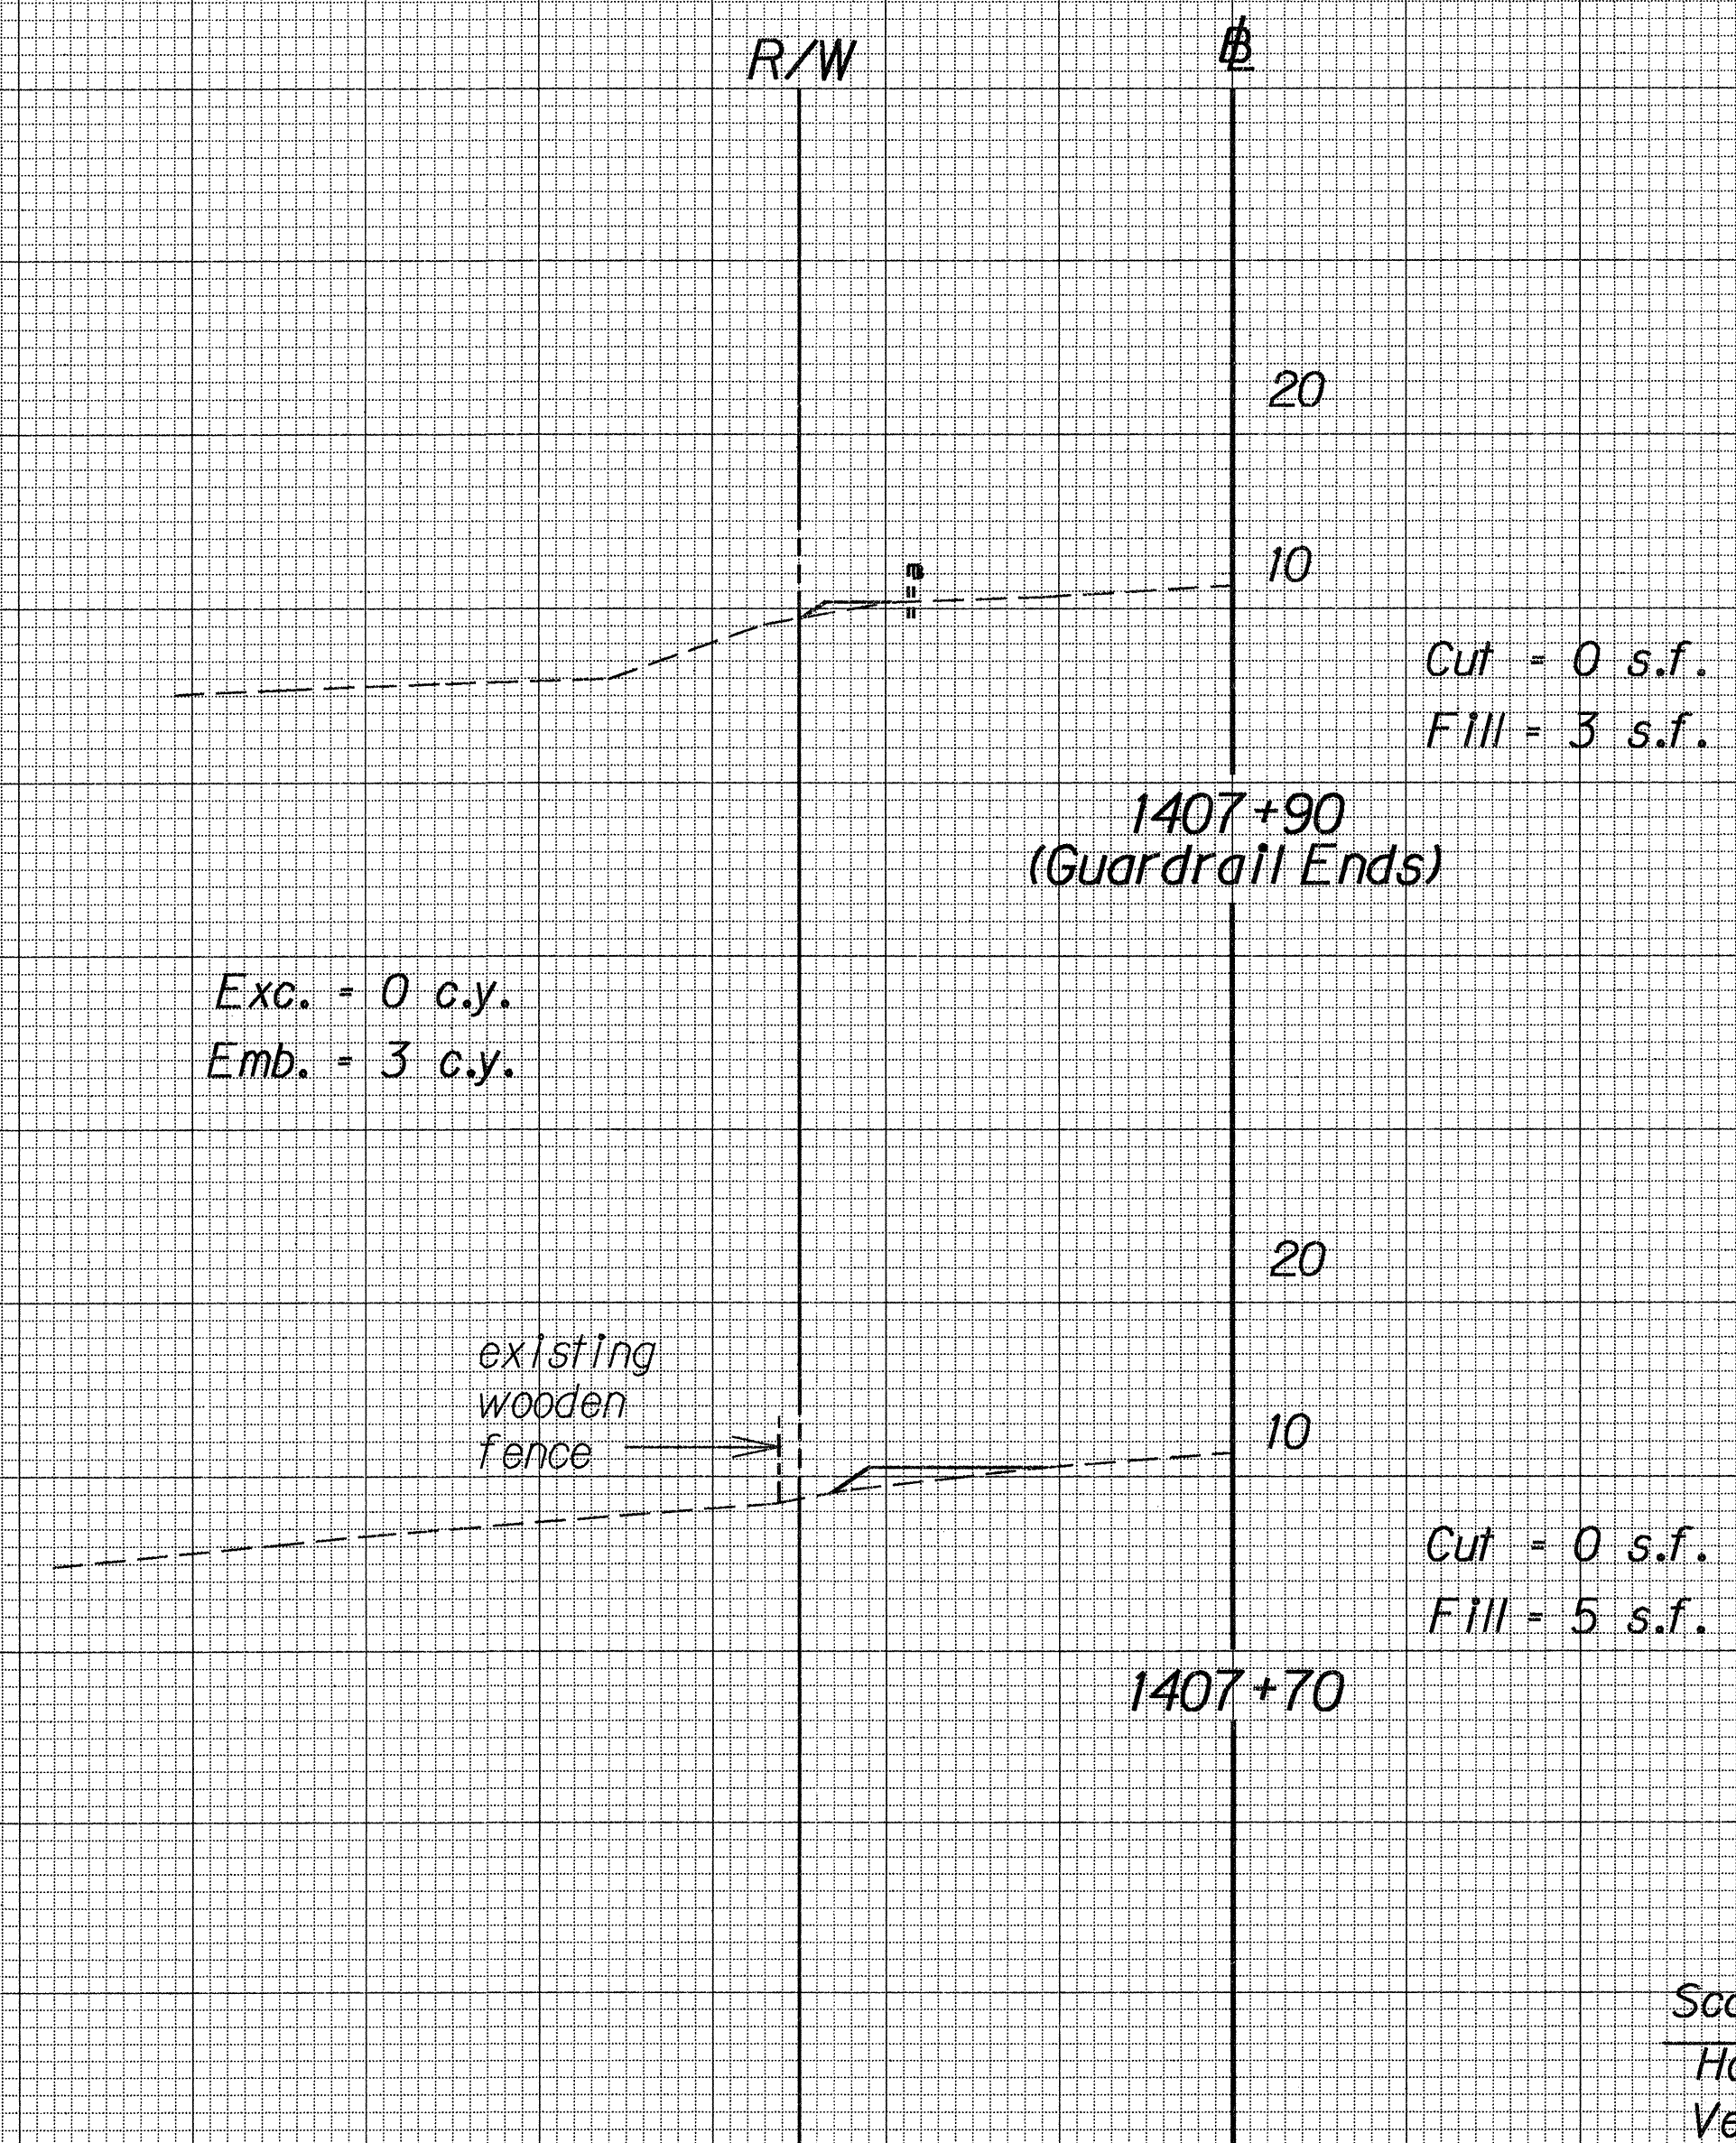


FED. ROAD DIST. NO.	STATE	FED. AID PROJ. NO.	FISCAL YEAR	SHEET NO.	TOTAL SHEETS
HAWAII	HAW.	83C-02-91M	1991	CO ADD.9	9
6-1-91 10-1-91		Addendum- Revised CRM Wall Revised CRM Wall and Added Type 2D Curb			
Date		Revision			

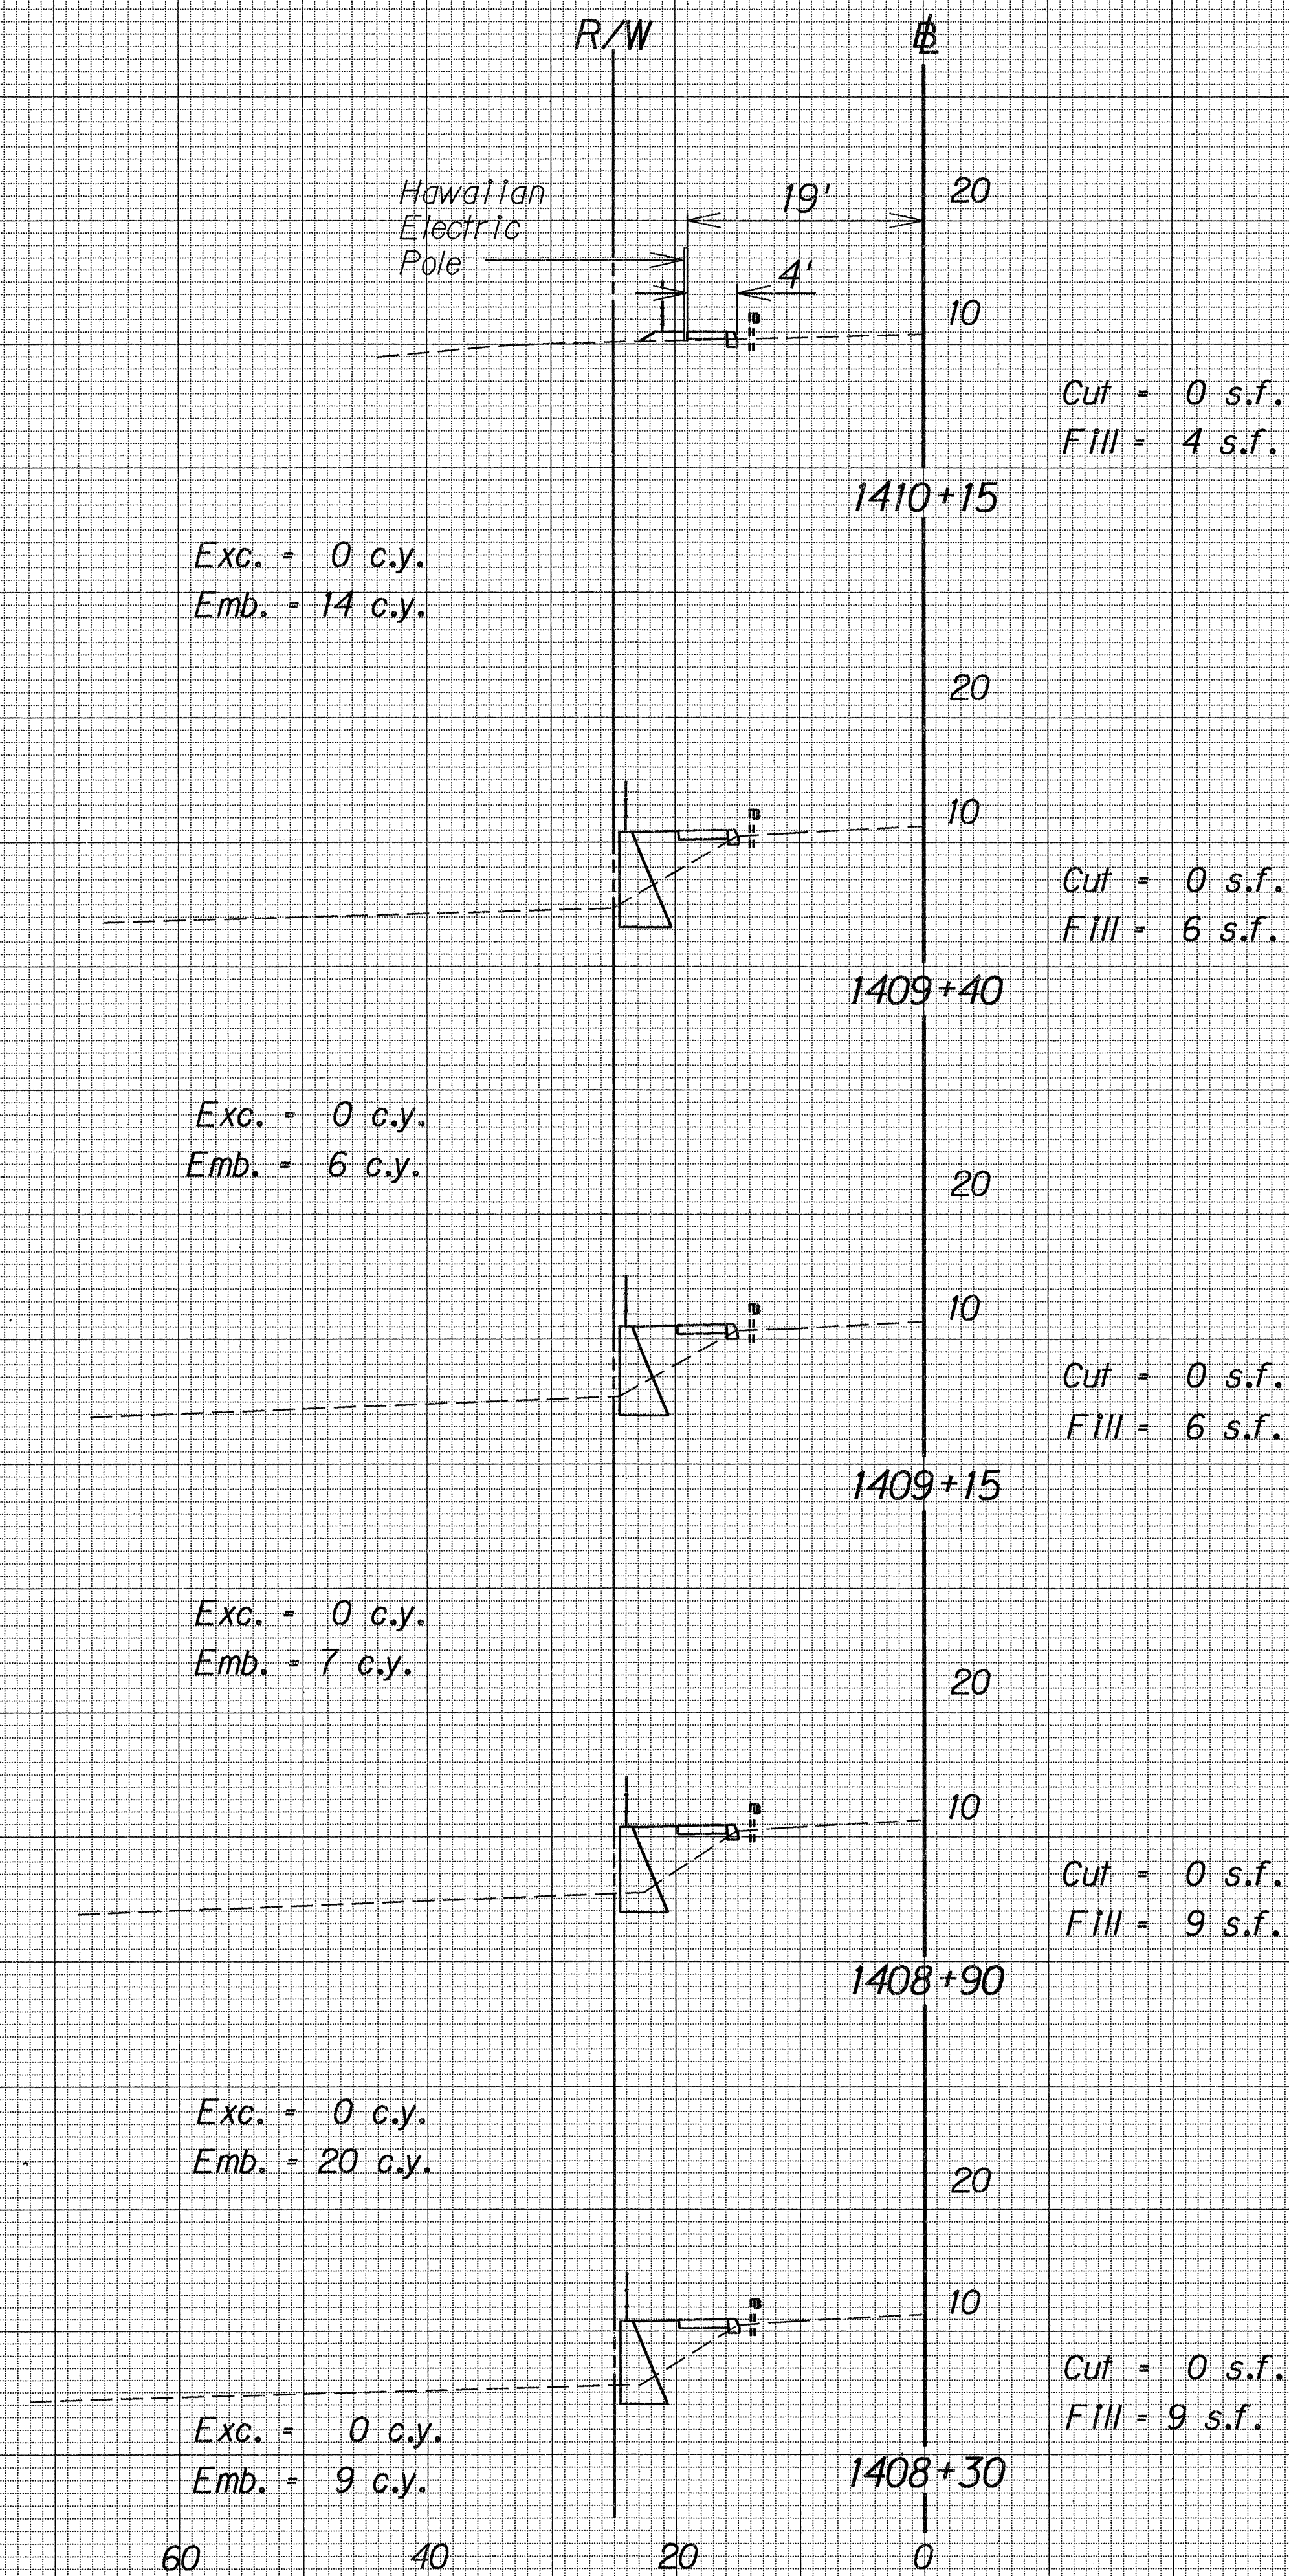

Scale:
 Horiz. : 1" = 10'
 Vert. : 1" = 10'

ORIGINAL PLAN	DATE
DESIGNED BY	
NOTED BY	
CHECKED BY	
DATE	