



FED. ROAD DIST. NO.	STATE	PROJ. NO.	FISCAL YEAR	SHEET NO.	TOTAL SHEETS
HAWAII	HAW.	83C-02-91M	1991	C.O. ADD.4	9

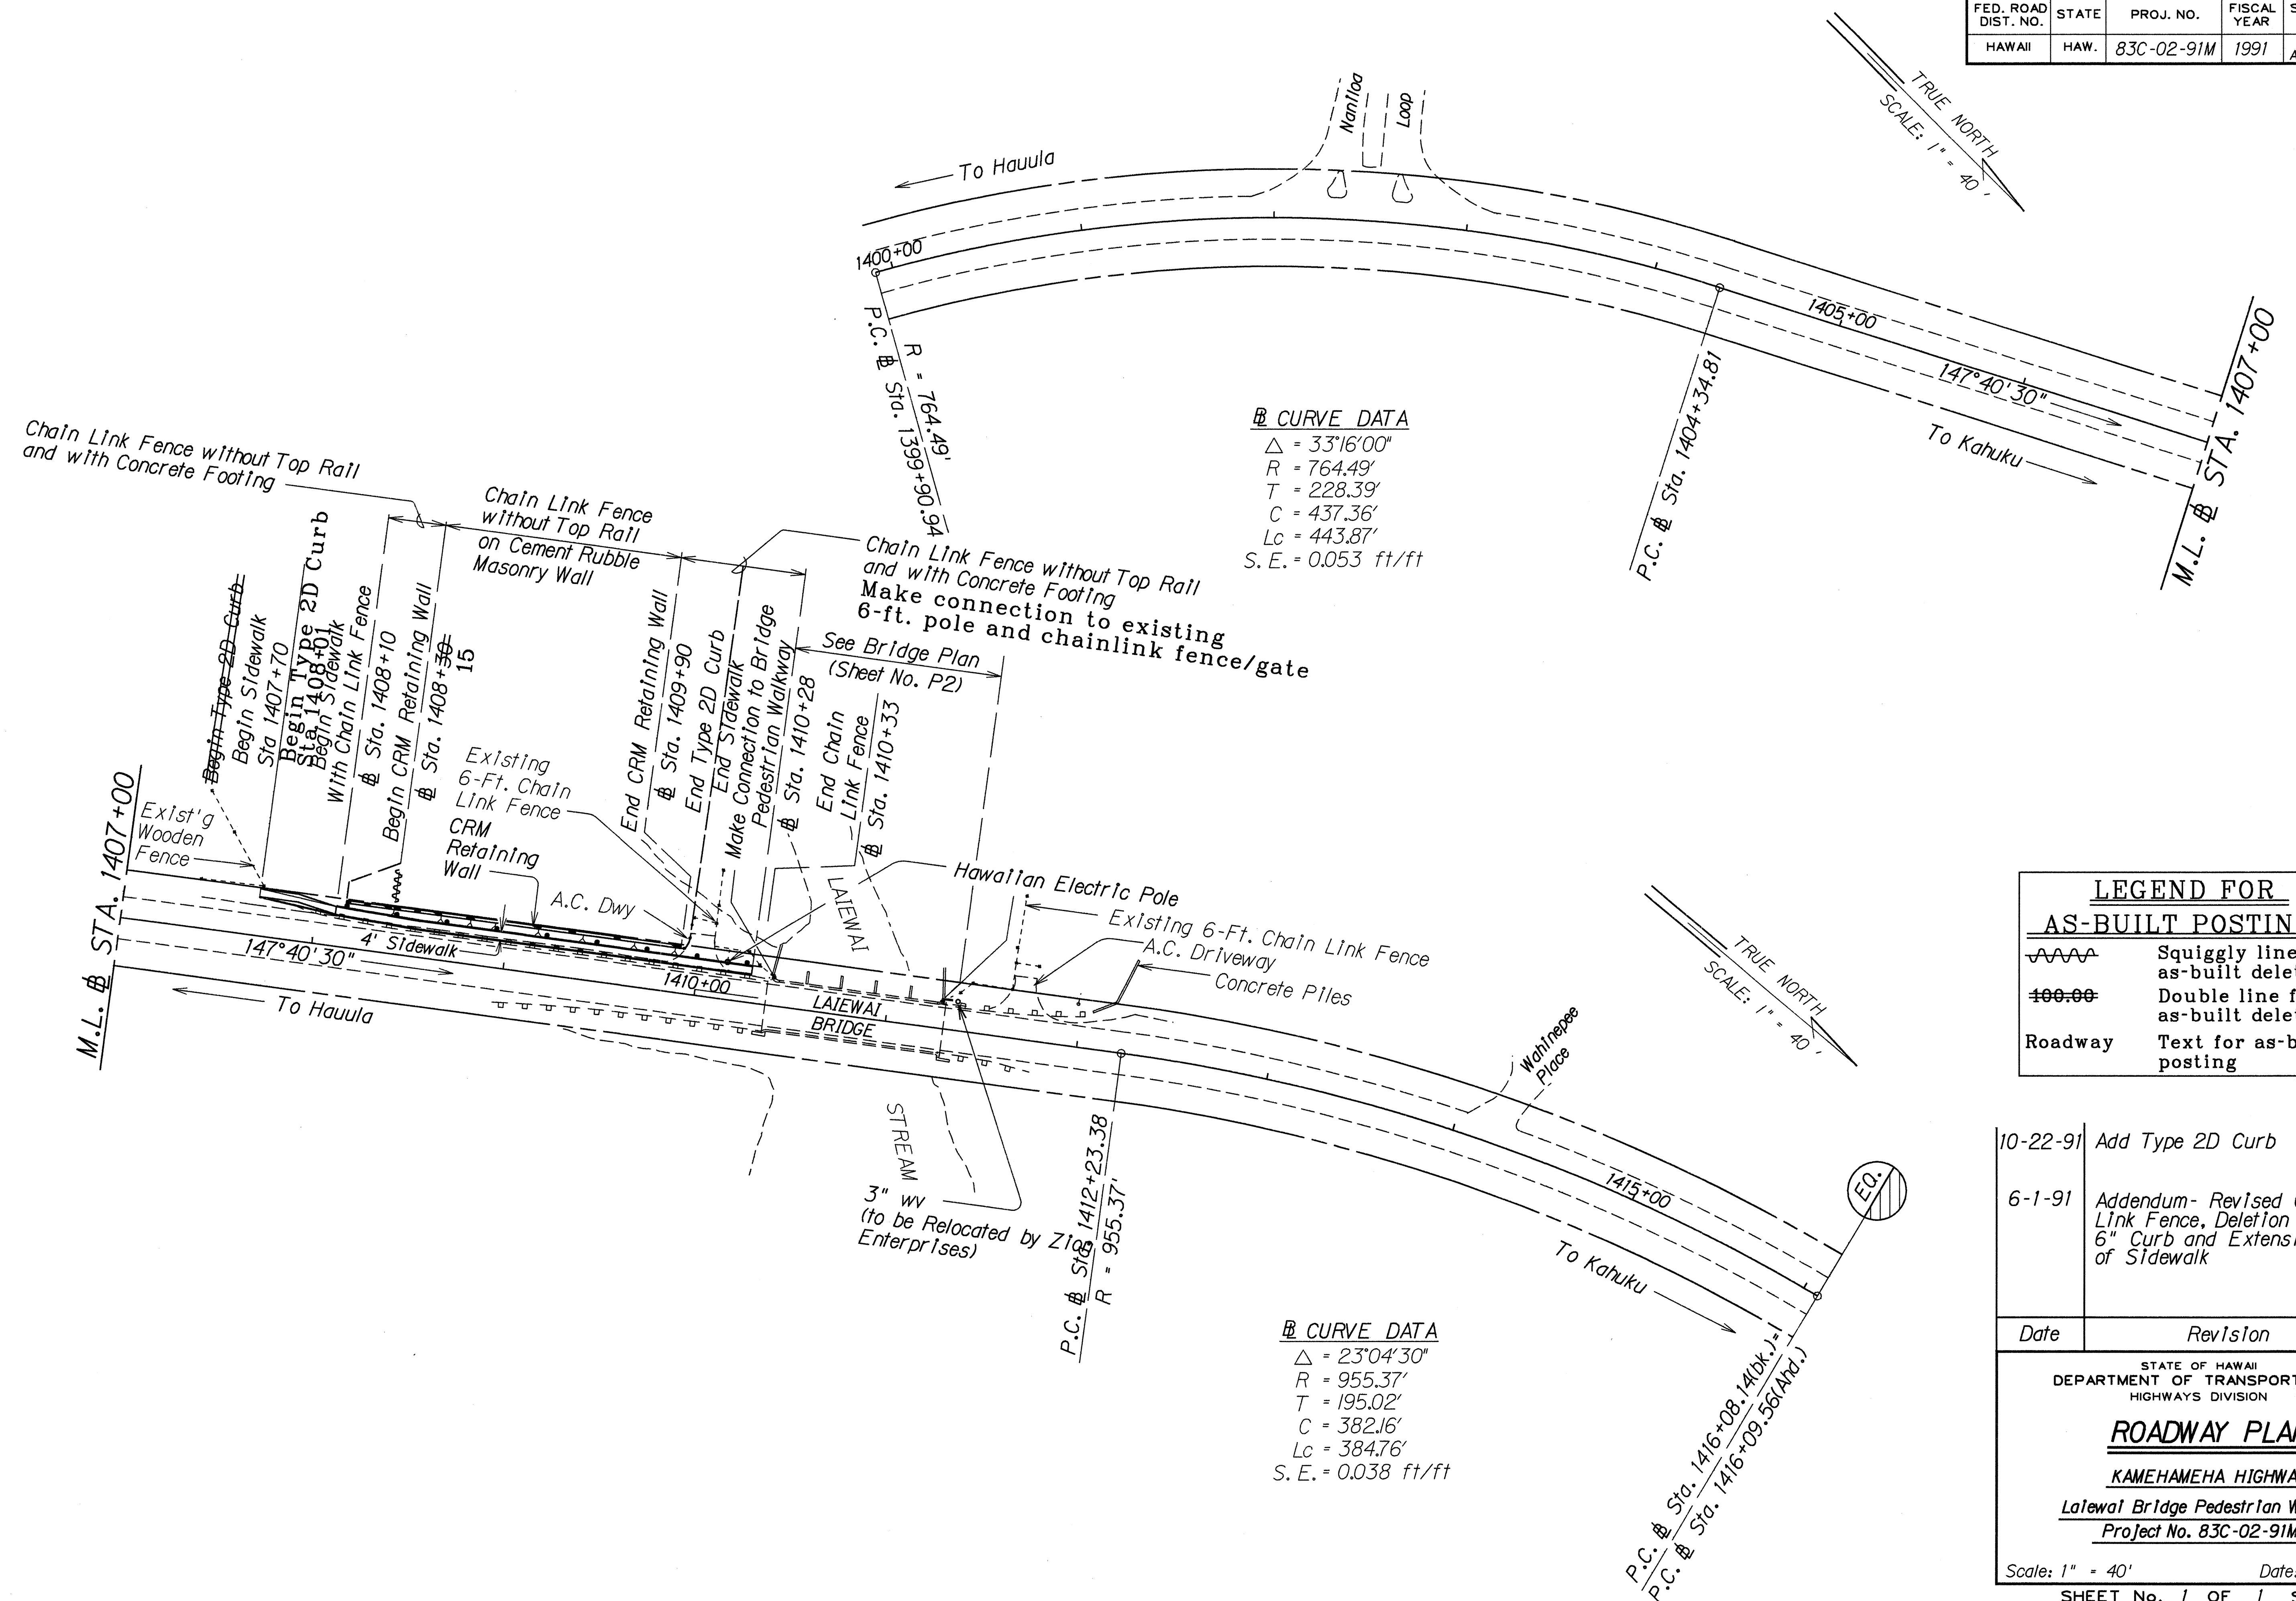

<u>LEGEND FOR</u> <u>AS-BUILT POSTINGS</u>	
	Squiggly line for as-built deletion
<del>100.00</del>	Double line for as-built deletion
Roadway	Text for as-built posting

10-22-91	Add Type 2D Curb
6-1-91	Addendum- Revised Chain Link Fence, Deletion of 6" Curb and Extension of Sidewalk
Date	Revision

STATE OF HAWAII  
DEPARTMENT OF TRANSPORTATION  
HIGHWAYS DIVISION

**ROADWAY PLAN**

**KAMEHAMEHA HIGHWAY**

**Laiwalai Bridge Pedestrian Walkway**

**Project No. 83C-02-91M**

Scale: 1" = 40'
Date: April, 1991

**SHEET No. 1 OF 1 SHEETS**

## "AS-BUILT"

**C.O.ADD. 4**

ORIGINAL PLAN	SURVEY PLOTTED BY _____ DATE _____
NOTE BOOK	DRAWN BY _____
	TRACED BY _____
	DESIGNED BY _____
	QUANTITIES BY _____
No. _____	CHECKED BY _____