


INDEX TO DRAWINGS	
SHEET NO.	DESCRIPTION
1	TITLE SHEET
2	STANDARD PLAN SUMMARY
3	GENERAL NOTES AND TYPICAL SECTION
4	ROADWAY PLAN
5	BRIDGE LAYOUT PLAN AND GENERAL NOTES
6	PART DECK LAYOUT PLAN AND SECTION
7	BRIDGE SECTIONS AND DETAILS
8	BRIDGE TYPICAL DETAILS
9	CROSS SECTIONS

STATE OF HAWAII
DEPARTMENT OF TRANSPORTATION
HIGHWAYS DIVISION
HONOLULU, HAWAII


"AS-BUILT"
PLANS FOR
KAMEHAMEHA HIGHWAY
LAIEWAI BRIDGE PEDESTRIAN WALKWAY
PROJECT NO. 83C-02-9IM

DISTRICT OF KOOLAULOA
ISLAND OF OAHU

THIS IS A SUPPLEMENTAL SHEET.
△ C.O. ADD. 3 S-I
NEW PLAN SHEET TOTAL = 10 SHTS.

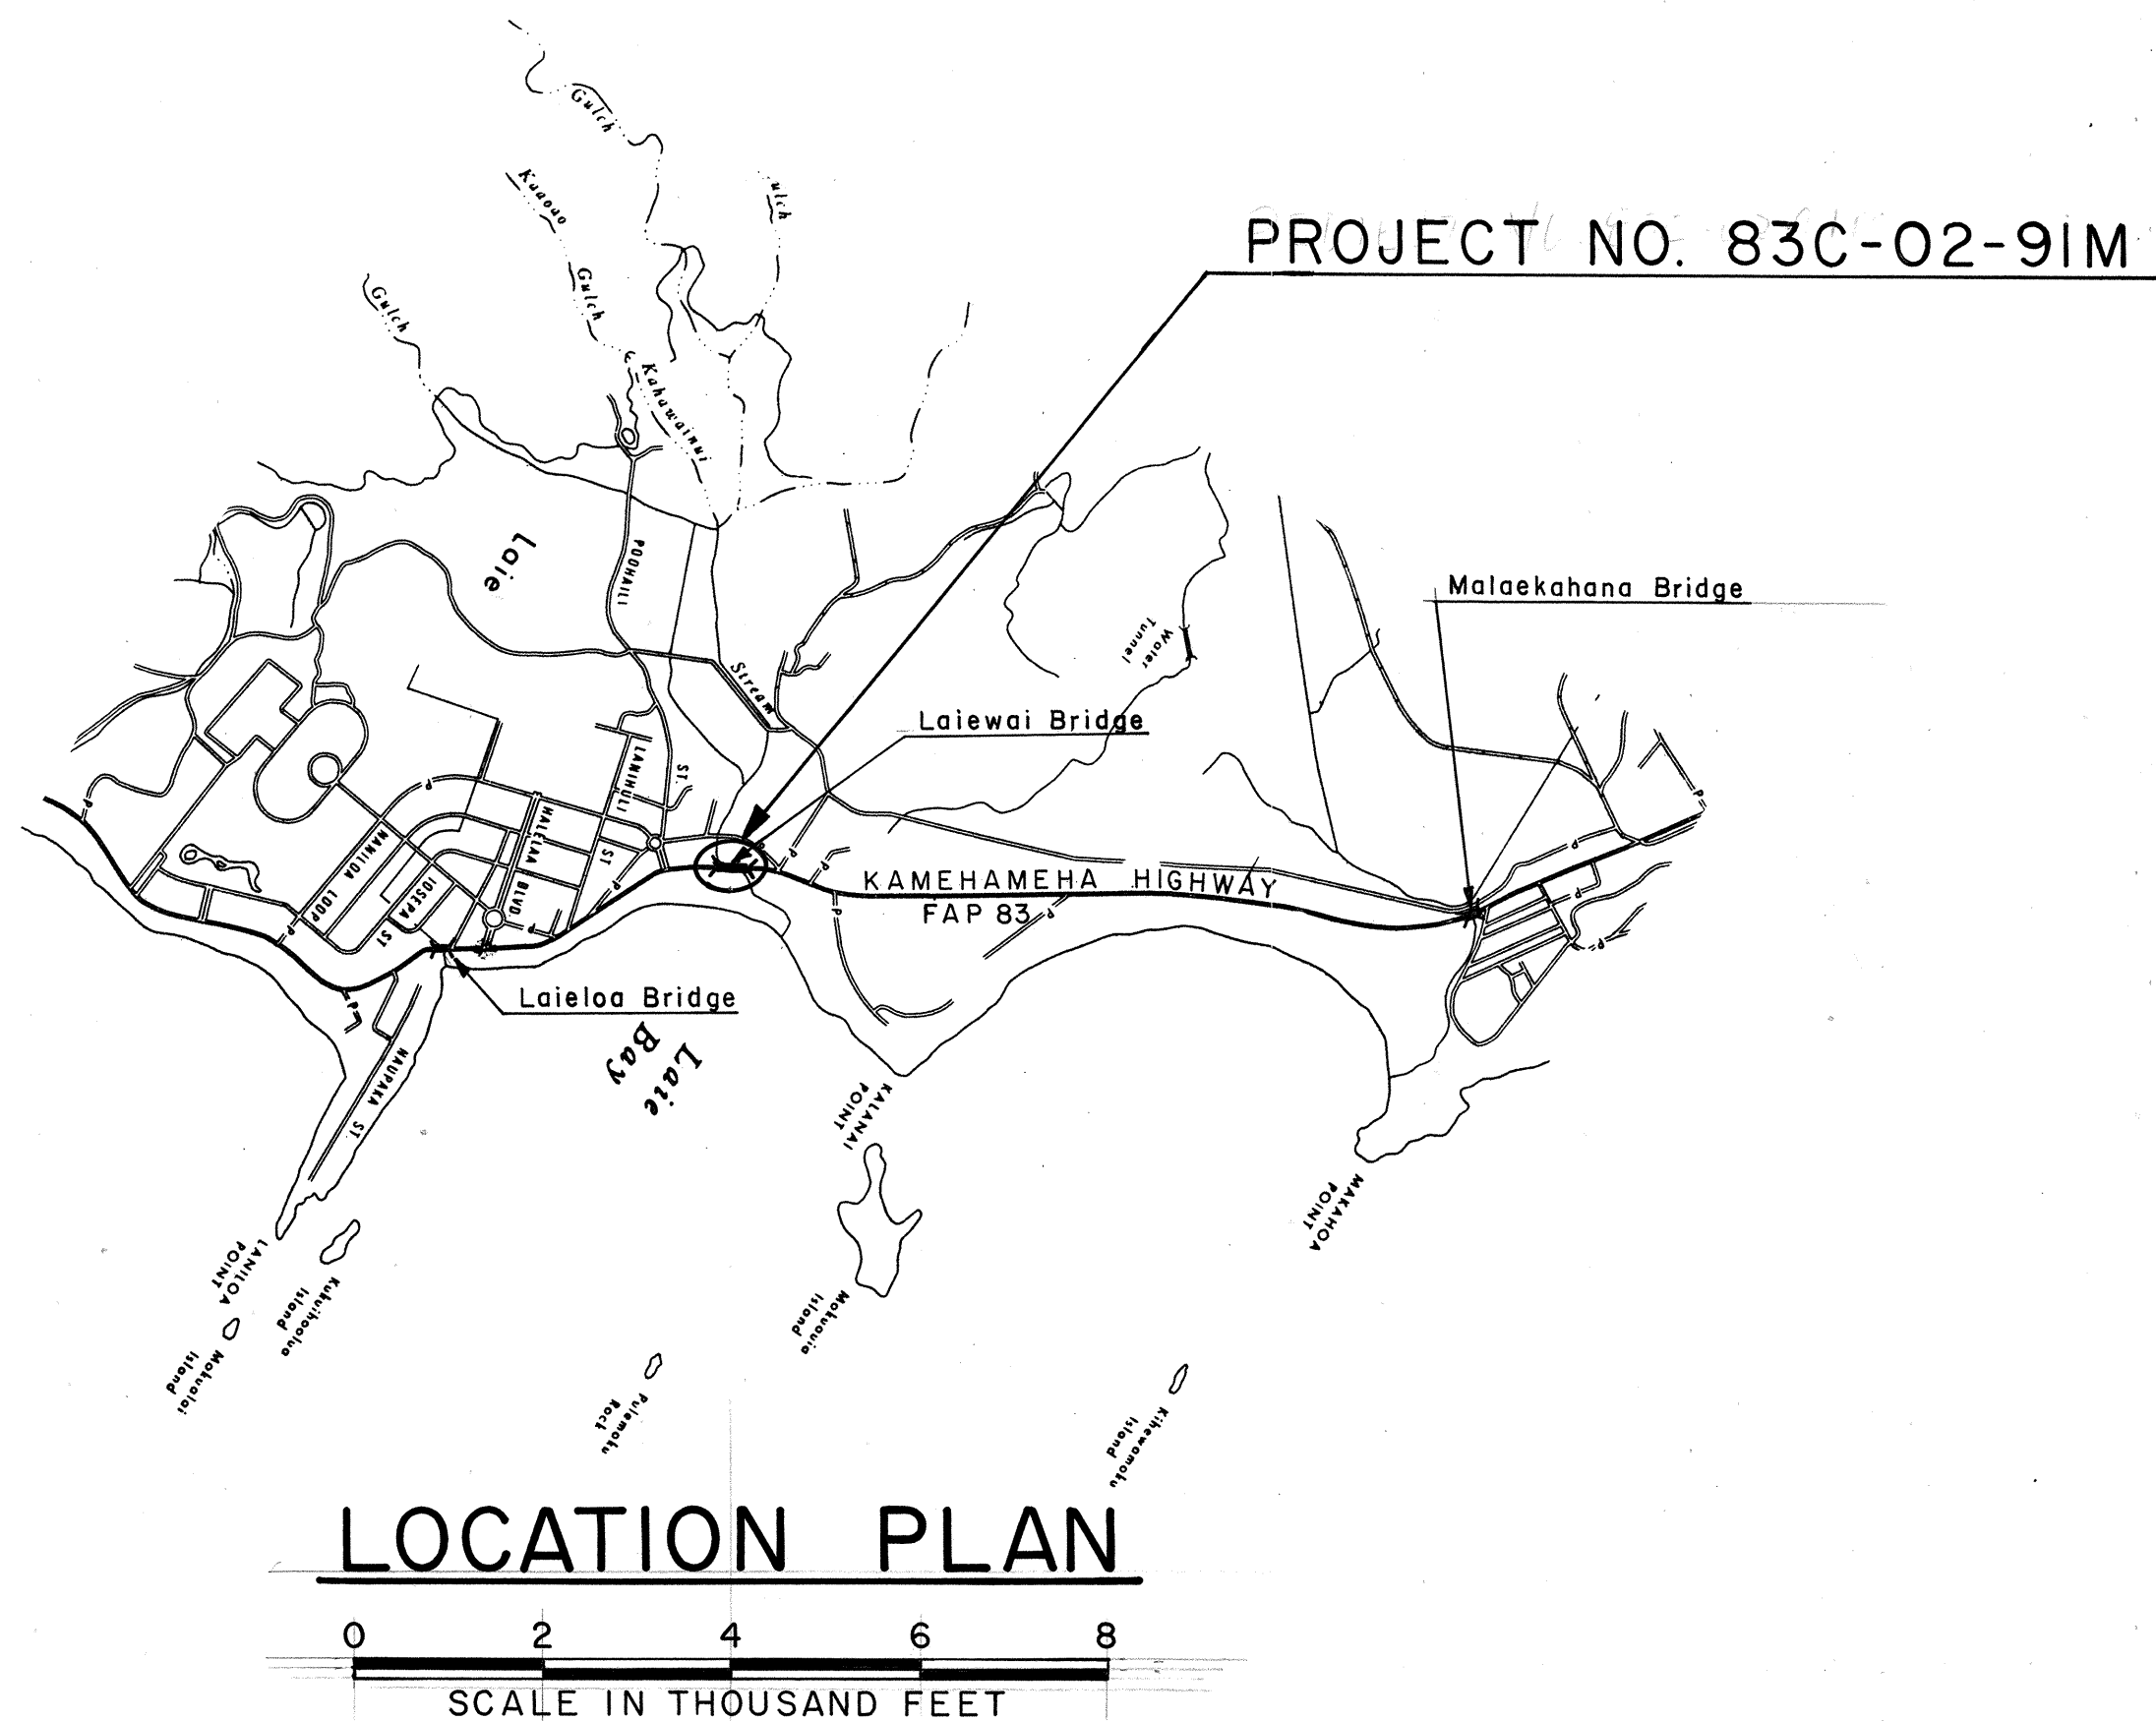

FED. ROAD DIST. NO.	STATE	PROJ. NO.	FISCAL YEAR	SHEET NO.	TOTAL SHEETS
HAWAII	HAW.	83C-02-9IM	1991	1	9

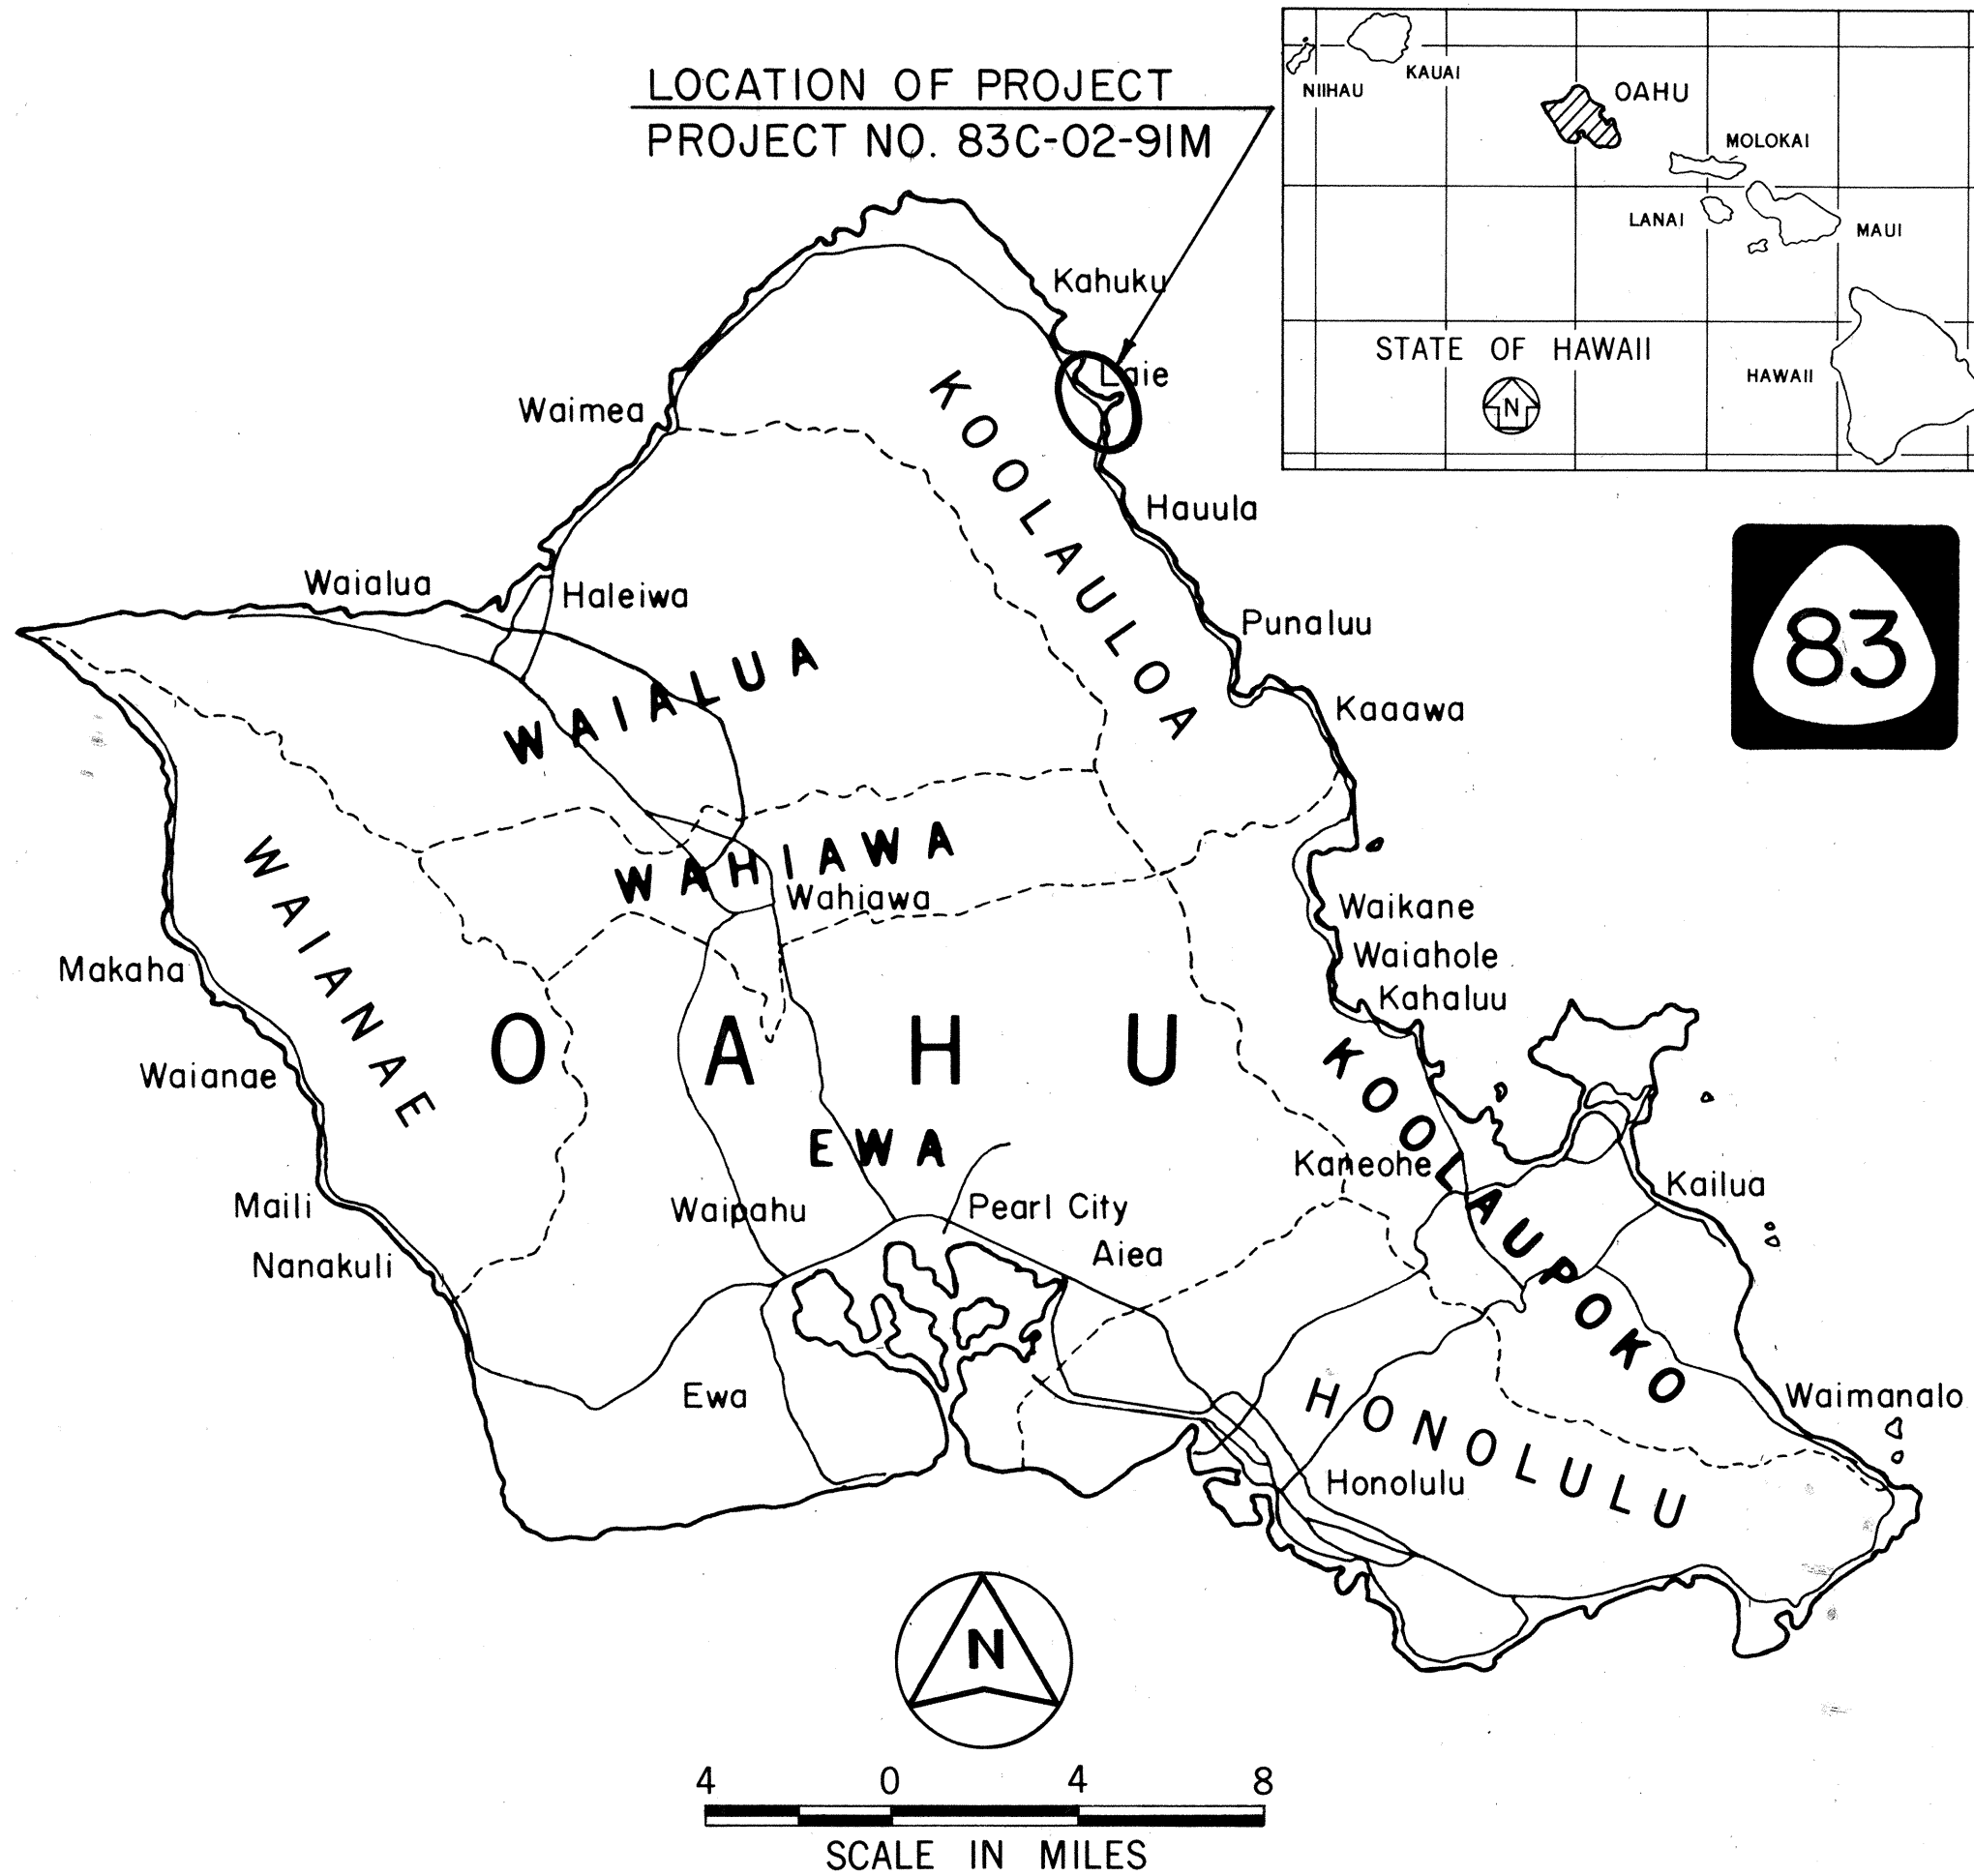

MILE POST 17.80 TO MILE POST 17.90

CHANGES MADE DURING CONSTRUCTION HAVE BEEN INCORPORATED ON THESE PLANS EXCEPT CHANGES IN THE ORIGINAL THEORETICAL QUANTITIES. FOR ACTUAL QUANTITIES, REFER TO PROJECT LEDGER AND/OR COMPUTATION BOOK.

Wanda Loui
RESIDENT ENGINEER

8-5-96
DATE

DEPARTMENT OF TRANSPORTATION STATE OF HAWAII	
APPROVED:	
<i>Edward J. Smith</i>	5/21/91
DIR. OF TRANSPORTATION	DATE

DESIGN UNIT E R. TAKAESU 548-7534 APRIL, 1991
P. S. & E. BY PHONE DATE