


[illegible]


STATE OF HAWAII
DEPARTMENT OF TRANSPORTATION
HIGHWAYS DIVISION
HONOLULU, HAWAII

KAHEKILI HIGHWAY
HIGHWAY LIGHTING
AHUIMANU PLACE TO AHUIMANU ROAD
PROJECT NO. 83F-01-91
DISTRICT OF KOOLAUPOKO
ISLAND OF OAHU

FED. ROAD DIST. NO.	STATE	PROJ. NO.	FISCAL YEAR	SHEET NO.	TOTAL SHEETS
HAWAII	HAW.	83F-01-91	1991	1	7

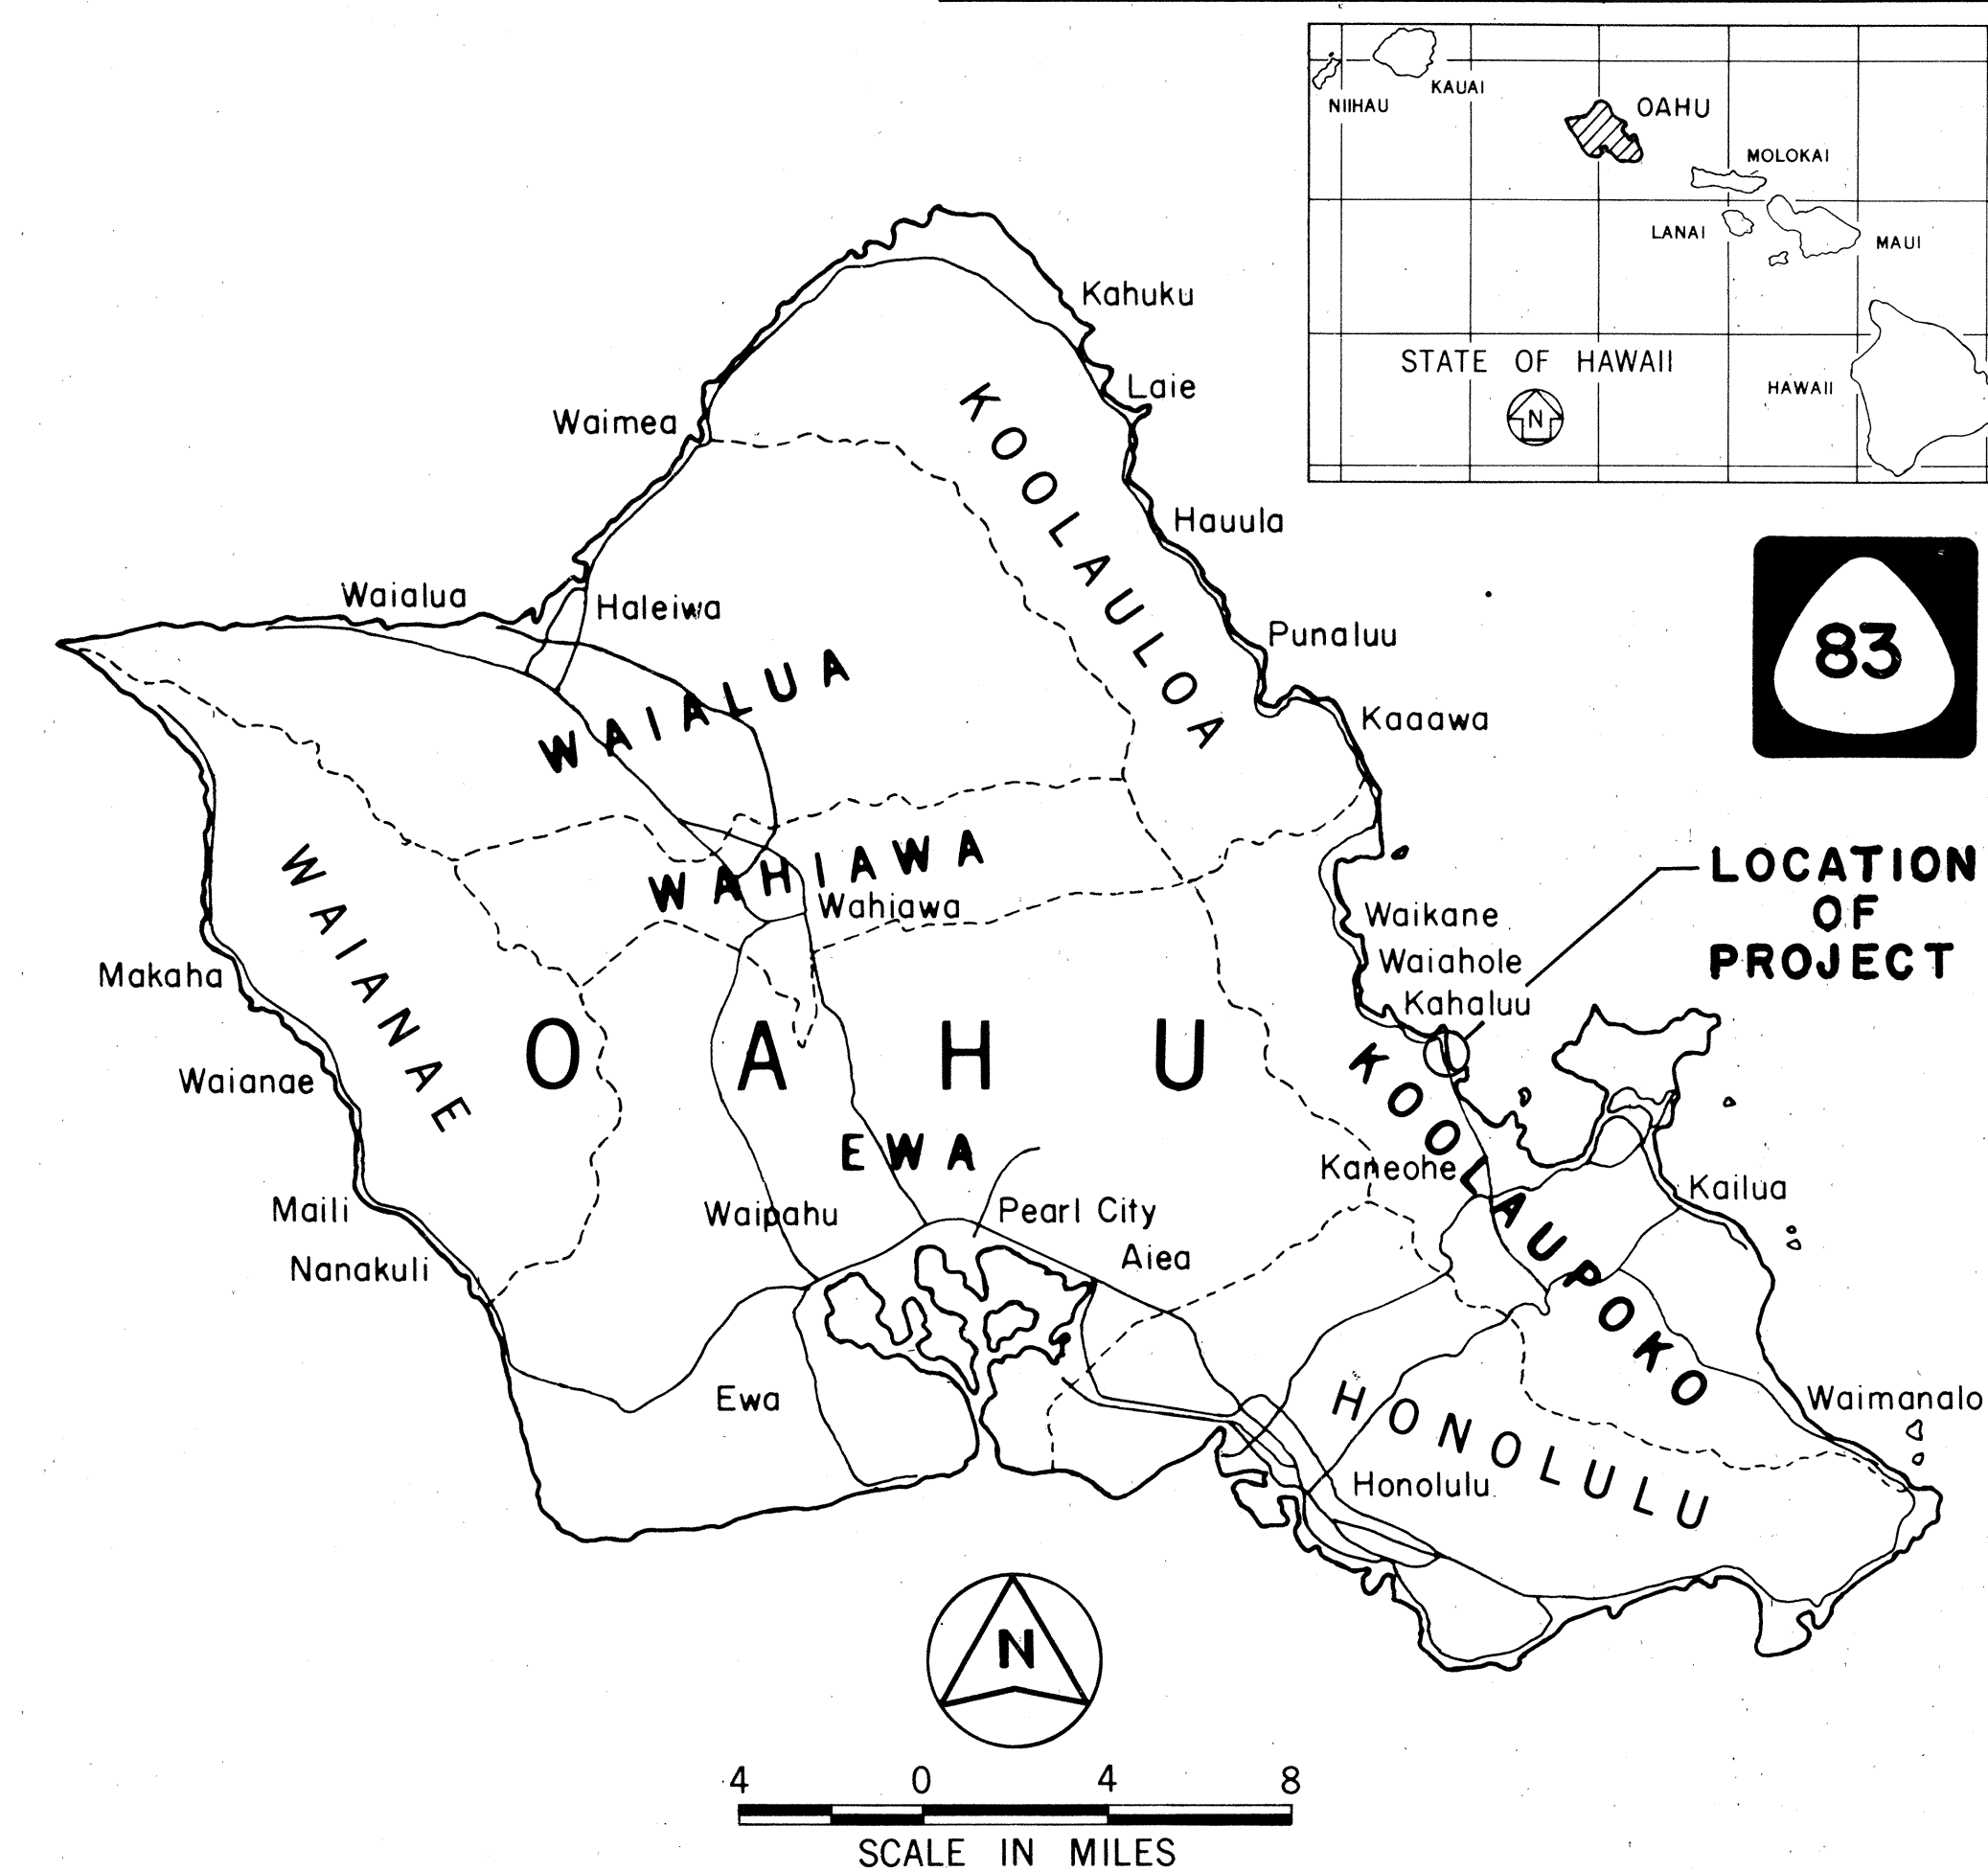

MILE POST 37.52 TO MILE POST 36.84

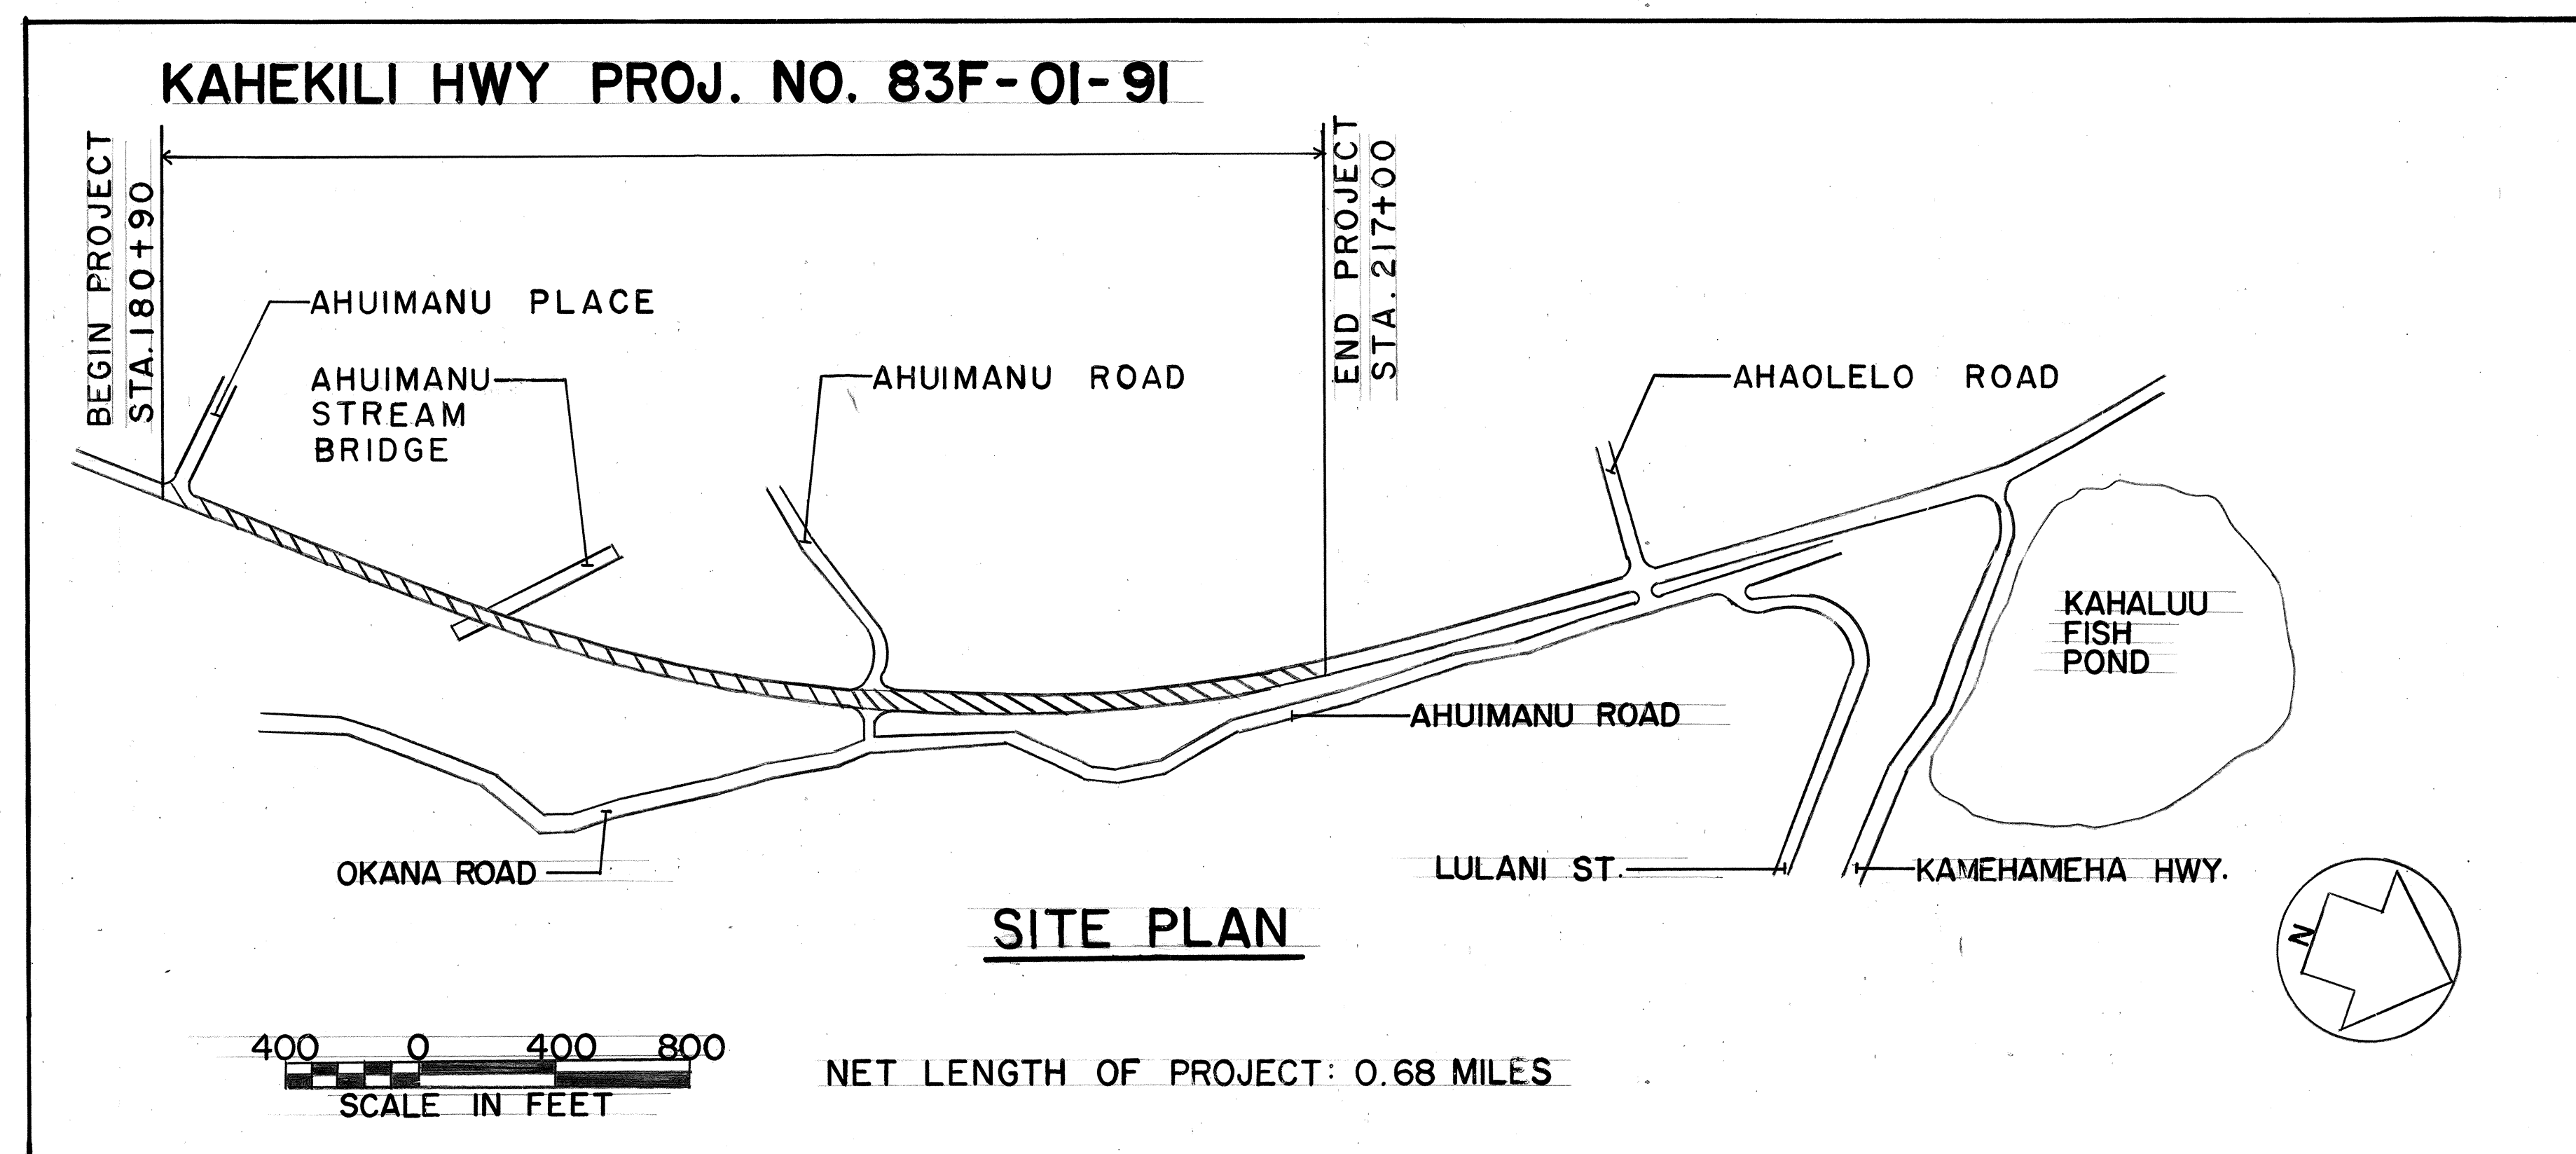

DEPARTMENT OF TRANSPORTATION STATE OF HAWAII	
APPROVED: <u>A. Hanao</u> <u>4/13/92</u>	
FOR DIR. OF TRANSPORTATION	DATE