	INDEX TO DRAWINGS
SHEET NO.	DESCRIPTION
1	TITLE SHEET
2	STREET LIGHT PLAN & LEGEND
	·
3	STREET LIGHT PLAN
4	STREET LIGHT DETAILS
5	STREET LIGHT CIRCUIT DETAILS AND
	WIRING DIAGRAM
`	
	,

STATE OF HAWAII


DEPARTMENT OF TRANSPORTATION
HIGHWAYS DIVISION
HONOLULU, HAWAII


"AS-BUILT"

PLANS FOR
KAMEHAMEHA HIGHWAY STREET LIGHTS

MALAEKAHANA STATE PARK TO MALAEKAHANA BRIDGE

PROJECT NO. 83C-01-91

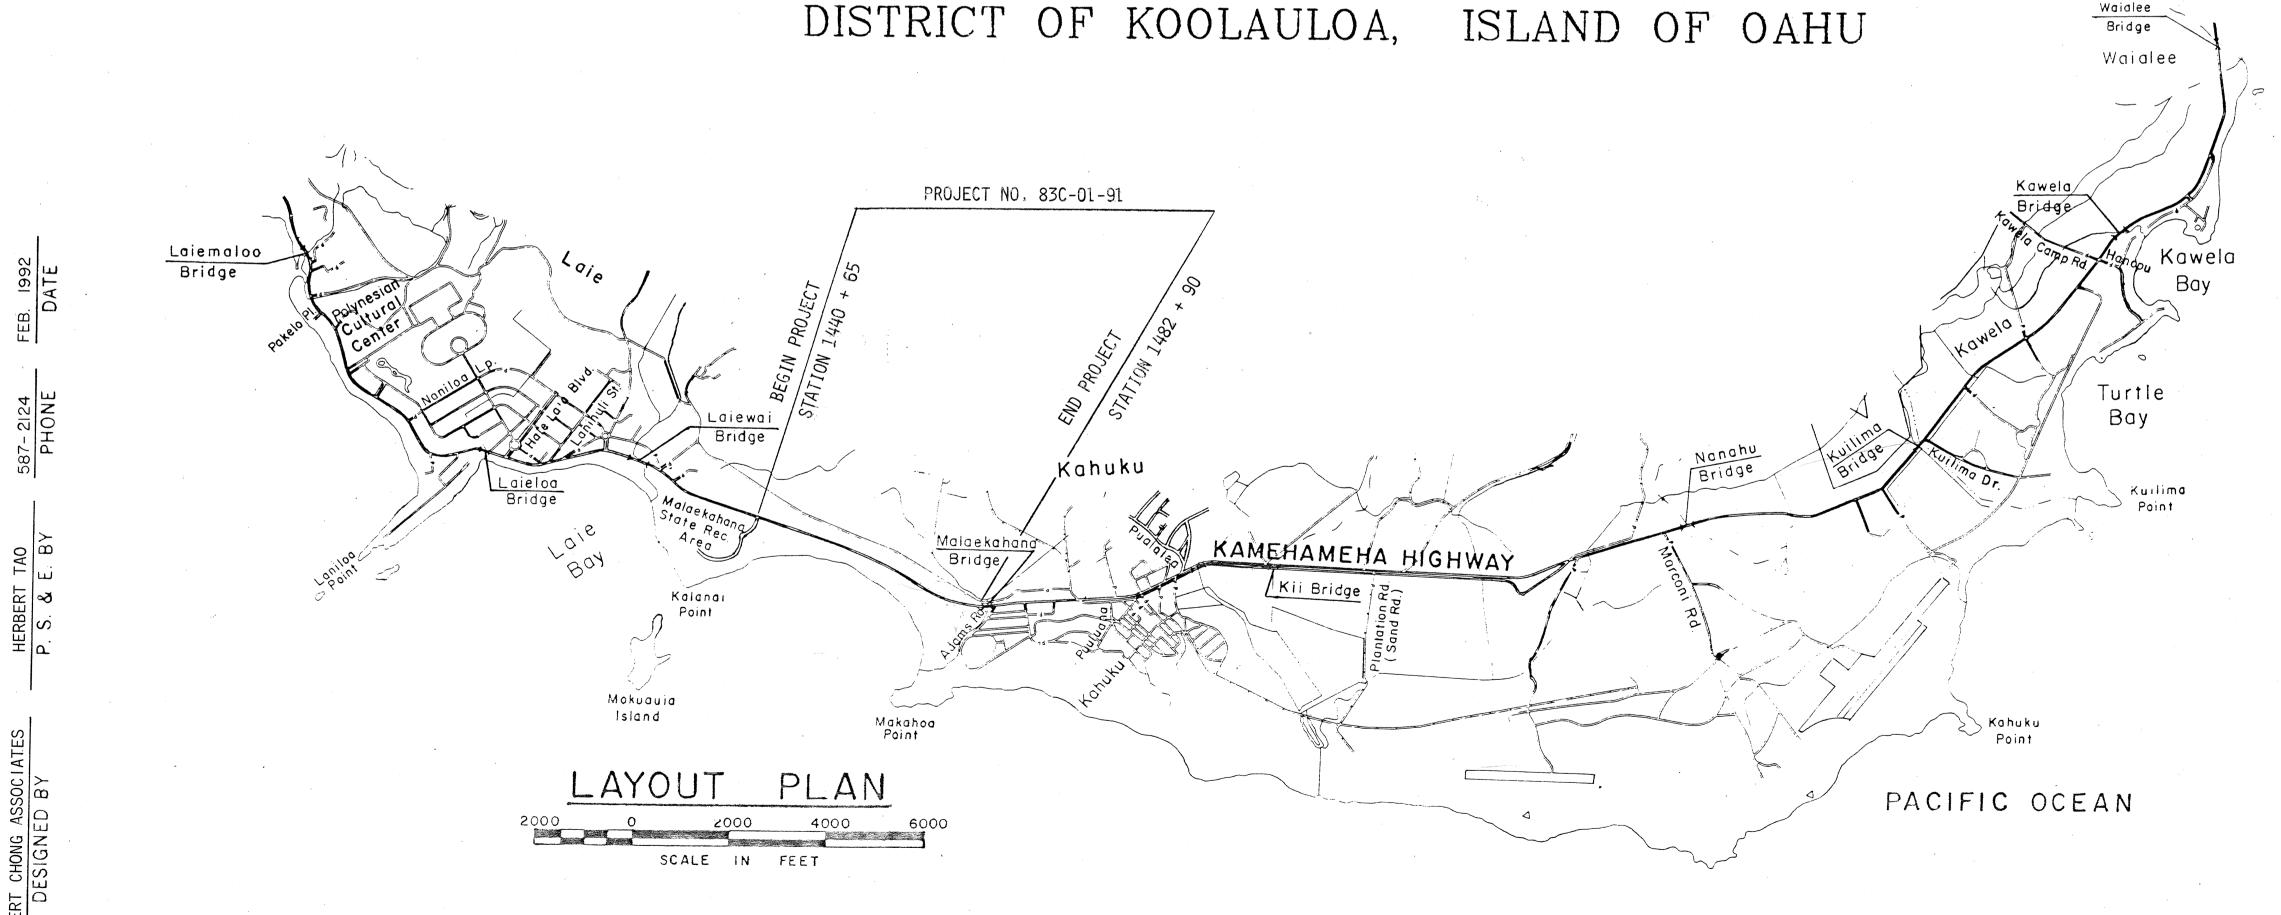

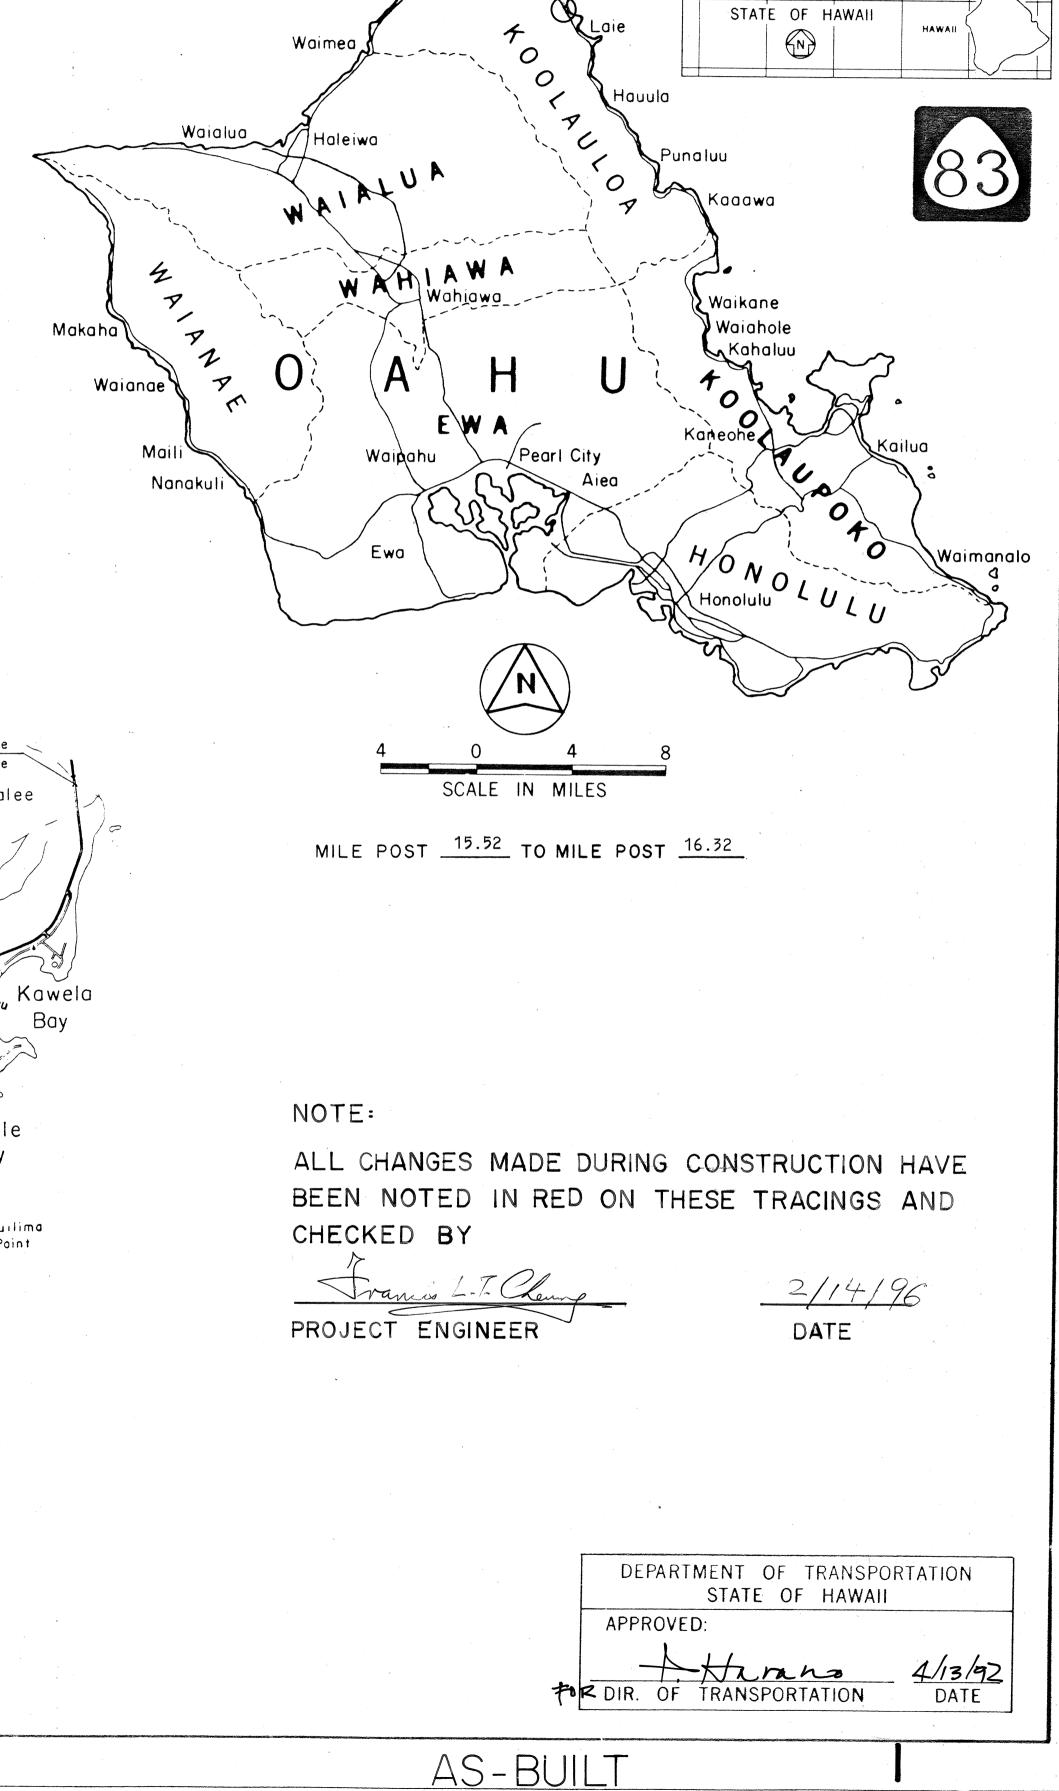

FED. ROAD DIST. NO.

LOCATION OF PROJECT NO.

FISCAL SHEET YEAR NO.

PROJ. NO.

83C-01-91

TOTAL SHEETS